



12/18  
OVERSPEED  
FILE


F-5509  
RIVERS PARK FIREHOUSE  
CROSS-SECTIONS OF  
STORM WATER MANAGEMENT  
POND  
FIELD BOOK 105 PAGES 47-53  
SHEET 1 OF 2  
SCALE  
V: 1" = 10'  
H: 1" = 10'

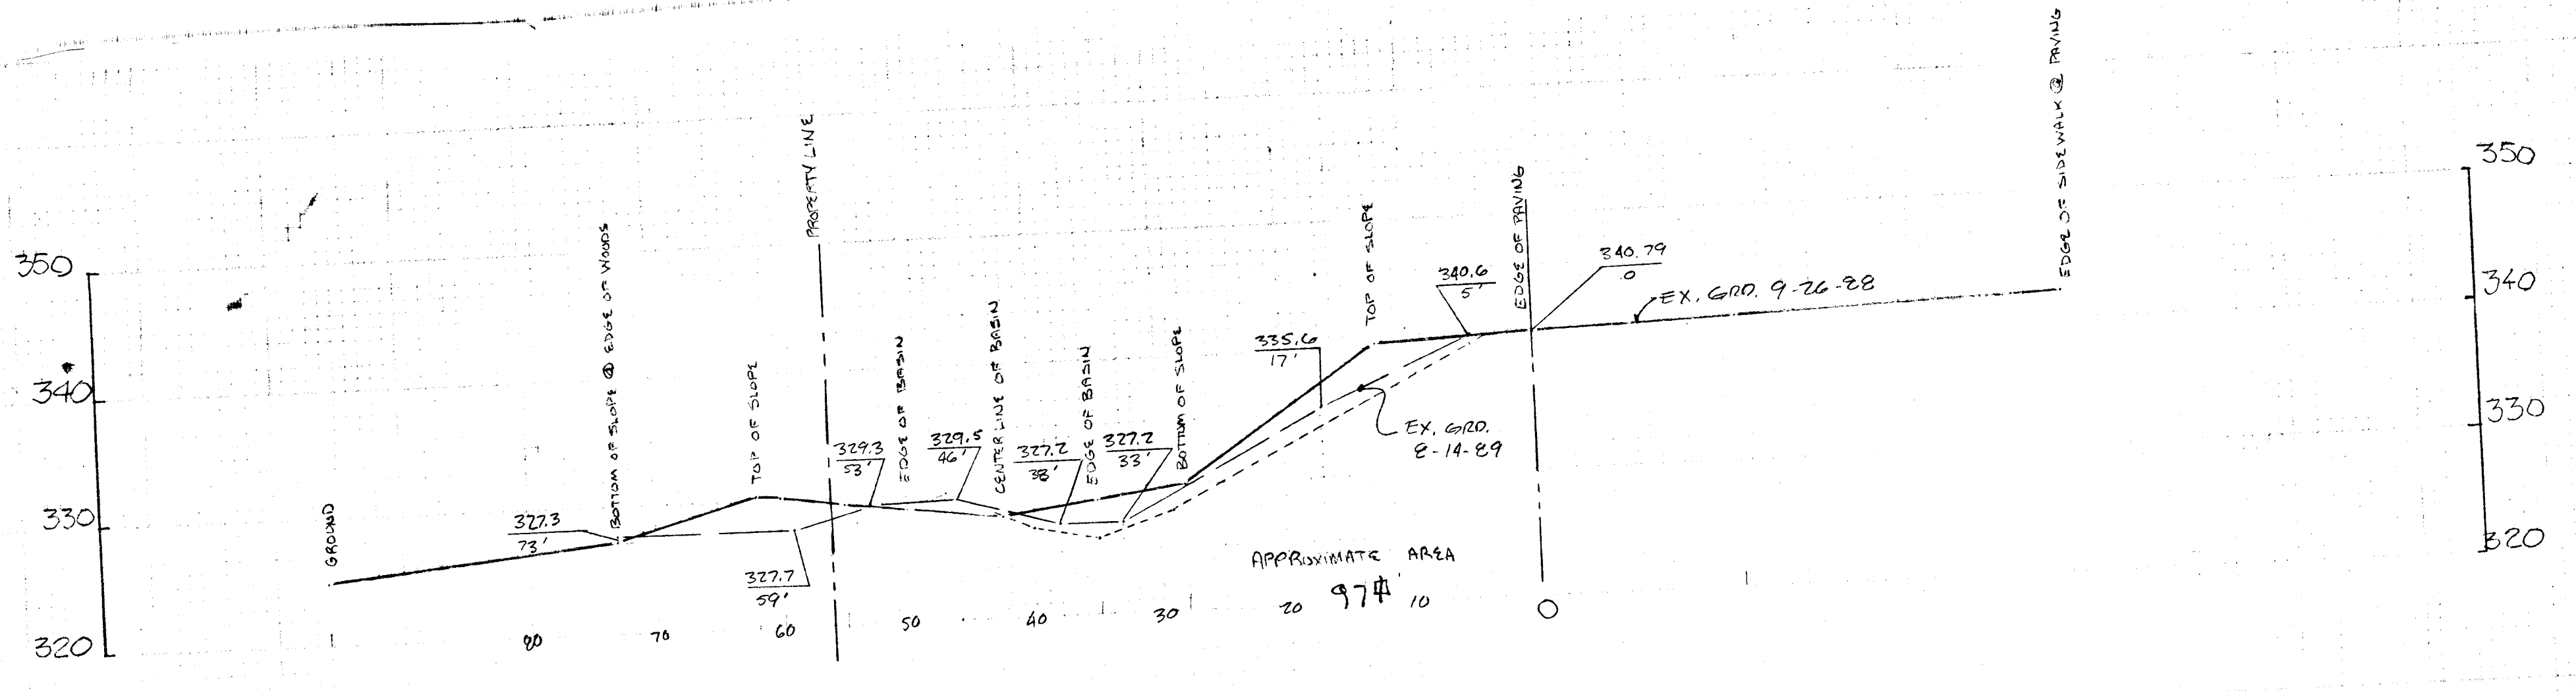


STA. 1+00

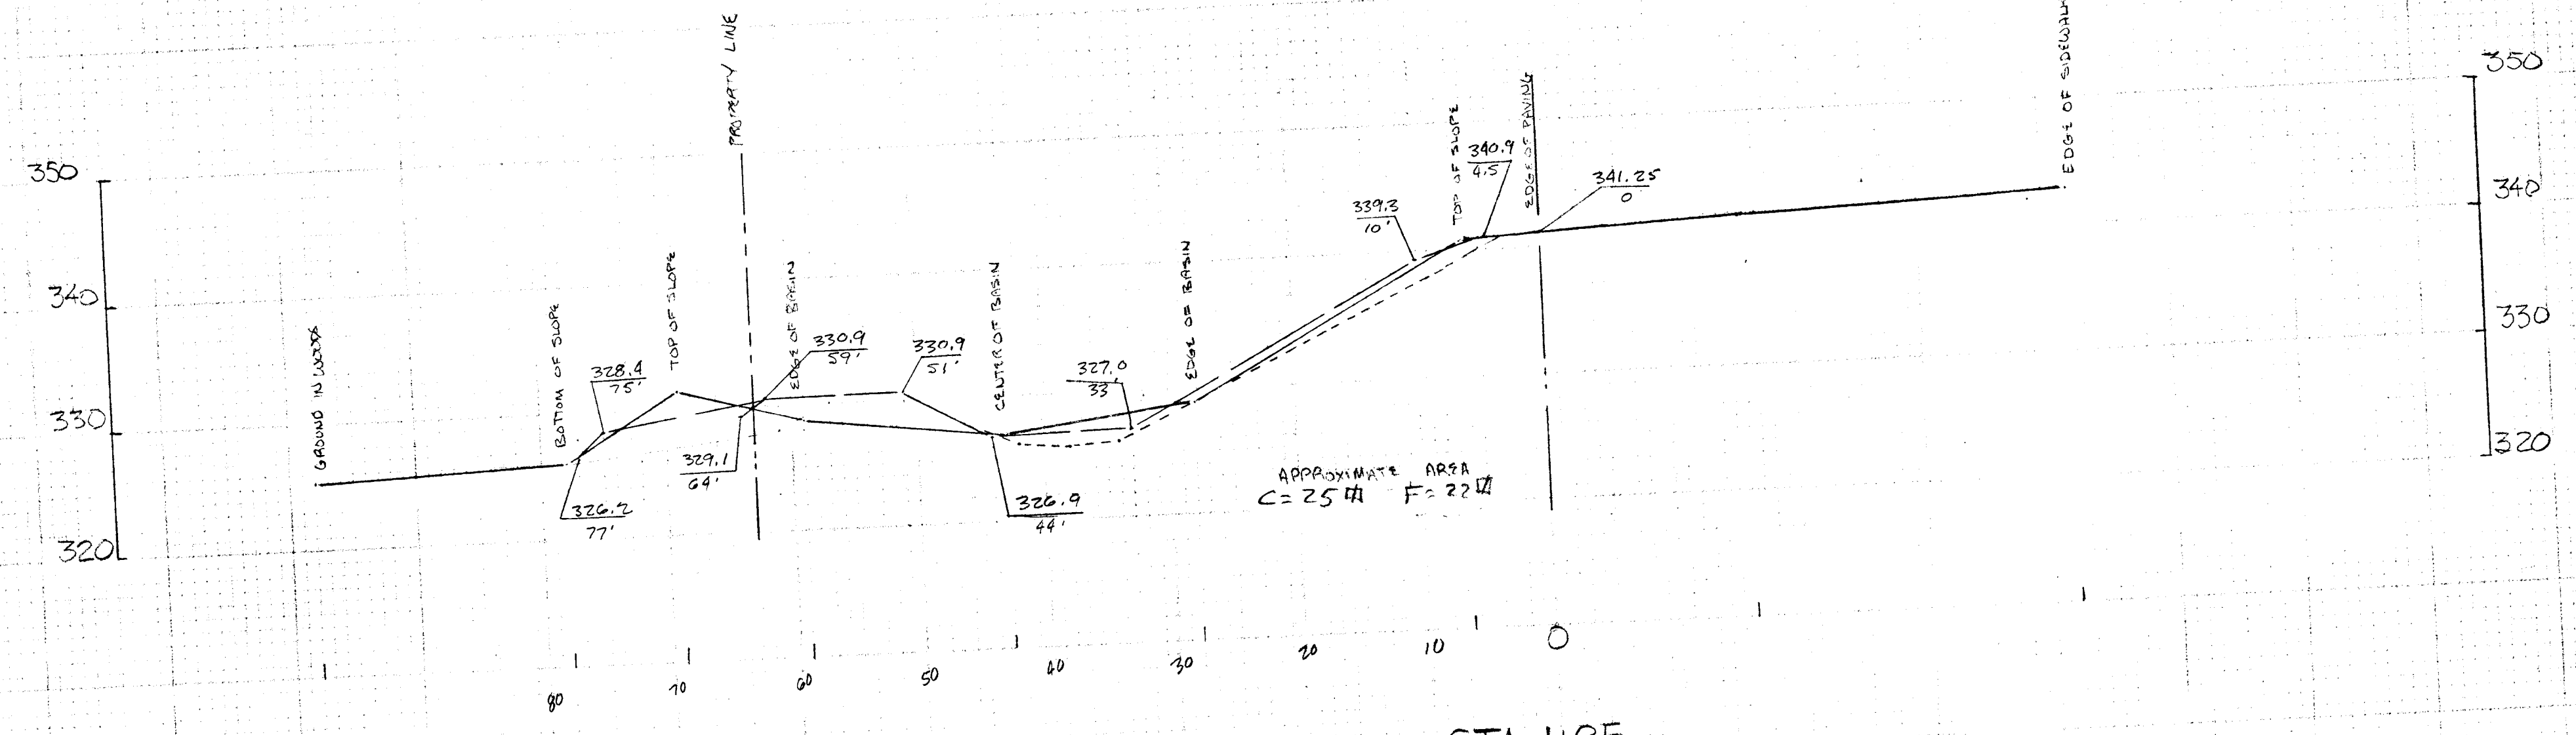


STA. 1+25

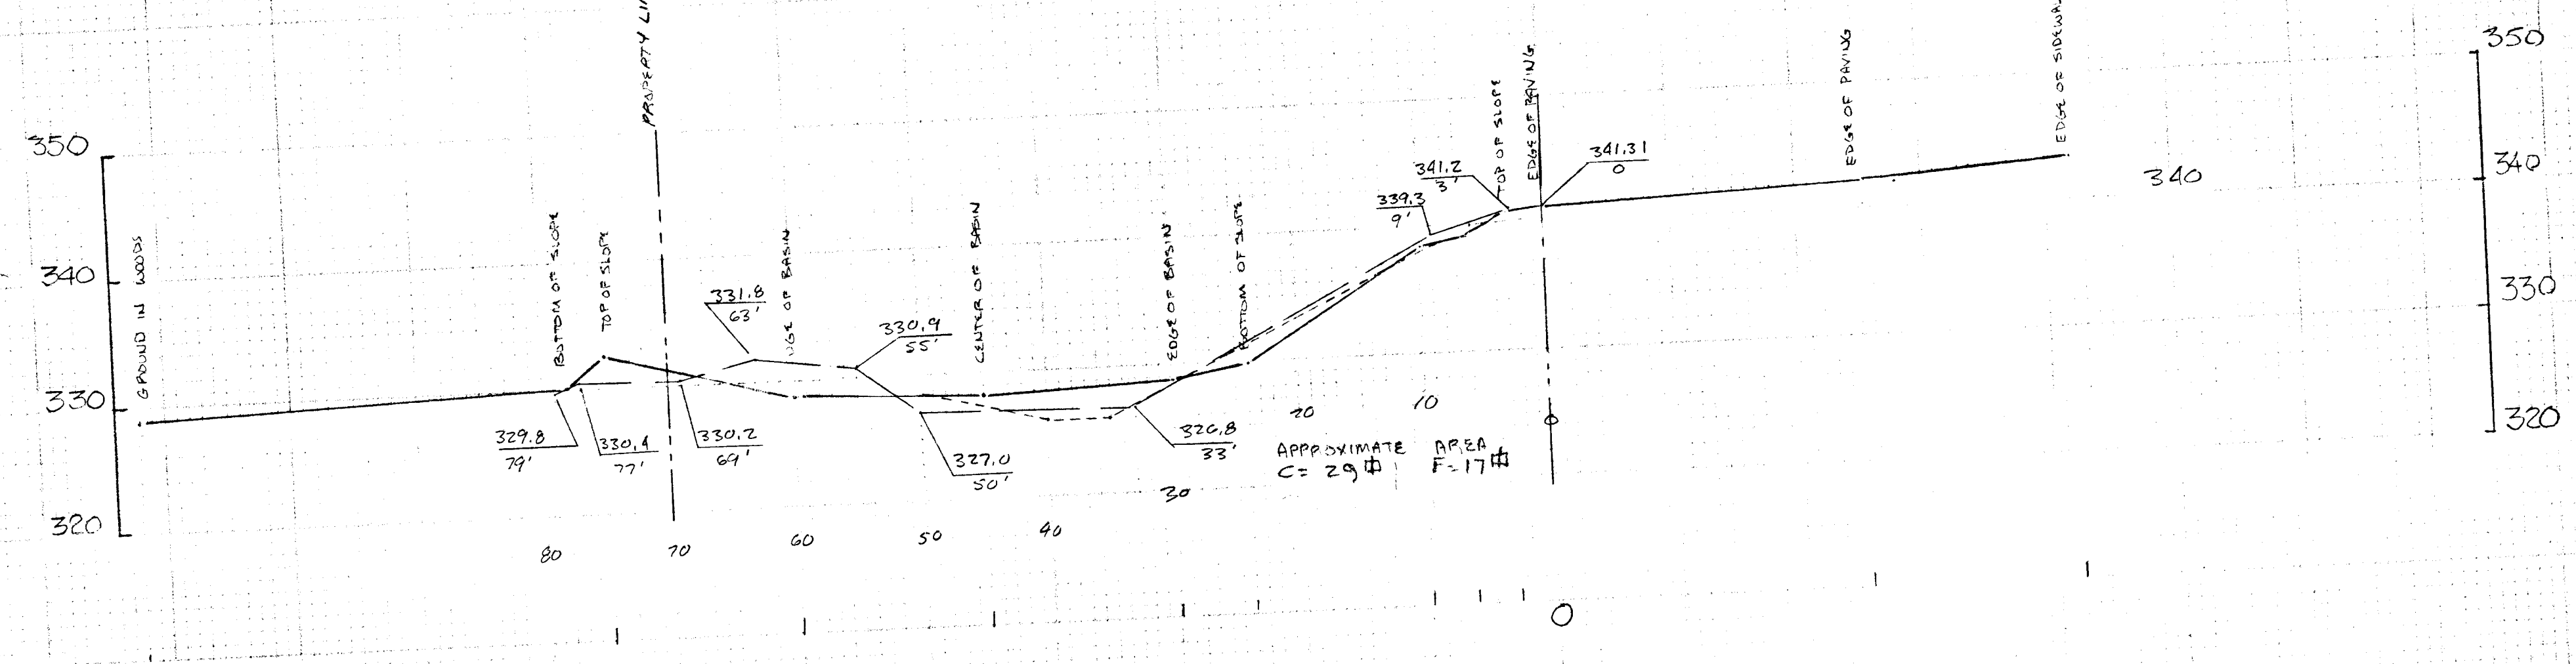


STA. 1+50

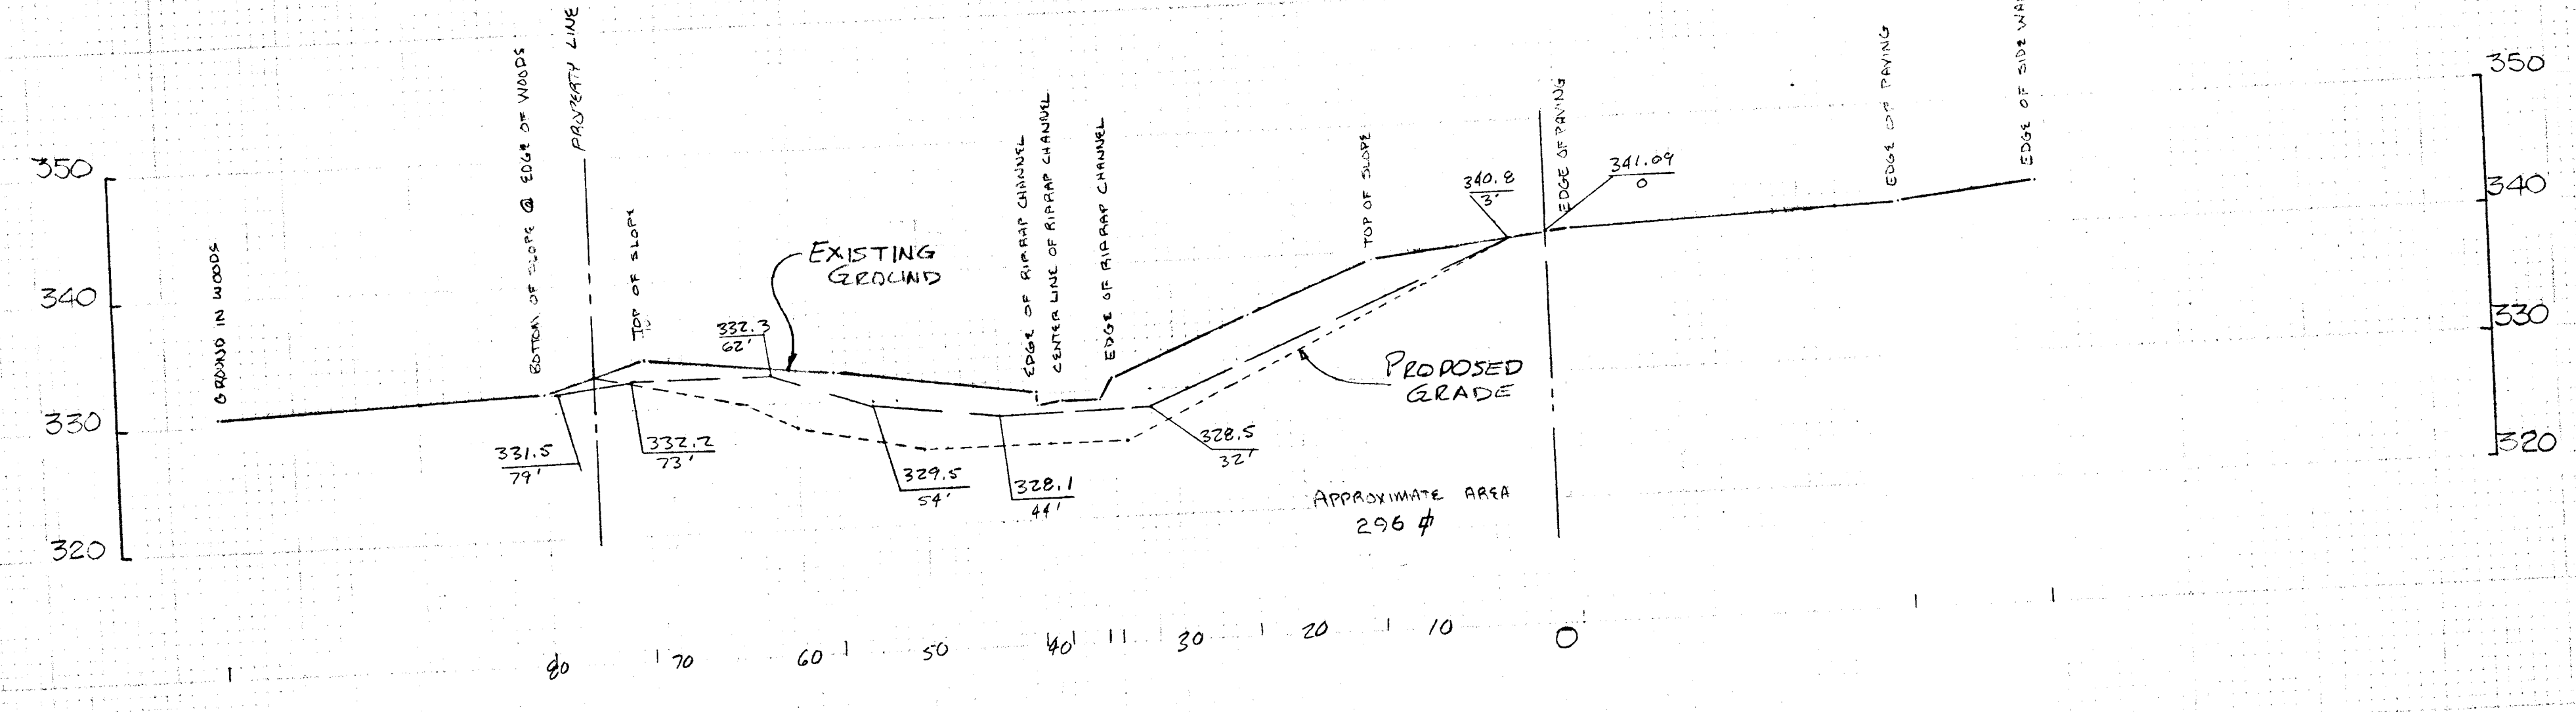

STA. 1+75

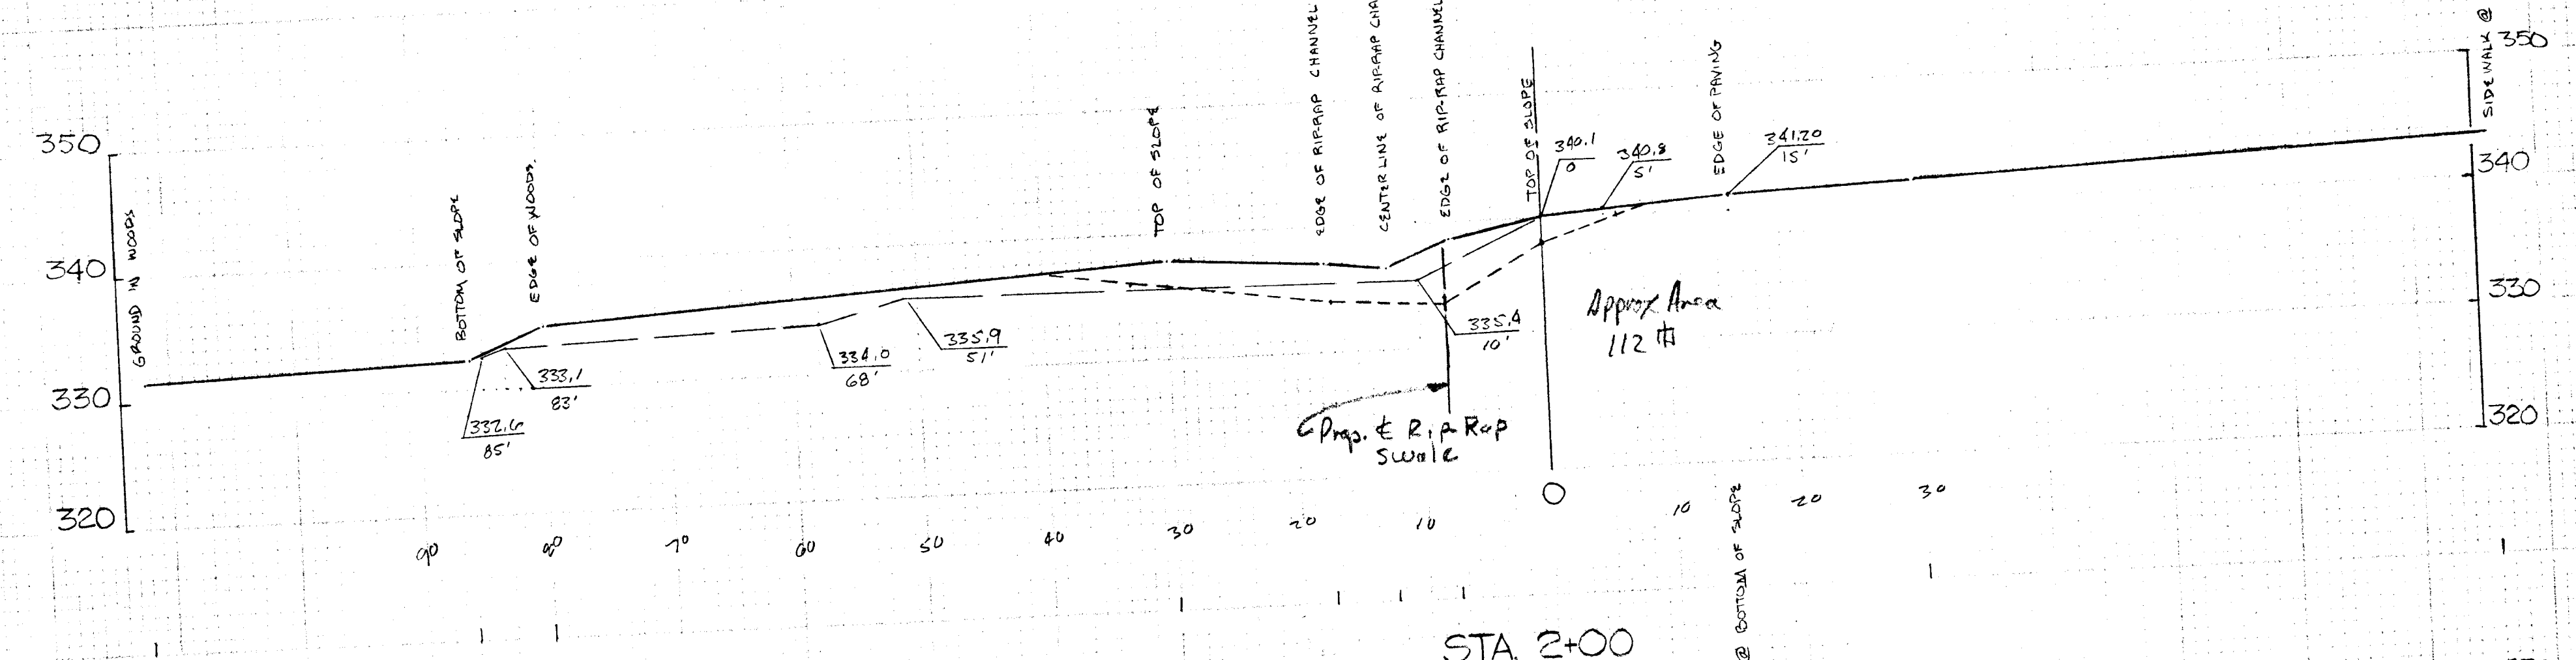

STA. 2+00

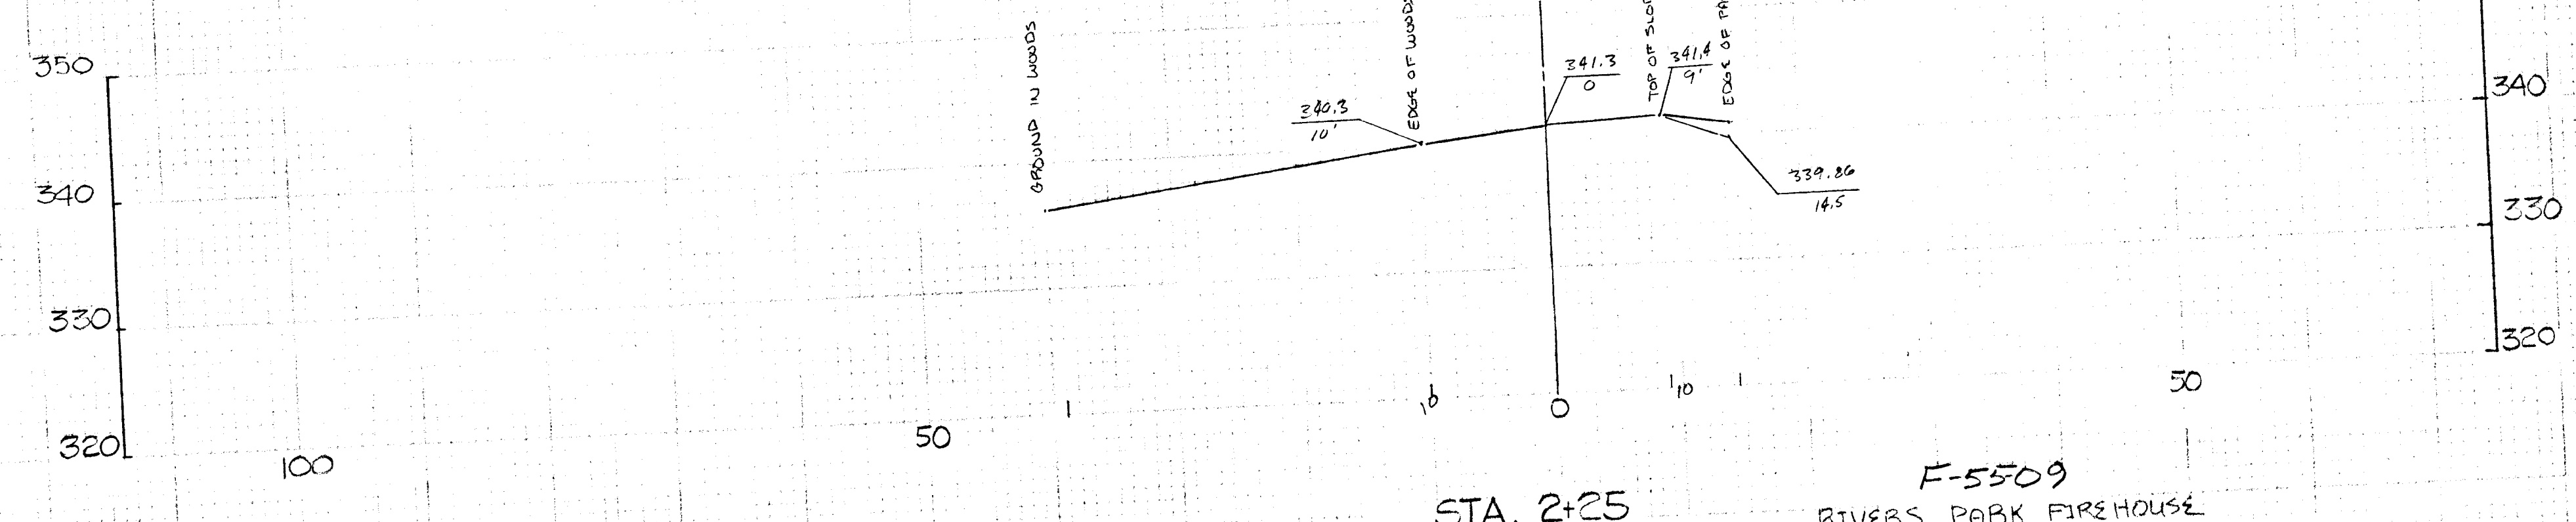

STA. 2+25

F-5509  
 RIVERS PARK FIREHOUSE  
 CROSS-SECTIONS OF  
 STORM WATER  
 MANAGEMENT POND  
 FIELD BOOK 105 PAGES 47-53  
 SCALE  
 V: 1"=10'  
 H: 1"=10'  
 SHEET 2 OF 2

12/19  
 OVERSIGHT  
 FILE