OLD LANTERN WAY
EXTENSION TO WHISKEY BOTTOM ROAD

WHISKEY BOTTOM APARTMENTS

6TH. ELECTION DISTRICT, HOWARD COUNTY, MARYLAND

SCALE : AS SHOWN
DATE : JUNE 18, 1973
REVISED: JULY 25, 1973
REVISED: SEPT. 11, 1973

DEPARTMENT OF PUBLIC WORKS	
S. R. Weiss	9/19/73
CHIEF, BUREAU OF HIGHWAYS	DATE
OFFICE OF PLANNING AND ZONING	
J. H. Clawson	9/19/73
CHIEF, DIVISION OF LAND DEVELOPMENT & TRANSPORTATION PLANNING	DATE

NOTES:
1. INCREASE WIDTH TO 30' AT ENTRANCE, AS SHOWN.
2. DESIGN SPEED = 25 M.P.H.
3. CONSTRUCTION SHALL BE IN STRICT ACCORDANCE WITH THE "ROAD CONSTRUCTION CODE AND STANDARD SPECIFICATIONS OF HOWARD COUNTY" INCLUDING ALL ERRATA AND ADDENDA THERETO.

APPROVED
DIVISION OF LAND DEVELOPMENT AND TRANSPORTATION PLANNING
HOWARD COUNTY, MARYLAND
DATE 8/28/73

STATE OF MARYLAND — LAWRENCE F. [illegible] — No. 5551 — REGISTERED PROFESSIONAL ENGINEER

Owner - Developer
WHISKEY BOTTOM, SECTION FOUR
A Limited Partnership
1720 Wisconsin Avenue N.W.
Washington, D.C. 20007

IPDS — 850 ELKIN AVENUE, SUITE 301, SILVER SPRING, MARYLAND 20910, TELEPHONE (301) 585-3447
the interprofessional PLANNING & DESIGN STUDIO LTD.

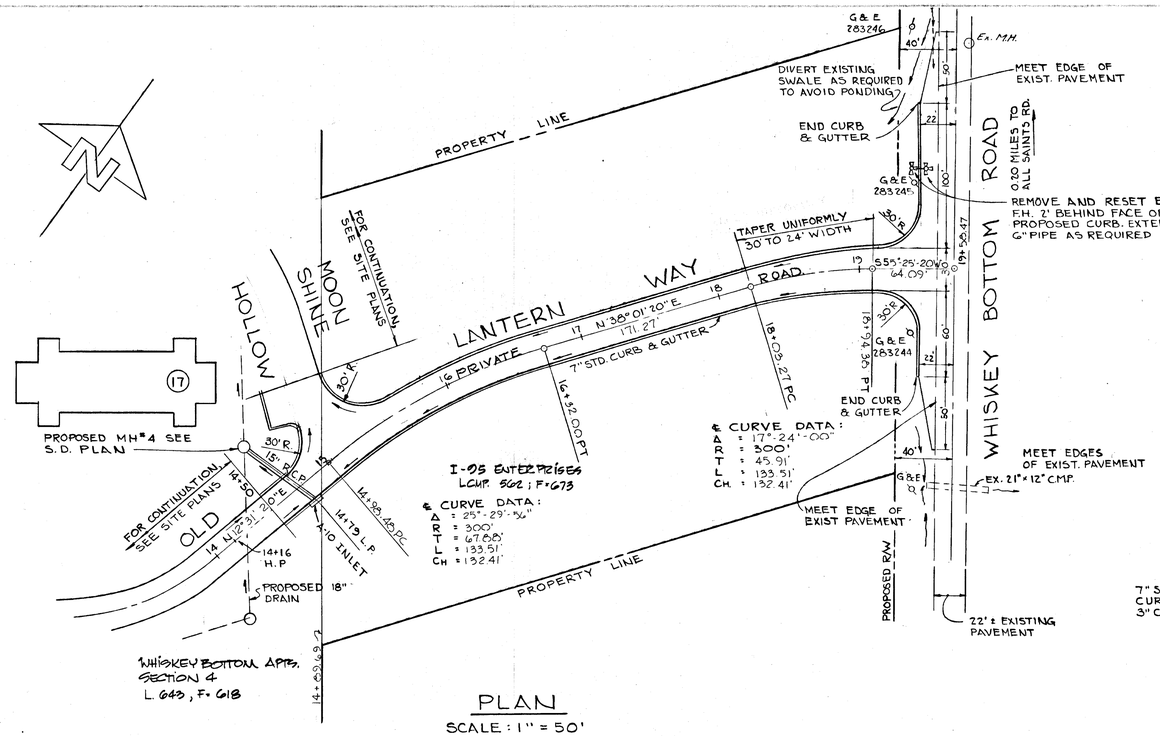

PLAN
SCALE : 1" = 50'

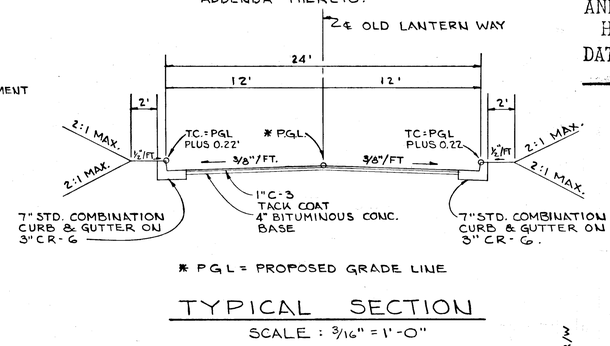

℄ PGL = PROPOSED GRADE LINE

TYPICAL SECTION
SCALE : 3/16" = 1'-0"

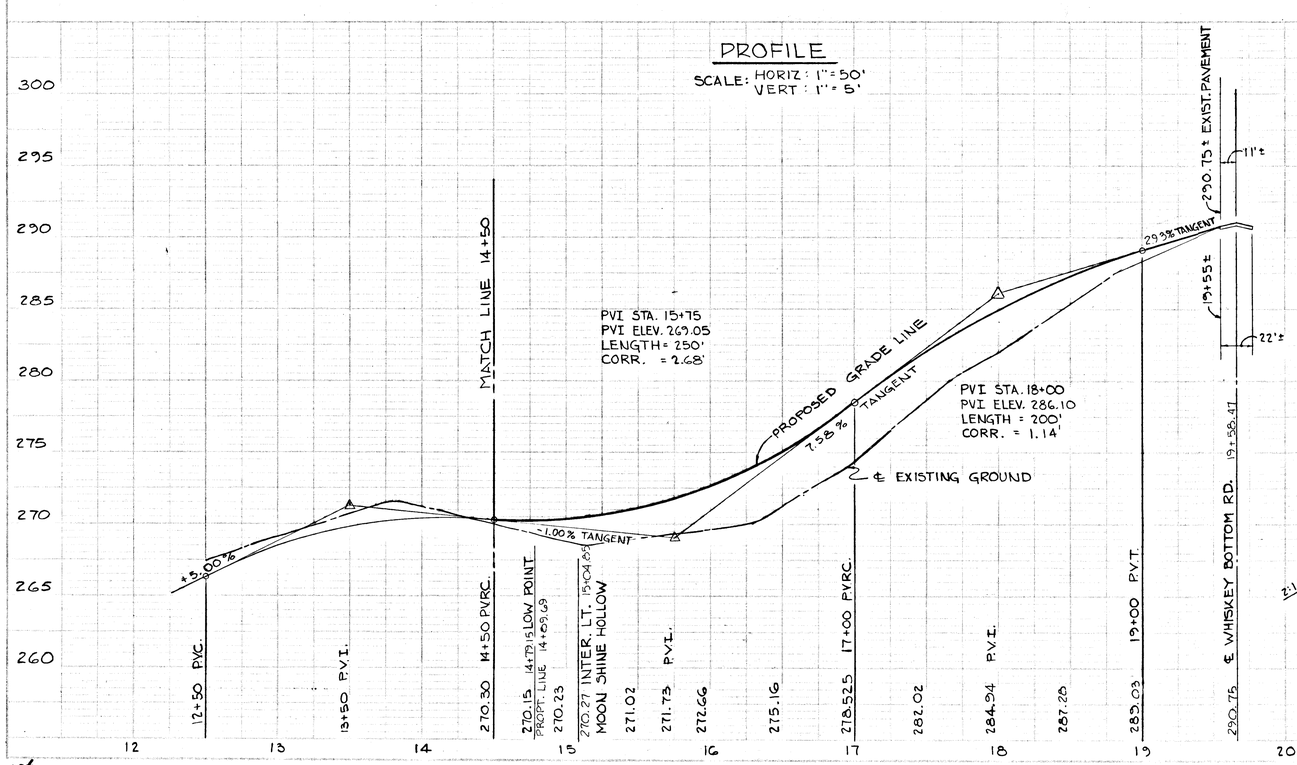

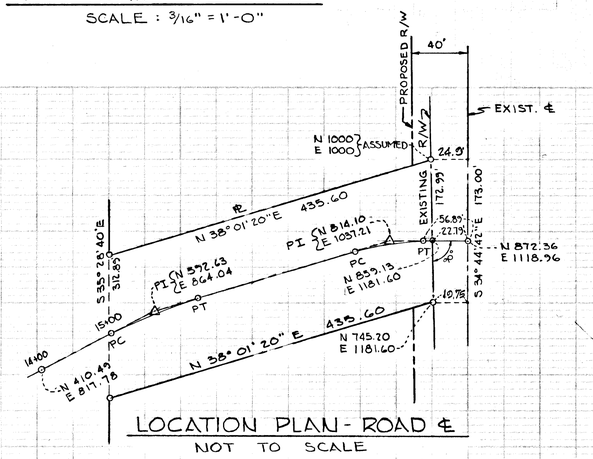

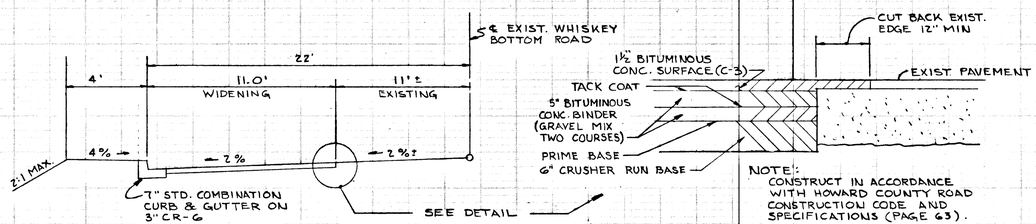

NOTE: CONSTRUCT IN ACCORDANCE WITH HOWARD COUNTY ROAD CONSTRUCTION CODE AND SPECIFICATIONS (PAGE 63).

SECTION — ROAD WIDENING
NOT TO SCALE

AS-BUILT 7-12-76

F-73-89