

PLANTING SPECIFICATIONS

Plants, related material, and operations shall meet the detailed description as given on the plans and as described herein. All plant material, unless otherwise specified, shall be nursery grown, uniformly branched, have a vigorous root system, and shall conform to the species, size, root and shape shown on the plan list and the American Association of Nurserymen (AAN) Standards. Plant material shall be healthy, vigorous, free from defects, decay, distortion, insect, mite, or other pest damage, insect pest eggs, borers and all forms of insect infestation or objectionable infestations. Plant material that is weak or which has been cut back from larger grades must meet specified requirements will be rejected. Trees with forked leaders will not be accepted. All plants shall be freshly dug; no heated-in plants from cold storage will be accepted. Unless otherwise specified, all general conditions, planting operations, details and planting specification shall conform to "Landscape Specification Guidelines for Baltimore-Washington Metropolitan Area", hereinafter "Landscape Guidelines" approved by the Landscape Contractors Association of Metropolitan Washington and the Potomac Chapter of the American Society of Landscape Architects, latest edition, including all updates. Contractor shall be required to guarantee all plant material for a period of one year after date of acceptance in accordance with the appropriate section of the Landscape Guidelines. Contractor's attention is directed to the maintenance requirements found within the one year specifications including watering and replacement of specified plant material. Contractor shall be responsible for notifying utility companies, utility contractors and "Miss Utility" a minimum of 48 hours prior to beginning any work. Contractor may make minor adjustments in spacing and location of plant material to avoid conflicts with utilities. Damage to existing structure and utilities shall be repaired at the expense of the Contractor. Protection of existing vegetation to remain shall be accomplished by the temporary installation of 4 foot high snow fence or blaze orange safety fence at the drip line. Contractor is responsible for installing all material in the proper planting season for each plant type. All planting is to be completed within the growing season of completion of site construction. Bid shall be based on actual site conditions. No extra payment shall be made for work arising from site conditions differing from those indicated on drawings and specifications. Plant quantities are provided for the convenience of the contractor only. If discrepancies exist between quantities shown on plan and those shown on the plant list, the quantities on the plant list take precedence. All shrubs shall be planted in continuous trenches or prepared planting beds and mulched with composted hardwood mulch as details and specified except where noted on plans. Positive drainage shall be maintained in planting beds 2 percent slope. Planting mix shall be as follows: Deciduous Plants - Two parts topsoil, one part well-rotted cow or horse manure, Add 3 lbs. of standard fertilizer per cubic yard of planting mix. Evergreen Plants - Two parts topsoil, one part humus or other approved organic material. Add 3 lbs. of evergreen (acidic) fertilizer per cubic yard of planting mix. Topsoil shall conform to the Landscape Guidelines. Weed Control - Incorporate a pre-emergent herbicide into the planting bed following recommended rates on the label. Caution: Be sure to carefully check the chemical used to assure its adaptability to the specific ground cover to be treated. All areas within contract limits disturbed during or prior to construction not designated to receive plants and mulch shall be fine graded and seeded. This plan is intended for landscape use only. See other plan sheets for more information on grading, sediment control, layout, etc.

SURETY AMOUNT FOR THIS PLAN IS IN THE AMOUNT OF \$16,950.00

- LANDSCAPE SURETY FOR LOTS 4,5,10,11,13,14 & 16 IS \$150,000 PER LOT.
- LANDSCAPE SURETY FOR LOT 15 IS \$120,000.
- LANDSCAPE SURETY FOR LOT 9 IS \$165,000, (4 SHADE TREES \$43,000.00 = \$172,000 PLUS 3 EVERGREEN TREES @ \$45,000.00 = \$150,000).
- STREET TREES ARE NOT INCLUDED IN MODIFIED SCHEDULE C LANDSCAPE CALCULATIONS.
- TYPE "B" BUFFER OR PERIMETER LANDSCAPE BUFFER WILL BE CREDITED TOWARDS THE LANDSCAPE REQUIREMENTS.
- LANDSCAPING CAN NOT BE PLANTED IN PUBLIC EASEMENTS.
- FINAL PLANTING TYPE AND LOCATION IS SUBJECT TO APPROVAL BY THE ARCHITECTURAL COMMITTEE.
- AT THE TIME OF INSTALLMENT, ALL SHRUBS AND OTHER PLANTING HEREWITH LISTED AND APPROVED FOR THIS SITE, SHALL BE OF THE PROPER HEIGHT REQUIREMENTS IN ACCORDANCE WITH HOWARD COUNTY LANDSCAPE MANUAL.
- THE OWNER, TENANT AND/OR THEIR AGENTS SHALL BE RESPONSIBLE FOR MAINTENANCE OF THE REQUIRED LANDSCAPING, PLANT MATERIALS, BENCHES AND WALLS. ALL PLANT MATERIALS SHALL BE MAINTAINED IN GOOD GROWING CONDITION AND WHEN NECESSARY, REPLACED WITH NEW MATERIALS TO ENSURE CONTINUED COMPLIANCE WITH APPLICABLE REGULATIONS. ALL OTHER REQUIRED LANDSCAPING SHALL BE PERMANENTLY MAINTAINED IN GOOD CONDITION AND WHEN NECESSARY, REPAIRED OR REPLACED.
- SIZES OF PLANT MATERIALS MUST CONFORM TO THE REQUIREMENTS OF THE LANDSCAPE MANUAL, CHAPTER IV AND APPENDIX C.

KEY PROPERTY DEVELOPMENT CRITERIA, APPROVED 7/1/99 SECTION VII RESIDENTIAL DEVELOPMENT INTERNAL LANDSCAPING

THE QUANTITY AND GENERAL LOCATION OF TREES REQUIRED FOR INTERNAL LANDSCAPING ARE DETERMINED BY CRITERIA APPLIED BY THE ARCHITECTURAL COMMITTEE. THE COMMITTEE WILL CLASSIFY, DURING ARCHITECTURAL REVIEW, ALL LOTS AND PARCELS AS D) NON-WOODED; 2) SEMI-WOODED; 3) WOODED. SUCH CLASSIFICATION SHALL TAKE INTO ACCOUNT THE EXISTING TREE COVER AND THE POTENTIAL FOR SAVING TREES IN CONNECTION WITH GRADING AND SITING. THIS CRITERIA ALSO CONSIDER THE SIZE OF THE LOT, AMOUNT OF EXISTING VEGETATION AND THE TYPE AND SITING OF RESIDENTIAL UNITS. IF, DURING OR AFTER CONSTRUCTION, THE COMMITTEE DETERMINES THAT A BUILDER HAS VIOLATED ANY PROVISION OF TREE PRESERVATION, THE BUILDER WILL BE REQUIRED TO ADD NEW PLANT MATERIAL. SHADE TREE REQUIREMENTS ARE SPECIFIED BY THE FOLLOWING TABLE DENSITIES REFER TO THE DENSITY OF THE INDIVIDUAL PARCEL.







SHADE TREE REQUIREMENTS

TYPE OF UNIT AND LOT SIZE	MINIMUM NUMBER OF SHADE TREES REQUIRED		
	NON WOODED	SEMI WOODED	WOODED
SMALL RESIDENTIAL LOT (4,000-7,000 SQUARE FEET) CLUSTER HOUSING	4.0/Lot	2.25/Lot	1.25/Lot
MEDIUM RESIDENTIAL LOT (7,000-13,000 SQUARE FEET) 2-4 BULLAGE	5.0/Lot	3.0/Lot	2.0/Lot

SUBSTITUTION OF TWO FLOWERING TREES OR TWO EVERGREEN TREES FOR EACH SHADE TREE MAY BE PERMITTED FOR UP TO 50% OF THE REQUIRED NUMBER OF SHADE TREES SHOWN IN THE TABLE SUBJECT TO THE APPROVAL OF THE ARCHITECTURAL COMMITTEE. CREDIT MAY ALSO BE GIVEN FOR ANY AREAS REQUIRED TO BE PROVIDED ALONG ROADWAYS, SUBJECT TO THE APPROVAL OF THE ARCHITECTURAL COMMITTEE.

ADDRESS CHART

LOT NUMBER	STREET ADDRESS
9	9604 BOUNDLESS SHADE TERRACE
12	9632 BOUNDLESS SHADE TERRACE
13	9635 BOUNDLESS SHADE TERRACE
14	9631 BOUNDLESS SHADE TERRACE
15	9627 BOUNDLESS SHADE TERRACE
16	9623 BOUNDLESS SHADE TERRACE

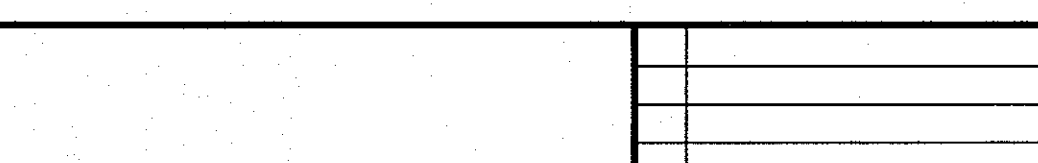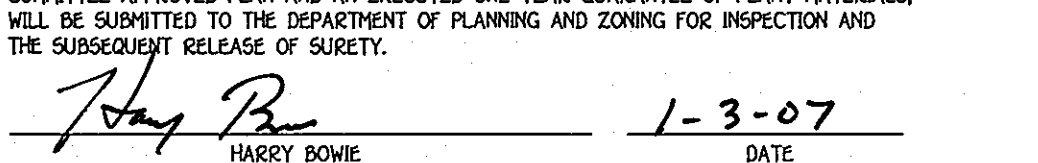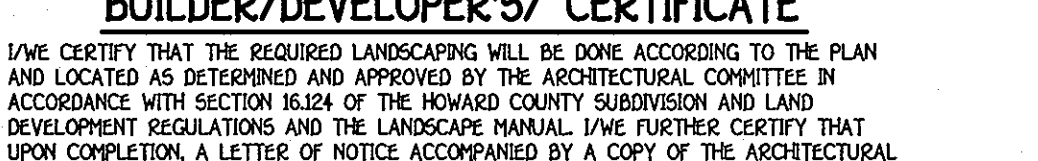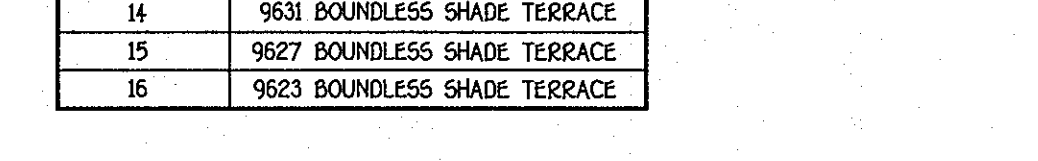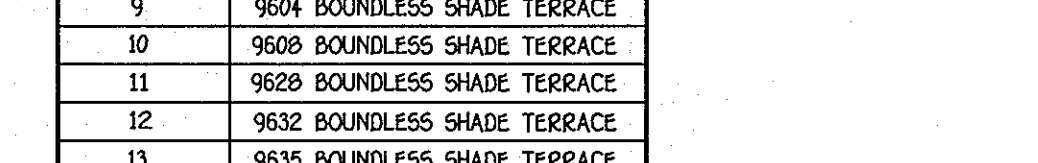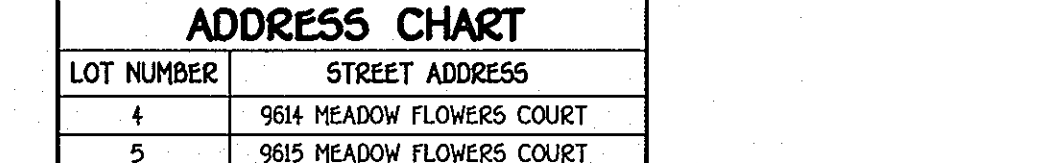


BUILDER/DEVELOPER'S CERTIFICATE

I/WE FURTHER CERTIFY THAT UPON COMPLETION, A LETTER OF NOTICE ACCOMPANIED BY A COPY OF THE ARCHITECTURAL COMMITTEE APPROVED PLAN AND AN EXECUTED LETTER OF GUARANTEE OF PLANT MATERIALS, WILL BE SUBMITTED TO THE DEPARTMENT OF PLANNING AND ZONING FOR INSPECTION AND THE SUBSEQUENT RELEASE OF SURETY.


Harry Bowie
HARRY BOWIE
1-3-07
DATE

FISHER, COLLINS & CARTER, INC.
CIVIL ENGINEERING CONSULTANTS & LAND SURVEYORS
CENTRAL SQUARE OFFICE PARK - 10722 BALTIMORE NATIONAL PIKE
ELKLOTT CITY, MARYLAND 21042
(410) 461-2292








NO.	REVISION	DATE

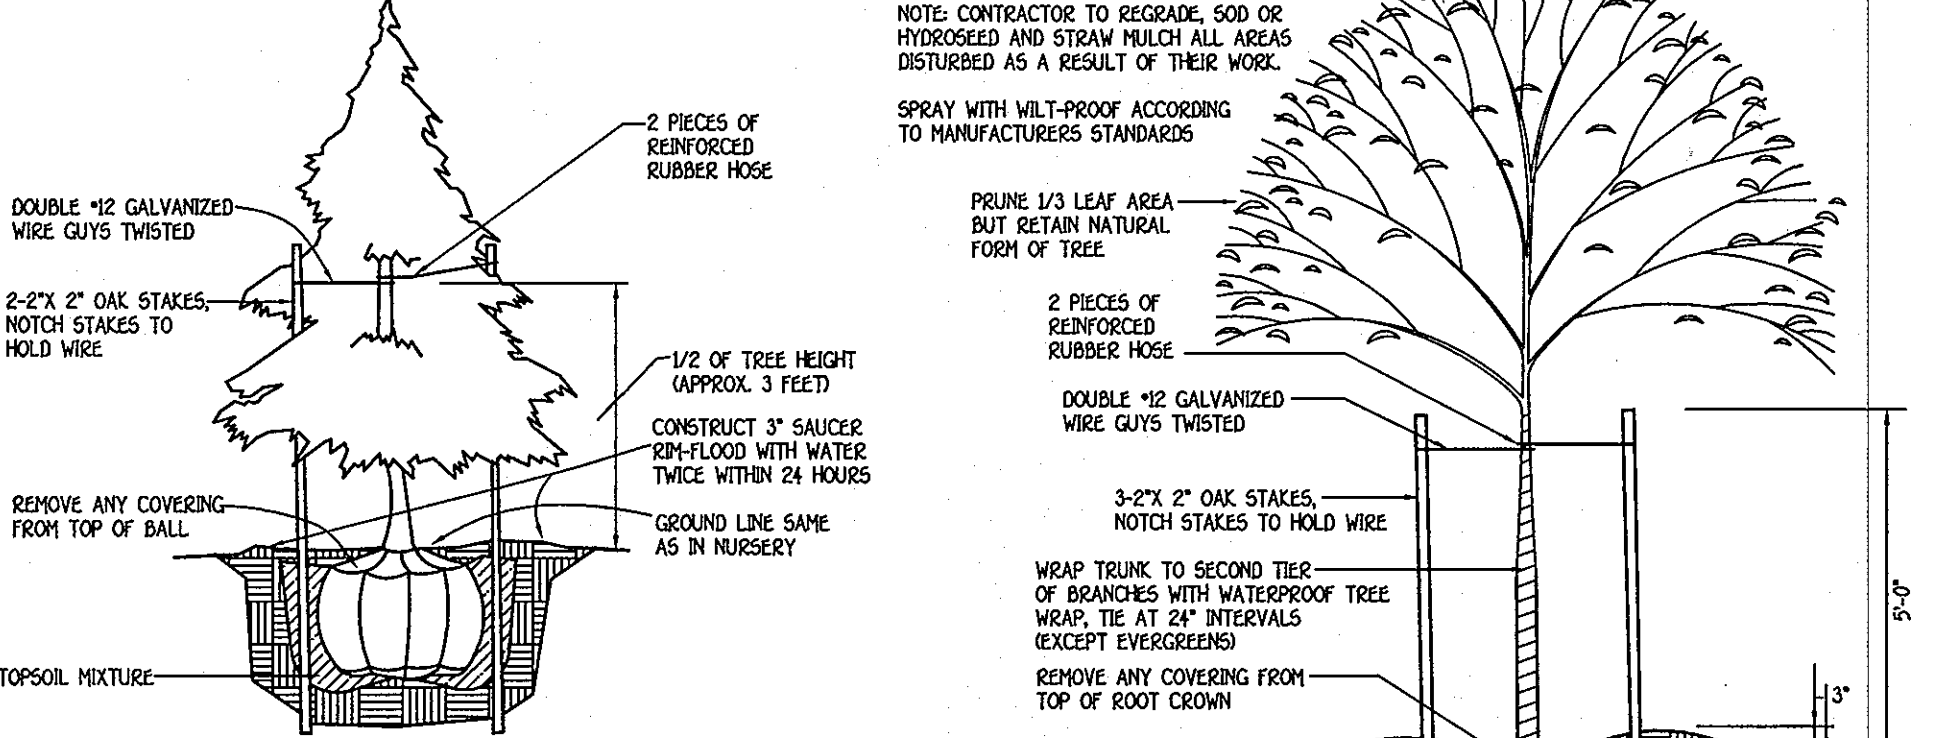

EVERGREEN PLANTING DETAIL
NOT TO SCALE

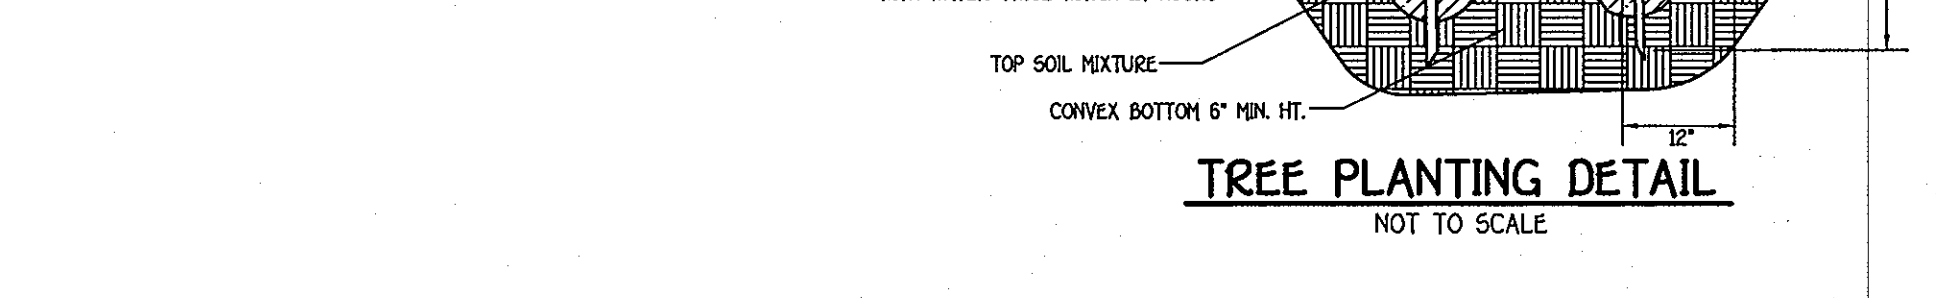

TREE PLANTING DETAIL
NOT TO SCALE

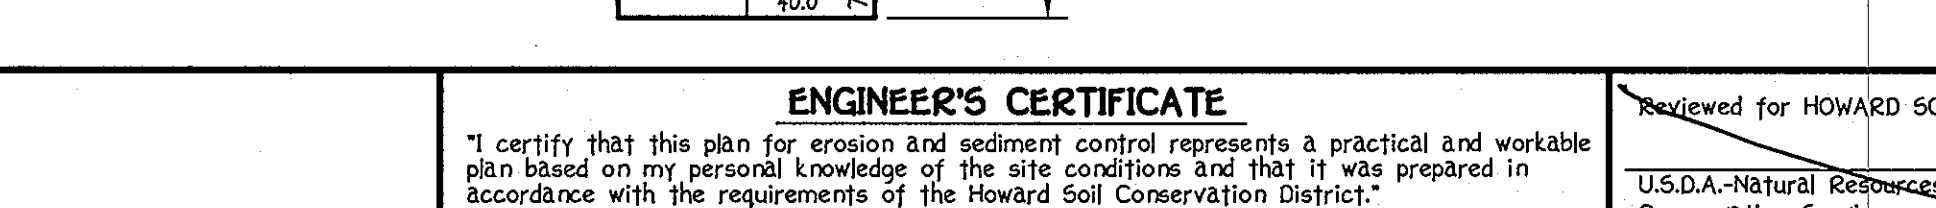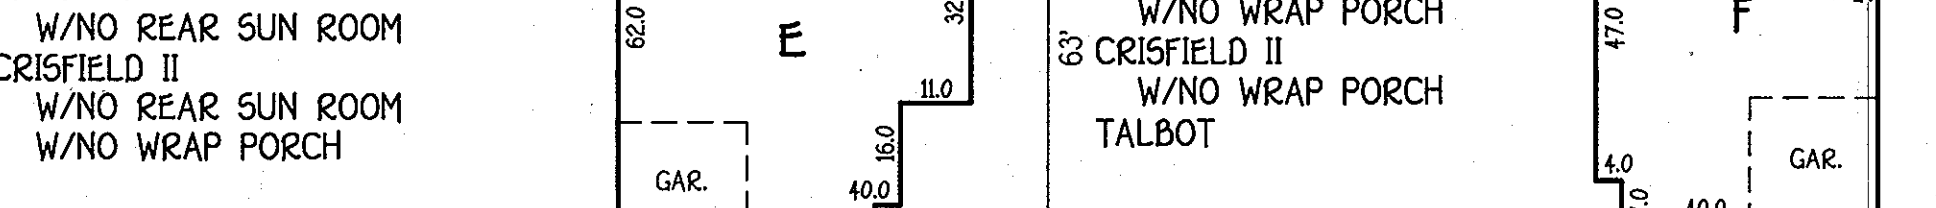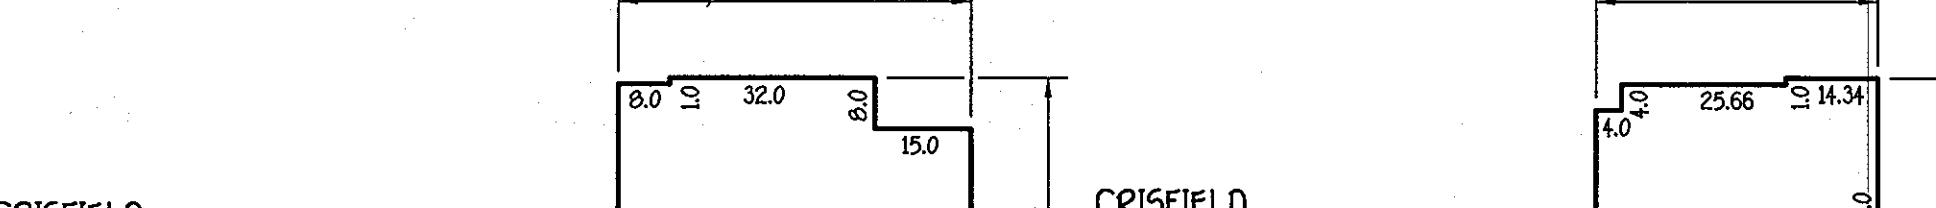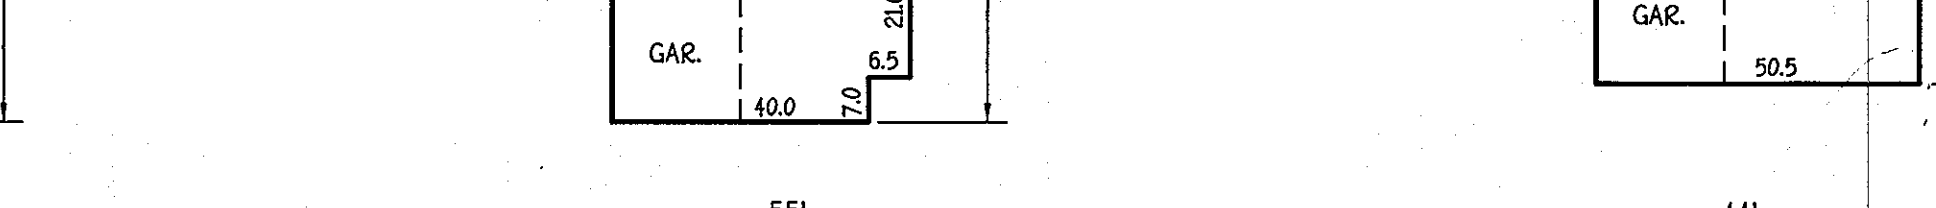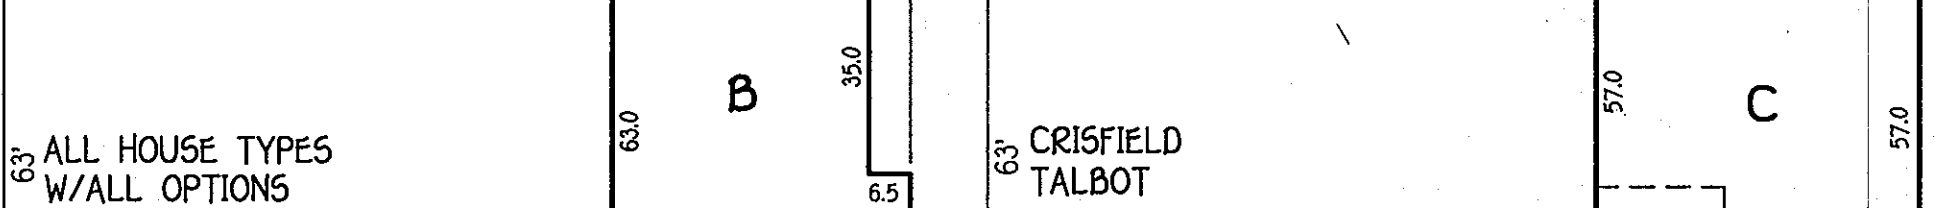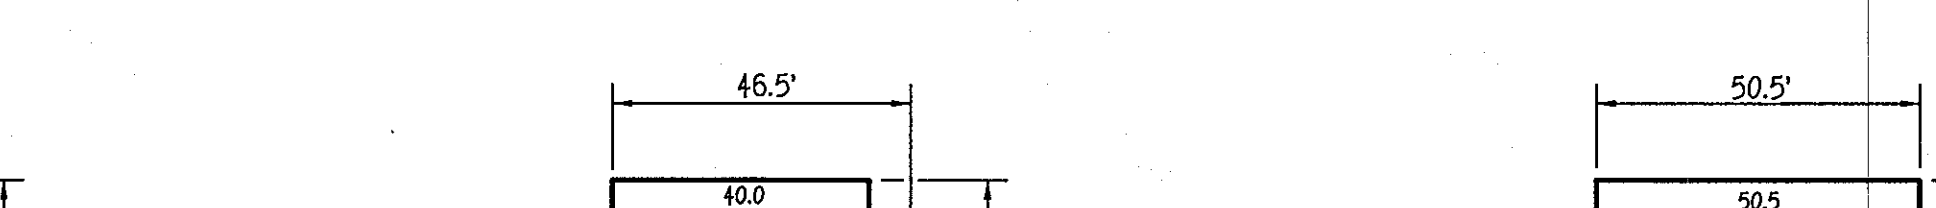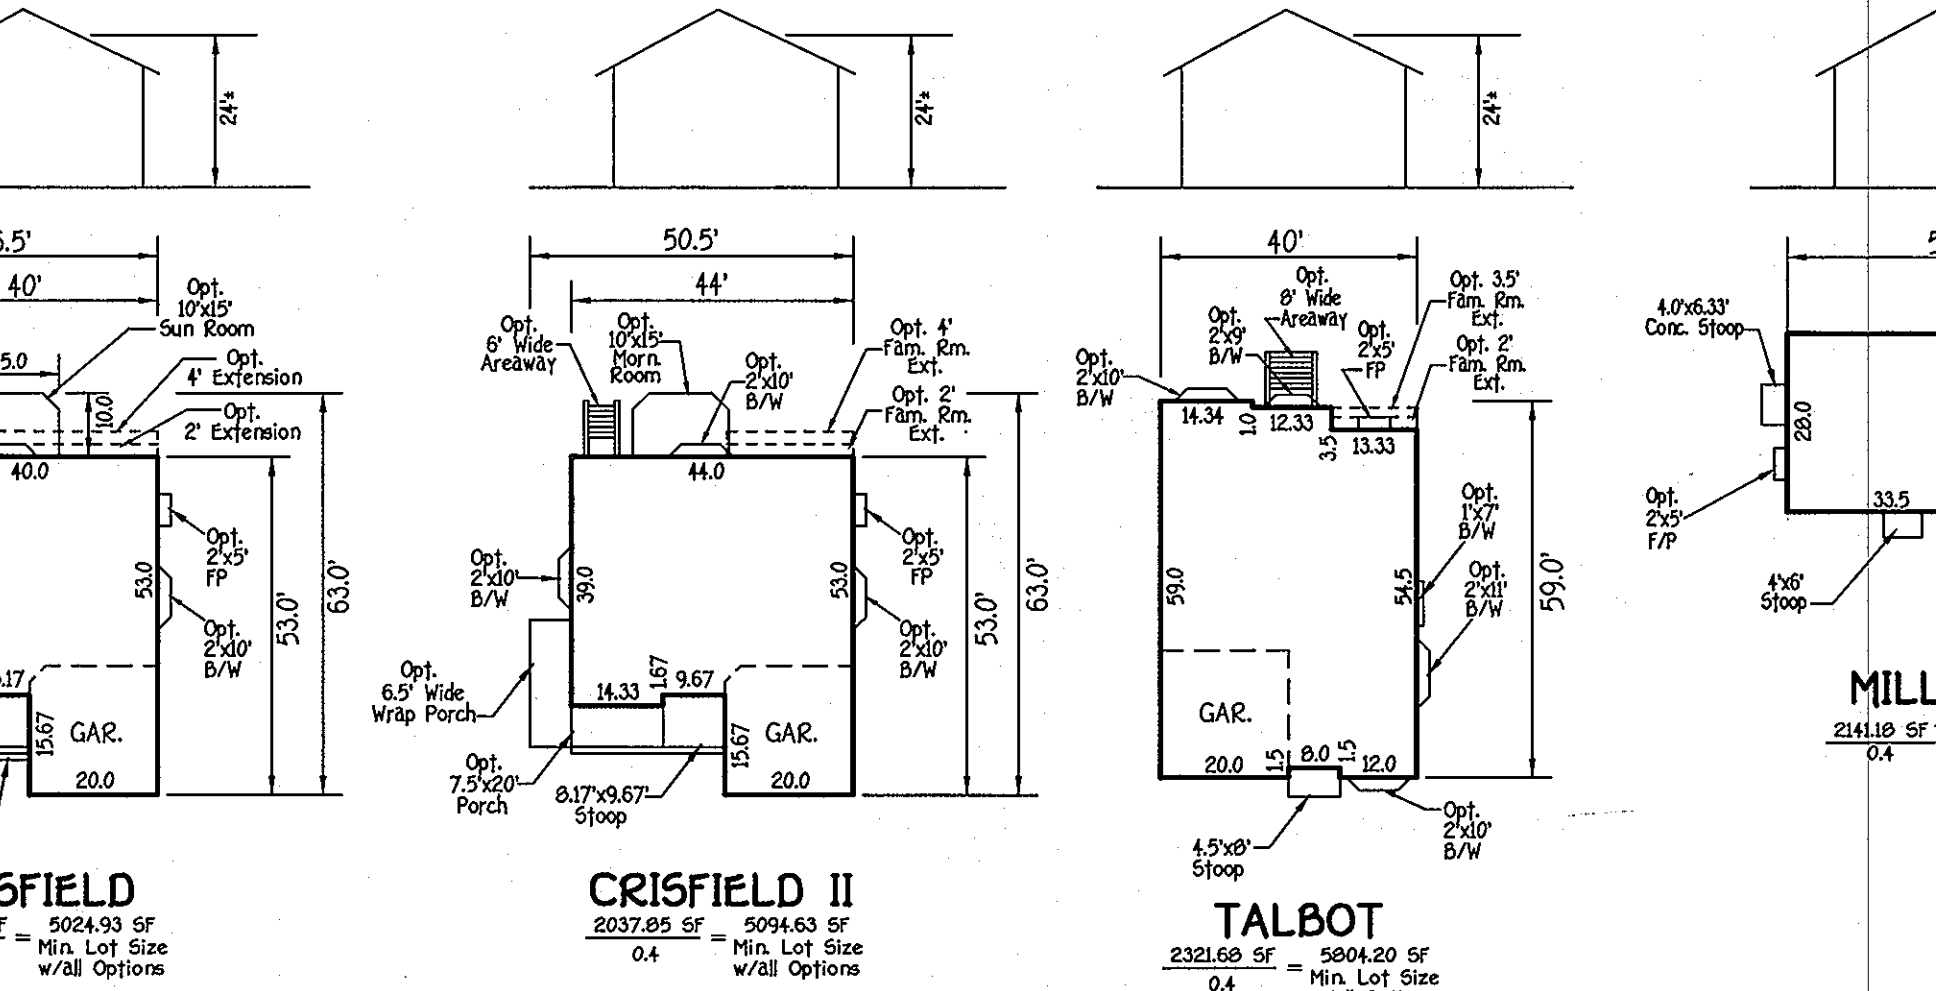

ENGINEER'S CERTIFICATE

I certify that this plan for erosion and sediment control represents a practical and workable plan based on my personal knowledge of the site conditions and that it was prepared in accordance with the requirements of the Howard Soil Conservation District.

Earl D. Collins
Earl D. Collins
1-3-07
Date

BUILDER/DEVELOPER'S CERTIFICATE

I/We certify that all development and construction will be done according to this plan, for sediment and erosion control and that any responsible personnel involved in the construction project will have a Certificate of Attendance at a Department of the Environment Approved Training Program for the Control of Sediment and Erosion before beginning the project. I also authorize periodic on-site inspection by the Howard Soil Conservation District.

Harry Bowie
HARRY BOWIE
1-3-07
Date

OWNER
THE HOWARD RESEARCH & DEVELOPMENT CORP.
10275 LITTLE PATUXENT PARKWAY
COLUMBIA, MARYLAND 21044
410-992-6000

BUILDER/DEVELOPER
NIJ-HOMES
10630 LITTLE PATUXENT PARKWAY
COLUMBIA, MARYLAND 21044
410-730-2100

MODIFIED SCHEDULE C LANDSCAPE CHART


SMALL LOTS 4,000 SF. THRU 7,000 SF.	MEDIUM LOTS 7,000 SF. THRU 15,000 SF.	LOT CLASSIFICATION	INTERNAL LANDSCAPING REQUIRED (# OF SHADE TREES)	TYPE B REQUIRED		SHADE TREE CREDIT *	REMAINING SHADE TREE OBLIGATION	TOTAL TREES REQUIRED	
				SHADE	EVERGREEN			SHADE	EVERGREEN
LOTS 4,5,10,11,13,14 & 16	NON-WOODED	5 TREES PER LOT	N/A	N/A	0	5	40	0	
LOT 15	NON-WOODED	4 TREES	N/A	N/A	0	4	4	0	
LOT 9 CORNER LOT	NON-WOODED	5 TREES	2	3	3	2	4	3	
TOTAL TREES								48	3

* THIS NUMBER REFLECTS THE MATHEMATICAL CONVERSION OF EVERGREEN TREES TO SHADE TREES (2:1) FOR THE PURPOSE OF MEETING THE INTERNAL PER LOT SHADE TREE OBLIGATION.

SCHEDULE A PERIMETER LANDSCAPE EDGE




LOT NO.	PERIMETER	CATEGORY (PROPERTIES/ROADWAYS)	LANDSCAPE TYPE	LINEAR FEET OF ROADWAY FRONTAGE PERIMETER	LINEAR FEET OF CREDIT	SHADE TREES	EVERGREEN TREES	TOTAL TREES
* 9 CORNER	P-1	ADJACENT TO ROADWAY	B	113'	0	2	3	5
11 & 12	P-2	ADJACENT TO PROPERTY	A	115'	115'	0	0	0
12 & 13	P-3	ADJACENT TO PROPERTY	A	218'	0	4	0	4
4 & 5	P-4	ADJACENT TO PROPERTY	A	135'	0	3	0	3

* TYPE "B" BUFFER WILL BE CREDITED TOWARDS THE INTERNAL LOT LANDSCAPE REQUIREMENTS.

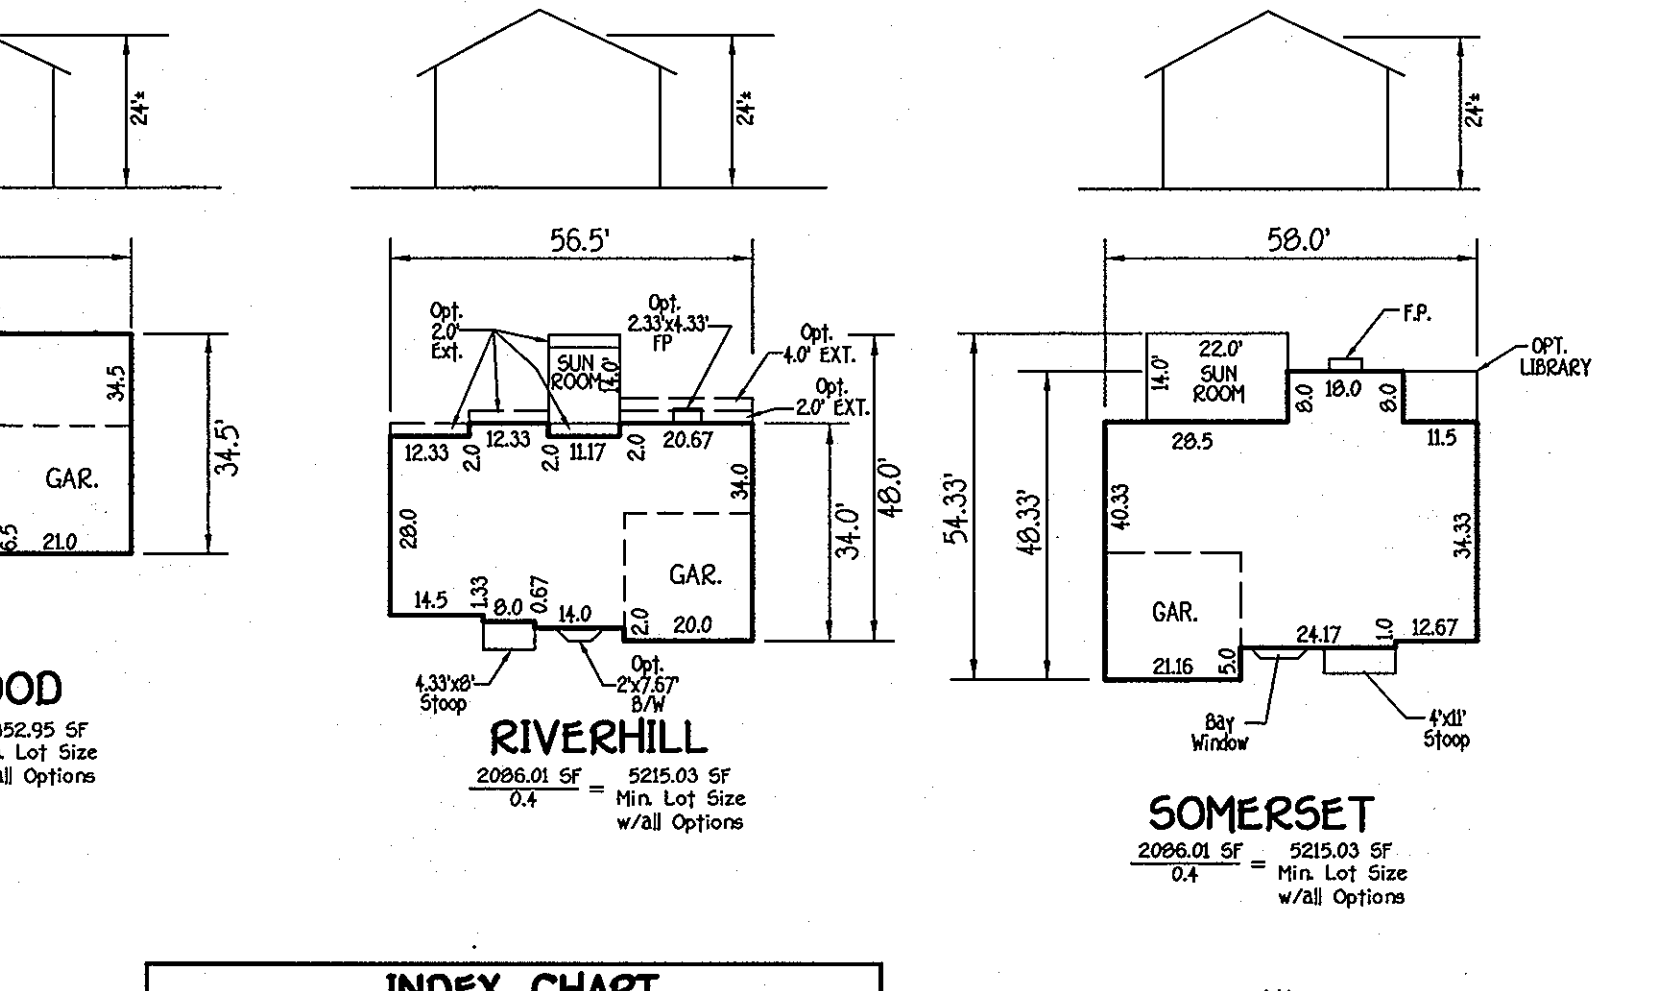

INDEX CHART

SHEET	DESCRIPTION
SHEET 1	TITLE SHEET, HOUSE TYPES, TEMPLATES
SHEET 2	SITE DEVELOPMENT PLAN, LOTS 4,5 & 9 THRU 16
SHEET 3	SEDIMENT/EROSION CONTROL PLAN LOTS 4,5 & 9 THRU 16
SHEET 4	SEDIMENT/EROSION CONTROL NOTES & DETAILS

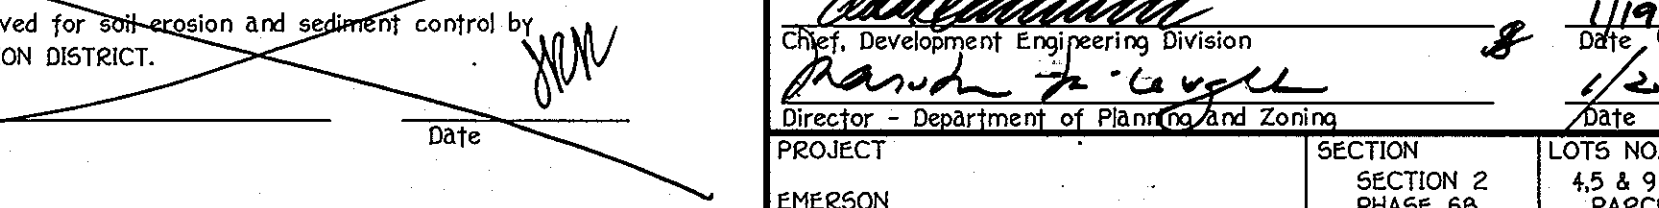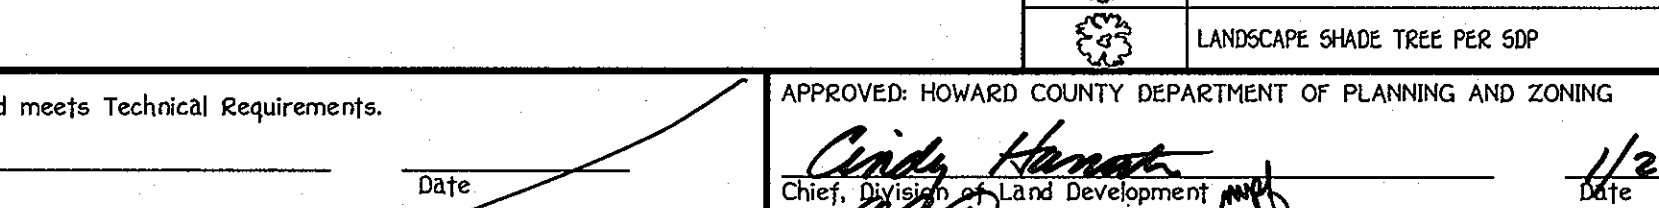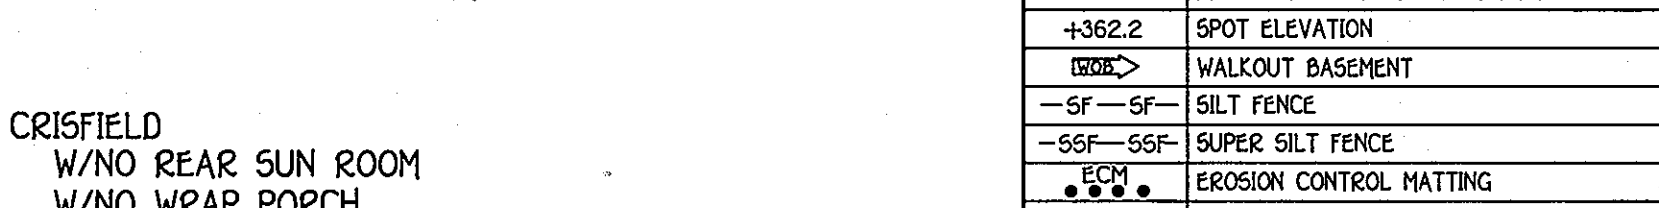

ENGINEER'S CERTIFICATE

Reviewed for HOWARD SCD and meets Technical Requirements.

U.S.D.A.-Natural Resources Conservation Service
This development plan is approved for soil erosion and sediment control by the HOWARD SOIL CONSERVATION DISTRICT.

Cindy Hamant
Cindy Hamant
1/22/07
Date

Matthew
Matthew
1/19/07
Date

Harvey
Harvey
1/23/07
Date

HOWARD SCD
Date


OWNER
THE HOWARD RESEARCH & DEVELOPMENT CORP.
10275 LITTLE PATUXENT PARKWAY
COLUMBIA, MARYLAND 21044
410-992-6000

BUILDER/DEVELOPER
NIJ-HOMES
10630 LITTLE PATUXENT PARKWAY
COLUMBIA, MARYLAND 21044
410-730-2100

BENCH MARKS

T.P. 47EA ELEV. 208.430
N. 535,063.639
E. 1357,284.000
LOC. NEAR INTERSECTION OF GORMAN RD. & STEPHENS RD.

T.P. 47HA ELEV. 292.309
N. 531,046.905
E. 1356,987.631

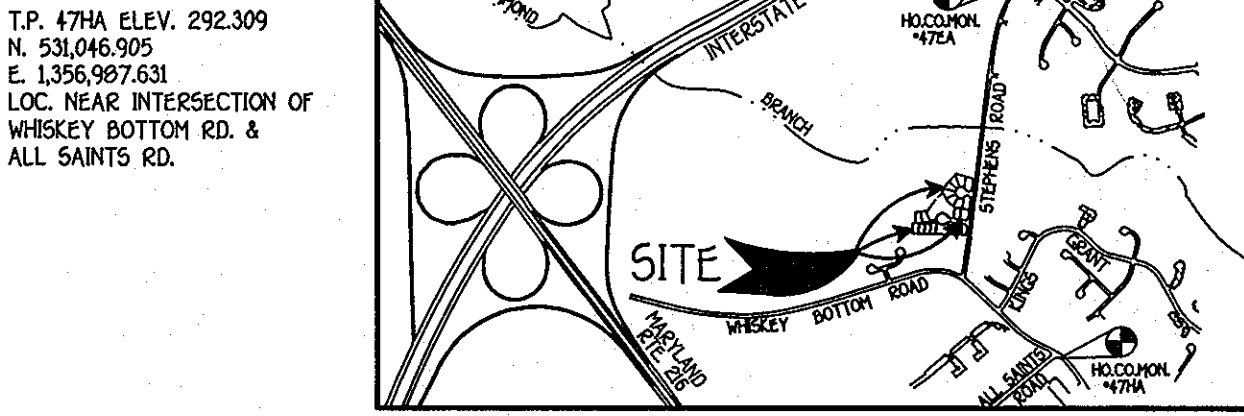

VICINITY MAP
SCALE: 1" = 2000'

GENERAL NOTES

- SUBJECT PROPERTY ZONED PEC-MXD-3 AS GRANTED BY THE ZONING BOARD ON 9/3/98 AS CASE NO. ZB97991.
- TOTAL AREA OF SITE 1.927 ACRES.
- TOTAL NUMBER OF LOTS SUBMITTED: 10 S/D
- THE CONTRACTOR SHALL NOTIFY THE DEPARTMENT OF PUBLIC WORKS/BUREAU OF ENGINEERING/CONSTRUCTION INSPECTION DIVISION AT (410)33-1880 AT LEAST FIVE (5) WORKING DAYS PRIOR TO THE START OF WORK.
- THE CONTRACTOR SHALL NOTIFY "MISS UTILITY" AT 1-800-257-7777 AT LEAST 48 HOURS PRIOR TO ANY EXCAVATION WORK.
- THIS PROJECT IS SUBJECT TO HOWARD COUNTY FILES: ZB-979M, P-04-14, F-05-09, 5-99-12, PB-39, PB-39S, WBS CONT. 124-423D-1.
- THE EXISTING TOPOGRAPHY IS TAKEN FROM FIELD RUN SURVEY WITH 2 FOOT CONTOUR INTERVALS PREPARED BY DAIT, MCNEIL, WALKER, INC., JUNE, 2000.
- HORIZONTAL AND VERTICAL CONTROL DATUM IS BASED ON NAD 83, MARYLAND COORDINATE SYSTEM AS PROJECTED BY HOWARD COUNTY GEODETIC CONTROL STATIONS. HOWARD COUNTY MONUMENT 47EA N 535046.905 E 1356772333 HOWARD COUNTY MONUMENT 47HA N 531046.905 E 1356987.631
- ANY DAMAGE TO THE COUNTY'S RIGHT-OF-WAY SHALL BE CORRECTED AT THE DEVELOPER'S EXPENSE.
- THIS PLAN IS FOR HOUSE SITING AND GRADING ONLY. IMPROVEMENTS WITHIN THE RIGHTS-OF-WAY OF THIS S.D.P. ARE NOT USED FOR CONSTRUCTION. FOR CONSTRUCTION SEE APPROVED ROAD CONSTRUCTION PLANS F-05-09. AND/OR APPROVED WATER AND SEWER PLANS CONSTRUCTION NO. 24-423D-1.
- CONTRACTOR WILL CHECK SEWER HOUSE CONNECTION ELEVATION AT EASEMENT LINE PRIOR TO CONSTRUCTION.
- STORMWATER MANAGEMENT (SWM) FOR THIS PROJECT WILL BE PROVIDED BY A STORMWATER MANAGEMENT POCKET POND TO BE JOINTLY MAINTAINED BY HOMEOWNERS ASSOCIATION AND HOWARD COUNTY AS SHOWN ON THE ROAD CONSTRUCTION DRAWINGS FILED UNDER F-05-09.
- INTERNAL LOT LANDSCAPING SHALL BE PROVIDED IN ACCORDANCE WITH THE DEVELOPMENT CRITERIA APPROVED BY THE PLANNING BOARD 7-1-99 PER CASE NO. PB-339 AND SECTION 16.24 OF THE HOWARD COUNTY CODE AND LANDSCAPE MANUAL. SURETY FOR THE REQUIRED LANDSCAPING HAS BEEN POSTED AS PART OF THE BUILDER'S GRADING PERMIT IN THE AMOUNT OF \$16,950.00 FOR 48 SHADE TREES @ \$300.00 EACH = \$14,400.00 AND 3 EVERGREEN TREES @ \$150.00 EACH = \$450.00.
- PERIMETER LANDSCAPING AND STREET TREES SHALL BE PROVIDED IN ACCORDANCE WITH SECTION 16.24 OF THE HOWARD COUNTY CODE AND THE LANDSCAPE MANUAL AND DEVELOPMENT CRITERIA APPROVED BY THE PLANNING BOARD 7-1-99 PER CASE NO. PB-339. THE NUMBER OF REQUIRED TREES AND AMOUNT OF SURETY FOR THE REQUIRED PERIMETER LANDSCAPING (P-3 & P-4) FOR WHICH INTERNAL LOT LANDSCAPING CREDIT IS NOT TAKEN, (7 SEVEN SHADE TREES @ \$300.00 EACH = \$2,100.00 AS SHOWN ON THE APPROVED ROAD CONSTRUCTION DRAWINGS FILED UNDER F-05-09).
- FOREST CONSERVATION REQUIREMENTS HAVE BEEN CODED WITH F-05-09.
- FOR DRIVEWAY ENTRANCE DETAILS REFER TO HO. CODES MANUAL VOL. IV DETAILS R.6.03 & R.6.05.
- OPEN SPACE REQUIREMENTS FOR THESE LOTS HAS BEEN PROVIDED UNDER F-05-09.
- MINIMUM BUILDING RESTRICTION SETBACKS FROM PROPERTY LINES AND PUBLIC ROAD RIGHTS-OF-WAY ARE TO BE IN ACCORDANCE WITH THE DEVELOPMENT CRITERIA APPROVED WITH THE COMPREHENSIVE SKETCH PLAN 5-99-12 AND THE DECISION AND ORDER FOR PB-339 APPROVED ON JULY 1, 1999.
- THE MINIMUM SETBACKS FOR STRUCTURES SHALL BE AS FOLLOWS:
FRONT SETBACK: 15' FROM THE RIGHT-OF-WAY TO THE HOUSE OR GARAGE.
SIDE SETBACK: 5' TO THE PROPERTY LINE WITH A MINIMUM OF 15' BETWEEN STRUCTURES.
REAR SETBACK: 10' FROM THE PROPERTY LINE TO AN OPEN DECK.
20' FROM THE PROPERTY LINE TO THE HOUSE.


ANY DEVIATION FROM THESE SETBACK REQUIREMENTS WILL REQUIRE SITE DEVELOPMENT PLAN APPROVAL BY THE HOWARD COUNTY PLANNING BOARD.

20. LOT COVERAGE BY BUILDINGS WITHIN SINGLE FAMILY DETACHED LAND USE AREAS SHALL NOT EXCEED 40%. NO LIMITATION IS IMPOSED UPON THE AREA USED FOR SIDEWALKS, PAVED PARKING AREAS, PATIOS, DECKS, LANDSCAPING AND SIMILAR MINOR STRUCTURE.

21. THIS PLAN IS SUBJECT TO THE AMENDED 5TH EDITION OF THE SUBDIVISION AND LAND DEVELOPMENT REGULATIONS PER COUNCIL BILL NO. 45-2003 AND THE ZONING REGULATIONS AS AMENDED UNDER COUNCIL BILL NO. 75-2003. DEVELOPMENT OR CONSTRUCTION ON THESE LOTS MUST COMPLY WITH SETBACK AND BUFFER REGULATIONS IN EFFECT AT THE TIME OF SUBMISSION OF THE SITE DEVELOPMENT PLAN. WAIVER PETITION APPLICATION OR BUILDING/GRADING PERMIT IN ACCORDANCE WITH SECTION 12.9 OF THE HOWARD COUNTY ZONING REGULATIONS. BAY WINDOWS, CHIMNEYS OR EXTERIOR STAIRWAYS NOT MORE THAN 16' FEET IN WIDTH MAY PROJECT NOT MORE THAN 4 FEET INTO ANY SETBACKS, PORCHES OR DECKS OPEN OR ENCLOSED MAY PROJECT NOT MORE THAN 10 FEET INTO THE FRONT OR REAR YARD SETBACKS. THE 15' MINIMUM DISTANCE BETWEEN STRUCTURES DOES NOT APPLY TO THOSE REFERENCED FEATURES NOR BETWEEN OPEN DECKS AND A DWELLING STRUCTURE OR ANOTHER DECK. AS AN ADVISORY, THE 15' DISTANCE DOES APPLY TO THE SECOND STORY OVERHANG.

23. DRIVEWAYS SHALL BE PROVIDED PRIOR TO ISSUANCE OF A USE AND OCCUPANCY PERMIT FOR ANY NEW DWELLINGS TO INSURE SAFE ACCESS FOR FIRE AND EMERGENCY VEHICLES PER THE FOLLOWING (MINIMUM) REQUIREMENTS:
A) WIDTH - 12' (14' IF SERVING MORE THAN ONE RESIDENCE)
B) SURFACE - 6" OF COMPACTED CRUSHER RUN BASE W/TAR AND CHIP COATING (1-1/2" MIN) TURNING RADIUS.
C) GEOMETRY MAXIMUM 15% GRADE, MAXIMUM 10% GRADE CHANGE AND 45 FOOT TURNING RADIUS.
D) STRUCTURES - (BRIDGES/CULVERTS) CAPABLE OF SUPPORTING 25 GROSS TONS (25-TONS LOADING)
E) DRAINAGE ELEMENTS CAPABLE OF SAFETY PASSING 100 YEAR FLOOD WITH NO MORE THAN 1 FOOT DEPTH OVER DRIVEWAY SURFACE.
F) STRUCTURE CLEARANCES - MINIMUM 12 FEET.
G) MAINTENANCE SUFFICIENT TO INSURE ALL WEATHER USE.

24. LANDSCAPING OR FENCING WILL NOT BE ALLOWED IN THE REAR YARD EASEMENT.

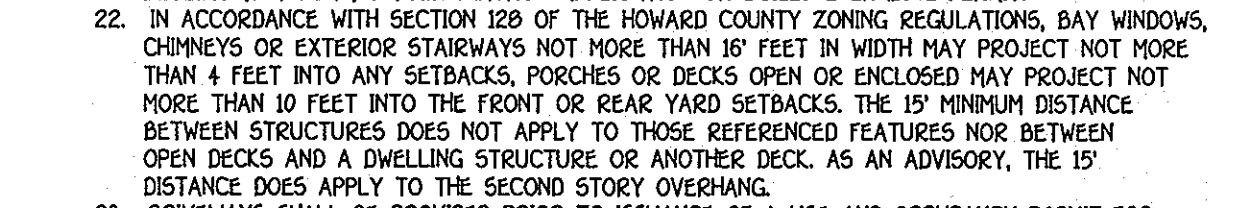

LEGEND

SYMBOL	DESCRIPTION
---	EXISTING CONTOUR 2' INTERVAL
---	PROPOSED CONTOUR 2' INTERVAL
+362.2	SPOT ELEVATION
---	WALKOUT BASEMENT
-SF - SF	SILT FENCE
-SSF - SSF	SUPER SILT FENCE
---	EROSION CONTROL MATTING
---	LIMIT OF DISTURBANCE
---	STREET LIGHTS PER F-05-09
---	EXISTING SHADE TREE TAKEN FROM F-05-09
---	EXISTING ORNAMENTAL TREE TAKEN FROM F-05-09
---	EXISTING EVERGREEN TREE TAKEN FROM F-05-09
---	LANDSCAPE SHADE TREE PER S/D

SITE ANALYSIS DATA CHART

A. TOTAL PROJECT AREA: 1.927 ACRES OR 79,584 SQUARE FEET.
B. AREA OF SUBMISSION: 1.927 ACRES OR 79,584 SQUARE FEET.
C. LIMITS OF DISTURBANCE: 1.927 ACRES OR 79,584 SQUARE FEET.
D. PRESENT ZONING DESIGNATION: PEC-MXD-3.
E. PROPOSED USES FOR SITE: RESIDENTIAL.

TITLE SHEET

SINGLE FAMILY DETACHED

EMERSON




SECTION 2 PHASE 6B

LOTS 4,5 & 9 THRU 16


PLAT NO. 17915
TAX MAP NO: 47 PARCEL NO: 837 GRID NO: 9
SIXTH ELECTION DISTRICT HOWARD COUNTY, MARYLAND
SCALE: 1" = 30' DATE: SEPTEMBER, 2006

SHEET 1 OF 4

SDP 07-23

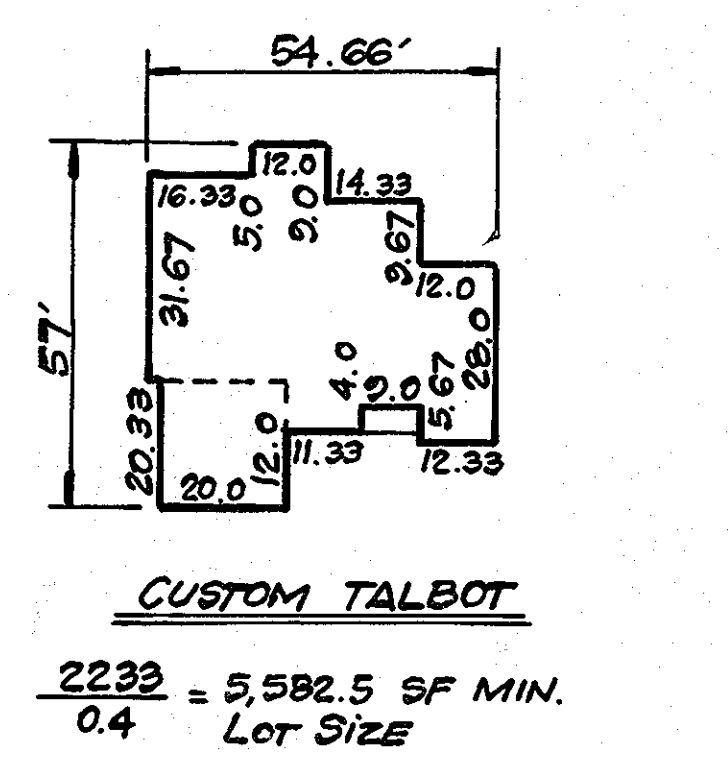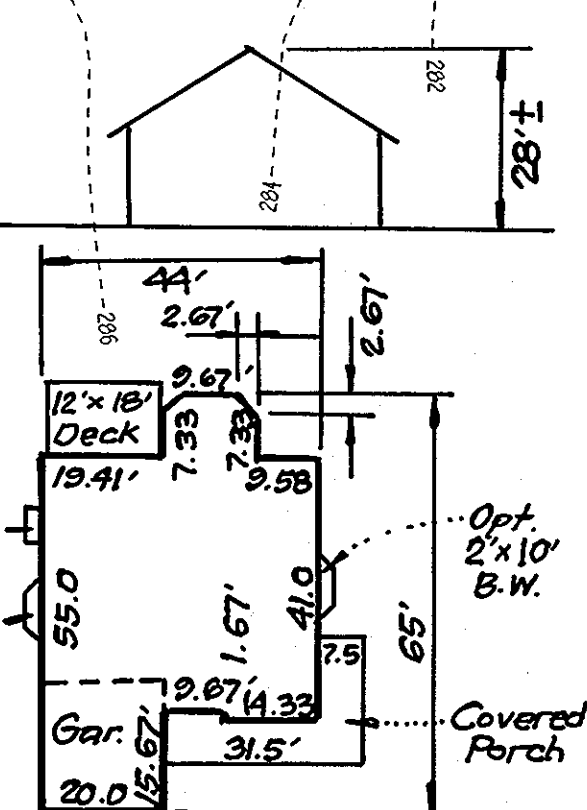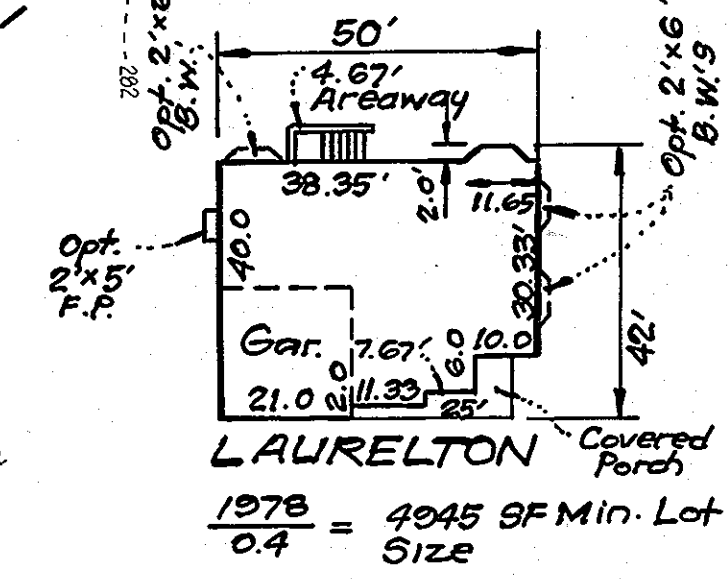

NO.	REVISION	DATE
9	Rev. grd. lot 13 to show As-Built Cond.	7-30-02
8	Rev. hse., Add hse. typical Lot 13	11-7-02
7	Revise hse. & grd. lot 11, Add hse. typical	8-29-02
6	Rev. hse. 4' grd. lot 5	4-11-01
5	Rev. house lot 4	12-14-01
4	Rev. grd. lot 10 to show As-Built Cond.	6-26-01
3	Move hse. 2' Left, Add wraparound porch	
	Lot 10, Delete Sewer on Open Space Lot 21	
	Add new W/S per Revised Contr. 24-4231-D	4-30-01
1	Revise house and grade Lot 5	
	Add Custom TALBOT house typical	3-30-01

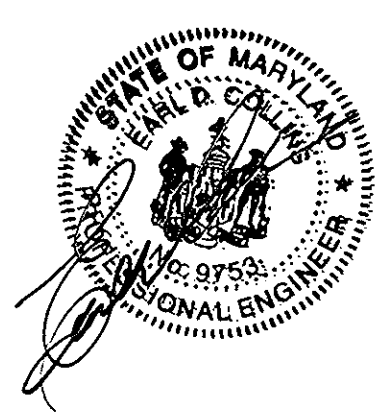

ENGINEER'S CERTIFICATE
I certify that this plan for erosion and sediment control represents a practical and workable plan based on my personal knowledge of the site conditions and that it was prepared in accordance with the requirements of the Howard Soil Conservation District.

Signature of Engineer: *Earl D. Collins* Date: _____
Earl D. Collins

BUILDER/DEVELOPER'S CERTIFICATE
I/We certify that all development and construction will be done according to this plan, for sediment and erosion control and that any responsible personnel involved in the construction project will have a Certificate of Attendance at a Department of the Environment Approved Training Program for the Control of Sediment and Erosion before beginning the project. I also authorize periodic on-site inspection by the Howard Soil Conservation District.

Signature of Developer: *Harry Bowie* Date: 1-3-07
Harry Bowie

Reviewed for HOWARD SCD and meets Technical Requirements.

U.S.D.A.-Natural Resources Conservation Service Date: _____
This development plan is approved for soil erosion and sediment control by the HOWARD SOIL CONSERVATION DISTRICT. *WKC*

Howard SCD Date: _____

OWNER
THE HOWARD RESEARCH & DEVELOPMENT CORP.
10275 LITTLE PATUXENT PARKWAY
COLUMBIA, MARYLAND 21044
410-992-6000

BUILDER/DEVELOPER
NU-HOMES
10630 LITTLE PATUXENT PARKWAY
COLUMBIA, MARYLAND 21044
410-730-2100

APPROVED: HOWARD COUNTY DEPARTMENT OF PLANNING AND ZONING

Condy Hanna 1/22/07
Chief, Division of Land Development Date

Michael A. Lewis 1/19/07
Chief, Development Engineering Division Date

Director - Department of Planning and Zoning Date

PROJECT: EMERSON SECTION: SECTION 2 PHASE 6B
LOTS NO. 4, 5 & 9 THRU 16 PARCEL 837

PLAT 17915, 17916, 17950 ZONE PEC-MXD-3 TAX/ZONE 47 ELEC. DIST. SIXTH CENSUS TR. 6069.02

WATER CODE C-02 SEWER CODE 7390000

SITE DEVELOPMENT PLAN

SINGLE FAMILY DETACHED


EMERSON

SECTION 2 PHASE 6B
LOTS 4, 5 & 9 THRU 16


PLAT NO. 17915
TAX MAP NO.: 47 PARCEL NO.: 837 GRID NO.: 9
SIXTH ELECTION DISTRICT HOWARD COUNTY, MARYLAND
SCALE: 1" = 30' DATE: SEPTEMBER, 2006

SHEET 2 OF 4

SDP 07-23

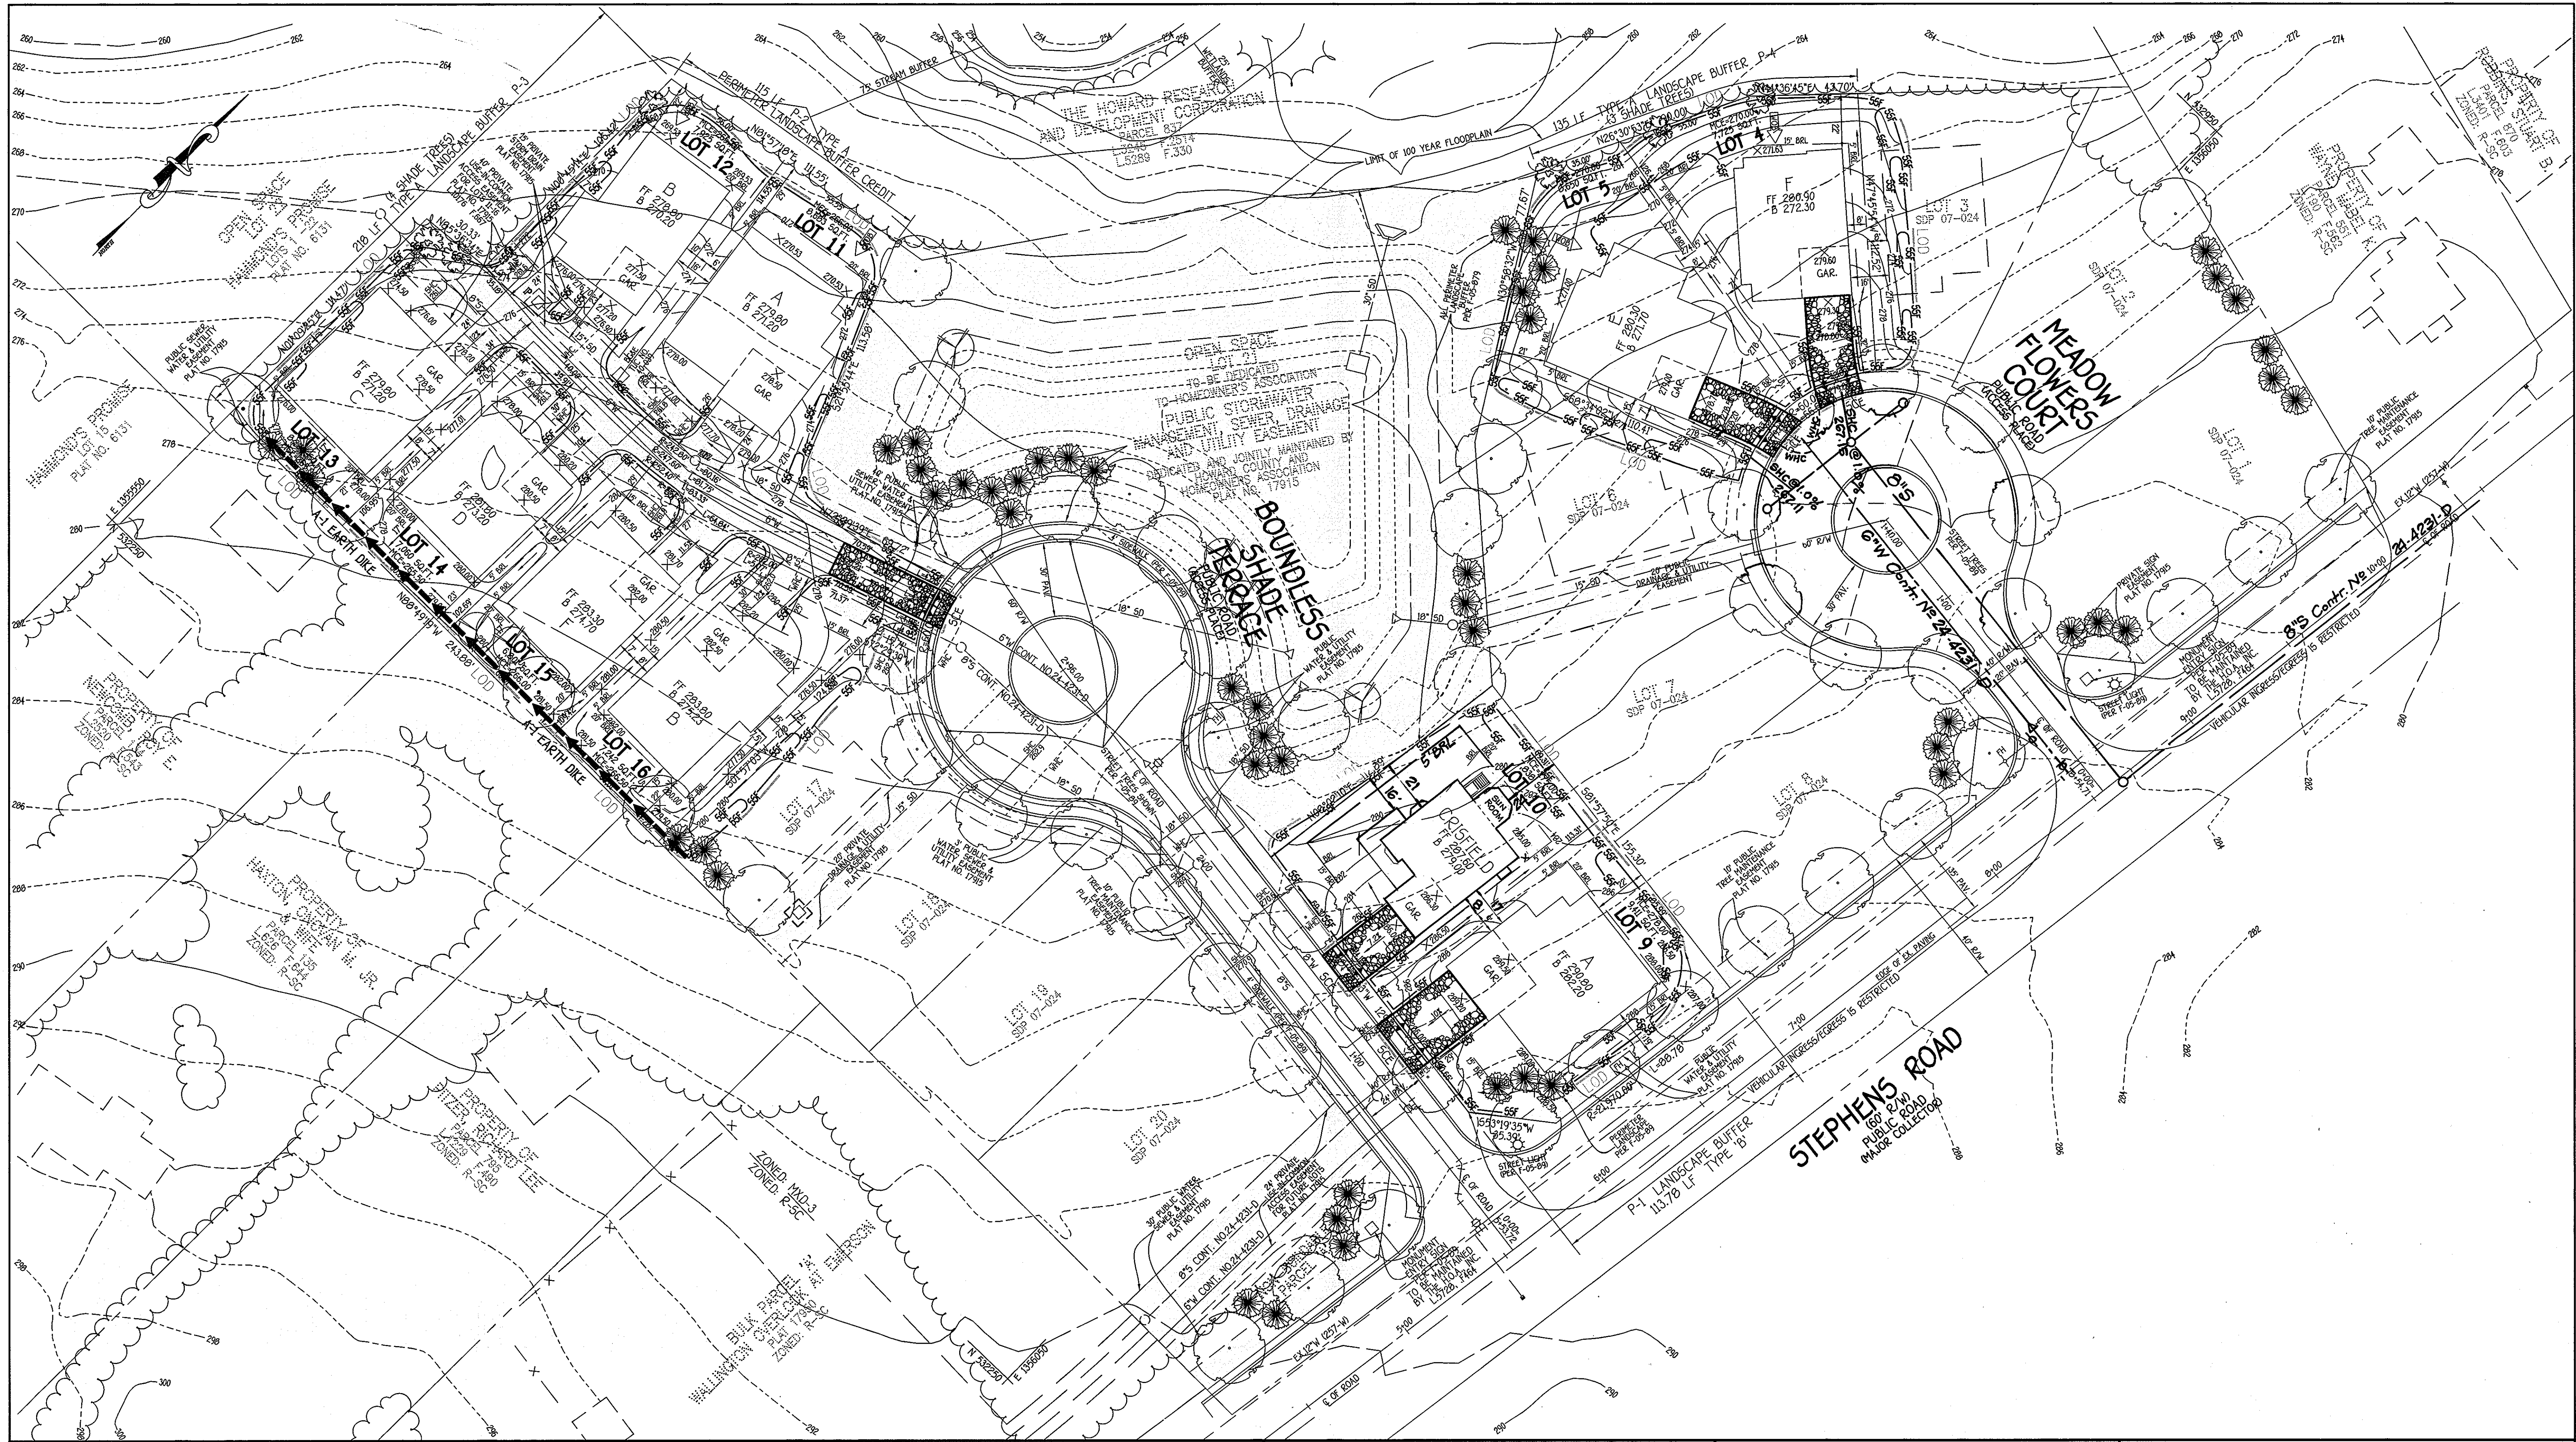

NO.	REVISION	DATE
1	Move hse. 2' Left, Add wraparound porch Lot 10, Delete B's on Open Space Lot 21 Add new W/S Per Revised Contr. 24-4231-D 4-30-07	

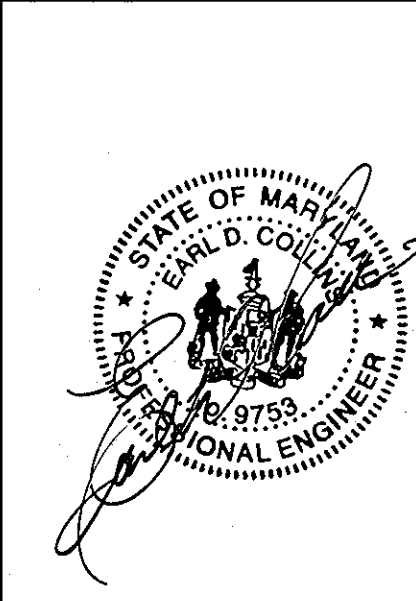

ENGINEER'S CERTIFICATE
 I certify that this plan for erosion and sediment control represents a practical and workable plan based on my personal knowledge of the site conditions and that it was prepared in accordance with the requirements of the Howard Soil Conservation District.
 Signature of Engineer: *Earl D. Collins* Date: 1/12/07
BUILDER/DEVELOPER'S CERTIFICATE
 I/We certify that all development and construction will be done according to this plan, for sediment and erosion control and that any responsible personnel involved in the construction project will have a Certificate of Attendance of a Department of the Environment Approved Training Program for the Control of Sediment and Erosion before beginning the project. I also authorize periodic on-site inspection by the Howard Soil Conservation District.
 Signature of Developer: *HARRY BOWIE* Date: 1-3-07

Reviewed for HOWARD SCD and meets Technical Requirements.
 Signature: *Jim Myers* Date: 1/12/07
 Director - Natural Resources Conservation Service
 This development plan is approved for soil erosion and sediment control by the HOWARD SOIL CONSERVATION DISTRICT.
 Signature: *John K. Tolman* Date: 1/12/07
 Director - Howard SCD
OWNER
 THE HOWARD RESEARCH & DEVELOPMENT CORP.
 10275 LITTLE PATUXENT PARKWAY
 COLUMBIA, MARYLAND 21044
 410-992-6000
BUILDER/DEVELOPER
 NU-HOMES
 10630 LITTLE PATUXENT PARKWAY
 COLUMBIA, MARYLAND 21044
 410-730-2100

APPROVED: HOWARD COUNTY DEPARTMENT OF PLANNING AND ZONING
 Signature: *Cindy Hammett* Date: 1/23/07
 Chief, Division of Planning and Development
 Signature: *John Vanaman* Date: 1/19/07
 Chief, Development Engineering Division
 Signature: *Paul M. ...* Date: 1/23/07
 Director - Department of Planning and Zoning
 PROJECT: EMERSON SECTION 2 PHASE 6B
 SECTION 2 PHASE 6B
 LOTS NO. 4, 5 & 9 THRU 16
 PARCEL 837

PLAT	BLOCK NO.	ZONE	TAX/ZONE	ELEC. DIST.	CENSUS TR.
17915, 17916 & 17950	9	PEC-MXD-3	47	SIXTH	6069.02
WATER CODE	SEWER CODE				
C-02	7390000				

SEDIMENT/EROSION CONTROL PLAN
 SINGLE FAMILY DETACHED
EMERSON
 SECTION 2 PHASE 6B
 LOTS 4, 5 & 9 THRU 16
 PLAT NO. 17915
 TAX MAP NO.: 47 PARCEL NO.: 837 GRID NO.: 9
 SIXTH ELECTION DISTRICT HOWARD COUNTY, MARYLAND
 SCALE: 1" = 30' DATE: SEPTEMBER, 2006
 SHEET 3 OF 4

SDP 07-23

J:\50001 Emerson Property\Map\Sec2Phase6B\0718-6002 Sec.Lots 4,5 & 9-16.dwg, 10/20/07 2:27:02 PM, 1/30

20.0 STANDARDS AND SPECIFICATIONS FOR VEGETATIVE STABILIZATION DEFINITION

Using vegetation as cover for barren soil to protect it from forces that cause erosion. PURPOSE: Vegetative stabilization specifications are used to promote the establishment of vegetation on exposed soil. When soil is stabilized with vegetation, the soil is less likely to erode and more likely to avoid infiltration of rainfall, thereby reducing sediment loads and runoff to downstream areas, and improving wildlife habitat and visual resources.

CONDITIONS WHERE PRACTICE APPLIES
This practice shall be used on denuded areas as specified on the plans and may be used on highly erodible or critically eroding areas. This practice is intended to quickly establish vegetative cover for short duration (up to one year), and Permanent Seeding, for long term vegetative cover. Examples of applicable areas for Temporary Seeding are temporary soil stockpiles, cleared areas being left idle between construction phases, earth dikes, etc. and for Permanent Seeding are lawns, dunes, cut and fill slopes and other areas at final grade, former stockpile and staging areas, etc.

EFFECTS ON WATER QUALITY AND QUANTITY
Planting vegetation in disturbed areas will have an effect on the water budget, especially on volumes and rates of runoff, infiltration evaporation, transpiration, percolation, and groundwater recharge. Vegetation over time will increase organic matter content and improve the water holding capacity of the soil and subsequent plant growth. Vegetation will help reduce the movement of sediment, nutrients, and other chemicals carried by runoff to receiving waters. Plants will also help protect groundwater supplies by assimilating those substances present within the root zone. Sediment control devices must remain in place during grading, seeded preparation, seeding, mulling and vegetative establishment to prevent large quantities of sediment and associated chemicals and nutrients from washing into surface waters.

SECTION 1 - VEGETATIVE STABILIZATION METHODS AND MATERIALS

- Site Preparation**
 - Install erosion and sediment control structures (either temporary or permanent) such as diversions, grade stabilization structures, berms, waterways, or sediment control basins.
 - Perform all grading operations at right angles to the slope. Final grading and application rates for sites not necessary for temporary seeding.
 - Schedule required soil tests to determine soil amendment composition and shipping rates for usability having disturbed area over 5 acres.
- Soil Amendment/Fertilizer and Lime Specifications**
 - Soil tests must be performed to determine the exact rates and application rates for both lime and fertilizer on sites having disturbed areas over 5 acres. Soil analysis may be performed by the University of Maryland or a recognized commercial laboratory. Soil samples taken for engineering purposes may also be used for chemical analysis.
 - Fertilizers shall be uniform in composition, free flowing and suitable for accurate application by approved equipment. Manure may be substituted for fertilizer with prior approval from the appropriate approval authority. Fertilizers shall all be delivered to the site fully labeled according to the applicable state fertilizer laws and shall bear the name, trade name or trademark and warranty of the producer.
 - Lime materials shall be ground limestone hydrated or burnt lime which contains at least 50% total calcium oxide plus magnesium oxide. The material shall be applied to such a thickness that at least 50% will pass through a #100 mesh sieve and 90-100% will pass through a #20 mesh sieve.
 - Incorporate lime and fertilizer into the top 3-5" of soil by disking or other suitable means.
- Seeded Preparation**
 - Temporary Seeding**
 - Seeded preparation shall consist of loosening soil to a depth of 3" to 5" by means of suitable agricultural or construction equipment, such as disc harrows or chisel plows or rippers mounted on construction equipment. After the soil is loosened it should not be rolled or dragged smooth, but left in the roughened condition. Seeded areas greater than 1/2 acre should be tracked leaving the surface in an irregular condition with ridges running parallel to the contour of the slope.
 - Apply fertilizer and lime as prescribed on the plans.
 - Incorporate lime and fertilizer into the top 3-5" of soil by disking or other suitable means.
 - Permanent Seeding**
 - Minimum soil conditions required for permanent vegetative establishment:
 - Soil pH shall be between 6.0 and 7.0.
 - Soluble salts shall be less than 500 parts per million (ppm).
 - The soil shall contain less than 40% clay, but enough fine grained material (20% silt plus clay) to provide the capacity to hold a moderate amount of moisture. An exception is if loess or siltstone or siltstone is to be planted, then a sandy soil (30% silt plus clay) would be acceptable.
 - Soil shall contain 1.5% minimum organic matter by weight.
 - Soil must contain sufficient pore space to permit adequate root penetration.
 - If these conditions cannot be met by soils site, adding topsoil is required in accordance with Section 21 Standard and Specification for Topsoil.
 - Areas previously graded in conjunction with the drawings shall be maintained in a true and even grade, then scarified or otherwise loosened to a depth of 3-5" to permit bonding of the topsoil to the surface area and create horizontal erosion check slots to prevent topsoil to the surface area and to create horizontal erosion check slots to prevent topsoil from sliding down a slope.
 - Apply soil amendments as per soil test as indicated on the plans.
 - Mix soil amendments into the top 3-5" of topsoil by disking or other suitable means. Lawn areas should be rolled to smooth the surface, remove large objects like stones and branches, and reseed the area for seed and application. When seed and application, normal seeded preparation, loosen surface soil by dragging with a heavy chain or other equipment to roughen the surface. Steep slopes steeper than 3:1 should be tracked by a dozer leaving the soil in an irregular condition with ridges running parallel to the contour of the slope. The top 3-5" of soil should be loose and friable. Seeded loosening may not be necessary on newly disturbed areas.

- Seed Specifications**
 - All seed must meet the requirements of the Maryland State Seed Law. All seed shall be subject to re-testing by a recognized laboratory. All seed and soil shall have been tested within the 6 months immediately preceding the date of sowing such material on this job.
 - Inoculant - The inoculant for treating legumes shall be a pure culture of nitrogen-fixing bacteria prepared specifically for the species. Inoculants shall not be used later than the date indicated on the container. Add fresh inoculant as directed on package. Use four times the recommended rate when hydroseeding. Note: It is very important to keep inoculant as cool as possible until used. Temperatures above 75°-80° F. can weaken bacteria and make the inoculant less effective.
- Methods of Seeding**
 - Hydroseeding** - Apply seed uniformly with hydroseeder (slurry includes seed and fertilizer), broadcast or drop seeded, or a catpucker seeder.
 - If fertilizer is being applied at the time of seeding, the application rates amounts will not exceed the following: nitrogen maximum of 100 lbs. per acre total of soluble nitrogen; P2O5 (phosphorous) 200 lbs./acre; K2O (potassium) 200 lbs./acre.
 - Lime - use only ground agricultural limestone. Up to 3 tons per acre may be applied by hydroseeding. Normally, not more than 2 tons are applied by hydroseeding at any one time. Do not use burnt or hydrated lime when hydroseeding.
 - Seed and fertilizer shall be mixed on site and seeding shall be done immediately and without interruption.
 - Dry Seeding** - This includes use of conventional drop or broadcast spreaders.
 - Seed and fertilizer shall be incorporated into the subsoil at the rates prescribed on the Temporary or Permanent Seeding Summaries or Tables 265 or 26. The seeded area shall then be rolled with a weighted roller to provide good seed to soil contact.
 - Where practical, seed should be applied in two directions perpendicular to each other. Apply half the seeding rate in each direction.
 - Drill or Catpucker Seeding** - Mechanized seeders that apply and cover seed with soil.
 - Catpucker seeders are required to bury the seed in such a fashion as to provide at least 1/4 inch of soil covering. Seeded must be firm after planting.
 - Where practical, seed should be applied in two directions perpendicular to each other. Apply half the seeding rate in each direction.

- Final Specifications in order of preference**
 - Straw shall consist of thoroughly threshed wheat, rice or oat straw, reasonable bright in color, and shall not be treated with herbicides, pesticides or excessive dust and shall be free of noxious weed seeds as specified in the Maryland Seed Law.
 - Wood Cellulose Fiber Mulch (WCFM)
 - WCFM shall consist of specially prepared wood cellulose processed into a uniform fibrous physical state.
 - WCFM shall be dyed green or contain a green dye in the package that will provide an appropriate color to facilitate visual inspection of the uniformity spread skirt.
 - WCFM, including dye, shall contain no germination or growth inhibiting factors.
 - WCFM materials shall be manufactured and processed in such a manner that the wood cellulose fiber mulch will remain in uniform suspension in water under agitation and will blend with seed, fertilizer and other additives to form a homogeneous slurry. The mulch material shall form a barrier-like ground cover, on application, having moisture absorption and percolation properties and shall cover and hold grass seed in contact with the soil without inhibiting the growth of the grass seedlings.
 - WCFM material shall contain no elements or compounds at concentrations levels that will be phytotoxic.
 - WCFM must conform to the following physical requirements: fiber length to approximately 10 mm, diameter approximately 1 mm, pH range of 4.0 to 8.5, ash content of 1.6% maximum and water holding capacity of 90% minimum.

Note: Only sterile straw mulch should be used in areas where one species of grass is desired.

- Mulching Seeded Areas** - Mulch shall be applied to all seeded areas immediately after seeding.
 - If grading is completed outside of the seeding season, mulch shall be applied as prescribed in this section and maintained until the seeding season returns and seeding can be performed in accordance with these specifications.
 - When straw mulch is used, it shall be spread over all seeded areas at the rate of 2 tons/acre. Mulch shall be applied to a uniform loose depth of between 1" and 2". Mulch applied shall achieve a uniform distribution and depth so that the soil surface is not exposed. If a mulch anchoring tool is to be used, the rate shall be increased to 2.5 tons/acre.
 - Wood cellulose fiber used as a mulch shall be applied at a net dry weight of 1,500 lbs. per acre. The wood cellulose fiber shall be mixed with water, and the mixture shall contain a maximum of 50 lbs. of wood cellulose fiber per 100 gallons of water.
 - Securing Straw Mulch (which Anchoring) - Mulch anchoring shall be performed immediately following mulch application to minimize loss by wind or water. This may be done by one of the following methods listed by preference, depending upon size of area and erosion hazard:
 - A mulch anchoring tool is a tractor drawn implement designed to punch and anchor mulch into the soil surface a minimum of two (2) inches. This practice is most effective on large areas, but is limited to flatter slopes where equipment can operate safely. If used on sloping land, this practice should be used on the contour if possible.
 - Wood cellulose fiber may be used for anchoring straw. The fiber binder shall be applied at a net dry weight of 100 lbs. per acre. The wood cellulose fiber shall be mixed with water and the mixture shall contain a maximum of 50 pounds of wood cellulose fiber per 100 gallons of water.
 - Application of liquid binders should be heavier at the edges where wind catches much, such as in valleys and crests of banks. The remainder of area should be applied uniformly after binder application. Synthetic binders - such as Acrylic Dike (Super-Tack), DCA-70 FETROSE, Terra-Tax II, Terra-Tack AR or other approved equal may be used at rates recommended by the manufacturer.
 - Lightweight plastic netting may be stapled over the mulch according to manufacturer's recommendations. Netting is usually available in rolls 4" to 15" feet wide and 300 to 3,000 feet long.
- Incremental Stabilization - Cut Slopes**
 - All cut slopes shall be dressed, prepared, seeded and mulched as the work progresses. Slopes shall be excavated and stabilized in equal increments not to exceed 15'.
 - Construction sequence (Refer to Figure 3 below):
 - Excavate and stabilize all temporary swales, side ditches, or berms that will be used to convey runoff around the fill.
 - Perform Phase 1 excavation, dress, and stabilize.
 - Perform Phase 2 excavation, dress and stabilize. Overseed Phase 1 areas as areas are necessary.
 - Perform final phase excavation, dress and stabilize. Overseed previously seeded areas as necessary.

- Incremental Stabilization - Fill Slopes**
 - Embankments shall be constructed in lifts as prescribed on the plans.
 - Slopes shall be stabilized immediately when the vertical height of the multiple lifts reaches 15', or when the grading operation ceases as prescribed in the plans.
 - At the end of each day, temporary berms and slope slopes should be constructed along the top edge of the embankment to intercept surface runoff and convey it down the slope in a non-erosive manner to the construction sequence. Refer to Figure 4 (below):
 - Excavate and stabilize all temporary swales, side ditches, or berms that will be used to divert runoff around the fill.
 - Perform Phase 1 embankment, dress and stabilize.
 - Perform Phase 2 embankment, dress and stabilize.
 - Perform final phase embankment, dress and stabilize. Overseed previously seeded areas as necessary.

Note: Once excavation has begun the operation should be continuous from grubbing through the completion of placement of topsoil (if required) and permanent seed and mulch. Any interruptions in the operation or completion of the seeding season will necessitate the application of temporary stabilization.

- SEDIMENT CONTROL NOTES**
- A MINIMUM OF 48 HOURS NOTICE MUST BE GIVEN TO THE HOWARD COUNTY DEPARTMENT OF INSPECTIONS, LICENSES AND PERMITS, SEDIMENT CONTROL DIVISION PRIOR TO THE START OF ANY CONSTRUCTION (311-3955).
 - ALL VEGETATIVE AND STRUCTURAL PRACTICES ARE TO BE INSTALLED ACCORDING TO THE PROVISIONS OF THIS PLAN AND ARE TO BE IN CONFORMANCE WITH THE MOST CURRENT MARYLAND STANDARDS AND SPECIFICATIONS FOR SOIL EROSION AND SEDIMENT CONTROL, AND REVISIONS THERE TO.
 - FOLLOWING INITIAL SOIL DISTURBANCE OR GRADED AREAS ON THE PROJECT SITE, ALL SEDIMENT TRAP/BASINS SHOWN MUST BE FENCED AND WARNING SIGNS POSTED AROUND THEIR PERIMETER IN ACCORDANCE WITH VOL. 1, CHAPTER 12, OF THE HOWARD COUNTY DESIGN MANUAL, STORM DRAINAGE.
 - ALL DISTURBED AREAS MUST BE STABILIZED WITHIN THE TIME PERIOD SPECIFIED ABOVE IN ACCORDANCE WITH THE 1994 MARYLAND STANDARDS AND SPECIFICATIONS FOR SOIL EROSION AND SEDIMENT CONTROL, FOR PERMANENT SEEDING (SEC. 50, 50.00 SEC. 54), TEMPORARY SEEDING (SEC. 50, AND MULCHING (SEC. 52). TEMPORARY STABILIZATION WITH MULCH ALONE CAN ONLY BE DONE WHEN RECOMMENDED SEEDING DATES DO NOT ALLOW FOR PROPER GERMINATION AND ESTABLISHMENT OF GRASSES.
 - ALL SEDIMENT CONTROL STRUCTURES ARE TO REMAIN IN PLACE AND ARE TO BE MAINTAINED IN OPERATIVE CONDITION UNTIL PERMSSION FOR THEIR REMOVAL HAS BEEN OBTAINED FROM THE HOWARD COUNTY SEDIMENT CONTROL INSPECTOR.
 - SITE ANALYSES:

TOTAL AREA OF SITE	1,827 ACRES
AREA TO BE ROOFED OR PAVED	0.9545 ACRES
AREA TO BE VEGETATIVELY STABILIZED	0.8725 ACRES
TOTAL CUT	49.0 CU.YDS.
TOTAL FILL	459.0 CU.YDS.
 - OFFSITE WASTE/DROPPED AREA LOCATION STOCKPILING WILL NOT BE PERMITTED ON SITE.
 - ANY SEDIMENT CONTROL PRACTICE WHICH IS DISTURBED BY GRADING ACTIVITY FOR PLACEMENT OF UTILITIES MUST BE REPAIRED ON THE SAME DAY OF DISTURBANCE.
 - ADDITIONAL SEDIMENT CONTROLS MUST BE PROVIDED, IF DEEMED NECESSARY BY THE HOWARD COUNTY SEDIMENT CONTROL INSPECTOR.
 - ON ALL SITES WITH DISTURBED AREAS IN EXCESS OF 2 ACRES, APPROVAL OF THE INSPECTION AGENCY SHALL BE REQUESTED UPON COMPLETION OF INSTALLATION OF PERMETER EROSION AND SEDIMENT CONTROLS, BUT BEFORE PROCEEDING WITH ANY OTHER EARTH DISTURBANCE OR GRADING. OTHER BUILDING OR GRADING INSPECTION APPROVALS MAY NOT BE AUTHORIZED UNTIL THIS INITIAL APPROVAL BY THE INSPECTION AGENCY IS MADE.
 - TRENCHES FOR THE CONSTRUCTION OF UTILITIES IS LIMITED TO THREE PIPE LENGTHS OR THAT WHICH SHALL BE BACK FILLED AND STABILIZED WITHIN ONE WORKING DAY, WHICHEVER IS GREATER.

- PERMANENT SEEDING NOTES**
- Apply to graded or cleared areas likely to be re-disturbed where a short-term vegetative cover is needed.
- Seeded Preparation** - Loosen upper three inches of soil by raking, disking or other acceptable means before seeding, if not previously loosened.
- Soil Amendments** - Apply 600 lbs. per acre 10-10-10 fertilizer (14 lbs. per 1000 sq.ft.).
- Seeding** - For periods March 1 thru April 30 and from August 15 thru November 15, seed with 2-1/2 bushels per acre of annual ryegrass (3.2 lbs. per 1000 sq.ft.). For the period May 1 thru August 14, seed with 3 lbs. per acre of weeping lovegrass (0.07 lbs. per 1000 sq.ft.). For the period November 16 thru February 28, protect site by applying 2 tons per acre of well anchored straw mulch and seed as soon as possible in the spring, or use seed.
- Mulching** - Apply 1-1/2 to 2 tons per acre (70 to 80 lbs. per 1000 sq.ft.) of unrotted small grain straw immediately after seeding. Anchor mulch immediately after application using mulch anchoring tool or 218 gal. per acre (5 gal. per 1000 sq.ft.) of emulsified asphalt on flat areas. On slopes, 8 ft. or higher, use 347 gal. per acre (8 gal. per 1000 sq.ft.) for anchoring.

- SEQUENCE OF CONSTRUCTION**
- OBTAIN GRADING PERMIT 7 DAYS
 - INSTALL SEDIMENT AND EROSION CONTROL DEVICES AS SHOWN ON PLAN 7 DAYS
 - CLEAR AND GRUB TO LIMITS OF DISTURBANCE 4 DAYS
 - INSTALL TEMPORARY SEEDING 2 DAYS
 - CONSTRUCT BUILDINGS 60 DAYS
 - FINE GRADE SITE AND INSTALL PERMANENT SEEDING AND LANDSCAPE 14 DAYS
 - REMOVE SEDIMENT CONTROL DEVICES AS UPLAND AREAS ARE STABILIZED AND PERMSSION IS GRANTED BY E/S CONTROL INSPECTOR. 7 DAYS

STANDARDS AND SPECIFICATIONS FOR TOPSOIL

Definition: Placement of topsoil over a prepared subsoil prior to establishment of permanent vegetation.

Purpose: To provide a suitable soil medium for vegetative growth. Soils of concern have low moisture content, low nutrient levels, low pH, materials toxic to plants, and/or unacceptable soil gradation.

- This practice is limited to areas having 2:1 or flatter slopes where:
 - The texture of the exposed subsoil/parent material is not adequate to produce vegetative growth.
 - The soil material is so shallow that the rooting zone is not deep enough to support plants or furnish confining supplies of moisture and plant nutrients.
 - The original soil to be vegetated contains material toxic to plant growth.
 - The soil is so acidic that treatment with limestone is not feasible.

- For the purpose of these standards and specifications, areas having slopes steeper than 2:1 require special consideration and design for adequate stabilization. Areas having slopes steeper than 2:1 shall have the appropriate stabilization shown on the plans.

- Topsoil obtained from the existing site may be used provided that it meets the standards as set forth in these specifications. Typically, the depth of topsoil to be salvaged for a given soil type can be found in the representative soil profile section in the Soil Survey published by USDA-SCS in cooperation with Maryland Agricultural Experiment Station.

- Topsoil Specifications - Soil to be used as topsoil must meet the following:
 - Topsoil shall be a loam, sandy loam, clay loam, silt loam, sandy clay loam, leamy sand. Other soils may be used if recommended by an agronomist or soil scientist and approved by the appropriate approval authority. Regardless, topsoil shall not be a mixture of contrasting textured subsoils and shall contain less than 5% by volume of stones, slag, coarse fragments, gravel, sticks, roots, trash, or other materials larger than 1 1/2" in diameter.
 - Topsoil must be free of plants or plant parts such as bermuda grass, quackgrass, Johnsongrass, nutgrass, poison ivy, thistle, or other plants as specified.
 - Where the subsoil is either highly acidic or composed of heavy clay, ground limestone shall be spread at the rate of 4-6 tons/acre (200-300 pounds per 1,000 square feet) prior to the placement of topsoil. Lime shall be distributed uniformly over designated areas and worked into the soil in conjunction with tillage operations as described in the following procedures:
 - For sites having disturbed areas over 5 acres:
 - Place topsoil (if required) and apply soil amendments as specified in 20.0 Vegetative Stabilization - Section 1 - Vegetative Stabilization Methods and Materials.
 - For sites having disturbed areas over 5 acres:
 - On soil meeting Topsoil specifications, obtain test results dictating fertilizer and lime amendments should be brought to the soil into compliance with the following:
 - pH for topsoil shall be between 6.0 and 7.5. If the tested soil demonstrates a pH of less than 6.0, sufficient lime shall be added to raise the pH to 6.5 or higher.
 - Organic content of topsoil shall be not less than 1.5 percent by weight.
 - Topsoil having soluble salt content greater than 500 parts per million shall not be used.
 - No soil or seed shall be placed on soil which has been treated with soil sterilants or chemicals used for weed control until sufficient time has elapsed (14 days min.) to permit distribution of phytotoxic materials.

- Topsoil Application
 - When topsoiling, maintain erosion and sediment control practices such as diversions, Grade Stabilization Structures, Earth Dikes, Slope Silt Fence and Sediment Traps and Basins.
 - Grades on the areas to be topsoiled, which have been previously established, shall be maintained, shall 4" - 8" higher in elevation.
 - Topsoil shall be uniformly distributed in a 4" - 8" layer and lightly compacted to a minimum thickness of 4". Spreading shall be performed in such a manner that seeding or seedling can proceed with a minimum of additional soil preparation and tillage. Any irregularities in the surface resulting from topsoiling or other operations shall be corrected in order to prevent the formation of depressions or water pockets.
 - Topsoil shall not be placed while the topsoil or subsoil is in a frozen or muddy condition, when the subsoil is excessively wet or in a condition that may otherwise be detrimental to proper grading and seeded preparation.

- Alternative for Permanent Seeding - Instead of applying the full amounts of lime and commercial fertilizer, composted sludge and amendments may be applied as specified below:
 - Composted Sludge Material for use as a soil conditioner for sites having disturbed areas over 5 acres shall be tested to prescribe amendments and for sites having disturbed areas under 5 acres shall conform to the following requirements:
 - Composted sludge shall be supplied by, or originate from, a person or persons that are permitted (at the time of acquisition of the compost) by the Maryland Department of the Environment under COMAR 26.04.06.
 - Composted sludge shall contain at least 1 percent nitrogen, 1.5 percent phosphorus, and 0.2 percent potassium and have a pH of 7.0 to 8.0. If compost does not meet these requirements, the appropriate constituents must be added to meet the requirements per acre.
 - Composted sludge shall be applied at a rate of 1 ton/1,000 square feet.
 - Composted sludge shall be amended with a potassium fertilizer applied at the rate of 4 lb./1,000 square feet, and 1/3 the normal lime application rate.

References: Guidelines Specifications, Soil Preparation and Seeding, MD-VIA, Pub. of Cooperative Extension Service, University of Maryland and Virginia Polytechnic Institute, Revised 1973.





