

SITE ANALYSIS DATA CHART

TOTAL PROJECT AREA: 357.976 ACRES
 AREA OF PLAN SUBMISSION: 498.8 ACRES (27.9 AC)
 LIMIT OF DISTURBANCE: 498.8 ACRES (27.9 AC)
 PRESENT ZONING: PEC
 PROPOSED USE: OUTDOOR TESTING AREAS
 EXISTING NUMBER OF JHU/APL EMPLOYEES: 4,600
 EXISTING MAXIMUM NUMBER OF PARKING SPACES REQUIRED BY ZONING: 2,850 (SDP-05-133)
 EXISTING ON-SITE PARKING SPACES: 4,798 (SDP-05-133)
 NO PARKING FOR OFF-SITE VEHICLES PROPOSED AS PART OF THIS SUBMISSION

CASE NUMBERS APPLICABLE:
 F-04-188, SDP-04-133, F-078-035
 SANITARY SEWER / WATER SERVICE:
 PRIVATE ONSITE SYSTEM, PUBLIC CONNECTION
 EXISTING BUILDING COVERAGE (INCLUDES SDP 18-035):
 25.57 ACRES (7.1%)
 PROPOSED BUILDING COVERAGE:
 9.697 ACRES (4,620 FT²) = 0.074 ACRES (3,240 FT²)
 TOTAL PROPOSED BUILDING COVERAGE:
 25.61 ACRES (7.2%) = 25.64 ACRES (7.3%)

ASSIGNABLE OFFICE SPACE: 0 GSF
 NO ADDITIONAL JHU/APL EMPLOYEES ARE PROPOSED AS PART OF THIS SUBMISSION
 PROPOSED BUILDING GROSS FT²: 1,620 GSF

NO FLOODPLAINS OR FOREST CONSERVATION EASEMENTS PRESENT WITHIN THE LIMITS OF DISTURBANCE.

EXISTING OPEN SPACE AREA: 278.89 ACRES (77.8% OF TOTAL LOT AREA)

PROPOSED OPEN SPACE AREA: 278.85 ACRES (77.9% OF TOTAL LOT AREA)

NATURAL STEEP SLOPES (>15%) = 7.2 ACRES

HIGHLY ERODIBLE SOILS = 7.2 ACRES

GENERAL NOTES




- THE TOPOGRAPHIC INFORMATION SHOWN HEREON, WAS OBTAINED FROM AN AERIAL SURVEY FLOWN BY AXIS GEOSPATIAL ON APRIL 6, 2014 AND PROVIDED TO RK&K IN AUGUST OF 2017. THE UTILITY INFORMATION WAS PROVIDED ELECTRONICALLY TO RK&K BY JHU APL IN AUGUST OF 2017. TOPOGRAPHIC AND UTILITY INFORMATION MAY NOT REFLECT CURRENT CONDITIONS. IT IS THE CONTRACTOR'S RESPONSIBILITY TO FIELD VERIFY ACTUAL SITE CONDITIONS PRIOR TO THE START OF ANY WORK. THERE IS NO WARRANTY OR GUARANTEE ON THE COMPLETENESS OR CORRECTNESS OF THE EXISTING CONDITION INFORMATION. ANY DISCREPANCY FOUND SHALL BE BROUGHT TO THE IMMEDIATE ATTENTION OF THE ENGINEER PRIOR TO THE START OF ANY WORK.
- BEARINGS, COORDINATES AND ELEVATIONS SHOWN ON THIS PLAN ARE SHOWN IN MARYLAND STATE PLANE. ALL VERTICAL CONTROLS ARE BASED ON NAVD 88.
- SOILS INFORMATION TAKEN FROM NRCS WEB SOIL SURVEY DATED APRIL 28, 2017.
- THE SUBJECT PROPERTY ZONED PEC (PLANNED EMPLOYMENT CENTER) PER THE OCTOBER 6, 2013 COMPREHENSIVE ZONING PLAN.
- PREVIOUS DEPARTMENT OF PLANNING AND ZONING FILE NUMBERS:
 SDP-04-76: SERVICES AREA COMPLEX
 F-02-40: SWM BASIN 'A', APFO, FOREST CONSERVATION
 SDP-04-133: BASIN 'C' SWM FACILITIES AND LAYDOWN AREA
 SDP-05-042: JHU/LIBRARIES SERVICES CENTER (FOREST CONSERVATION & WETLANDS UPDATES)
 SDP-03-043: SANNER ROAD IMPROVEMENTS (NEW APFO NUMBER: 4,600)
 F-04-188: FOREST CONSERVATION EASEMENTS RE-PLAT
 F-07-035: FOREST CONSERVATION, RE-PLAT EASEMENT
 SDP-08-084: SERVICES AND SUPPORT AREA INFRASTRUCTURE FACILITY PHASE
- THIS PROJECT COMPLIES WITH THE REQUIREMENTS OF SECTION 16.1200 OF THE HOWARD COUNTY CODE FOR FOREST CONSERVATION BY F-02-40, F-04-188, AND F-07-035. FOREST CONSERVATION OBLIGATION WAS FULFILLED UNDER F-04-188 AND F-07-035.
- NO WETLANDS, STREAMS OR 100-YEAR FLOOD PLAINS EXIST WITHIN 25' OF THIS PROJECT'S LIMIT OF DISTURBANCE.
- NO CEMETERIES EXIST ON THIS SITE BASED ON A SITE VISIT AND AN EXAMINATION OF THE HOWARD COUNTY CEMETERY INVENTORY MAP.
- NO HISTORIC STRUCTURES EXIST ON THE SUBJECT PROPERTY.
- THERE ARE NO EXISTING DWELLINGS ON THIS SITE.
- TRASH PICK UP WILL BE PRIVATELY MAINTAINED.
- NO OFF-SITE ACTIVITIES ARE PROPOSED FOR THIS PROJECT.
- THE SITE IS NOT IN THE AIRPORT ZONE.
- THE PROPERTY IS LOCATED WITHIN THE METROPOLITAN DISTRICT.
- EXISTING WATER IS PUBLIC. WATER DISTRIBUTION WITHIN THE PROPERTY BOUNDARIES IS PRIVATE.
- EXISTING SEWER IS PUBLIC. SEWER COLLECTION WITHIN THE PROPERTY BOUNDARIES IS PRIVATE.
- NO WORK IS PROPOSED IN THE COUNTY RIGHT-OF-WAY. ALL PROPOSED WORK IS INTERIOR TO THE SITE.
- THIS PLAN HAS BEEN PREPARED IN ACCORDANCE WITH THE PROVISIONS OF SECTION 16.124 OF THE HOWARD COUNTY CODE AND LANDSCAPE MANUAL. PERIMETER LANDSCAPING IS NOT REQUIRED WITH THIS SDP BECAUSE THE PROPOSED FIELDS ARE LOCATED INTERNAL TO THE SITE.
- STREET LIGHT PLACEMENT AND THE TYPE OF FIXTURES AND POLES SHALL BE IN ACCORDANCE WITH THE HOWARD COUNTY DESIGN MANUAL, VOLUME III (2006), SECTION 5.5.A. A MINIMUM OF 20' SHALL BE MAINTAINED BETWEEN ANY STREET LIGHT AND ANY TREE.
- STORMWATER MANAGEMENT WILL BE PROVIDED IN ACCORDANCE WITH THE 2010 MDE, CHAPTER 5 REGULATIONS (ESD TO MEP) AND THE LATEST HOWARD COUNTY DESIGN MANUAL, VOL. 1, CHAPTER 5, ADOPTED ON OR ABOUT MAY 4, 2010. RECHARGE VOLUME WILL BE PROVIDED THROUGH THE USE OF A STORMWATER RESERVOIR. STORMWATER MANAGEMENT FACILITIES WILL BE PRIVATELY OWNED AND MAINTAINED BY JOHNS HOPKINS UNIVERSITY. SEVEN (7) ESD PRACTICES SHALL BE USED TO ADDRESS THE SITE PE AND ESDV.
- HEALTH DEPARTMENT APPROVAL OF THIS DEVELOPMENT PLAN DOES NOT ENSURE APPROVAL OF BUILDING PERMIT APPLICATIONS ASSOCIATED WITH THIS PLAN. PLANS FOR CERTAIN FACILITIES TO BE CONSTRUCTED WITHIN THE LIMITS DESCRIBED BY THIS PLAN WILL REQUIRE REVIEW AND APPROVAL BY THE HEALTH DEPARTMENT. SUCH FACILITIES MAY INCLUDE, BUT ARE NOT LIMITED TO, THOSE WHICH HAVE SWIMMING POOLS, OR THAT SELL PREPARED OR PACKAGED FOODS, OR THAT MAY HAVE EQUIPMENT THAT EMITS RADIATION.
- FOR BUILDING ELEVATIONS, SEE SHEET A-101.
- THE CONTRACTOR IS REQUIRED TO OBTAIN ALL NECESSARY PERMITS AND INSPECTIONS.
- WHERE REFERENCE IS MADE TO STANDARD DETAILS IT WILL BE THE CONTRACTOR'S RESPONSIBILITY TO HAVE IN HIS POSSESSION THE LATEST UP-TO-DATE STANDARD DETAILS OF ALL JURISDICTIONS GOVERNING THE SITE. FOR DETAILS NOT SHOWN ON THE DRAWINGS AND FOR ALL MATERIALS AND CONSTRUCTION METHODS, USE HOWARD DESIGN MANUAL, STANDARD SPECIFICATIONS AND DETAILS FOR CONSTRUCTION. ALL CONSTRUCTION SHALL BE IN ACCORDANCE WITH THE LATEST STANDARDS AND SPECIFICATIONS OF HOWARD COUNTY AND MSHA STANDARDS AND SPECIFICATIONS IF APPLICABLE. IT IS THE SOLE RESPONSIBILITY OF THE CONTRACTOR, TO PROVIDE ALL SITE SUB-CONTRACTORS/BIDDERS WITH FULL AND COMPLETE SETS OF ALL CIVIL DRAWINGS AND SPECIFICATIONS FOR THEIR USE IN PREPARING BIDS. THE GENERAL CONTRACTOR/CONSTRUCTION MANAGER SHALL BE RESPONSIBLE FOR ANY AND ALL DELAYS AND COSTS ARISING DURING CONSTRUCTION FROM BIDS BASED UPON INCOMPLETE SETS OF SITE DOCUMENTS.
- THE CONTRACTOR SHALL NOTIFY THE DEPARTMENT OF PUBLIC WORKS/BUREAU OF ENGINEERING/CONSTRUCTION INSPECTION DIVISION AT 410-313-1880 AT LEAST (5) WORKING DAYS PRIOR TO START OF WORK.
- THE CONTRACTOR SHALL NOTIFY "MISS UTILITY" (1-800-257-7777) FIVE (5) DAYS BEFORE STARTING WORK AND THE JOHNS HOPKINS UNIVERSITY, APPLIED PHYSICS LABORATORY FIVE (5) DAYS BEFORE STARTING WORK.
- THE CONTRACTOR SHALL VERIFY ALL EXISTING UTILITY INVERTS AND CLEARANCES FROM NEW WORK PRIOR TO START OF ANY WORK. THE LOCATION OF EXISTING UNDERGROUND UTILITIES IS SHOWN IN AN APPROXIMATE WAY ONLY, BASED UPON RECORD DOCUMENTS. THEY HAVE NOT BEEN COMPARED TO OR VERIFIED WITH FIELD TEST PITS. THE CONTRACTOR SHALL BE RESPONSIBLE TO VERIFY TO HIS OWN SATISFACTION THE EXACT LOCATION, SIZE AND TYPE OF ALL EXISTING UNDERGROUND UTILITIES BEFORE COMMENCING ANY WORK. THE CONTRACTOR MUST NOTIFY THE UTILITY COMPANIES AFFECTED BY THE PROJECT PRIOR TO THE START OF THE WORK. CONTRACTOR AGREES TO BE FULLY RESPONSIBLE FOR THE COST OF ANY AND ALL DAMAGES WHICH OCCUR AS A RESULT OF A FAILURE TO EXACTLY LOCATE AND PRESERVE ANY AND ALL EXISTING UTILITIES TO REMAIN THE CONTRACTOR MUST PROTECT AND MINIMIZE INTERRUPTIONS TO ALL EXISTING UTILITY SERVICES/HOUSE CONNECTIONS INCLUDING GAS, ELECTRIC, TELEPHONE, WATER AND SEWER DURING CONSTRUCTION, UNLESS OTHERWISE AUTHORIZED BY THE ENGINEER.
- EXISTING UTILITIES WHICH ARE NOT TO BE REMOVED OR ABANDONED SHALL REMAIN OPERATIONAL AT ALL TIMES. APPROPRIATE EXISTING UTILITIES SHALL REMAIN IN SERVICE UNTIL REPLACEMENT/RELOCATED UTILITIES ARE OPERATIONAL.
- ALL EXISTING SITE FEATURES IMPACTED BY THE PROPOSED WORK SHALL BE RESTORED TO PRE-CONSTRUCTION CONDITIONS UNLESS OTHERWISE NOTED OR DIRECTED BY THE ENGINEER. ALL EXISTING UTILITIES ARE TO BE ADJUSTED TO FINISHED GRADE AND TO REMAIN IN SERVICE UNLESS OTHERWISE NOTED.
- THE CONTRACTOR SHALL REPAIR OR REPLACE FACILITIES DISTURBED OR DAMAGED BY HIS OPERATIONS INSIDE AND OUTSIDE OF THE PROJECT LIMITS, TO THE OWNERS SATISFACTION AND AT NO ADDITIONAL EXPENSE.
- ALL PLAN DIMENSIONS ARE TO FACE OF CURB UNLESS OTHERWISE NOTED. NUMERICAL DIMENSIONS AND ELEVATIONS SHOWN SHALL SUPERSEDE ANY DISCREPANCY IN THE SCALINGS ON THE DRAWINGS.
- ALL GRADING AND EXCAVATION SHALL BE PERFORMED IN ACCORDANCE WITH THE GEOTECHNICAL ENGINEER'S REPORT AND INSPECTED BY A GEOTECHNICAL ENGINEER.
- CONSTRUCTION OF SUBGRADE, UNDERDRAINS, AND PAVING SHALL BE INSPECTED AND APPROVED BY THE GEOTECHNICAL ENGINEER.
- LIMIT OF DISTURBANCE AS SHOWN ON ALL CIVIL DRAWINGS IS APPROXIMATE AND SHALL NOT PREVENT THE CONTRACTOR FROM EXTENDING BEYOND THESE LIMITS FOR COMPLETE INSTALLATION OF PROJECT ELEMENTS.
- CONTRACTOR SHALL PROVIDE POSITIVE DRAINAGE AWAY FROM ALL EXISTING AND PROPOSED BUILDING ENTRANCES DURING ALL PHASES OF CONSTRUCTION, UNLESS OTHERWISE NOTED IN THESE DOCUMENTS. CONTRACTOR SHALL NOTIFY ENGINEER / OWNER IF EXISTING OR PROPOSED CONDITIONS RESTRICT ABILITY TO ACHIEVE POSITIVE DRAINAGE FROM BUILDINGS PRIOR TO THE START OF CONSTRUCTION.
- ALL WATER MAINS TO BE DIPP, UNLESS OTHERWISE NOTED. TOPS OF ALL WATER MAINS TO HAVE A MINIMUM OF 4' COVER UNLESS OTHERWISE NOTED.
- ALL DISTURBED AREAS NOT STABILIZED WITH STRUCTURES, PAVING, AND/OR PLANTINGS SHALL BE STABILIZED WITH FOUR INCHES OF TOPSOIL, SEED, MULCH AND WATERED TO ESTABLISH AN ADEQUATE GROWTH OF GRASSES AS SPECIFIED ON THE EROSION AND SEDIMENT CONTROL PLANS.
- NO GRADING, REMOVAL OF VEGETATIVE COVER OR TREES, PAVING AND NEW STRUCTURES SHALL BE PERMITTED WITHIN WETLANDS, STREAM(S) OR THEIR BUFFERS, FOREST CONSERVATION EASEMENT AREAS AND 100-YEAR FLOODPLAIN.
- A WAIVER HAS BEEN SUBMITTED FOR THE USE OF POROUS ASPHALT IN THE PROPOSED DRIVEWAYS AND WAS APPROVED ON 06/11/2018.
- A WAIVER WAS APPROVED ON SEPTEMBER 12, 2023 TO ALLOW NCMA STANDARDS FOR THE DESIGN OF THE RETAINING WALL.

THE JOHNS HOPKINS UNIVERSITY

APPLIED PHYSICS LABORATORY

OUTDOOR TESTING AREAS

SITE DEVELOPMENT PLAN

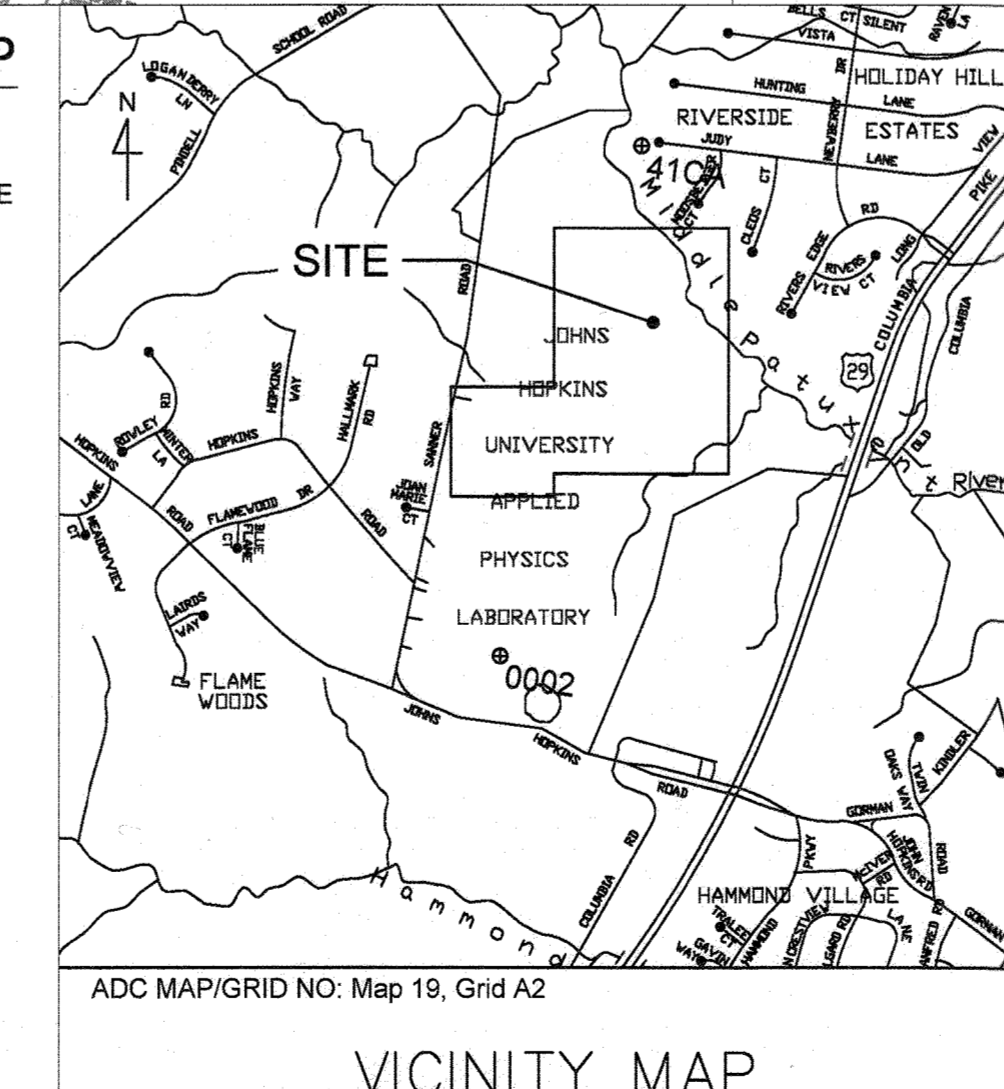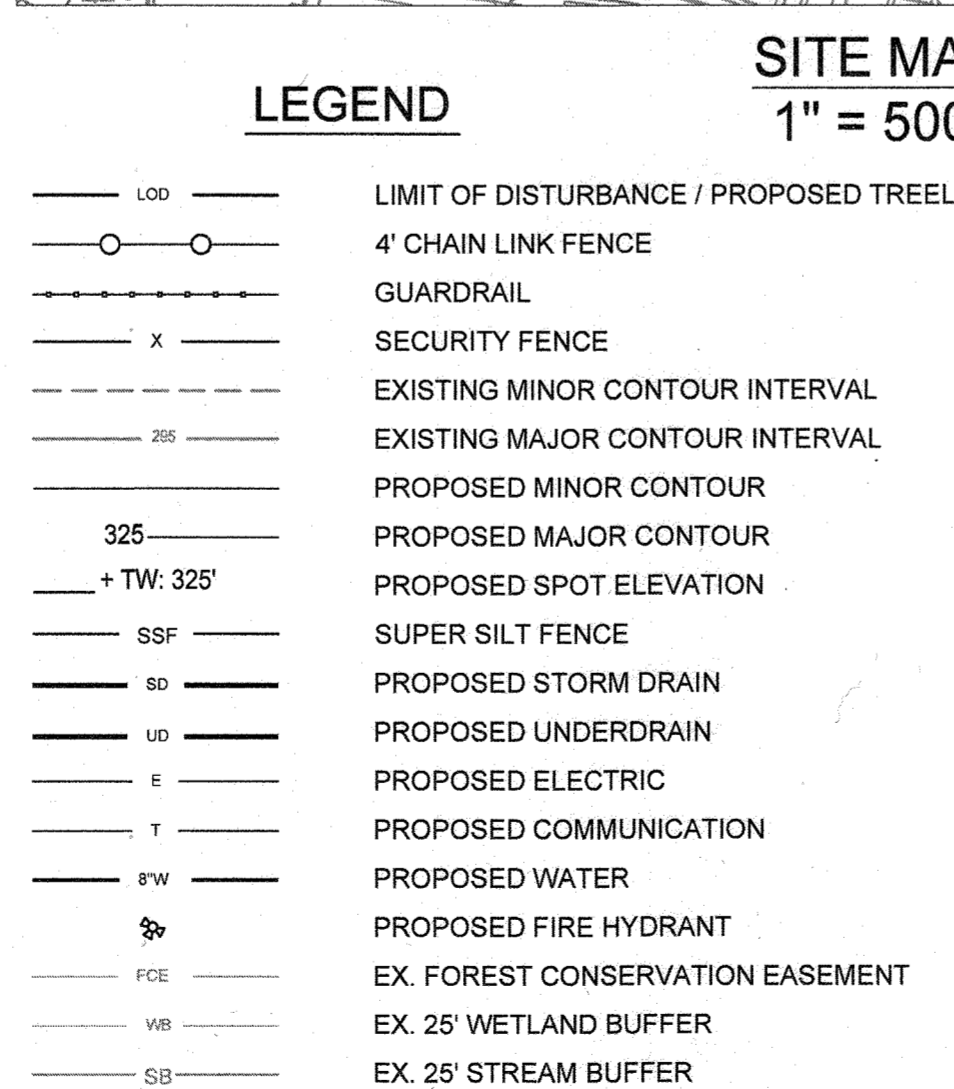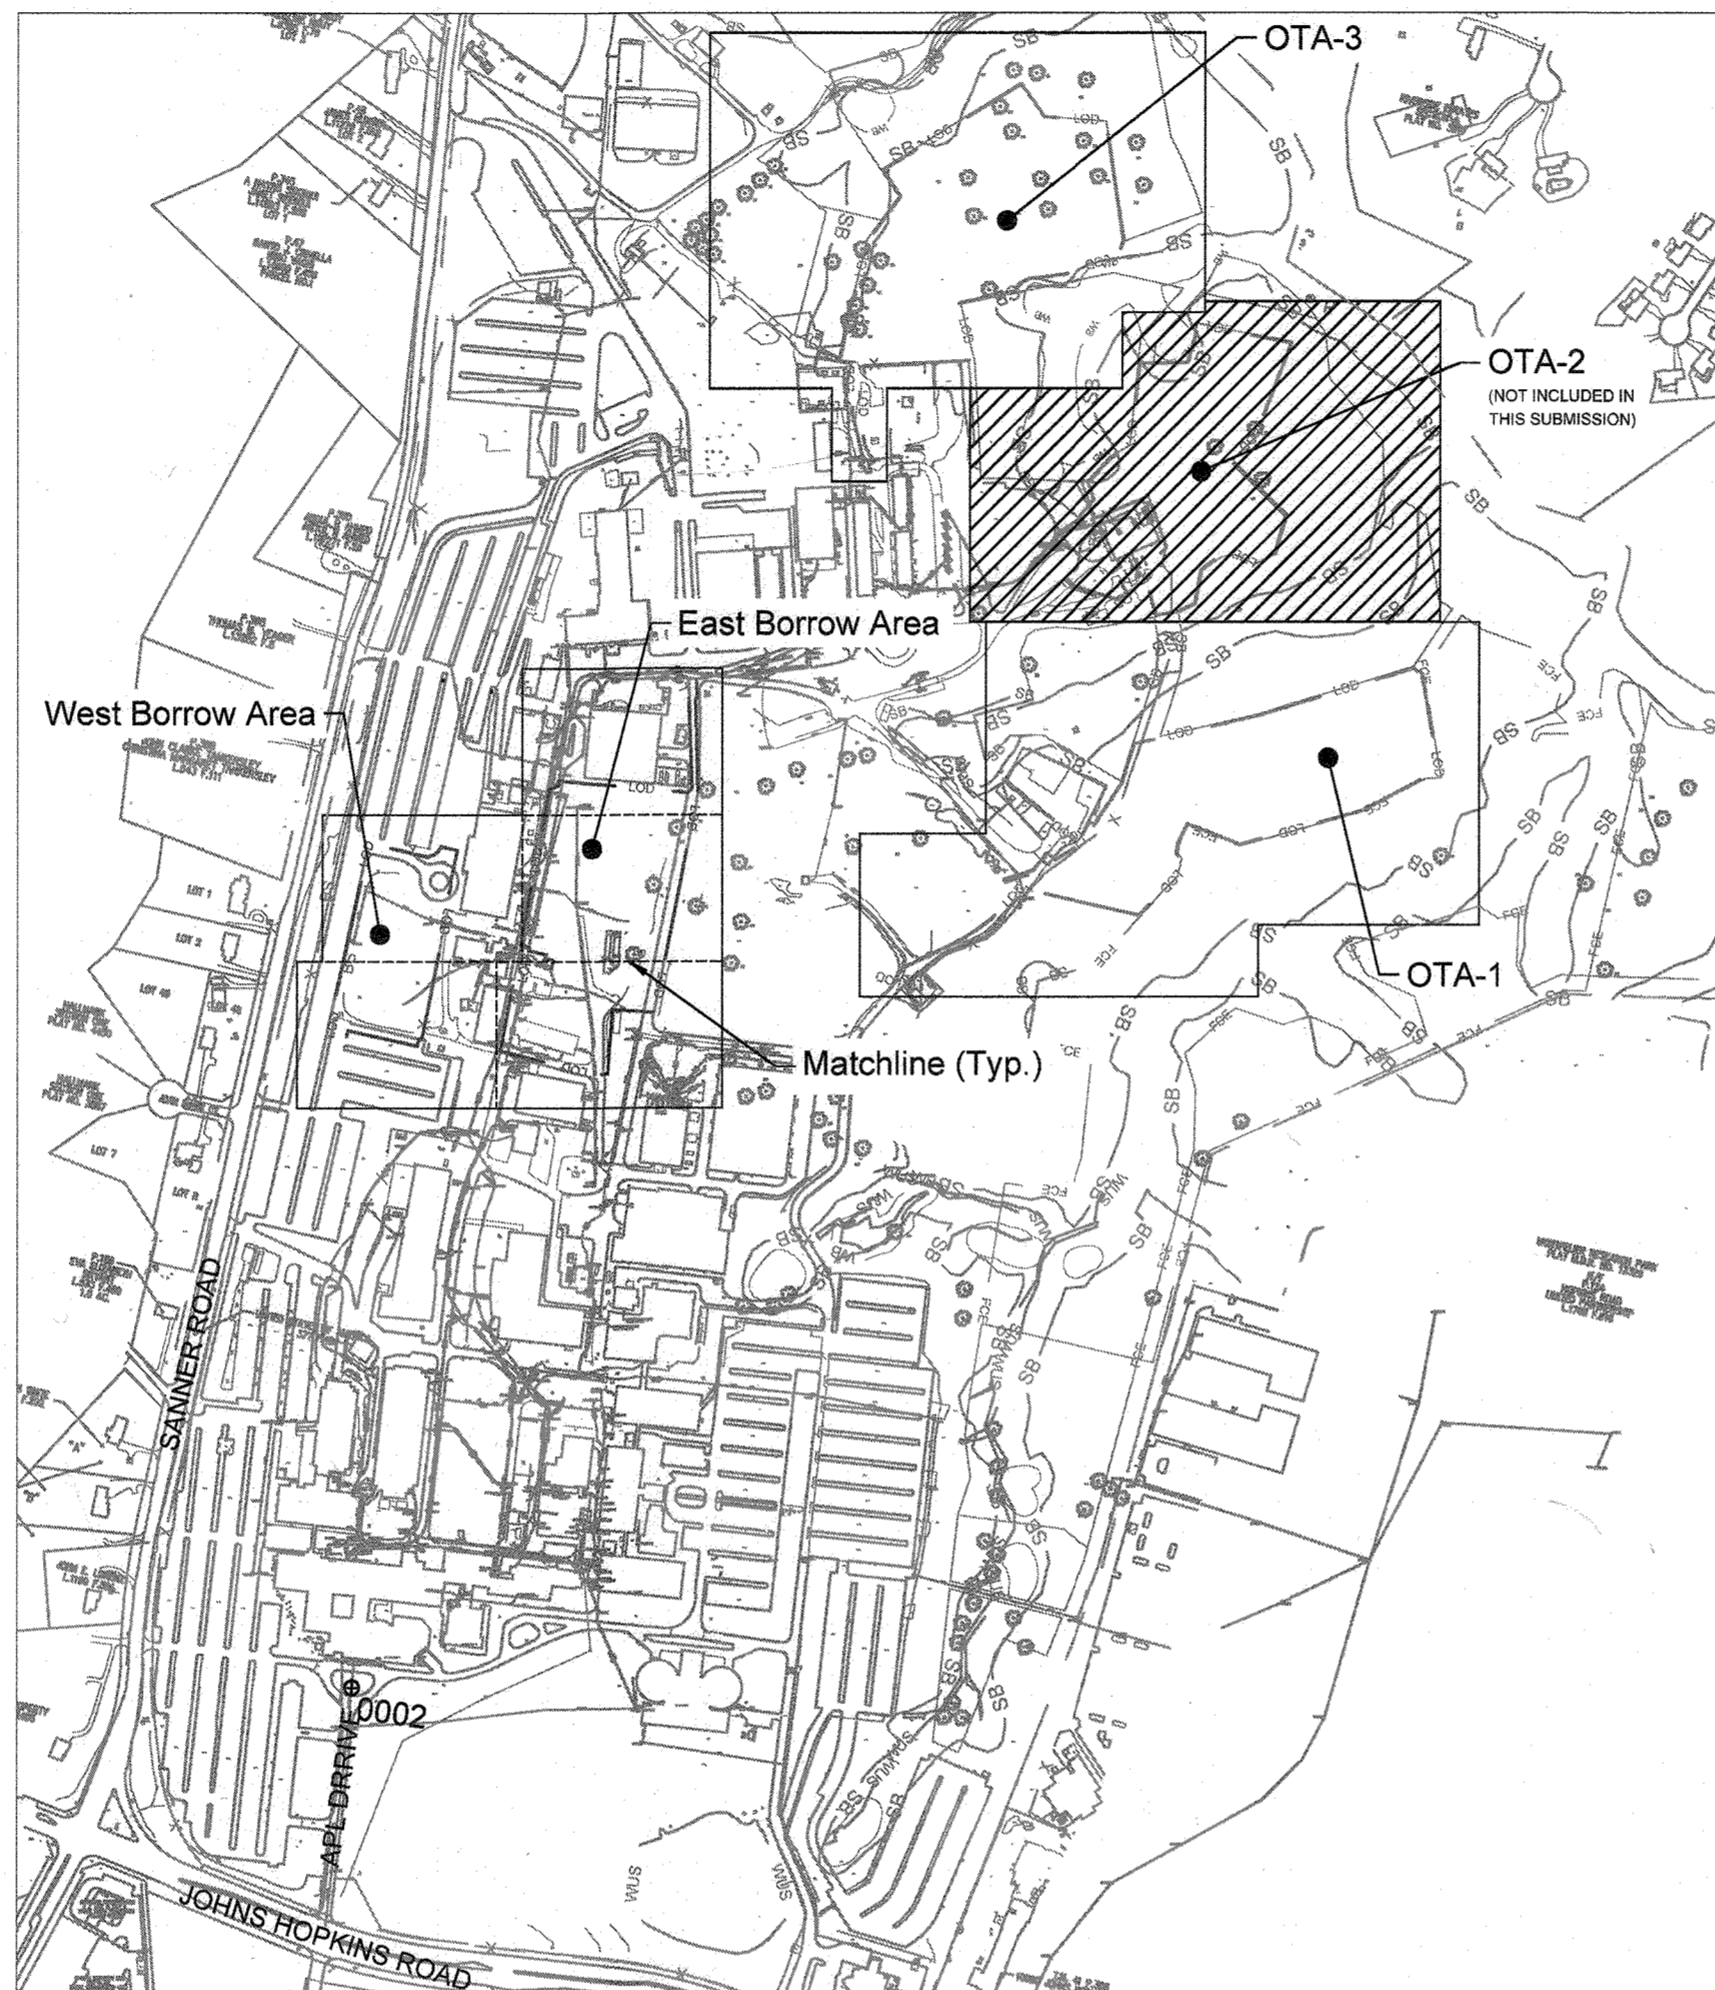

| INDEX OF SHEETS | | |
|-----------------|-------------|--|
| SHEET NUMBER | SHEET TITLE | SHEET DESCRIPTION |
| 01 | C-001 | Cover Sheet |
| 02 | A-101 | Shed Plan & Elevation; Concrete Pad Detail |
| 03 | A-106 | Shed Plan & Elevation - OTA 3 (Phase 2) |
| 04 | C-101 | Ex. Condition & Demo Plan - OTA 1 (Phase 1) |
| 05 | C-103 | Ex. Condition & Demo Plan - OTA 3 (Phase 2) |
| 06 | C-201 | Site, Grading and Utility Plan - OTA 1 (Phase 1) |
| 07 | C-203 | Site, Grading and Drainage Plan - OTA 3 (Phase 2) |
| 08 | C-204 | Layout Plan - OTA 1 (Phase 1) |
| 09 | C-206 | Layout Plan - OTA 3 (Phase 2) |
| 10 | C-207 | Roadway Profiles - OTA 1 (Phase 1) |
| 11 | C-208 | Roadway Profiles - OTA 1 (Phase 1) |
| 12 | C-212 | Roadway Profiles - OTA 3 (Phase 2) |
| 13 | C-213 | Roadway Profiles - OTA 3 (Phase 2) |
| 14 | C-214 | Roadway Profiles - OTA 3 (Phase 2) |
| 15 | C-215 | Site Details & Structure Table |
| 16 | C-220 | Storm Drain Profiles |
| 17 | C-281 | Ex. Condition & Demo Plan - East Borrow Area (Phase 2) |
| 18 | C-282 | Ex. Condition & Demo Plan - East Borrow Area (Phase 2) |
| 19 | C-283 | Ex. Condition & Demo Plan - East Borrow Area (Phase 2) |
| 20 | C-284 | Ex. Condition & Demo Plan - West Borrow Area (Phase 2) |
| 21 | C-285 | Ex. Condition & Demo Plan - West Borrow Area (Phase 2) |
| 22 | C-286 | Site and Grading Plan - East Borrow Area (Phase 2) |
| 23 | C-287 | Site and Grading Plan - East Borrow Area (Phase 2) |
| 24 | C-288 | Site and Grading Plan - East Borrow Area (Phase 2) |
| 25 | C-289 | Site and Grading Plan - West Borrow Area (Phase 2) |
| 26 | C-290 | Site and Grading Plan - West Borrow Area (Phase 2) |
| 27 | C-291 | Utility Plan - East Borrow Area (Phase 2) |
| 28 | C-292 | Utility Plan - East Borrow Area (Phase 2) |
| 29 | C-293 | Utility Plan - East Borrow Area (Phase 2) |
| 30 | C-294 | Site Details - Borrow Area |
| 31 | C-295 | Water Profiles - Borrow Area (Phase 2) |
| 32 | C-296 | Sanitary & Storm Sewer Profiles - Borrow Area (Phase 2) |
| 33 | C-320 | Retaining Wall Elevation - OTA 1 (Phase 1) |
| 34 | C-321 | Retaining Wall Elevation - OTA 1 (Phase 1) |
| 35 | C-322 | Retaining Wall Elevation - OTA 1 (Phase 1) |
| 36 | C-323 | Retaining Wall Elevation - OTA 1 (Phase 1) |
| 37 | C-327 | Retaining Wall Elevation - OTA 3 (Phase 2) |
| 38 | C-328 | Retaining Wall Elevation - OTA 3 (Phase 2) |
| 39 | C-329 | Retaining Wall Elevation - OTA 3 (Phase 2) |
| 40 | C-330 | Segmental Block Retaining Wall Section |
| 41 | C-331 | Segmental Block Retaining Wall Section - OTA 3 (Phase 2) |
| 42 | C-501 | Stormwater Management Plan - OTA 1 (Phase 1) |
| 43 | C-503 | Stormwater Management Plan - OTA 3 (Phase 2) |
| 44 | C-504 | SWM Notes |

| INDEX OF SHEETS | | |
|-----------------|-------------|---|
| SHEET NUMBER | SHEET TITLE | SHEET DESCRIPTION |
| 45 | C-505 | SWM Details |
| 46 | C-506 | SWM Landscaping Plan - OTA 3 (Phase 2) |
| 47 | C-581 | Stormwater Management Plan - East Borrow Area (Phase 2) |
| 48 | C-582 | Stormwater Management Plan - West Borrow Area (Phase 2) |
| 49 | C-601 | Erosion Sediment Control Plan - OTA 1 (ESC Phase 1A) |
| 50 | C-602 | Erosion Sediment Control Plan - OTA 1 (ESC Phase 1B) |
| 51 | C-605 | Erosion Sediment Control Plan - OTA 3 (ESC Phase 2A) |
| 52 | C-606 | Erosion Sediment Control Plan - OTA 3 (ESC Phase 2B) |
| 53 | C-607 | Erosion Sediment Control Notes & Details |
| 54 | C-608 | Erosion Sediment Control Notes & Details |
| 55 | C-609 | Erosion Sediment Control Details |
| 56 | C-681 | Erosion Sediment Control Plan - East Borrow Area (ESC Phase 2A) |
| 57 | C-682 | Erosion Sediment Control Plan - East Borrow Area (ESC Phase 2A) |
| 58 | C-683 | Erosion Sediment Control Plan - East Borrow Area (ESC Phase 2A) |
| 59 | C-684 | Erosion Sediment Control Plan - West Borrow Area (ESC Phase 2A) |
| 60 | C-685 | Erosion Sediment Control Plan - West Borrow Area (ESC Phase 2A) |
| 61 | C-686 | Erosion Sediment Control Plan - East Borrow Area (ESC Phase 2B) |
| 62 | C-687 | Erosion Sediment Control Plan - East Borrow Area (ESC Phase 2B) |
| 63 | C-688 | Erosion Sediment Control Plan - East Borrow Area (ESC Phase 2B) |
| 64 | C-689 | Erosion Sediment Control Plan - West Borrow Area (ESC Phase 2B) |
| 65 | C-690 | Erosion Sediment Control Plan - West Borrow Area (ESC Phase 2B) |
| 66 | C-691 | Erosion Sediment Control Plan - East Borrow Area (ESC Phase 2C) |
| 67 | C-692 | Erosion Sediment Control Plan - East Borrow Area (ESC Phase 2C) |
| 68 | C-693 | Erosion Sediment Control Plan - East Borrow Area (ESC Phase 2C) |
| 69 | C-694 | Erosion Sediment Control Plan - West Borrow Area (ESC Phase 2C) |
| 70 | C-695 | Erosion Sediment Control Plan - West Borrow Area (ESC Phase 2C) |
| 71 | C-696 | Erosion Control Notes & Details - Borrow Area |
| 72 | C-697 | Erosion Control Notes & Details - Borrow Area |
| 73 | C-698 | Erosion Control Profiles & Details - Borrow Area |

GEODETIC CONTROL

▲ PURPOSE STATEMENT (11/1/23): DESIGN OF OUTDOOR TESTING AREA 3; INCLUDING THE SOURCE OF BORROW MATERIAL REFERRED TO AS THE EAST AND WEST BORROW AREAS.

▲ PURPOSE STATEMENT (4/7/22): ADDITION OF TWO 6"x40" CONCRETE PADS

| ADDRESS CHART | |
|---------------|--------------------------|
| LOT/PARCEL # | STREET ADDRESS |
| 1/123 | 11100 JOHNS HOPKINS ROAD |

| PERMIT INFORMATION CHART | | | | | |
|--------------------------|-------|----------------|--------|----------------|--------|
| SUBDIVISION NAME | N/A | SECTION AREA | N/A | LOT/PARCEL NO. | 1/123 |
| PLAT # of LR | 18968 | GRID # | 16 | ZONING | PEC |
| TAX MAP NO. | 41 | ELECT DISTRICT | 5 | CENSUS TRACT | 605102 |
| WATER CODE | E21 | SEWER CODE | 648000 | | |

APPROVED: FOR PUBLIC WATER AND PUBLIC SEWERAGE

[Signature]
 County Health Officer
 Howard County Health Department
 Date: 11/1/23


APPROVED: DEPARTMENT OF PLANNING AND ZONING

[Signature]
 Chief, Development Engineering Division
 Date: 12.5.23

[Signature]
 Chief, Division of Land Development
 Director
 Date: 2/22/24



PROFESSIONAL CERTIFICATION. I HEREBY CERTIFY THAT THESE DOCUMENTS WERE PREPARED OR APPROVED BY ME AND THAT I AM A DULY LICENSED PROFESSIONAL ENGINEER UNDER THE LAWS OF THE STATE OF MARYLAND. LICENSE NO. 4842, EXPIRATION DATE: MAY 31, 2024.

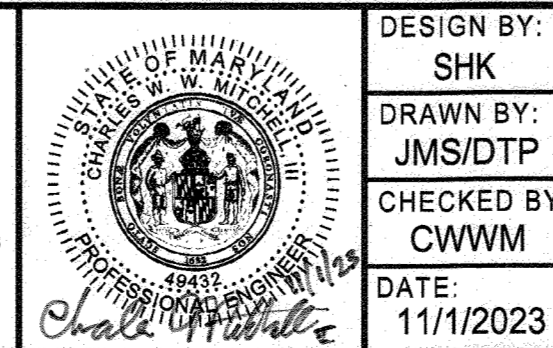

| DESIGN BY: | DATE: | BY | NO. | REVISION | DATE |
|------------|-----------|----|-----|----------|------|
| SHK | 11/1/2023 | | | | |
| JMS/DTP | | | | | |
| CWMM | | | | | |
| | | | | | |

OWNER/DEVELOPER

JOHNS HOPKINS APPLIED PHYSICS LABORATORY
 11100 JOHNS HOPKINS ROAD
 LAUREL, MARYLAND 20723


COVER SHEET

JOHNS HOPKINS UNIVERSITY - APPLIED PHYSICS LABORATORY


OUTDOOR TESTING AREAS

11100 JOHNS HOPKINS ROAD
 TAX MAP: 41 PARCEL: 123 GRID: 16 ZONED: PEC
 ELECTION DISTRICT 5 - HOWARD COUNTY, MARYLAND
 SHEET 01 OF 73


RK&K PROJECT NUMBER: 21047.013
 SCALE: As Shown

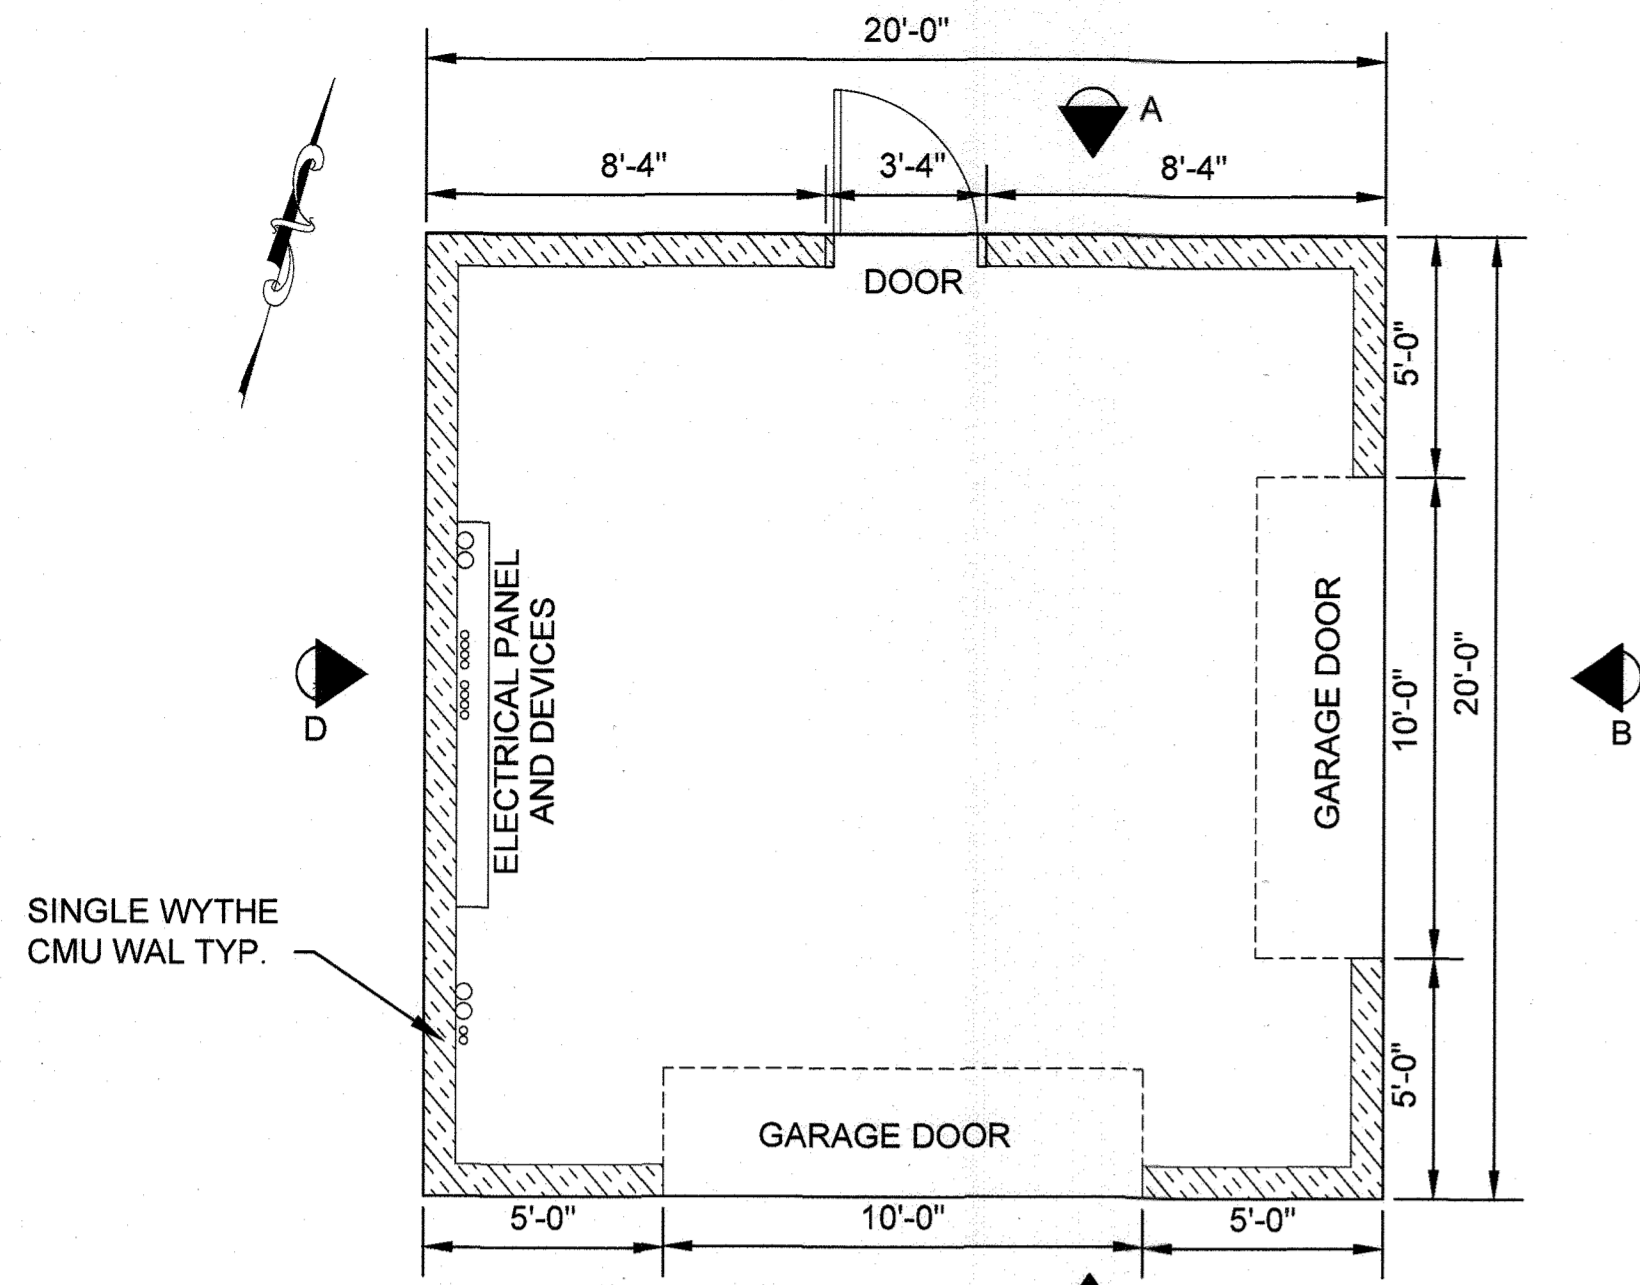

OTA # 1 FLOOR PLAN
SCALE: 1/4" = 1'

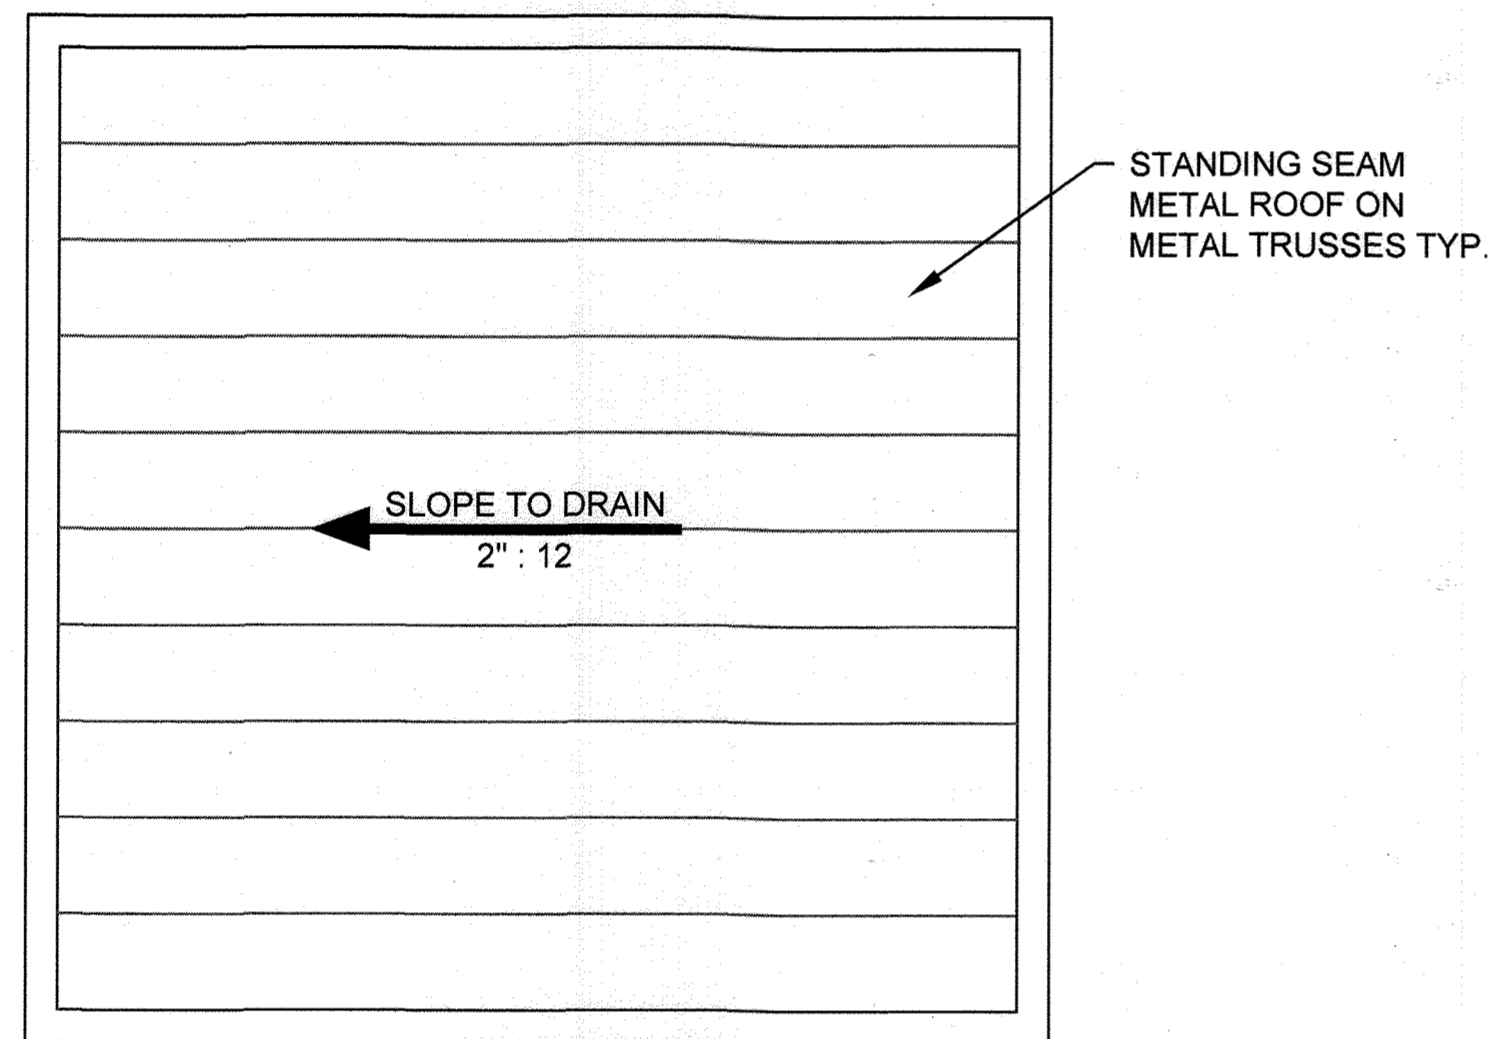


OTA # 1 ROOF PLAN
SCALE: 1/4" = 1'

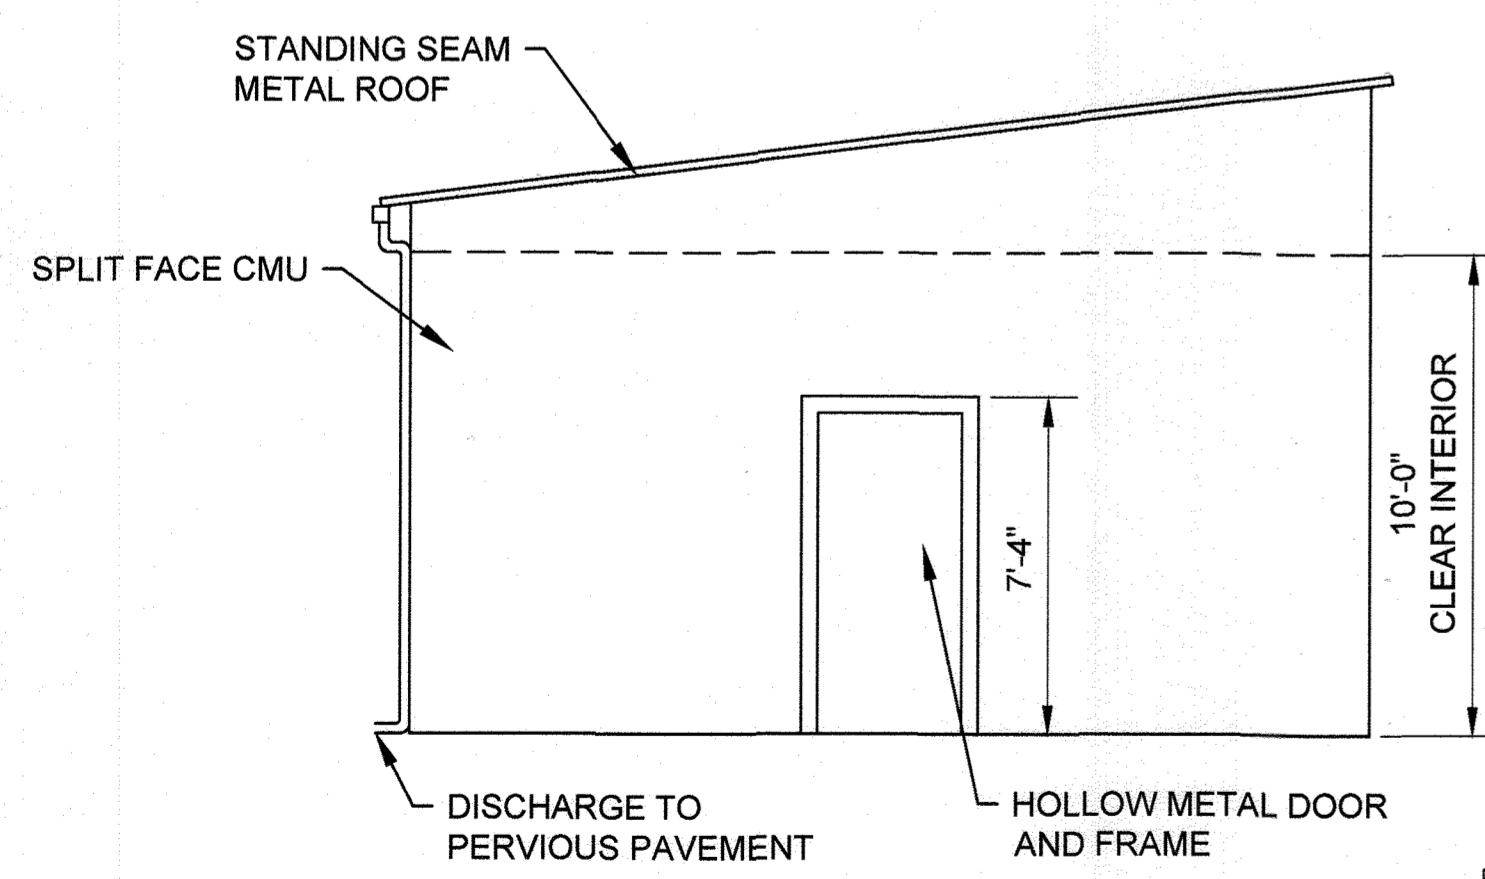


ELEVATION A
SCALE: 1/4" = 1'




PROFESSIONAL CERTIFICATION I HEREBY CERTIFY THAT THESE DOCUMENTS WERE PREPARED OR APPROVED BY ME, AND THAT I AM A DULY LICENSED PROFESSIONAL ENGINEER UNDER THE LAWS OF THE STATE OF MARYLAND.
LICENSE NO. 44432 EXPIRATION DATE: 5/31/24

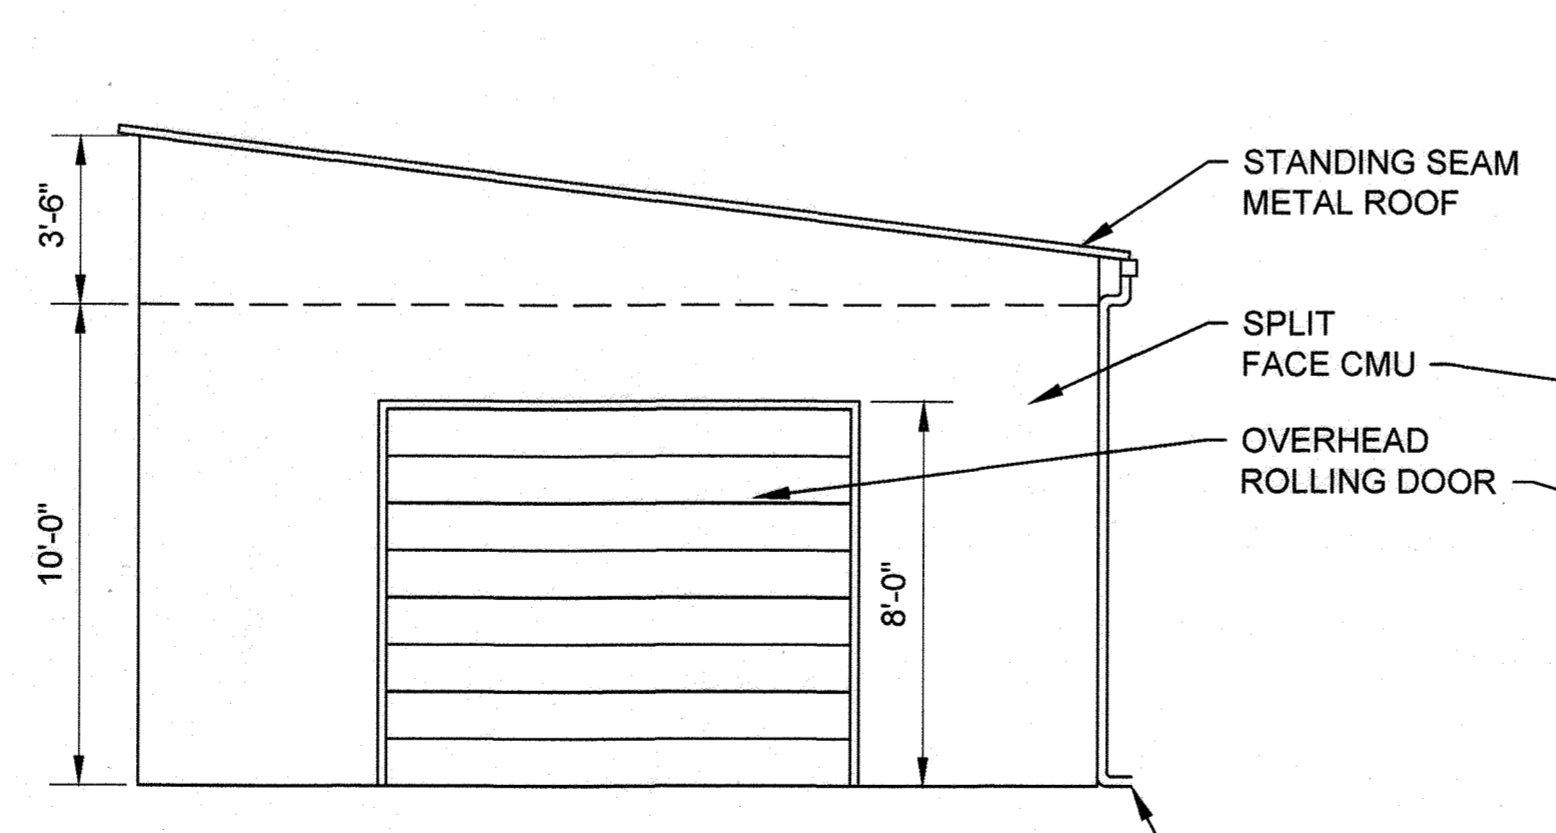


ELEVATION B
SCALE: 1/4" = 1'

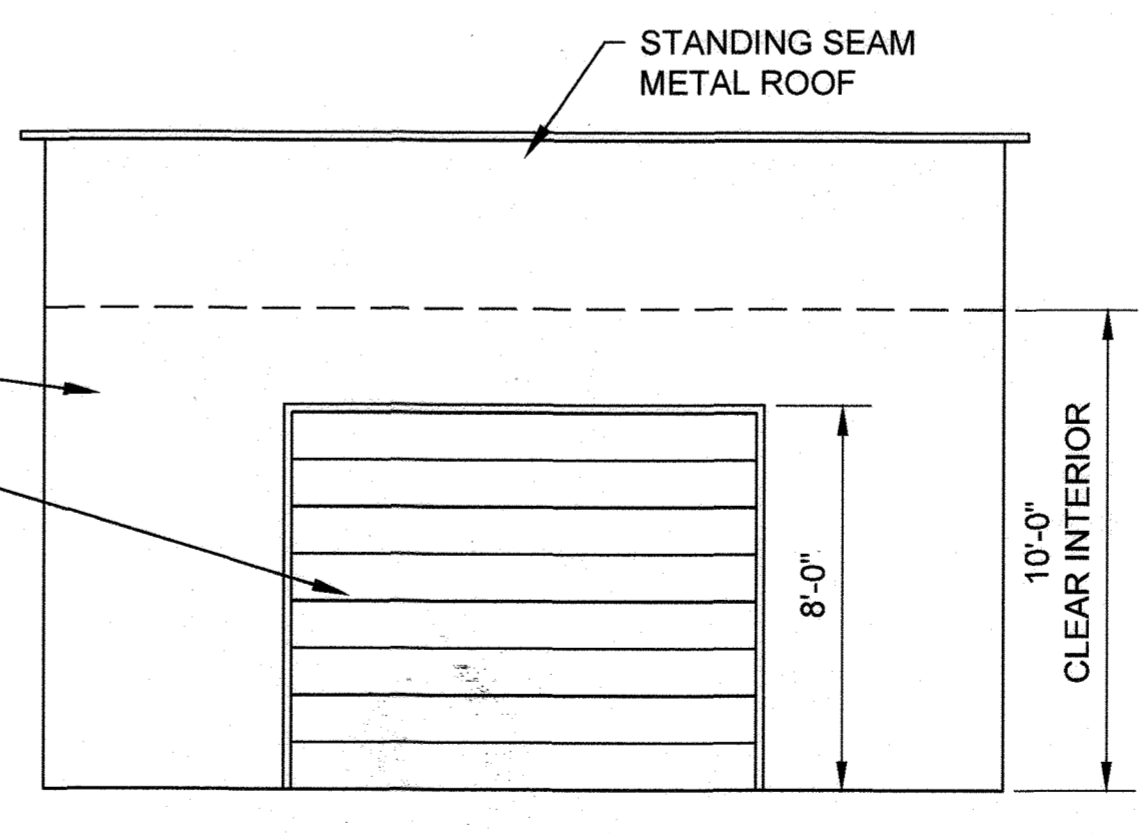

ELEVATION C
SCALE: 1/4" = 1'

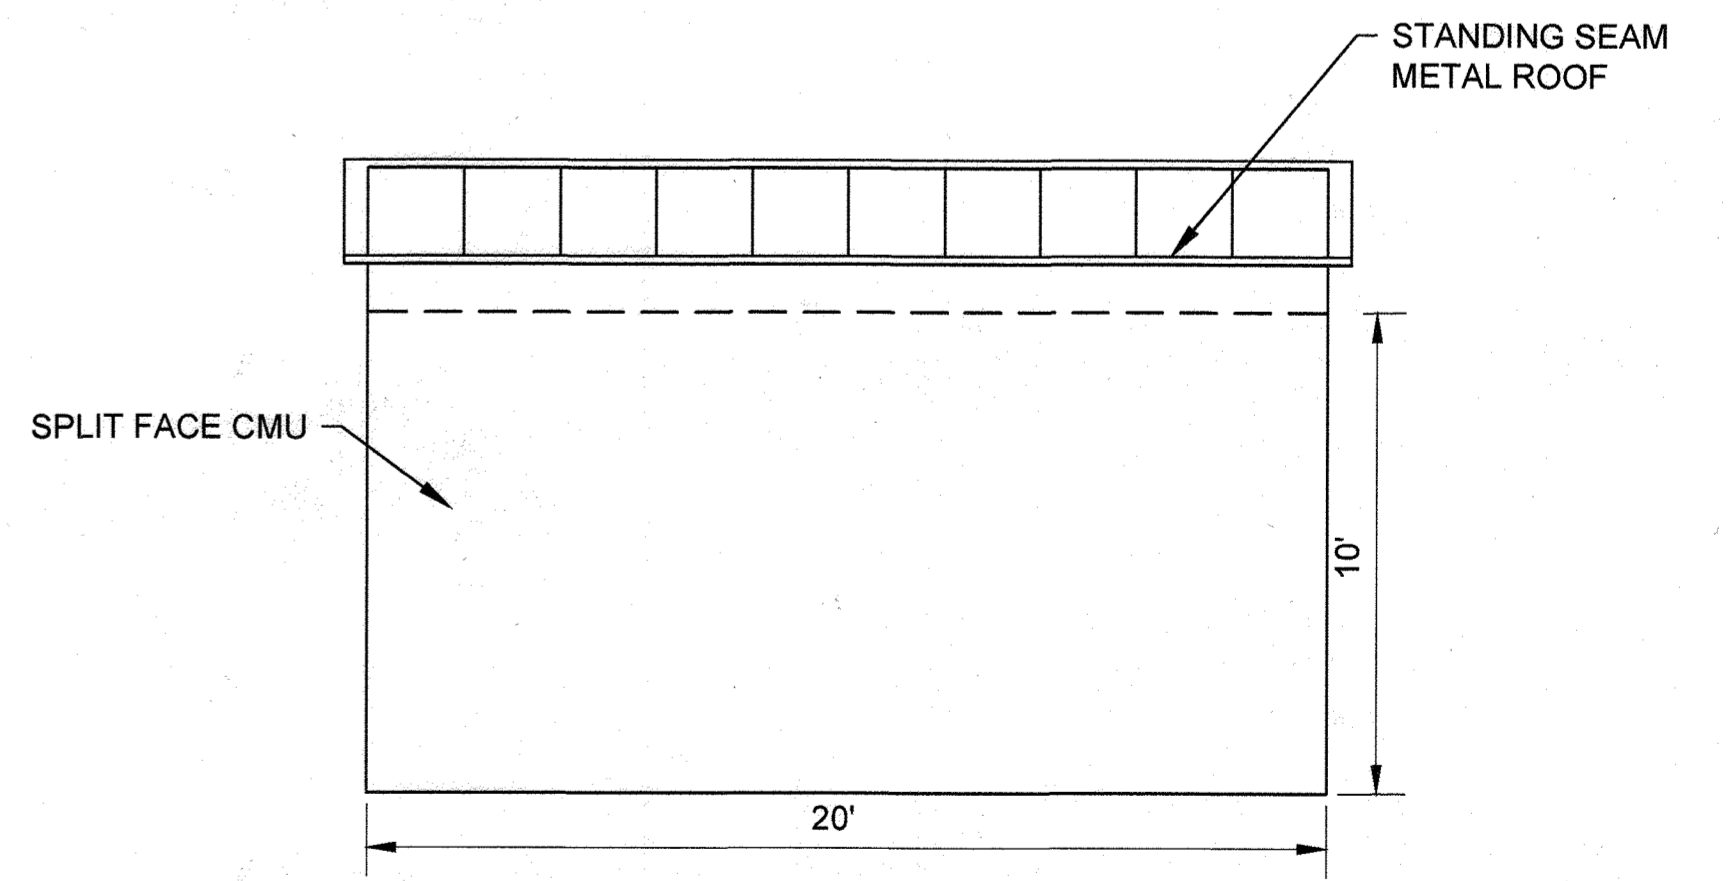


ELEVATION D
SCALE: 1/4" = 1'

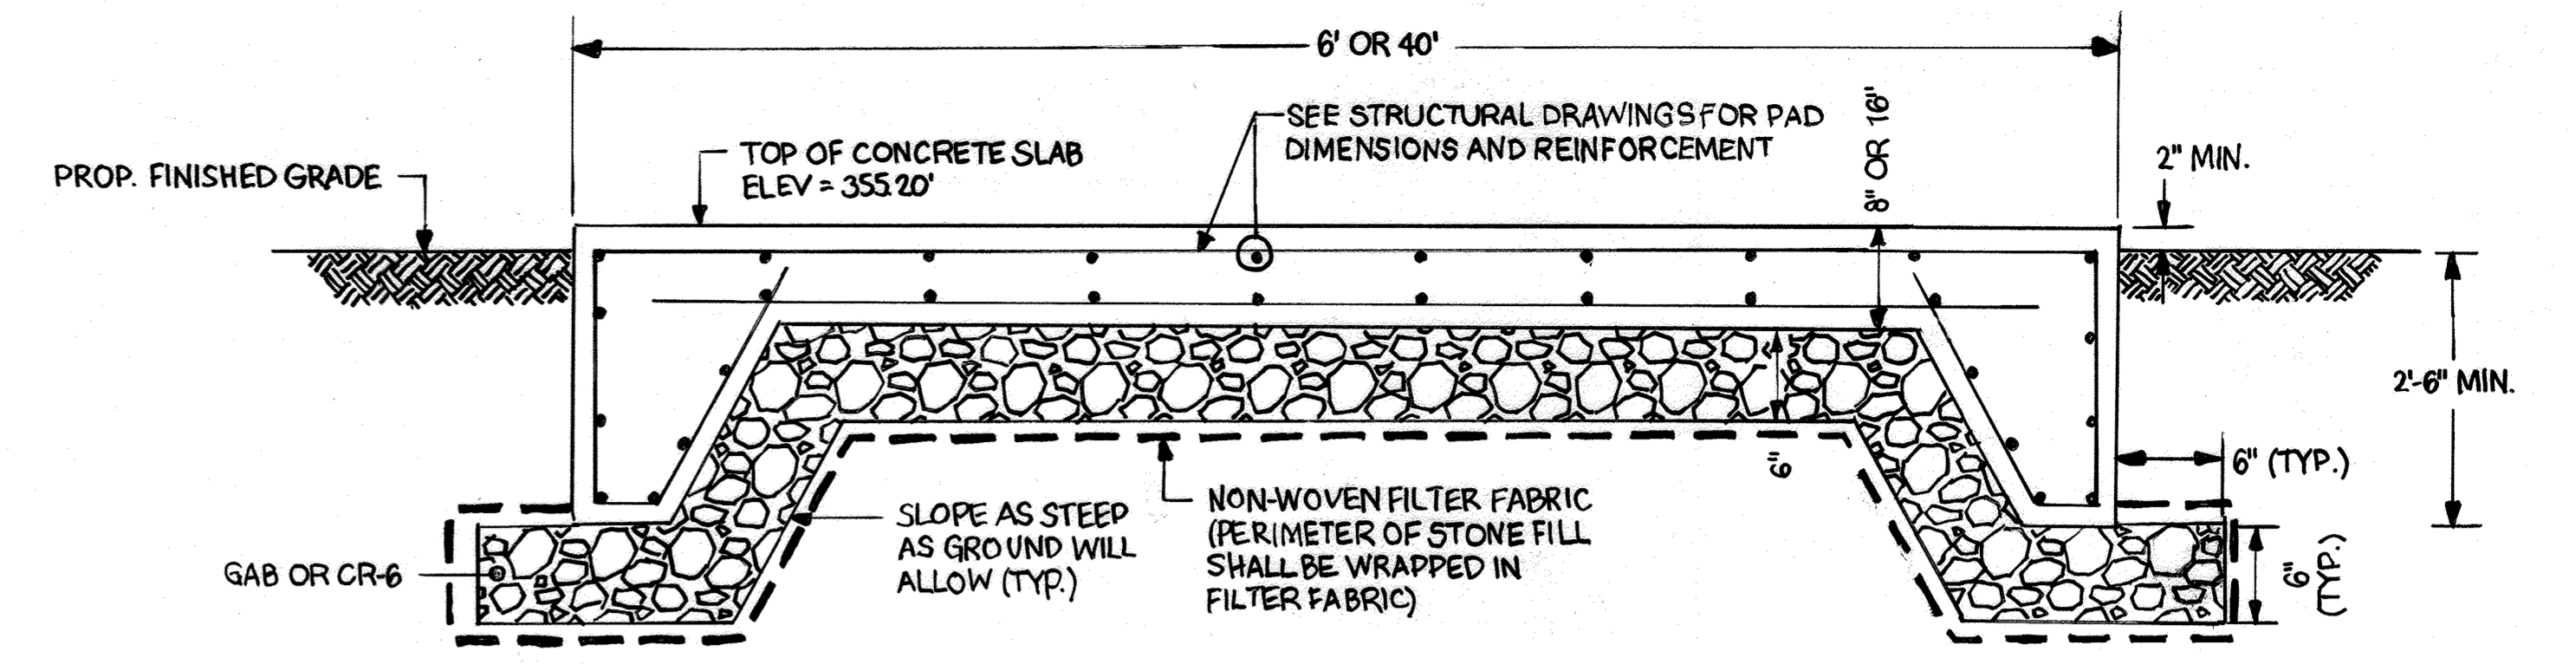

3 CONCRETE PAD DETAIL
NOT TO SCALE

3 PURPOSE STATEMENT (417)22: ADDITION OF TWO 4'X40' CONCRETE PADS.


NOAs-Built Information in this sheet 2/14/23

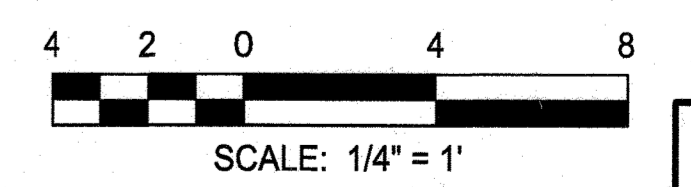

APPROVED: DEPARTMENT OF PLANNING AND ZONING
 Chief, Development Engineering Division
 Date: 4-21-18
 Chief, Division of Land Development
 Date: 8-26-18
 Director



PROFESSIONAL CERTIFICATION I HEREBY CERTIFY THAT THESE DOCUMENTS WERE PREPARED OR APPROVED BY ME, AND THAT I AM A DULY LICENSED PROFESSIONAL ENGINEER UNDER THE LAWS OF THE STATE OF MARYLAND.
LICENSE NO. 20012 EXPIRATION DATE: MARCH 6, 2016.

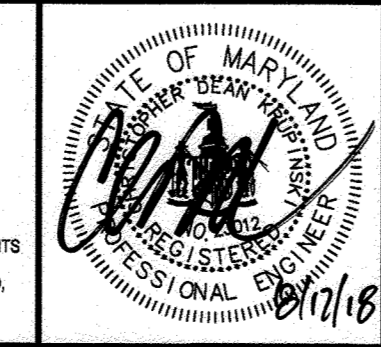

| | | | | |
|-------------|---------|----------|--------------------------------------|--------|
| DESIGN BY: | RK&K | 3 | ADDITION OF TWO 4'X40' CONCRETE PADS | 4/7/22 |
| DRAWN BY: | CWMM | | | |
| CHECKED BY: | CDK | | | |
| DATE: | 8/17/18 | | | |
| BY | NO. | REVISION | | DATE |


OWNER/DEVELOPER
JOHNS HOPKINS APPLIED PHYSICS LABORATORY
 11100 JOHNS HOPKINS ROAD
 LAUREL, MARYLAND 20723

SHED PLAN & ELEVATION AS-BUILT
 JOHNS HOPKINS UNIVERSITY - APPLIED PHYSICS LABORATORY
OUTDOOR TESTING AREAS
 11100 JOHNS HOPKINS ROAD
 ELECTION DISTRICT 5 - HOWARD COUNTY, MARYLAND
 SHEET 02 OF 73

A-101
 RK&K PROJECT NUMBER 17152
 SCALE: As Shown

LEGEND

- EXISTING MINOR CONTOUR
- 670 EXISTING MAJOR CONTOUR
- EX 15" D. EXISTING STORM DRAIN AND INLET
- EX 12" W. EXISTING WATER AND FIRE HYDRANT
- EX 8" S. EXISTING SEWER
- E EXISTING ELECTRIC
- * EXISTING LIGHT POLE
- C EXISTING COMMUNICATION
- X EXISTING FENCE
- - - EXISTING SOIL BOUNDARY
- FCE EXISTING FOREST CONSERVATION EASEMENT
- WB EXISTING WETLAND BUFFER
- EXISTING TREE LINE
- EXISTING BUILDING
- EXISTING SLOPE GREATER THAN 20%
- EXISTING WETLAND
- CLEAR AND GRUB
- EXISTING PAVEMENT TO BE REMOVED
- - - EXISTING UTILITY TO BE REMOVED
- LOD LIMITS OF DISTURBANCE
- FENCE REMOVAL
- TREE PROTECTION FENCE

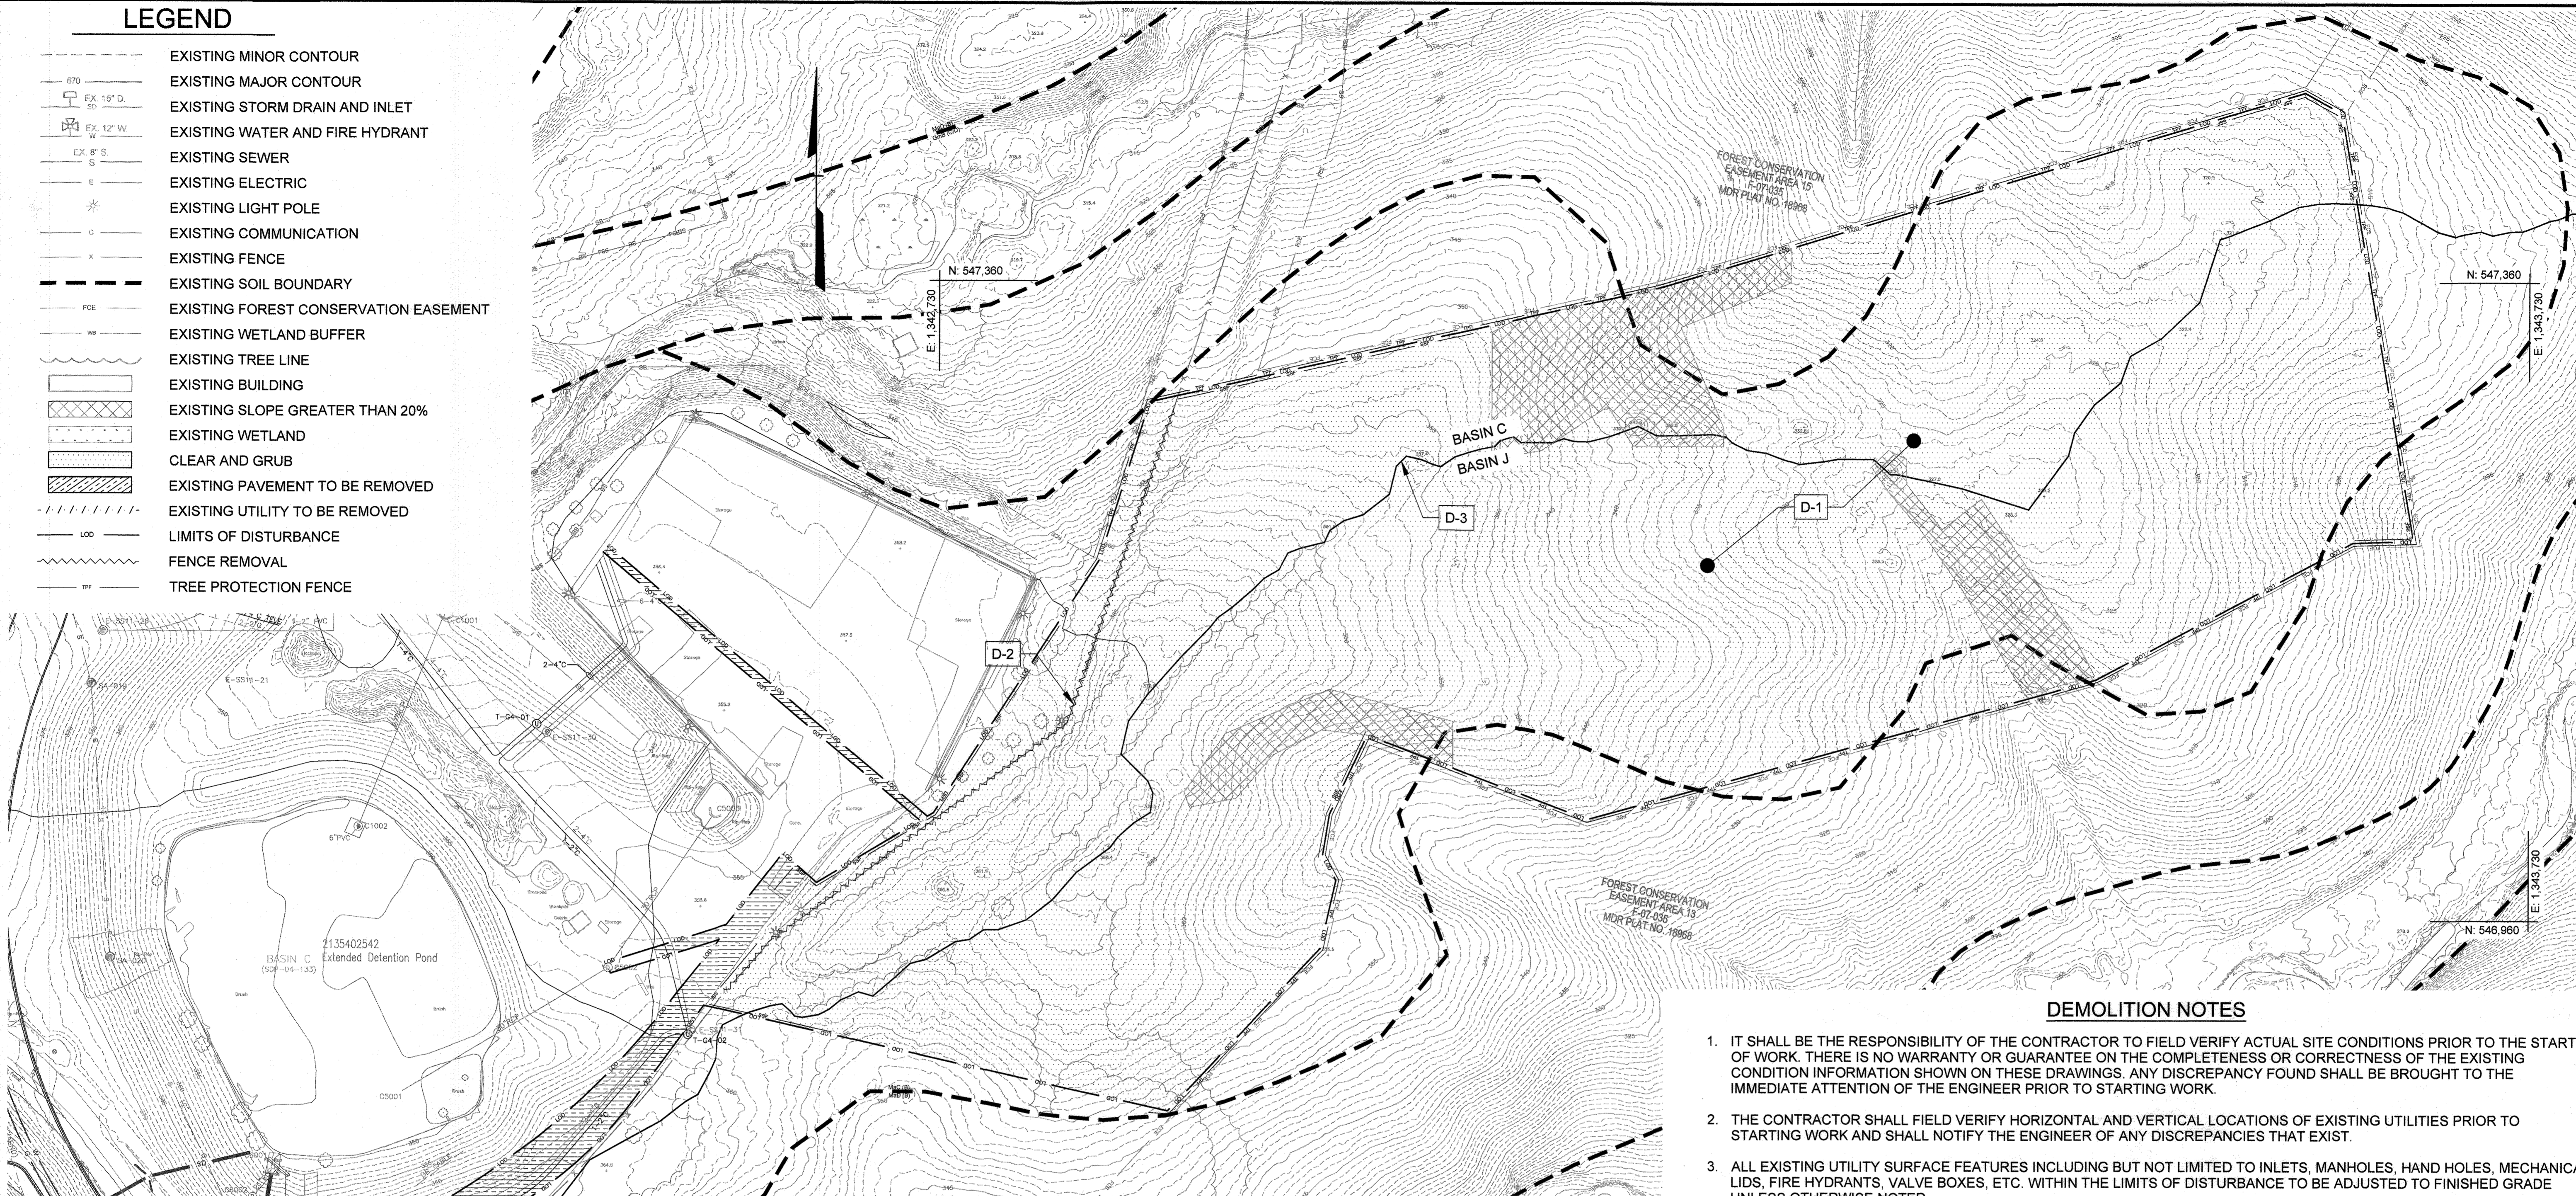

GENERAL NOTES

1. THE TOPOGRAPHIC INFORMATION SHOWN HEREON, WAS OBTAINED FROM AN AERIAL SURVEY FLOWN BY AXIS GEOSPATIAL ON APRIL 6, 2014 AND PROVIDED TO RK&K IN AUGUST OF 2017. THE UTILITY INFORMATION WAS PROVIDED ELECTRONICALLY TO RK&K BY JHU APL IN AUGUST OF 2017. TOPOGRAPHIC AND UTILITY INFORMATION MAY NOT REFLECT CURRENT CONDITIONS. IT IS THE CONTRACTOR'S RESPONSIBILITY TO FIELD VERIFY ACTUAL SITE CONDITIONS PRIOR TO THE START OF ANY WORK. THERE IS NO WARRANTY OR GUARANTEE ON THE COMPLETENESS OR CORRECTNESS OF THE EXISTING CONDITION INFORMATION. ANY DISCREPANCY FOUND SHALL BE BROUGHT TO THE IMMEDIATE ATTENTION OF THE ENGINEER PRIOR TO THE START OF ANY WORK.
2. BEARINGS, COORDINATES AND ELEVATIONS SHOWN ON THIS PLAN ARE SHOWN IN MARYLAND STATE PLANE. ALL VERTICAL CONTROLS ARE BASED ON NAVD 88.
3. FOR PROJECT GENERAL NOTES, SEE THE COVER SHEET.
4. THE SITE IS PRIMARILY WOODED AND ALL TREES WILL BE REMOVED FROM THE SITE. THE PROPOSED TREE LINE WILL BE THE LIMIT OF DISTURBANCE (LOD).

DEMO PLAN NOTES

KEY [D-1]


1. CLEAR ALL TREES AND GRUB. REMOVE ALL ROOT AND LEAF MATTER TO AN APPROXIMATE DEPTH OF 2.5' IN FILL AREAS.
2. REMOVE EXISTING FENCE.
3. EXISTING DRAINAGE BASIN BOUNDARY.
4. TEMPORARILY PLUG EX. 8" SEWER AT EX. MH SA-009 AND AND EX. MH SA-006. PROVIDE A PUMP AROUND SERVICE FROM MH SA-009 TO SA-006. REMOVE EXISTING SANITARY SEWER PIPE AND CONNECT PROPOSED SANITARY SEWER PIPE. COORDINATE WORK WITH THE INSTALLATION OF NEW PIPE TO LIMIT INTERRUPTION TIME. PUMP AND TRANSFER OF SERVICE WORK MUST BE COMPLETED BETWEEN FRIDAY AT 7PM AND MONDAY AT 4AM. COORDINATE WITH OWNER 14 DAYS PRIOR TO OUTAGE.
5. RETAIN AND PROTECT SELECTED TREES IN THIS AREA AS TAGGED BY THE OWNER ON SITE PRIOR TO TREE REMOVAL.
6. EX. SHED TO BE RELOCATED BY OWNER.

NOTE: SOME NOTES MAY NOT BE REPRESENTED ON THIS SHEET.

DEMOLITION NOTES

1. IT SHALL BE THE RESPONSIBILITY OF THE CONTRACTOR TO FIELD VERIFY ACTUAL SITE CONDITIONS PRIOR TO THE START OF WORK. THERE IS NO WARRANTY OR GUARANTEE ON THE COMPLETENESS OR CORRECTNESS OF THE EXISTING CONDITION INFORMATION SHOWN ON THESE DRAWINGS. ANY DISCREPANCY FOUND SHALL BE BROUGHT TO THE IMMEDIATE ATTENTION OF THE ENGINEER PRIOR TO STARTING WORK.
2. THE CONTRACTOR SHALL FIELD VERIFY HORIZONTAL AND VERTICAL LOCATIONS OF EXISTING UTILITIES PRIOR TO STARTING WORK AND SHALL NOTIFY THE ENGINEER OF ANY DISCREPANCIES THAT EXIST.
3. ALL EXISTING UTILITY SURFACE FEATURES INCLUDING BUT NOT LIMITED TO INLETS, MANHOLES, HAND HOLES, MECHANICAL LIDS, FIRE HYDRANTS, VALVE BOXES, ETC. WITHIN THE LIMITS OF DISTURBANCE TO BE ADJUSTED TO FINISHED GRADE UNLESS OTHERWISE NOTED.
4. CONTRACTOR TO REMOVE ALL EXISTING RIP-RAP, GRAVEL, DEBRIS, TREES, POSTS, AND STONE WITHIN THE LOD TO FACILITATE THE WORK TO BE COMPLETED.
5. THE CONTRACTOR SHALL MAINTAIN POSITIVE DRAINAGE AWAY FROM BUILDINGS AND STRUCTURES AT ALL TIMES.
6. THE CONTRACTOR SHALL CONTACT "MISS UTILITY" (1-800-257-7777) AT LEAST 48 HOURS PRIOR TO BEGINNING ANY DEMOLITION, UTILITY, OR EXCAVATION ACTIVITY.
7. ALL EXISTING FEATURES OUTSIDE OF THE LIMITS OF DISTURBANCE ARE TO REMAIN, UNLESS OTHERWISE NOTED.
8. UTILITIES MARKED FOR DEMOLITION WILL BE REMOVED.
9. COORDINATE REMOVAL OF EXISTING UTILITIES WITH INSTALLATION OF NEW UTILITIES TO MINIMIZE OUTAGE DURATION. ANY OUTAGE MUST BE COORDINATED IN ADVANCE WITH APPROPRIATE FACILITIES MANAGEMENT.
10. ALL CUTS OF EXISTING PAVEMENT SHALL BE NEAT AND IN A STRAIGHT LINE TO FACILITATE NEW PAVING. CONTRACTOR SHALL REMOVE TWO FEET OF THE SURFACE COURSE OF PAVEMENT (2" DEPTH) BEYOND ANY SAW CUTS TO OVERLAP PAVEMENT PATCHES.
11. CONTRACTOR TO TEST EXISTING SANITARY PIPES TO BE REMOVED FOR ASBESTOS. SHOULD PIPE TEST POSITIVE, CONTRACTOR IS REQUIRED TO NOTIFY THE OWNER & ENGINEER AND PROPERLY REMOVE & DISPOSE OF THE PIPING.
12. SEE UTILITY SITE PLAN FOR ADDITIONAL INFORMATION.
13. CONTRACTOR TO PROTECT EXISTING UTILITIES TO REMAIN WITHIN LOD DURING CONSTRUCTION.

No As-Built information in this sheet 2/14/23

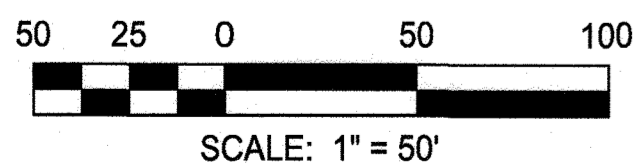


APPROVED: DEPARTMENT OF PLANNING AND ZONING

Chief, Development Engineering Division
 T. Murch
 Chief, Division of Land Development
 Director

9-21-18
 Date
 9-25-18
 Date
 9-26-18
 Date

RK&K
 RUMMEL, KLEPPER & RAHL, LLP
 ENGINEERS/CONSTRUCTION MANAGERS/PLANNERS/DESIGNERS
 RESPONSIVE PEOPLE • CREATIVE SOLUTIONS
 700 East Pratt Street, Suite 500
 Baltimore, MD 21202
 Ph: 410.728.2200
 www.rkk.com

PROFESSIONAL CERTIFICATION: I HEREBY CERTIFY THAT THESE DOCUMENTS WERE PREPARED OR APPROVED BY ME, AND THAT I AM A DULY LICENSED PROFESSIONAL ENGINEER UNDER THE LAWS OF THE STATE OF MARYLAND, LICENSE NO. 23072, EXPIRATION DATE: MARCH 6, 2019.

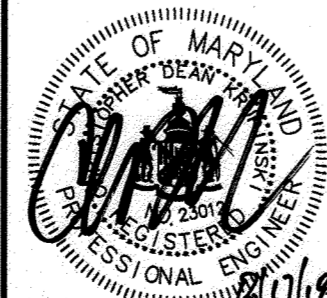

| | | | |
|-------------|---------|----------|------|
| DESIGN BY: | CWMM | | |
| DRAWN BY: | CWMM | | |
| CHECKED BY: | CDK | | |
| DATE: | 8/17/18 | | |
| BY | NO. | REVISION | DATE |

SDP SUBMISSION

OWNER/DEVELOPER
 JOHNS HOPKINS
 APPLIED PHYSICS LABORATORY
 11100 JOHNS HOPKINS ROAD
 LAUREL, MARYLAND 20723


EX. CONDITION & DEMO PLAN - OTA 1
 (PHASE 1) AS-BUILT
 JOHNS HOPKINS UNIVERSITY - APPLIED PHYSICS LABORATORY
OUTDOOR TESTING AREAS

11100 JOHNS HOPKINS ROAD
 PARCEL: 123 GRID: 16 ZONED: PEC
 ELECTION DISTRICT 5 - HOWARD COUNTY, MARYLAND
 SHEET 04 OF 73

C-101

RK&K PROJECT NUMBER
 17152

SCALE:
 As Shown

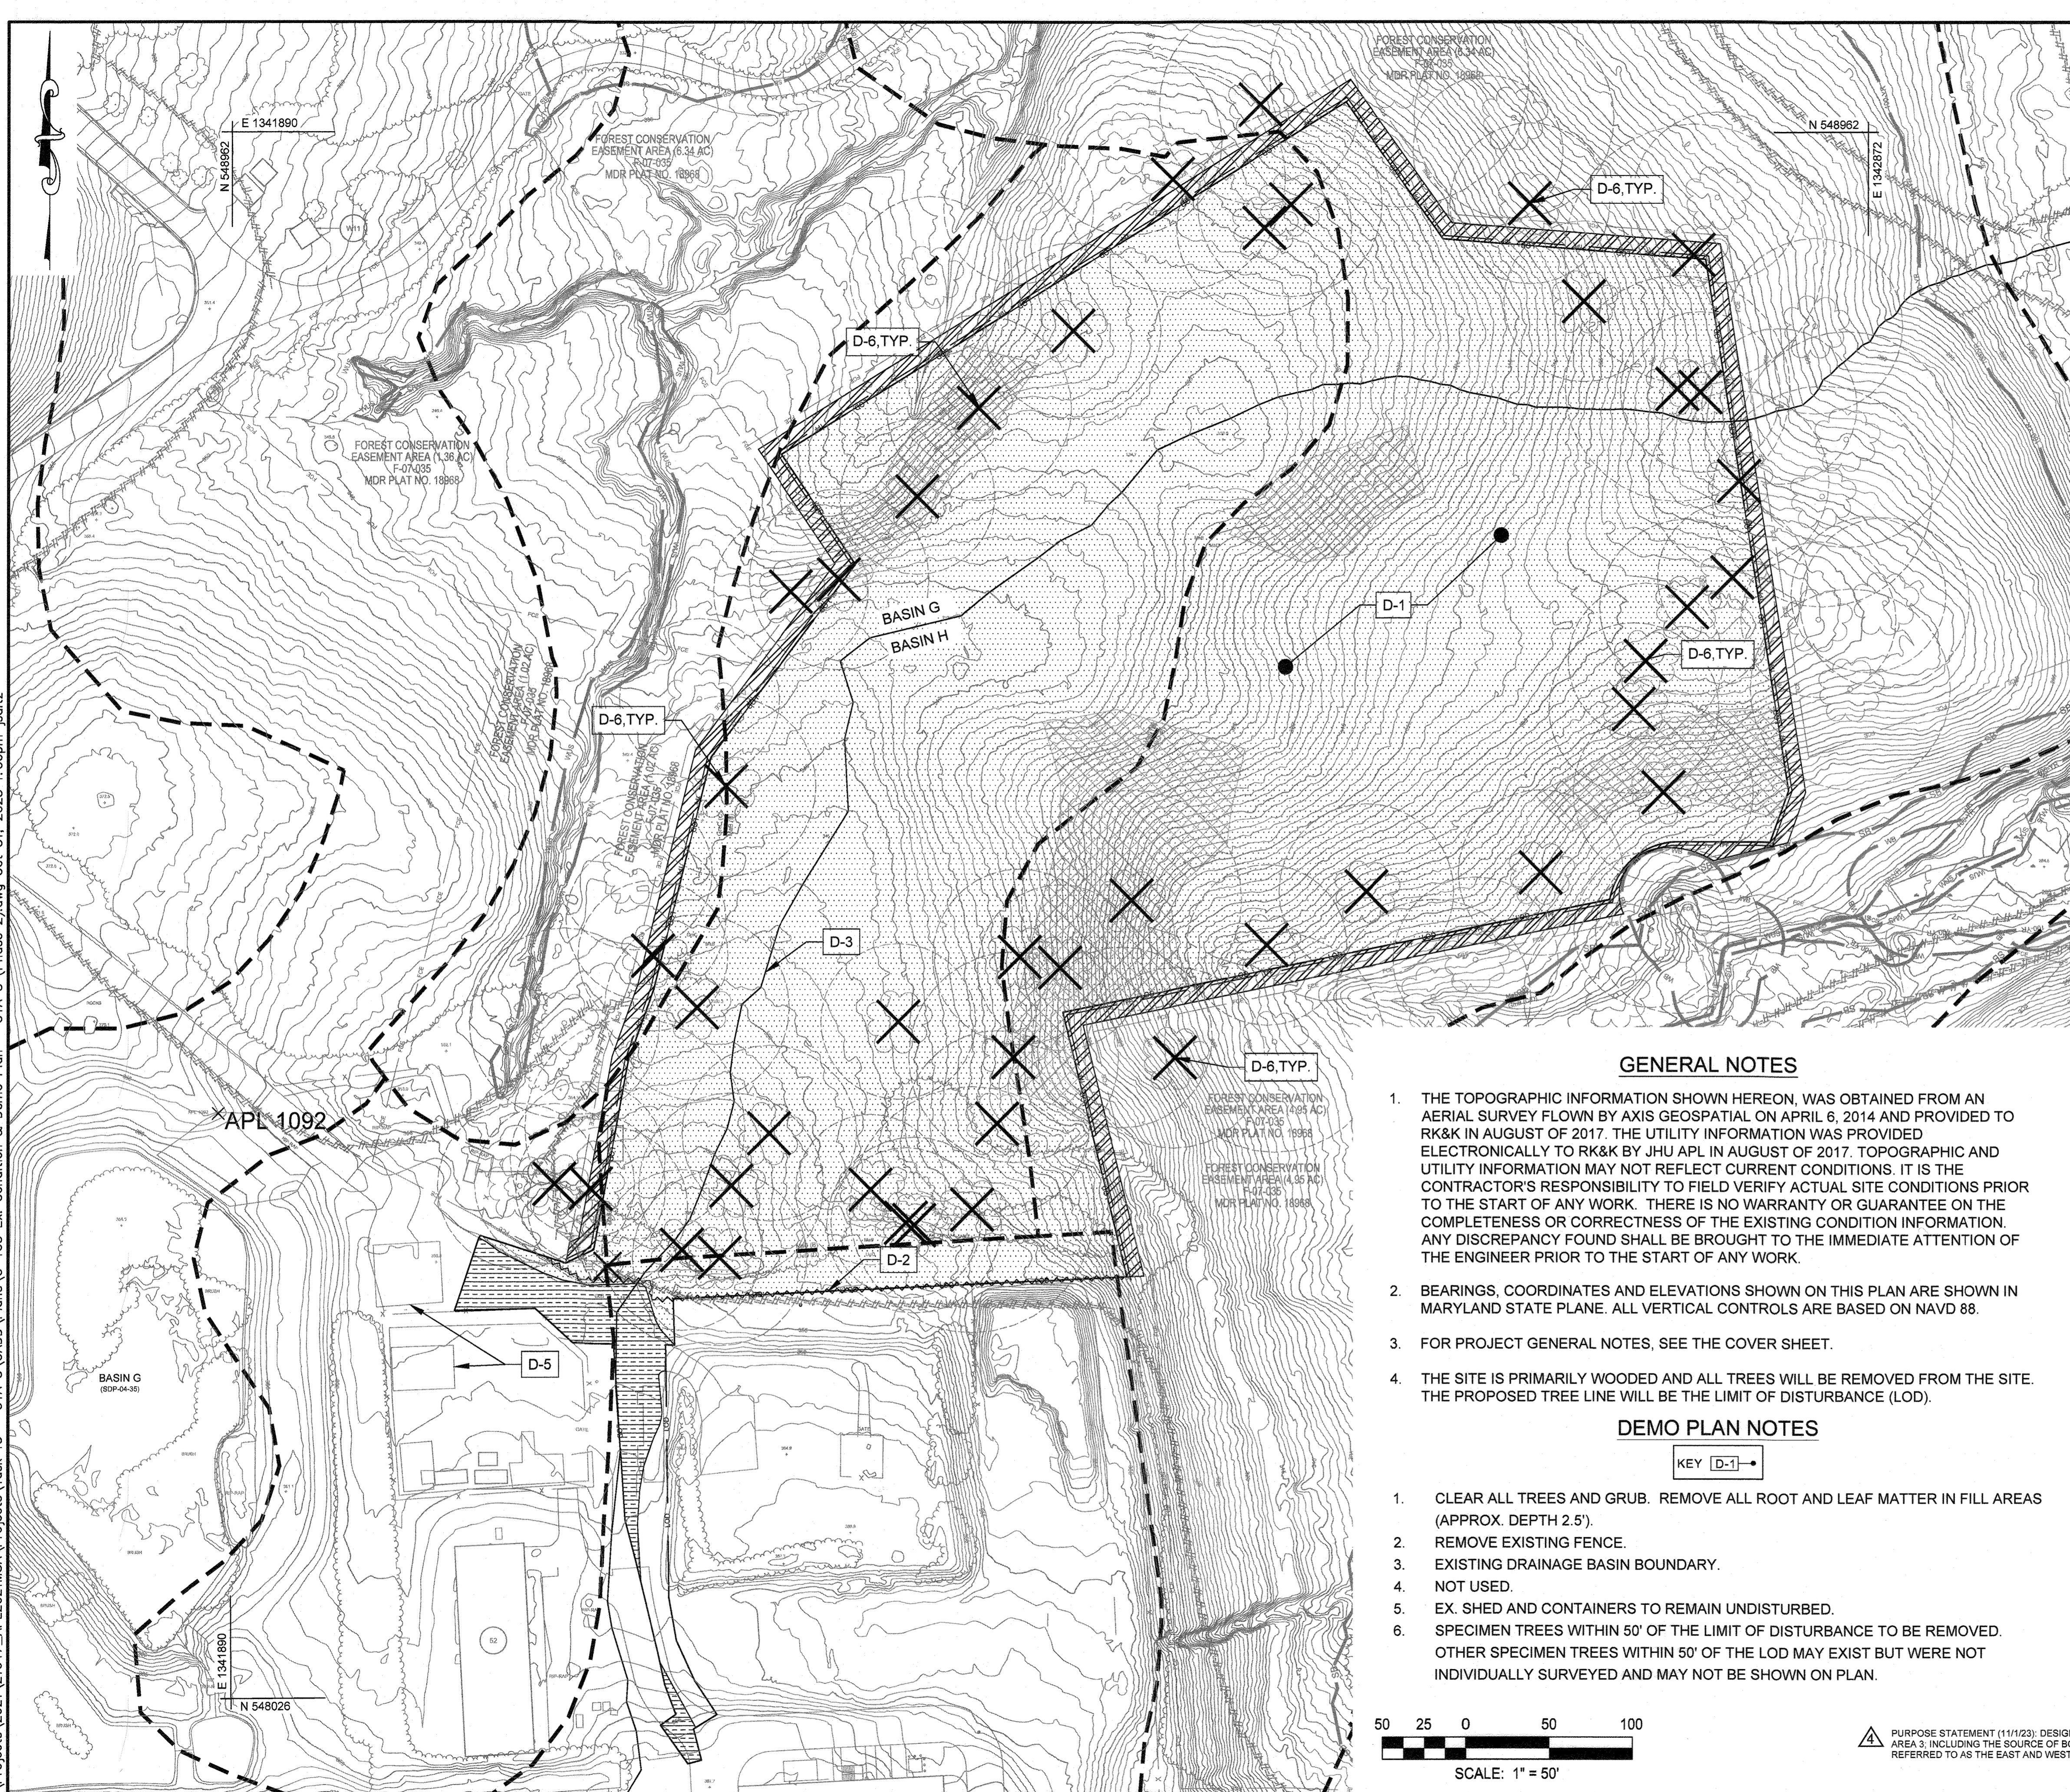

LEGEND

- EXISTING MINOR CONTOUR
- EXISTING MAJOR CONTOUR
- EXISTING STORM DRAIN AND INLET
- EXISTING WATER AND FIRE HYDRANT
- EXISTING SEWER
- EXISTING ELECTRIC
- EXISTING LIGHT POLE
- EXISTING COMMUNICATION
- EXISTING FENCE
- EXISTING SOIL BOUNDARY
- EXISTING FOREST CONSERVATION EASEMENT
- EXISTING WETLAND BUFFER
- EXISTING TREE LINE
- EXISTING BUILDING
- EXISTING SLOPE GREATER THAN 20%
- PROP. CLEAR AND GRUB
- EXISTING PAVEMENT TO BE REMOVED
- EXISTING UTILITY TO BE REMOVED
- LIMITS OF DISTURBANCE
- PROP. FENCE REMOVAL
- PROP. TREE PROTECTION FENCE
- STREAM BUFFER
- TREE WITH CRITICAL ROOT ZONE
- SPECIMEN TREES TO BE REMOVED (SEE DEMO PLAN NOTE 6)
- CONTRACTOR TO CLEAR/REMOVE VEGETATION WITHIN 10' ZONE OUTSIDE THE LOD. ACTIVITIES SHOULD NOT INCLUDE GRUBBING/REMOVAL OF TREE ROOTS (i.e. SOIL DISTURBANCE)

GENERAL DEMOLITION NOTES


1. IT SHALL BE THE RESPONSIBILITY OF THE CONTRACTOR TO FIELD VERIFY ACTUAL SITE CONDITIONS PRIOR TO THE START OF WORK. THERE IS NO WARRANTY OR GUARANTEE ON THE COMPLETENESS OR CORRECTNESS OF THE EXISTING CONDITION INFORMATION SHOWN ON THESE DRAWINGS. ANY DISCREPANCY FOUND SHALL BE BROUGHT TO THE IMMEDIATE ATTENTION OF THE ENGINEER PRIOR TO STARTING WORK.
2. THE CONTRACTOR SHALL FIELD VERIFY HORIZONTAL AND VERTICAL LOCATIONS OF EXISTING UTILITIES PRIOR TO STARTING WORK AND SHALL NOTIFY THE ENGINEER OF ANY DISCREPANCIES THAT EXIST.
3. ALL EXISTING UTILITY SURFACE FEATURES INCLUDING BUT NOT LIMITED TO INLETS, MANHOLES, HAND HOLES, MECHANICAL LIDS, FIRE HYDRANTS, VALVE BOXES, ETC. WITHIN THE LIMITS OF DISTURBANCE TO BE ADJUSTED TO FINISHED GRADE UNLESS OTHERWISE NOTED.
4. CONTRACTOR TO REMOVE ALL EXISTING RIP-RAP, GRAVEL, DEBRIS, TREES, BRUSH, FENCES, POSTS, AND GABION BASKETS/STONE WITHIN THE LOD TO FACILITATE THE WORK TO BE COMPLETED.
5. THE CONTRACTOR SHALL MAINTAIN POSITIVE DRAINAGE AWAY FROM BUILDINGS AND STRUCTURES AT ALL TIMES.
6. THE CONTRACTOR SHALL CONTACT "MISS UTILITY" (1-800-257-7777) AT LEAST 48 HOURS PRIOR TO BEGINNING ANY DEMOLITION, UTILITY, OR EXCAVATION ACTIVITY.
7. ALL EXISTING FEATURES OUTSIDE OF THE LIMITS OF DISTURBANCE ARE TO REMAIN, UNLESS OTHERWISE NOTED.
8. UTILITIES MARKED FOR DEMOLITION WILL BE REMOVED.
9. COORDINATE REMOVAL OF EXISTING UTILITIES WITH INSTALLATION OF NEW UTILITIES TO MINIMIZE OUTAGE DURATION. ANY OUTAGE MUST BE COORDINATED IN ADVANCE WITH APPROPRIATE FACILITIES MANAGEMENT.
10. ALL CUTS OF EXISTING PAVEMENT SHALL BE NEAT AND IN A STRAIGHT LINE TO FACILITATE NEW PAVING. CONTRACTOR SHALL REMOVE TWO FEET OF THE SURFACE COURSE OF PAVEMENT (2" DEPTH) BEYOND ANY SAW CUTS TO OVERLAP PAVEMENT PATCHES.
11. SEE UTILITY SITE PLAN FOR ADDITIONAL INFORMATION.
12. CONTRACTOR TO PROTECT EXISTING UTILITIES TO REMAIN WITHIN LOD DURING CONSTRUCTION.

GENERAL NOTES

1. THE TOPOGRAPHIC INFORMATION SHOWN HEREON, WAS OBTAINED FROM AN AERIAL SURVEY FLOWN BY AXIS GEOSPATIAL ON APRIL 6, 2014 AND PROVIDED TO RK&K IN AUGUST OF 2017. THE UTILITY INFORMATION WAS PROVIDED ELECTRONICALLY TO RK&K BY JHU APL IN AUGUST OF 2017. TOPOGRAPHIC AND UTILITY INFORMATION MAY NOT REFLECT CURRENT CONDITIONS. IT IS THE CONTRACTOR'S RESPONSIBILITY TO FIELD VERIFY ACTUAL SITE CONDITIONS PRIOR TO THE START OF ANY WORK. THERE IS NO WARRANTY OR GUARANTEE ON THE COMPLETENESS OR CORRECTNESS OF THE EXISTING CONDITION INFORMATION. ANY DISCREPANCY FOUND SHALL BE BROUGHT TO THE IMMEDIATE ATTENTION OF THE ENGINEER PRIOR TO THE START OF ANY WORK.
2. BEARINGS, COORDINATES AND ELEVATIONS SHOWN ON THIS PLAN ARE SHOWN IN MARYLAND STATE PLANE. ALL VERTICAL CONTROLS ARE BASED ON NAVD 88.
3. FOR PROJECT GENERAL NOTES, SEE THE COVER SHEET.
4. THE SITE IS PRIMARILY WOODED AND ALL TREES WILL BE REMOVED FROM THE SITE. THE PROPOSED TREE LINE WILL BE THE LIMIT OF DISTURBANCE (LOD).

DEMO PLAN NOTES

1. CLEAR ALL TREES AND GRUB. REMOVE ALL ROOT AND LEAF MATTER IN FILL AREAS (APPROX. DEPTH 2.5').
2. REMOVE EXISTING FENCE.
3. EXISTING DRAINAGE BASIN BOUNDARY.
4. NOT USED.
5. EX. SHED AND CONTAINERS TO REMAIN UNDISTURBED.
6. SPECIMEN TREES WITHIN 50' OF THE LIMIT OF DISTURBANCE TO BE REMOVED. OTHER SPECIMEN TREES WITHIN 50' OF THE LOD MAY EXIST BUT WERE NOT INDIVIDUALLY SURVEYED AND MAY NOT BE SHOWN ON PLAN.

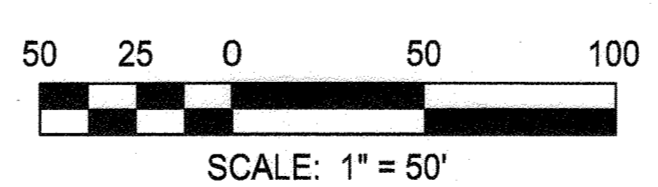


PURPOSE STATEMENT (11/1/23): DESIGN OF OUTDOOR TESTING AREA 3, INCLUDING THE SOURCE OF BORROW MATERIAL REFERRED TO AS THE EAST AND WEST BORROW AREAS.

\\ad.rk.com\fs\Cloud\Projects\2021\21047_APL2021MSA\Projects\Task 13 - OTA 3\CADD\Plans\C-103 Ex. Condition & Demo Plan - OTA 3 (Phase 2).dwg Oct 31, 2023 1:06pm jgaliz

APPROVED: DEPARTMENT OF PLANNING AND ZONING
 Chief, Development Engineering Division
 Date: 12-5-23
 Chief, Division of Land Development
 Date: 12/21/24
 Director

RK&K
 RUMMEL, KLEPPER & KAHL, LLP
 ENGINEERS, ARCHITECTS, PLANNERS, ENVIRONMENTAL SCIENTISTS
 700 East Pratt Street, Suite 500
 Baltimore, MD 21202
 Ph: 410.728.2800 Contact: Matt Thomason
 www.rk.com

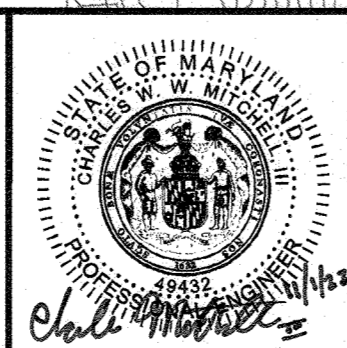

| | | | | | |
|-------------|-----------|------|-----|---|---------|
| DESIGN BY: | SHK | RXAK | 4 | New Sheet - OTA-3 and Borrow Area Modifications | 11/1/23 |
| DRAWN BY: | JMS/DTP | | | | |
| CHECKED BY: | CWWW | | | | |
| DATE: | 11/1/2023 | BY | NO. | REVISION | DATE |

OWNER/DEVELOPER
JOHNS HOPKINS APPLIED PHYSICS LABORATORY
 11100 JOHNS HOPKINS ROAD
 LAUREL, MARYLAND 20723

EX. CONDITION & DEMO PLAN - OTA 3
 (PHASE 2)
 JOHNS HOPKINS UNIVERSITY - APPLIED PHYSICS LABORATORY
OUTDOOR TESTING AREAS
 11100 JOHNS HOPKINS ROAD
 TAX MAP: 41 PARCEL: 123 GRID: 18 ZONED: PEG
 ELECTION DISTRICT 5 - HOWARD COUNTY, MARYLAND
 SHEET 05 OF 73

C-103
 RK&K PROJECT NUMBER 21047.013
 SCALE: As Shown


LEGEND

- EXISTING MINOR CONTOUR INTERVAL
- EXISTING MAJOR CONTOUR INTERVAL
- EXISTING SOIL BOUNDARY
- EX. FOREST CONSERVATION EASEMENT
- L00 LIMIT OF DISTURBANCE / PROPOSED TREELINE
- TREE PROTECTION FENCE
- 325 PROPOSED MAJOR CONTOUR
- PROPOSED MINOR CONTOUR
- PROPOSED 4' CHAIN LINK FENCE
- GUARDRAIL
- PROP. SECURITY FENCE
- PROPOSED STORM DRAIN
- PROPOSED ELECTRIC
- PROPOSED COMMUNICATION
- PROPOSED WATER
- PROPOSED ASPHALT DRIVEWAY PER HC R-2.01 ON SHEET C-215
- PROPOSED GRASS/TOPSOIL RESTORATION
- PROPOSED CENTERLINE OF SWALE
- PROPOSED CONCRETE PAD, SEE SHEET A-101
- PROPOSED SPOT ELEVATION

LANDCOVER SUMMARY
 CUT... 67CY
 FILL... 5CY

PURPOSE STATEMENT (4/17/22):
 ADDITION OF TWO 6'X4' CONCRETE PADS

\\balew-05\2017\2017\17152_HJHAPL\CADD\Plans\C-201-203_Site_Plans.dwg Jul 03, 2018 2:35pm cmitcheil

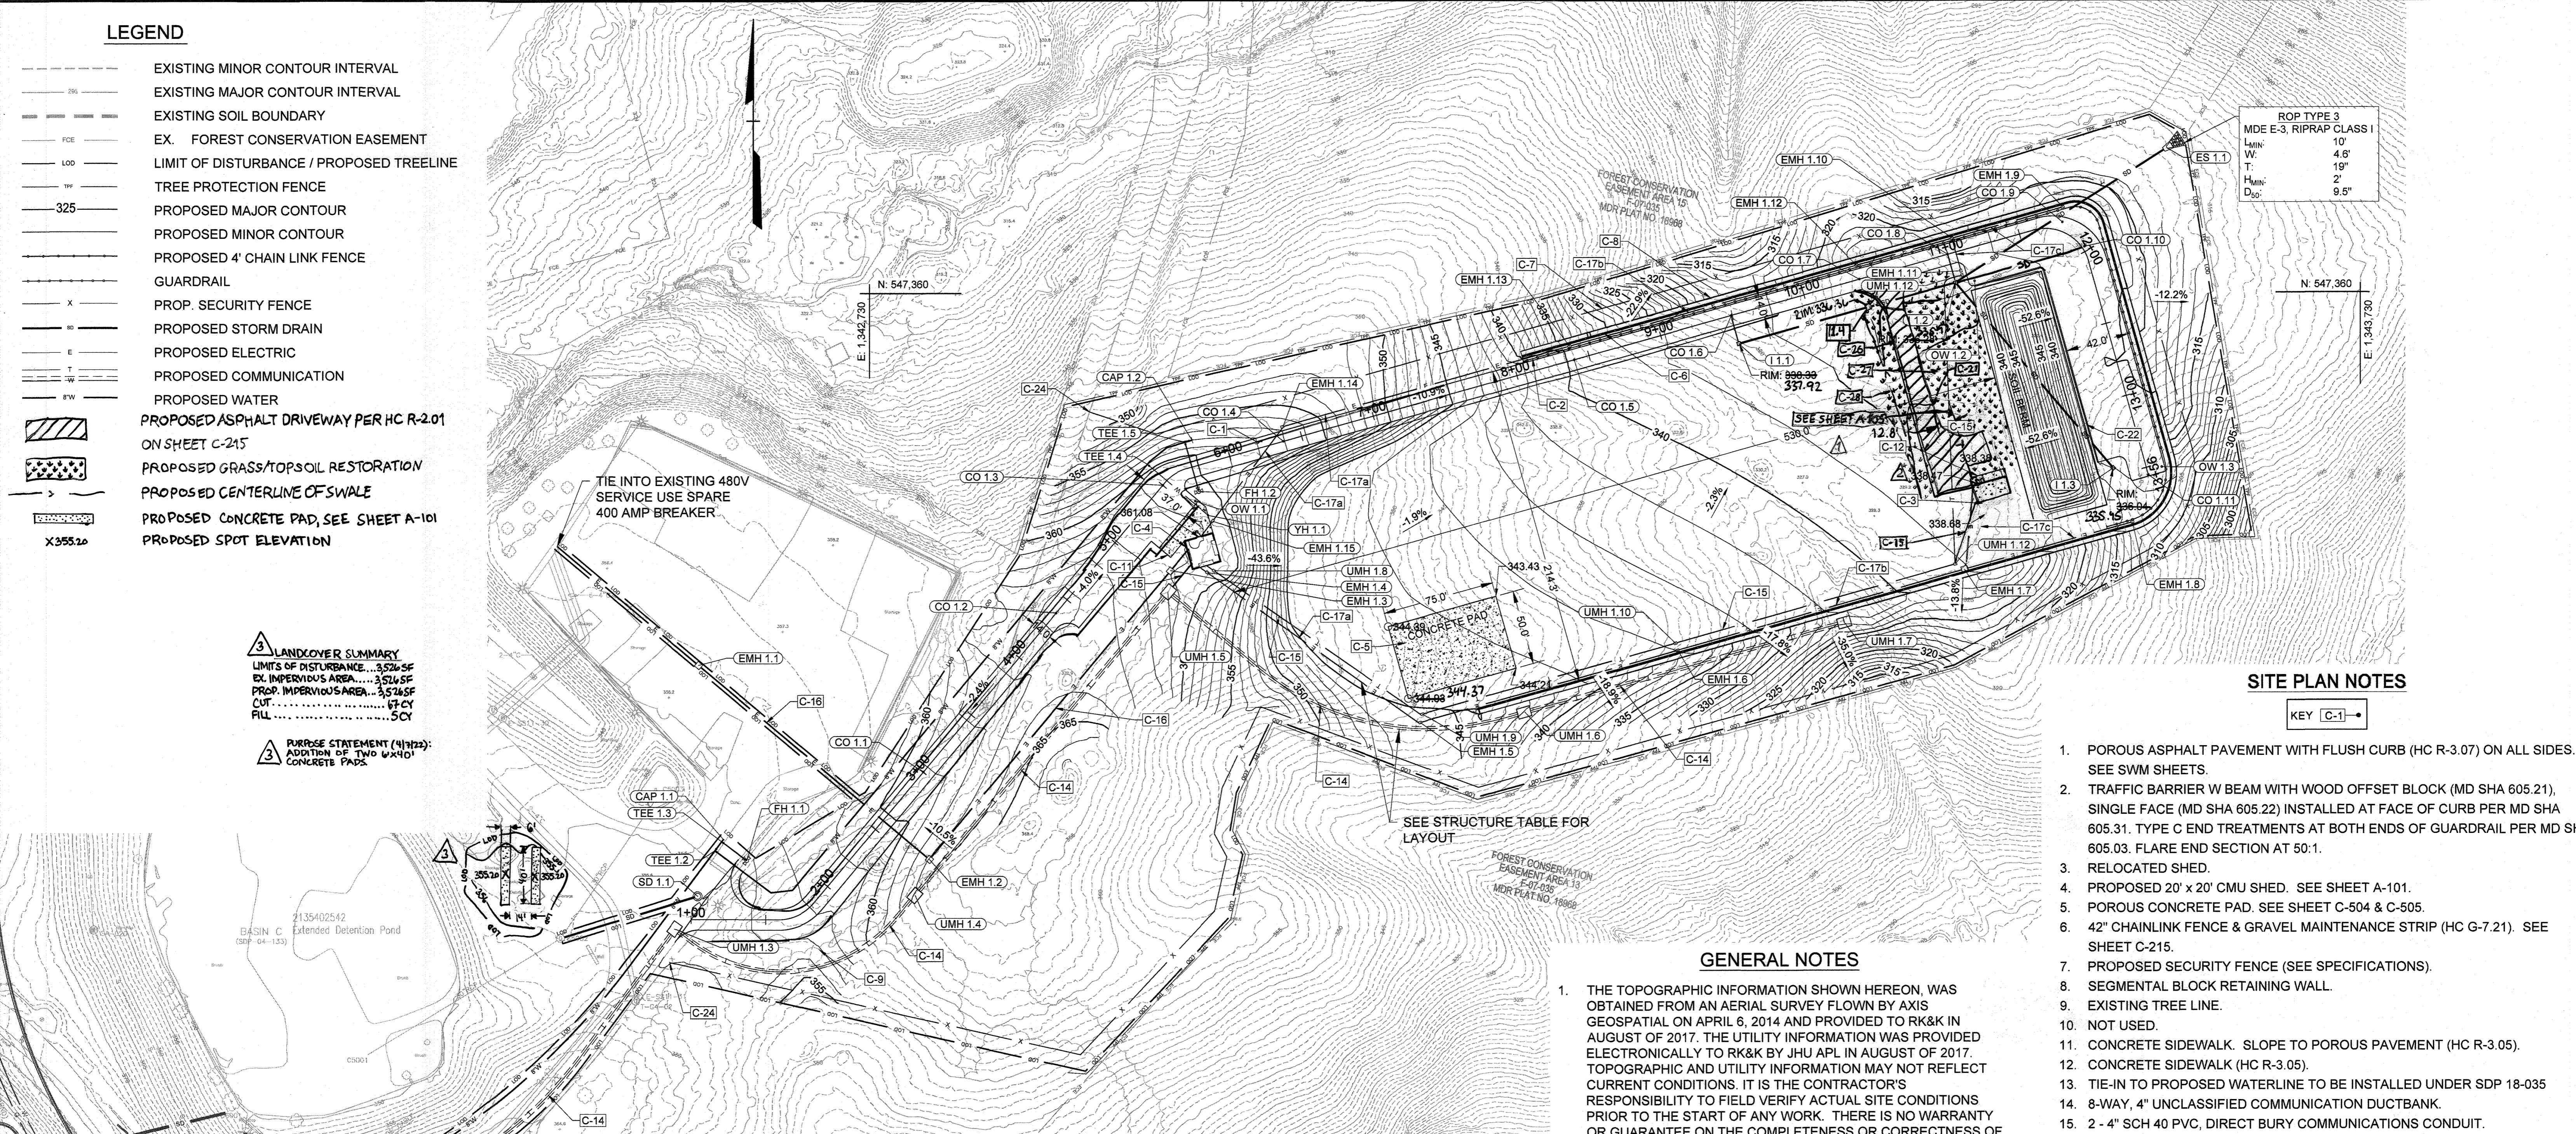

ROP TYPE 3
 MDE E-3, RIPRAP CLASS 1

| | |
|--------------------|------|
| L _{MIN} : | 10' |
| W: | 4.6' |
| T: | 19' |
| H _{MIN} : | 2' |
| D ₅₀ : | 9.5" |

SITE PLAN NOTES

KEY [C-1] →

1. POROUS ASPHALT PAVEMENT WITH FLUSH CURB (HC R-3.07) ON ALL SIDES. SEE SWM SHEETS.
2. TRAFFIC BARRIER W BEAM WITH WOOD OFFSET BLOCK (MD SHA 605.21), SINGLE FACE (MD SHA 605.22) INSTALLED AT FACE OF CURB PER MD SHA 605.31. TYPE C END TREATMENTS AT BOTH ENDS OF GUARDRAIL PER MD SHA 605.03. FLARE END SECTION AT 50:1.
3. RELOCATED SHED.
4. PROPOSED 20' x 20' CMU SHED. SEE SHEET A-101.
5. POROUS CONCRETE PAD. SEE SHEET C-504 & C-505.
6. 42" CHAINLINK FENCE & GRAVEL MAINTENANCE STRIP (HC G-7.21). SEE SHEET C-215.
7. PROPOSED SECURITY FENCE (SEE SPECIFICATIONS).
8. SEGMENTAL BLOCK RETAINING WALL.
9. EXISTING TREE LINE.
10. NOT USED.
11. CONCRETE SIDEWALK. SLOPE TO POROUS PAVEMENT (HC R-3.05).
12. CONCRETE SIDEWALK (HC R-3.05).
13. TIE-IN TO PROPOSED WATERLINE TO BE INSTALLED UNDER SDP 18-035
14. 8-WAY, 4" UNCLASSIFIED COMMUNICATION DUCTBANK.
15. 2 - 4" SCH 40 PVC, DIRECT BURY COMMUNICATIONS CONDUIT.
16. 2 - 4" SCH 40 PVC, DIRECT BURY ELECTRICAL CONDUIT.
17. NOT USED.
- 17a. 4-1.5" SCH 40 PVC, DIRECT BURY ELECTRICAL CONDUIT.
- 17b. 3-1.5" SCH 40 PVC, DIRECT BURY ELECTRICAL CONDUIT.
- 17c. 2-1.5" SCH 40 PVC, DIRECT BURY ELECTRICAL CONDUIT.
18. CONCRETE ANCHOR PAD.
19. CONCRETE RAIL PAD WITH RAILROAD TRACKS.
20. CAST IN PLACE CONCRETE RETAINING WALL.
21. 7" COMBINATION CURB & GUTTER (HC R-3.01).
22. 7" CONCRETE BARRIER CURB (HC R-3.03). (SUBSTITUTE BARRIER CURB FOR FLUSH CURB).
23. TIE-IN TO PROPOSED UMH-2 WALL TERMINATOR (8-4") TO BE INSTALLED UNDER SDP 18-035.
24. CONNECT NEW FENCE TO EXISTING FENCE.

GENERAL NOTES

1. THE TOPOGRAPHIC INFORMATION SHOWN HEREON, WAS OBTAINED FROM AN AERIAL SURVEY FLOWN BY AXIS GEOSPATIAL ON APRIL 6, 2014 AND PROVIDED TO RK&K IN AUGUST OF 2017. THE UTILITY INFORMATION WAS PROVIDED ELECTRONICALLY TO RK&K BY JHU APL IN AUGUST OF 2017. TOPOGRAPHIC AND UTILITY INFORMATION MAY NOT REFLECT CURRENT CONDITIONS. IT IS THE CONTRACTOR'S RESPONSIBILITY TO FIELD VERIFY ACTUAL SITE CONDITIONS PRIOR TO THE START OF ANY WORK. THERE IS NO WARRANTY OR GUARANTEE ON THE COMPLETENESS OR CORRECTNESS OF THE EXISTING CONDITION INFORMATION. ANY DISCREPANCY FOUND SHALL BE BROUGHT TO THE IMMEDIATE ATTENTION OF THE ENGINEER PRIOR TO THE START OF ANY WORK.
2. BEARINGS, COORDINATES AND ELEVATIONS SHOWN ON THIS PLAN ARE SHOWN IN MARYLAND STATE PLANE. ALL VERTICAL CONTROLS ARE BASED ON NAVD 88.
3. FOR PROJECT GENERAL NOTES, SEE THE COVER SHEET.
4. THE SITE IS PRIMARILY WOODED AND ALL TREES WILL BE REMOVED FROM THE SITE. THE PROPOSED TREE LINE WILL BE THE LIMIT OF DISTURBANCE (LOD).

SITE AND UTILITY PLAN NOTES

1. UNLESS OTHERWISE NOTED, DIMENSIONS FROM CURB ARE MEASURED TO FACE OF CURB.
2. THE CONTRACTOR SHALL PROVIDE A TWO-FOOT AREA AT 1/2-INCH PER FOOT SLOPE BEHIND ALL PROPOSED CURB, UNLESS OTHERWISE INDICATED.
3. FINISHED GRADES SHALL FALL AWAY FROM EXISTING AND PROPOSED BUILDINGS AT A MINIMUM OF 1/4-INCH PER FOOT FOR VEGETATED AREAS AND A MINIMUM OF 1/8-INCH PER FOOT FOR PAVED AREAS UNLESS OTHERWISE INDICATED.
4. IT SHALL BE THE RESPONSIBILITY OF THE CONTRACTOR TO FIELD VERIFY ACTUAL SITE CONDITIONS PRIOR TO THE START OF WORK. THERE IS NO WARRANTY OR GUARANTEE ON THE COMPLETENESS OR CORRECTNESS OF THE EXISTING CONDITION INFORMATION SHOWN ON THESE DRAWINGS. ANY DISCREPANCY FOUND SHALL BE BROUGHT TO THE IMMEDIATE ATTENTION OF THE ENGINEER PRIOR TO STARTING WORK.
5. THE CONTRACTOR SHALL FIELD VERIFY HORIZONTAL AND VERTICAL LOCATIONS OF EXISTING UTILITIES PRIOR TO STARTING WORK AND SHALL NOTIFY THE ENGINEER OF ANY DISCREPANCIES THAT EXIST.
6. ALL EXISTING UTILITY SURFACE FEATURES INCLUDING BUT NOT LIMITED TO INLETS, MANHOLES, HAND HOLES, MECHANICAL LIDS, FIRE HYDRANTS, VALVE BOXES, ETC. WITHIN THE LIMITS OF DISTURBANCE TO BE ADJUSTED TO FINISHED GRADE UNLESS OTHERWISE NOTED.
7. THE CONTRACTOR SHALL MAINTAIN POSITIVE DRAINAGE AWAY FROM BUILDINGS AND STRUCTURES AT ALL TIMES.
8. THE CONTRACTOR SHALL CONTACT "MISS UTILITY" (1-800-257-7777) AT LEAST 48 HOURS PRIOR TO BEGINNING ANY DEMOLITION, UTILITY, OR EXCAVATION ACTIVITY.
9. SEE SHEET C-501 THROUGH C-505 FOR UNDERDRAIN LOCATION, DIAMETER & DETAILS.

Purpose Statement (7/30/21): This red line submission adds a proposed asphalt driveway with a concrete curb to the existing shed at OTA 1. A proposed storm drain inlet and swale are included.


Purpose Statement (9/10/19): This red line submission adjusts the configuration of the proposed shed at OTA 1. Changes to utilities are also required and identified under this revision.



PROFESSIONAL CERTIFICATION, I HEREBY CERTIFY THAT THESE DOCUMENTS WERE PREPARED OR APPROVED BY ME AND THAT I AM A DULY LICENSED PROFESSIONAL ENGINEER UNDER THE LAWS OF THE STATE OF MARYLAND, LICENSE NO. 44932, EXPIRATION DATE: MARCH 6, 2019.



PROFESSIONAL CERTIFICATION, I HEREBY CERTIFY THAT THESE DOCUMENTS WERE PREPARED OR APPROVED BY ME, AND THAT I AM A DULY LICENSED PROFESSIONAL ENGINEER UNDER THE LAWS OF THE STATE OF MARYLAND, LICENSE NO. 44932, EXPIRATION DATE: 5/31/24.

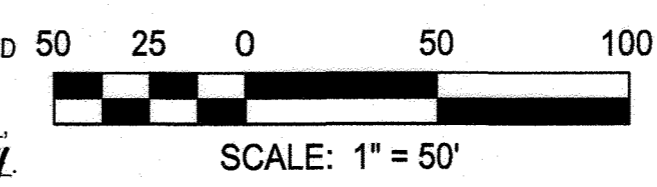

- 25. NOT USED
- 26. PROPOSED ASPHALT DRIVEWAY PER HC R-2.01 ON SHEET C-215
- 27. GRASS/TOPSOIL RESTORATION
- 28. SWALE CENTERLINE

- NOTES:
1. SOME NOTES MAY NOT BE REPRESENTED ON THIS SHEET.
 2. DETAIL REFERENCES ARE STANDARD HOWARD COUNTY ORDINANCES.

AS-BUILT CERTIFICATION
 I hereby certify, by my seal, that to the best of my knowledge and belief the facilities shown on this plan were constructed as shown on this "AS-BUILT" plan meet the Approved Plans and Specifications.
 Charles W. J. Mitchell, III, P.E. # 49432, 2/11/23

APPROVED: DEPARTMENT OF PLANNING AND ZONING


 Chief, Development Engineering Division
 Date: 9-21-18

Chief, Division of Land Development
 Date: 9-25-18

Director
 Date: 9-26-18

RK&K
 RUMMEL, KLEPPER & KAHL, LLP
 ENGINEERING, ARCHITECTURE, PLANNING & ENVIRONMENTAL CONSULTANTS
 RESPONSIVE PEOPLE • CREATIVE SOLUTIONS
 700 East Pratt Street, Suite 500
 Baltimore, MD 21202
 PH: 410.728.2800 CONTACT: John DePugliese
 WWW.RK&K.COM

PROFESSIONAL CERTIFICATION, I HEREBY CERTIFY THAT THESE DOCUMENTS WERE PREPARED OR APPROVED BY ME AND THAT I AM A DULY LICENSED PROFESSIONAL ENGINEER UNDER THE LAWS OF THE STATE OF MARYLAND, LICENSE NO. 23912, EXPIRATION DATE: MARCH 6, 2019.

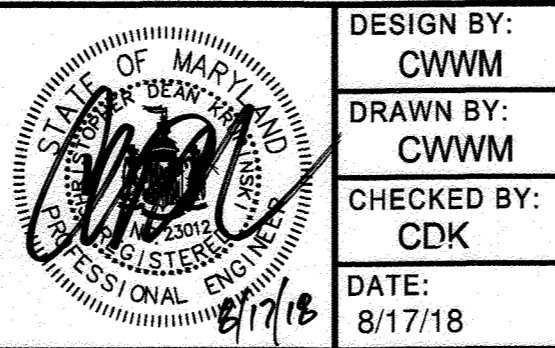


| | | | |
|-------------|---------|--------------------------------------|---------|
| DESIGN BY: | RK&K | SHED LOCATION REVISION | 9/10/19 |
| DRAWN BY: | RK&K | ASPHALT DRIVEWAY ADDITION | 7/30/21 |
| CHECKED BY: | CDK | SDP SUBMISSION | |
| DATE: | 8/17/18 | ADDITION OF TWO 6'X4' CONCRETE PADS. | 4/17/22 |
| BY | NO. | REVISION | DATE |

OWNER/DEVELOPER
JOHNS HOPKINS APPLIED PHYSICS LABORATORY
 11100 JOHNS HOPKINS ROAD
 LAUREL, MARYLAND 20723

SITE, GRADING AND UTILITY PLAN - OTA 1 (PHASE 1) AS-BUILT
 JOHNS HOPKINS UNIVERSITY - APPLIED PHYSICS LABORATORY
OUTDOOR TESTING AREAS
 11100 JOHNS HOPKINS ROAD
 TAX MAP: 41 PARCEL 123 GRID: 16 ZONED: PEC
 ELECTION DISTRICT 5 - HOWARD COUNTY, MARYLAND
 SHEET 06 OF 73

RK&K PROJECT NUMBER
 17152

SCALE:
 As Shown

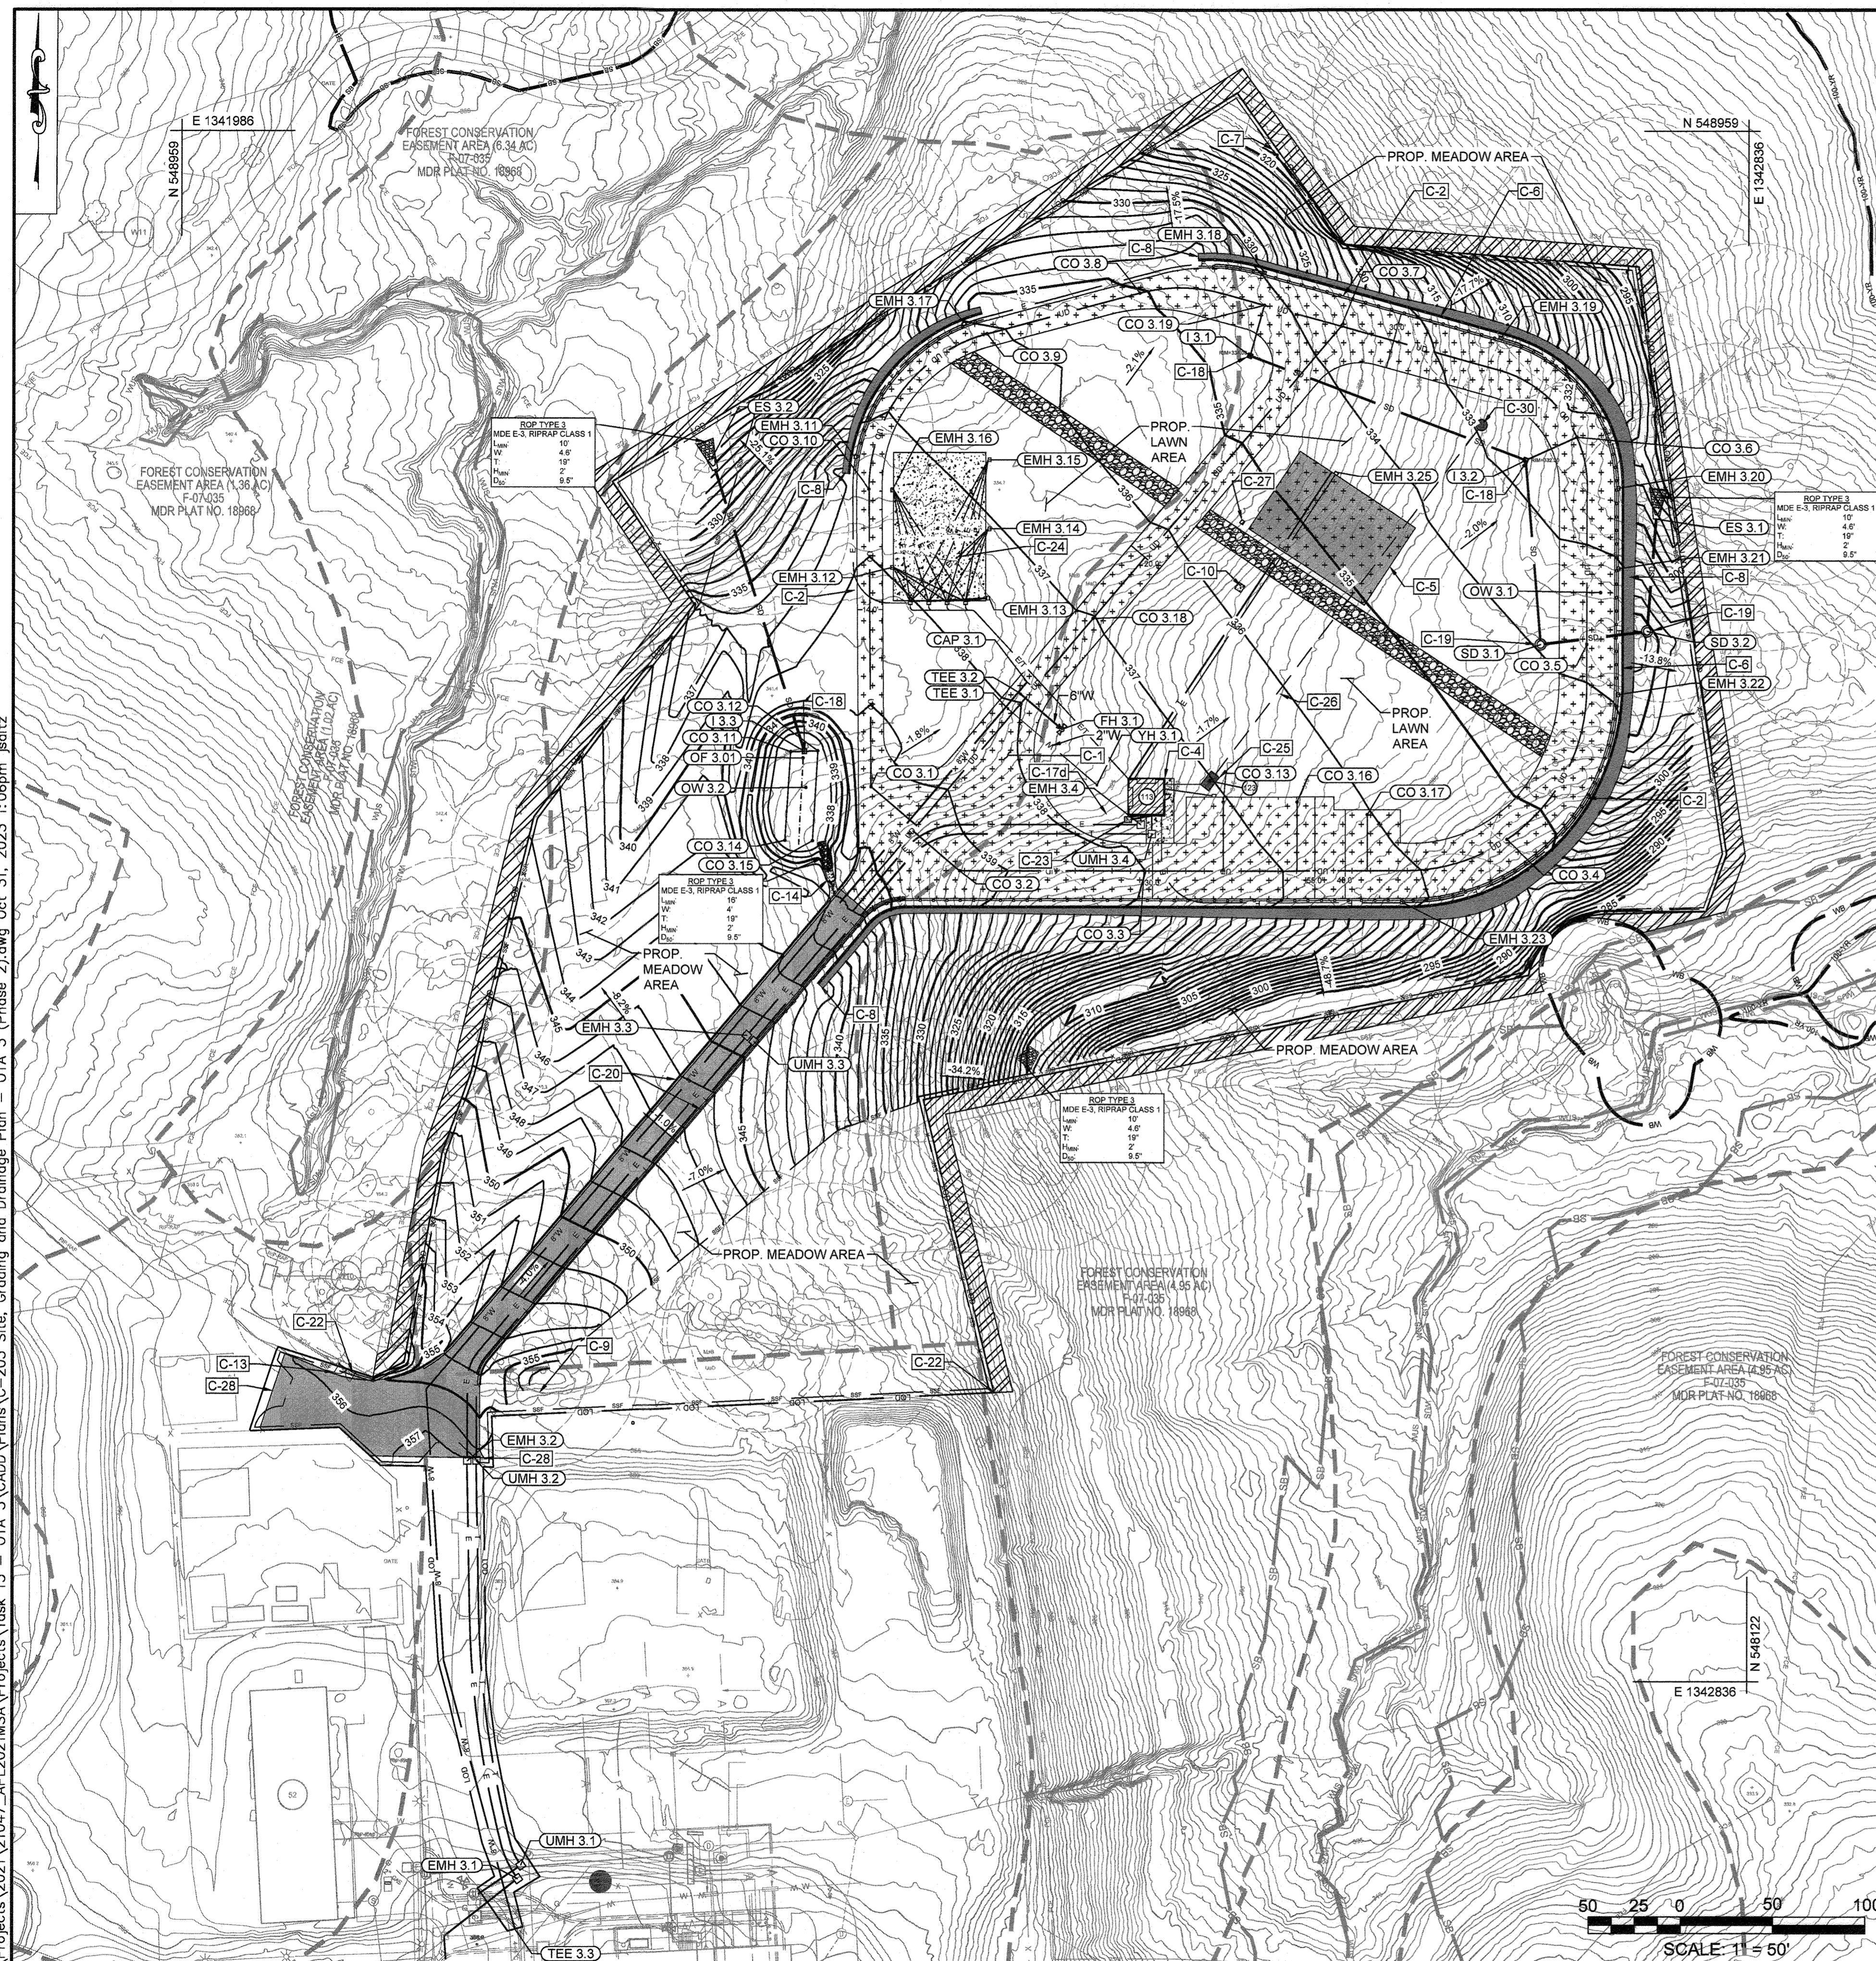

GENERAL NOTES

1. THE TOPOGRAPHIC INFORMATION SHOWN HEREON, WAS OBTAINED FROM AN AERIAL SURVEY FLOWN BY AXIS GEOSPATIAL ON APRIL 6, 2014 AND PROVIDED TO RK&K IN AUGUST OF 2017. THE UTILITY INFORMATION WAS PROVIDED ELECTRONICALLY TO RK&K BY JHU APL IN AUGUST OF 2017. TOPOGRAPHIC AND UTILITY INFORMATION MAY NOT REFLECT CURRENT CONDITIONS. IT IS THE CONTRACTOR'S RESPONSIBILITY TO FIELD VERIFY ACTUAL SITE CONDITIONS PRIOR TO THE START OF ANY WORK. THERE IS NO WARRANTY OR GUARANTEE ON THE COMPLETENESS OR CORRECTNESS OF THE EXISTING CONDITION INFORMATION. ANY DISCREPANCY FOUND SHALL BE BROUGHT TO THE IMMEDIATE ATTENTION OF THE ENGINEER PRIOR TO THE START OF ANY WORK.
2. BEARINGS, COORDINATES AND ELEVATIONS SHOWN ON THIS PLAN ARE SHOWN IN MARYLAND STATE PLANE. ALL VERTICAL CONTROLS ARE BASED ON NAVD 88.
3. THE SITE IS PRIMARILY WOODED AND ALL TREES WILL BE REMOVED FROM THE SITE. THE PROPOSED TREE LINE WILL BE THE LIMIT OF DISTURBANCE (LOD).

SITE AND UTILITY PLAN NOTES

1. UNLESS OTHERWISE NOTED, DIMENSIONS FROM CURB ARE MEASURED AT FACE OF CURB.
2. THE CONTRACTOR SHALL PROVIDE A TWO-FOOT AREA AT 1/2-INCH PER FOOT SLOPE BEHIND ALL PROPOSED CURB, UNLESS OTHERWISE INDICATED.
3. FINISHED GRADES SHALL FALL AWAY FROM EXISTING AND PROPOSED BUILDINGS AT A MINIMUM OF 1/4-INCH PER FOOT FOR VEGETATED AREAS AND A MINIMUM OF 1/8-INCH PER FOOT FOR PAVED AREAS UNLESS OTHERWISE INDICATED.
4. IT SHALL BE THE RESPONSIBILITY OF THE CONTRACTOR TO FIELD VERIFY ACTUAL SITE CONDITIONS PRIOR TO THE START OF WORK. THERE IS NO WARRANTY OR GUARANTEE ON THE COMPLETENESS OR CORRECTNESS OF THE EXISTING CONDITION INFORMATION SHOWN ON THESE DRAWINGS. ANY DISCREPANCY FOUND SHALL BE BROUGHT TO THE IMMEDIATE ATTENTION OF THE ENGINEER PRIOR TO STARTING WORK.
5. THE CONTRACTOR SHALL FIELD VERIFY HORIZONTAL AND VERTICAL LOCATIONS OF EXISTING UTILITIES PRIOR TO STARTING WORK AND SHALL NOTIFY THE ENGINEER OF ANY DISCREPANCIES THAT EXIST.
6. ALL EXISTING UTILITY SURFACE FEATURES INCLUDING BUT NOT LIMITED TO INLETS, MANHOLES, HAND HOLES, MECHANICAL LIDS, FIRE HYDRANTS, VALVE BOXES, ETC. WITHIN THE LIMITS OF DISTURBANCE TO BE ADJUSTED TO FINISHED GRADE UNLESS OTHERWISE NOTED.
7. THE CONTRACTOR SHALL MAINTAIN POSITIVE DRAINAGE AWAY FROM BUILDINGS AND STRUCTURES AT ALL TIMES.
8. THE CONTRACTOR SHALL CONTACT "MISS UTILITY" (1-800-257-7777) AT LEAST 48 HOURS PRIOR TO BEGINNING ANY DEMOLITION, UTILITY, OR EXCAVATION ACTIVITY.
9. REFER TO SHEET E-104 ELECTRICAL & COMMUNICATIONS SITE PLAN FOR SITE ELECTRICAL AND COMMUNICATIONS DISPOSITION NOTES AND LAYOUT.

SITE PLAN NOTES* KEY [C-1]

1. PROPOSED POROUS ASPHALT PAVEMENT WITH FLUSH CURB (HC R-3.07) ON ALL SIDES. SEE SWM SHEETS. REFER TO FLUSH CURB DETAIL ON C-216 AND POROUS ASPHALT PAVEMENT ON C-505.
2. PROPOSED TRAFFIC BARRIER W BEAM WITH WOOD OFFSET BLOCK (MD SHA 605.21), SINGLE FACE (MD SHA 605.22) INSTALLED AT FACE OF CURB PER MD SHA 605.31. TYPE C END TREATMENTS AT BOTH ENDS OF GUARDRAIL PER MD SHA 605.03. FLARE END SECTION AT 50:1.
3. NOT USED.
4. PROPOSED 20' x 20' CMU SHED.
5. PROPOSED POROUS CONCRETE PAD, SEE DETAIL ON SHEET C-505.
6. PROPOSED 48" CHAINLINK FENCE & GRAVEL MAINTENANCE STRIP (HC G-7.21).
7. PROPOSED SECURITY FENCE, REFER TO SPECIFICATION SECTION 32 31 13
8. PROPOSED SEGMENTAL BLOCK RETAINING WALL.
9. EXISTING TREE LINE.
10. PROPOSED 4'W x 4'L x 4'D CONCRETE ANCHOR BLOCK, REFER TO STRUCTURAL DWGS.
11. PROPOSED CONCRETE SIDEWALK. SLOPE TO POROUS PAVEMENT (HC R-3.05).
12. PROPOSED CONCRETE SIDEWALK (HC R-3.05).
13. PROPOSED 10' WIDE DOUBLE SWING GATE WITH 5' PANELS FOR VEHICULAR ACCESS. REFER TO SPECIFICATION SECTION 32 31 13.
14. PROPOSED CONCRETE CURB OPENING (SEE MD SHA 640.01, SHEET C-505).
15. NOT USED.
16. NOT USED.
17. NOT USED.
- 17a. NOT USED.
- 17b. NOT USED.
- 17c. NOT USED.
- 17d. NOT USED.
- 17e. NOT USED.
18. PROPOSED YARD INLET (HC D-4.14).
19. PROPOSED 48" PRECAST MANHOLE.
20. PROPOSED 7" CONCRETE BARRIER CURB (HC R-3.01). (SUBSTITUTE BARRIER CURB FOR FLUSH CURB).
21. TIE-IN TO PROPOSED UMH-2 WALL TERMINATOR (8-4") TO BE INSTALLED UNDER SDP 18-035.
22. CONNECT NEW PROPOSED FENCE TO EXISTING FENCE.
23. PROPOSED TRANSFORMER PAD, 36"x44"x6". 3000 PSI CONCRETE. MINIMUM 4' FROM FACE OF BUILDING.
24. PROPOSED 80' X 50' CONTAINER FOUNDATION PAD, 10" THICKNESS WITH TURNDOWN EDGES
25. PROPOSED PORTA-KING SPORTS VIEWING TOWER FOR CAMERA CABLE SYSTEM, REFER TO ELEVATION ON SHEET A-106.
26. PROPOSED TEMPORARY STEEL CABLE FOR CAMERA SYSTEM
27. PROPOSED SURVEY MONUMENT, REFER TO DETAIL ON SHEET C-216.
28. MEET EXISTING CONDITIONS
29. PROPOSED STORMWATER MANAGEMENT FACILITY, SEE SHEET C-503.
30. PROPOSED 60' HEIGHT SPORTS POLE FOR CAMERA CABLE SYSTEM.

▲ PURPOSE STATEMENT (11/1/23): DESIGN OF OUTDOOR TESTING AREA 3, INCLUDING THE SOURCE OF BORROW MATERIAL, REFERRED TO AS THE EAST AND WEST BORROW AREAS.

| PERMANENT STABILIZATION NOTE | |
|---|--|
| UNLESS OTHERWISE NOTED, ALL DISTURBED AREAS SHOULD RECEIVE 4" OF TOPSOIL AND SEED MIX CONTAINING 70% TURF TYPE TALL FESCUE AND 30% PERENNIAL RYE, WITH A CURLEX COVERING. LOOSE STRAW IS NOT PERMITTED. | |

| OTA-3 LANDCOVER SUMMARY | |
|----------------------------|------------|
| LIMITS OF DISTURBANCE..... | 311,260 SF |
| EX. IMPERVIOUS AREA..... | 6,432 SF |
| PROP. IMPERVIOUS AREA..... | 69,184 SF |
| CUT..... | 5,100 CY |
| FILL..... | 86,980 CY |

LEGEND

| | |
|--|--|
| | EXISTING MINOR CONTOUR INTERVAL |
| | EXISTING MAJOR CONTOUR INTERVAL |
| | EXISTING SOIL BOUNDARY |
| | EX. FOREST CONSERVATION EASEMENT |
| | LIMIT OF DISTURBANCE / PROPOSED TREELINE |
| | TREE PROTECTION FENCE |
| | SUPER SILT FENCE |
| | PROPOSED MAJOR CONTOUR |
| | PROPOSED MINOR CONTOUR |
| | PROPOSED 4' CHAIN LINK FENCE |
| | GUARDRAIL |
| | PROP. SECURITY FENCE |
| | PROPOSED STORM DRAIN |
| | PROPOSED ELECTRIC |
| | PROPOSED COMMUNICATION |
| | PROPOSED ELECTRIC/TELECOM |
| | PROPOSED WATER |
| | PROPOSED FIRE HYDRANT |
| | PROPOSED ASPHALT PAVEMENT |
| | PROPOSED RETAINING WALL |
| | PROPOSED POROUS ASPHALT PAVEMENT |
| | PROPOSED REINFORCED TURF/GRAVELPAVE |
| | PROPOSED CONCRETE PAVEMENT |
| | PROPOSED BUILDING |
| | PROPOSED POROUS CONCRETE PAVEMENT |
| | EXISTING WETLAND BUFFER |
| | EXISTING WETLAND |
| | EXISTING WATERS OF THE U.S. |
| | SOIL BOUNDARY |
| | 100-YR FLOOD PLAIN |
| | STREAM/RIVER BUFFER |
| | SEE LEGEND ON C-103 |

- *NOTES:
1. SOME NOTES MAY NOT BE REPRESENTED ON THIS SHEET.
 2. DETAIL REFERENCES ARE STANDARD HOWARD COUNTY OR MDSA DETAILS.

APPROVED: DEPARTMENT OF PLANNING AND ZONING
 Chief, Development Engineering Division
 Date: 12-5-23
 Chief, Division of Land Development
 Date: 2/22/24

RK&K
 RUMMEL, KLEPPER & KAHL, LLP
 ENGINEERS/CONSTRUCTORS/MANAGERS/PLANNERS/SCIENTISTS
 RESPONSIVE PEOPLE • CREATIVE SOLUTIONS
 700 East Pratt Street, Suite 500
 Baltimore, MD 21202
 PH: 410.728.2900 FAX: 410.728.2901
 www.rkk.com

DESIGN BY: SHK
 DRAWN BY: JMS/DTP
 CHECKED BY: CWWW
 DATE: 11/1/2023

| BY | NO. | REVISION | DATE |
|----|-----|----------|------|
| | | | |

OWNER/DEVELOPER
JOHNS HOPKINS APPLIED PHYSICS LABORATORY
 11100 JOHNS HOPKINS ROAD
 LAUREL, MARYLAND 20723

SITE, GRADING AND UTILITY PLAN - OTA 3
 (PHASE 2)
 JOHNS HOPKINS UNIVERSITY - APPLIED PHYSICS LABORATORY
OUTDOOR TESTING AREAS
 11100 JOHNS HOPKINS ROAD
 PARCEL: 123 GRID: 18 ZONED: PEG
 ELECTION DISTRICT 5 - HOWARD COUNTY, MARYLAND
 SHEET 07 OF 73

RK&K PROJECT NUMBER
 21047.013
 SCALE:
 As Shown


LEGEND

- LOD --- LIMIT OF DISTURBANCE
- 4' CHAIN LINK FENCE
- GUARDRAIL
- X --- 10' SECURITY FENCE
- EXISTING MINOR CONTOUR INTERVAL
- EXISTING MAJOR CONTOUR INTERVAL
- SD --- PROPOSED STORM PIPE
- FCE --- EX. FOREST CONSERVATION EASEMENT
- ASPHALT DRIVEWAY
- GRASS/TOPSOIL RESTORATION
- CONCRETE PAD, SEE SHEET A-101

GENERAL NOTES

1. THE TOPOGRAPHIC INFORMATION SHOWN HEREON, WAS OBTAINED FROM AN AERIAL SURVEY FLOWN BY AXIS GEOSPATIAL ON APRIL 6, 2014 AND PROVIDED TO RK&K IN AUGUST OF 2017. THE UTILITY INFORMATION WAS PROVIDED ELECTRONICALLY TO RK&K BY JHU APL IN AUGUST OF 2017. TOPOGRAPHIC AND UTILITY INFORMATION MAY NOT REFLECT CURRENT CONDITIONS. IT IS THE CONTRACTOR'S RESPONSIBILITY TO FIELD VERIFY ACTUAL SITE CONDITIONS PRIOR TO THE START OF ANY WORK. THERE IS NO WARRANTY OR GUARANTEE ON THE COMPLETENESS OR CORRECTNESS OF THE EXISTING CONDITION INFORMATION. ANY DISCREPANCY FOUND SHALL BE BROUGHT TO THE IMMEDIATE ATTENTION OF THE ENGINEER PRIOR TO THE START OF ANY WORK.
2. BEARINGS, COORDINATES AND ELEVATIONS SHOWN ON THIS PLAN ARE SHOWN IN MARYLAND STATE PLANE. ALL VERTICAL CONTROLS ARE BASED ON NAVD 88.
3. FOR PROJECT GENERAL NOTES, SEE THE COVER SHEET.
4. THE SITE IS PRIMARILY WOODED AND ALL TREES WILL BE REMOVED FROM THE SITE. THE PROPOSED TREE LINE WILL BE THE LIMIT OF DISTURBANCE (LOD).

11/17/2017 17:52 - JHUAPL - CAOD - Plans - C-204 - 206 Layout - Plans.dwg Jul 03, 2018 2:36pm cmtitchell

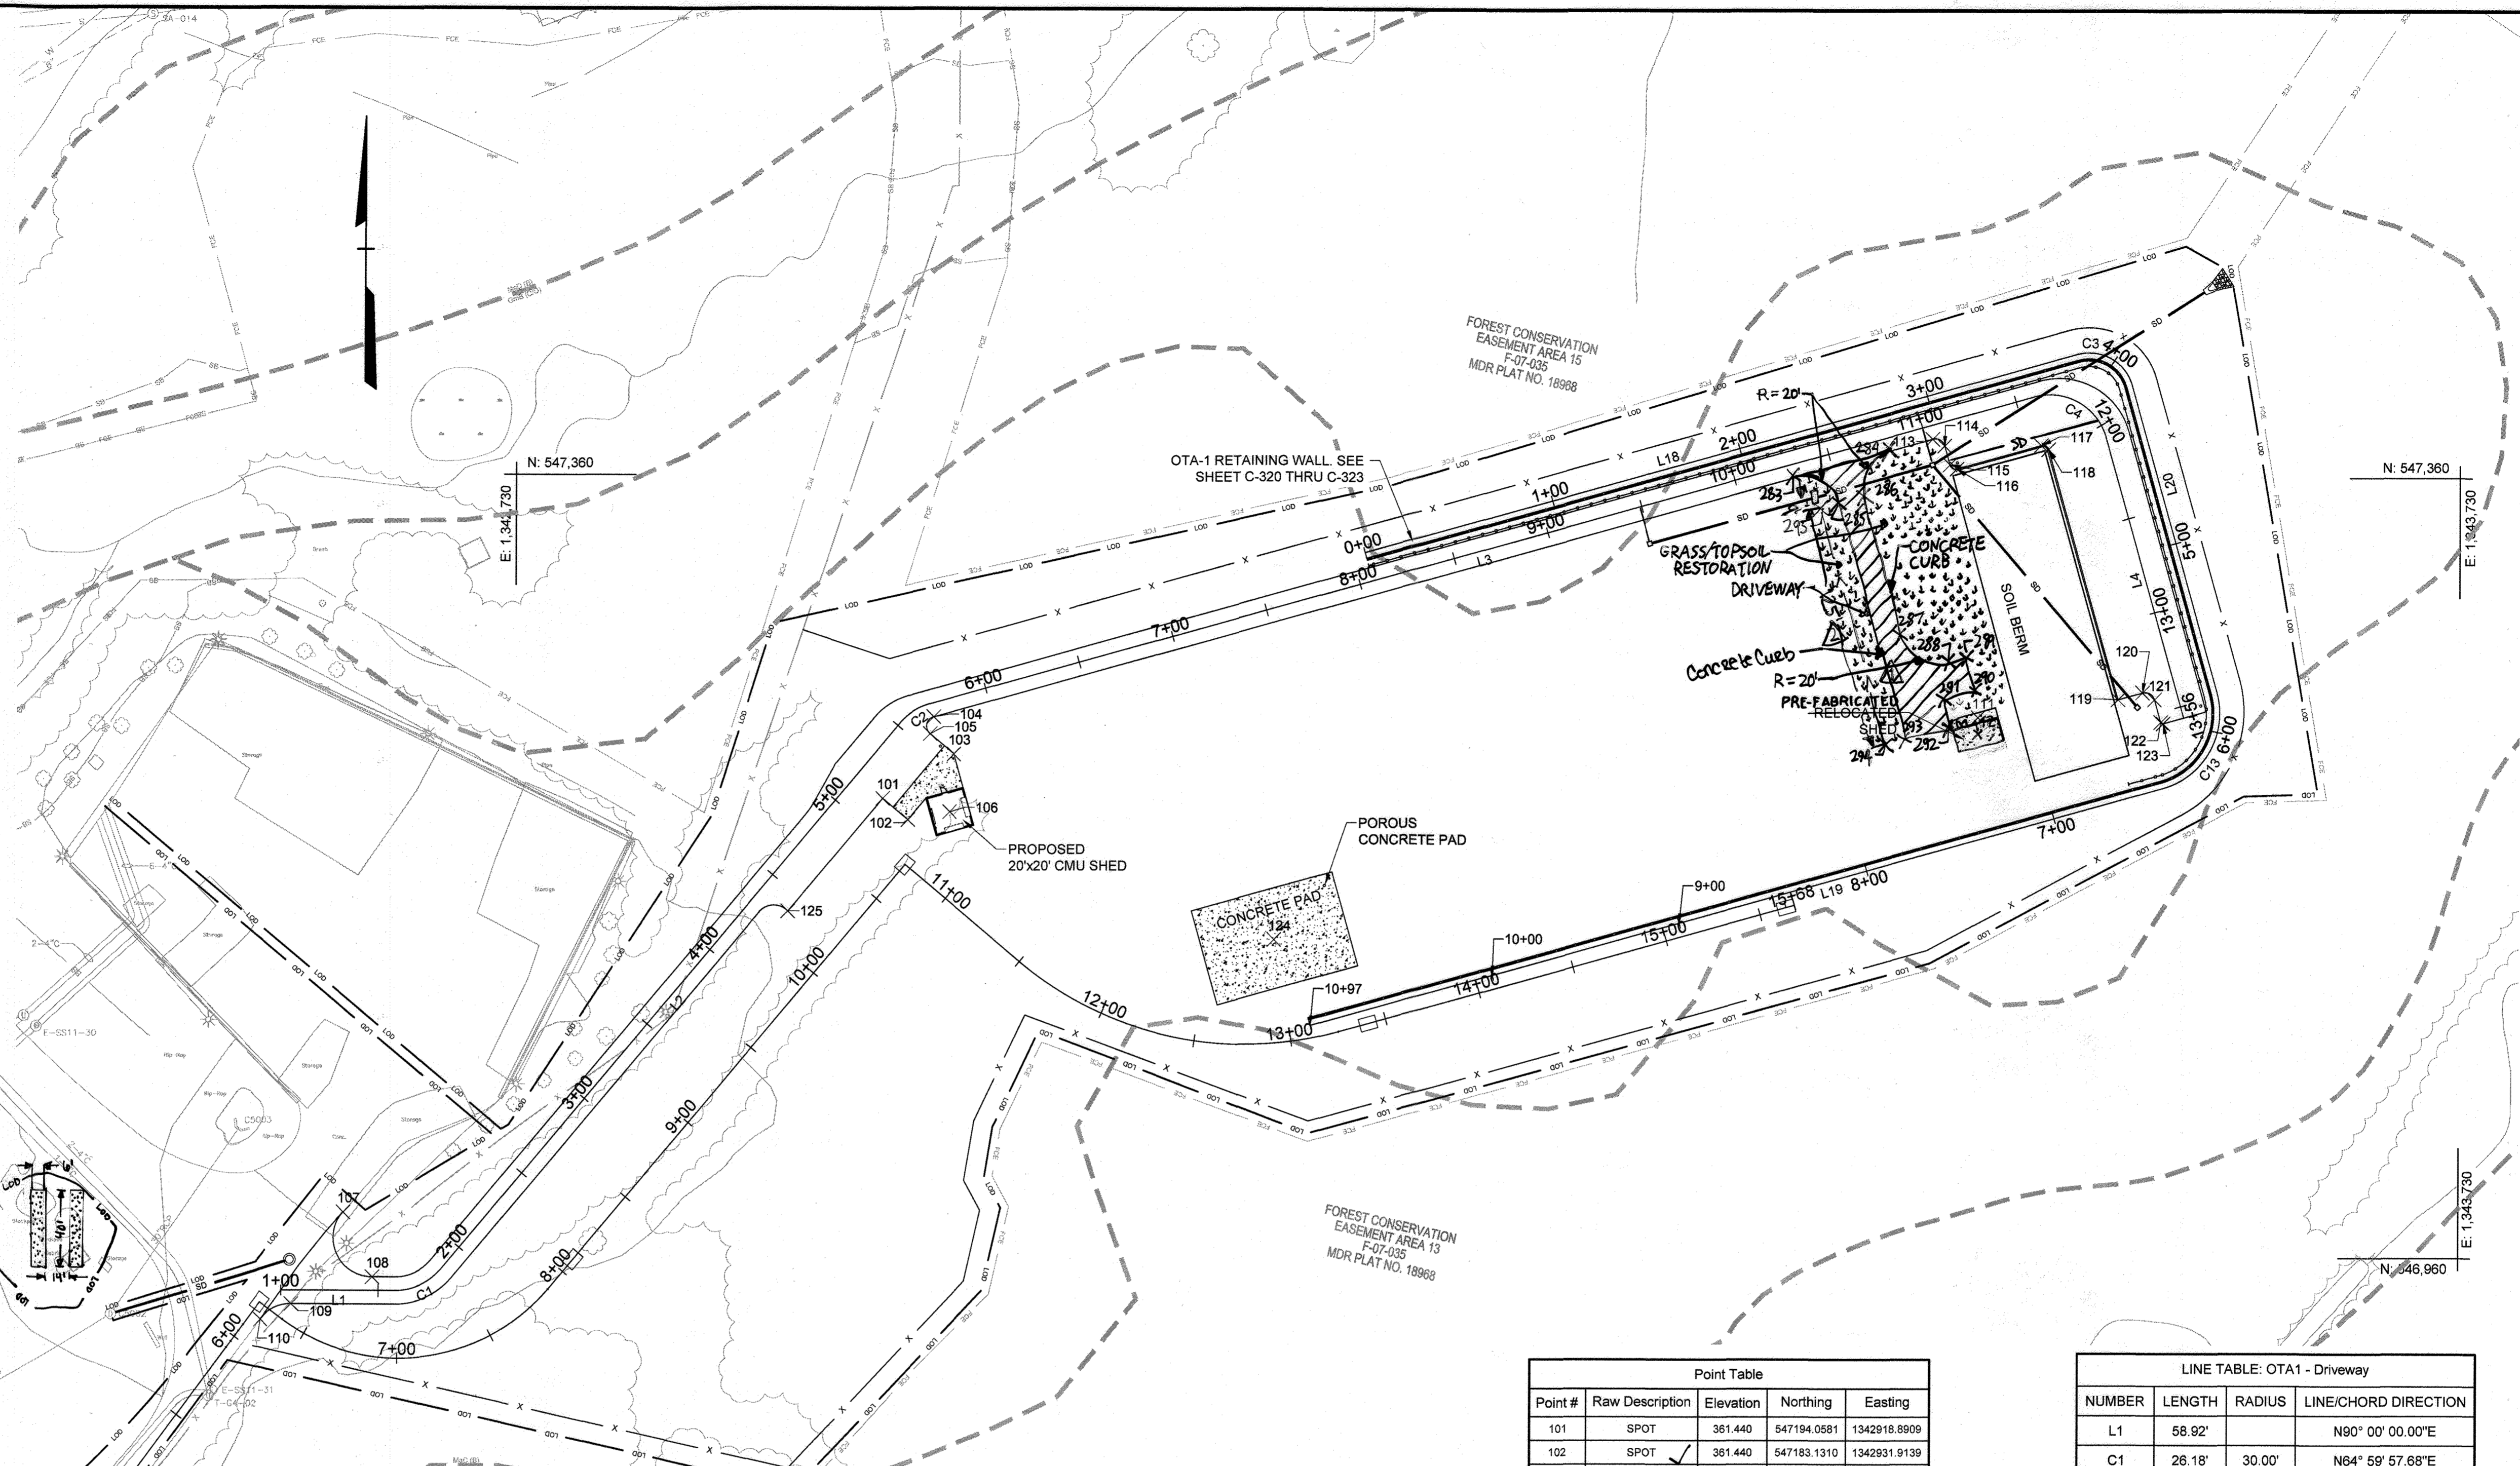

| Point# | Raw Description | Elevation | Northing | Easting |
|--------|-----------------|-----------|-------------|--------------|
| 283 | SPOT | 337.265 | 547359.6466 | 1343397.3099 |
| 284 | SPOT | 336.552 | 547373.6061 | 1343437.3844 |
| 285 | SPOT | 337.094 | 547345.7793 | 1343411.9615 |
| 286 | SPOT | 336.996 | 547349.0146 | 1343423.5171 |
| 287 | SPOT | 338.127 | 54727.6932 | 1343443.4851 |
| 288 | SPOT | 338.226 | 547263.8259 | 1343468.1367 |
| 289 | SPOT | 338.326 | 547266.5219 | 1343477.7664 |
| 290 | SPOT | 338.537 | 547249.1885 | 1343482.6193 |
| 291 | SPOT | 338.357 | 547244.3356 | 1343465.2858 |
| 292 | SPOT | 338.670 | 547230.6668 | 1343469.1127 |
| 293 | SPOT | 338.721 | 547224.1963 | 1343446.0014 |
| 294 | SWALE | 338.121 | 547221.5002 | 1343436.3717 |
| 295 | SWALE | 336.494 | 547343.0833 | 1343402.3318 |

| Point # | Raw Description | Elevation | Northing | Easting |
|---------|-----------------|-----------|-------------|--------------|
| 101 | SPOT | 361.440 | 547194.0881 | 1342918.8909 |
| 102 | SPOT | 361.440 | 547183.1310 | 1342931.9139 |
| 103 | SPOT | 360.647 | 547218.7917 | 1342955.9833 |
| 104 | SPOT 240.17 | 360.999 | 547235.8296 | 1342945.0829 |
| 105 | SPOT 340.21 | 360.804 | 547227.1845 | 1342943.1970 |
| 106 | SPOT | 360.900 | 547487.4830 | 1342963.4423 |
| 107 | SPOT 355.76 | 360.900 | 548981.3798 | 1342842.1345 |
| 108 | SPOT 358.32 | 355.152 | 548948.1370 | 1342857.1221 |
| 109 | SPOT 356.16 | 360.166 | 548934.1370 | 1342815.4513 |
| 110 | SPOT | 358.350 | 548926.2372 | 1342899.6269 |
| 111 | SPOT | 358.350 | 547238.0490 | 1343482.3745 |
| 112 | SPOT | 358.350 | 547226.8016 | 1343486.2824 |
| 113 | SPOT 355.89 | 358.297 | 547379.6203 | 1343458.8515 |
| 114 | SPOT 355.89 | 358.297 | 547378.1535 | 1343464.8144 |
| 115 | SPOT 355.77 | 358.662 | 547358.6238 | 1343467.5105 |
| 116 | SPOT 356.01 | 358.703 | 547364.4437 | 1343471.2082 |
| 117 | SPOT 356.77 | 358.934 | 547378.5827 | 1343514.6662 |
| 118 | SPOT 355.98 | 358.919 | 547374.5026 | 1343518.2639 |
| 119 | SPOT 355.75 | 358.467 | 547248.1490 | 1343554.1994 |
| 120 | SPOT 355.88 | 358.732 | 547249.6538 | 1343566.7180 |
| 121 | SPOT 355.50 | 358.578 | 547248.1870 | 1343572.8809 |
| 122 | SPOT | 335.770 | 547234.6314 | 1343576.1162 |
| 123 | SPOT | 335.753 | 547233.9380 | 1343577.3488 |
| 124 | SPOT | 344.094 | 547122.0000 | 1343120.6000 |
| 125 | SPOT | 363.861 | 547198.0877 | 1342870.2501 |

| NUMBER | LENGTH | RADIUS | LINE/CHORD DIRECTION |
|--------|---------|--------|----------------------|
| C1 | 26.18' | 30.00' | N64° 59' 57.68"E |
| L2 | 366.84' | | N39° 59' 55.35"E |
| C2 | 17.99' | 30.00' | N57° 10' 44.27"E |
| L3 | 589.69' | | N74° 21' 33.19"E |
| C4 | 47.12' | 30.00' | S60° 38' 26.81"E |
| L4 | 149.29' | | S15° 38' 26.81"E |

POINT OF BEGINNING: N 546,941.14, E 1,342,610.27

| NUMBER | LENGTH | RADIUS | LINE/CHORD DIRECTION |
|--------|---------|--------|----------------------|
| L18 | 379.90' | | N74° 21' 33.19"E |
| C3 | 36.14' | 23.01' | S60° 38' 26.81"E |
| L20 | 163.28' | | S15° 38' 26.81"E |
| C13 | 62.85' | 40.01' | S28° 21' 31.18"W |
| L19 | 454.90' | | S74° 21' 29.17"W |

POINT OF BEGINNING: N 547,320.78, E 1,343,166.84


| | | | | |
|-----|---------|---------|-------------|--------------|
| 111 | CL SLAB | 338.650 | 547236.3593 | 1343480.2867 |
| 112 | FFE | 338.670 | 547228.1740 | 1343482.5781 |

PROFESSIONAL CERTIFICATION. I HEREBY CERTIFY THAT THESE DOCUMENTS WERE PREPARED OR APPROVED BY ME, AND THAT I AM A DULY LICENSED PROFESSIONAL ENGINEER UNDER THE LAWS OF THE STATE OF MARYLAND. LICENSE NO. 49932, EXPIRATION DATE: 5/31/24

PROFESSIONAL CERTIFICATION. I HEREBY CERTIFY THAT THESE DOCUMENTS WERE PREPARED OR APPROVED BY ME, AND THAT I AM A DULY LICENSED PROFESSIONAL ENGINEER UNDER THE LAWS OF THE STATE OF MARYLAND. LICENSE NO. 23012, EXPIRATION DATE: MARCH 6, 2028

PURPOSE STATEMENT (4/17/22): ADDITION OF TWO 6'x4' CONCRETE PADS.

I hereby certify, by my seal, that to the best of my knowledge and belief the facilities shown on this plan were constructed as shown on this "AS-BUILT" plan meet the Approved Plans and Specifications. Charles W.W. Mitchell, III PE # 49932, 02/11/23

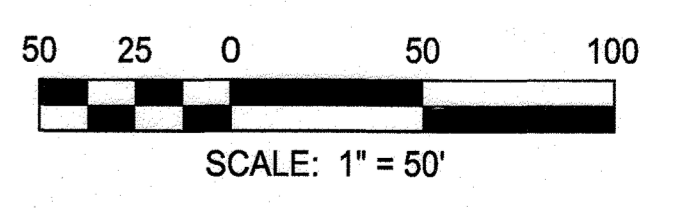

APPROVED: DEPARTMENT OF PLANNING AND ZONING
 Chief, Development Engineering Division: 9-21-18
 Date: 9-25-18
 Chief, Division of Land Development: 9-26-18
 Date: 9-26-18

RK&K
 RUMMEL, KLEPPER & KHALIL, LLP
 ENGINEERS, ARCHITECTS, PLANNERS, INTERIORS
 RESPONSIVE PEOPLE • CREATIVE SOLUTIONS
 700 East Pratt Street, Suite 500
 Baltimore, MD 21202
 P: 410.728.2200
 www.rkk.com


DESIGN BY: RK&K
 DRAWN BY: CWWM
 CHECKED BY: CDK
 DATE: 8/17/18

| BY | NO. | REVISION | DATE |
|------|-----|-------------------------------------|---------|
| RK&K | 1 | SHED LOCATION REVISION | 9/10/19 |
| RK&K | 2 | ASPHALT DRIVEWAY ADDITION | 7/30/21 |
| | | SDP SUBMISSION | |
| RK&K | 3 | ADDITION OF TWO 6'x4' CONCRETE PADS | 4/17/22 |

OWNER/DEVELOPER
JOHNS HOPKINS APPLIED PHYSICS LABORATORY
 11100 JOHNS HOPKINS ROAD
 LAUREL, MARYLAND 20723

LAYOUT PLAN - OTA 1 (PHASE 1)
AS-BUILT
OUTDOOR TESTING AREAS
 11100 JOHNS HOPKINS ROAD
 TAX MAP: 41 PARCEL: 123 GRID: 18 ZONED: PEC
 ELECTION DISTRICT 5 - HOWARD COUNTY, MARYLAND
 SHEET 08 OF 73

C-204
 RK&K PROJECT NUMBER 17152
 SCALE: As Shown

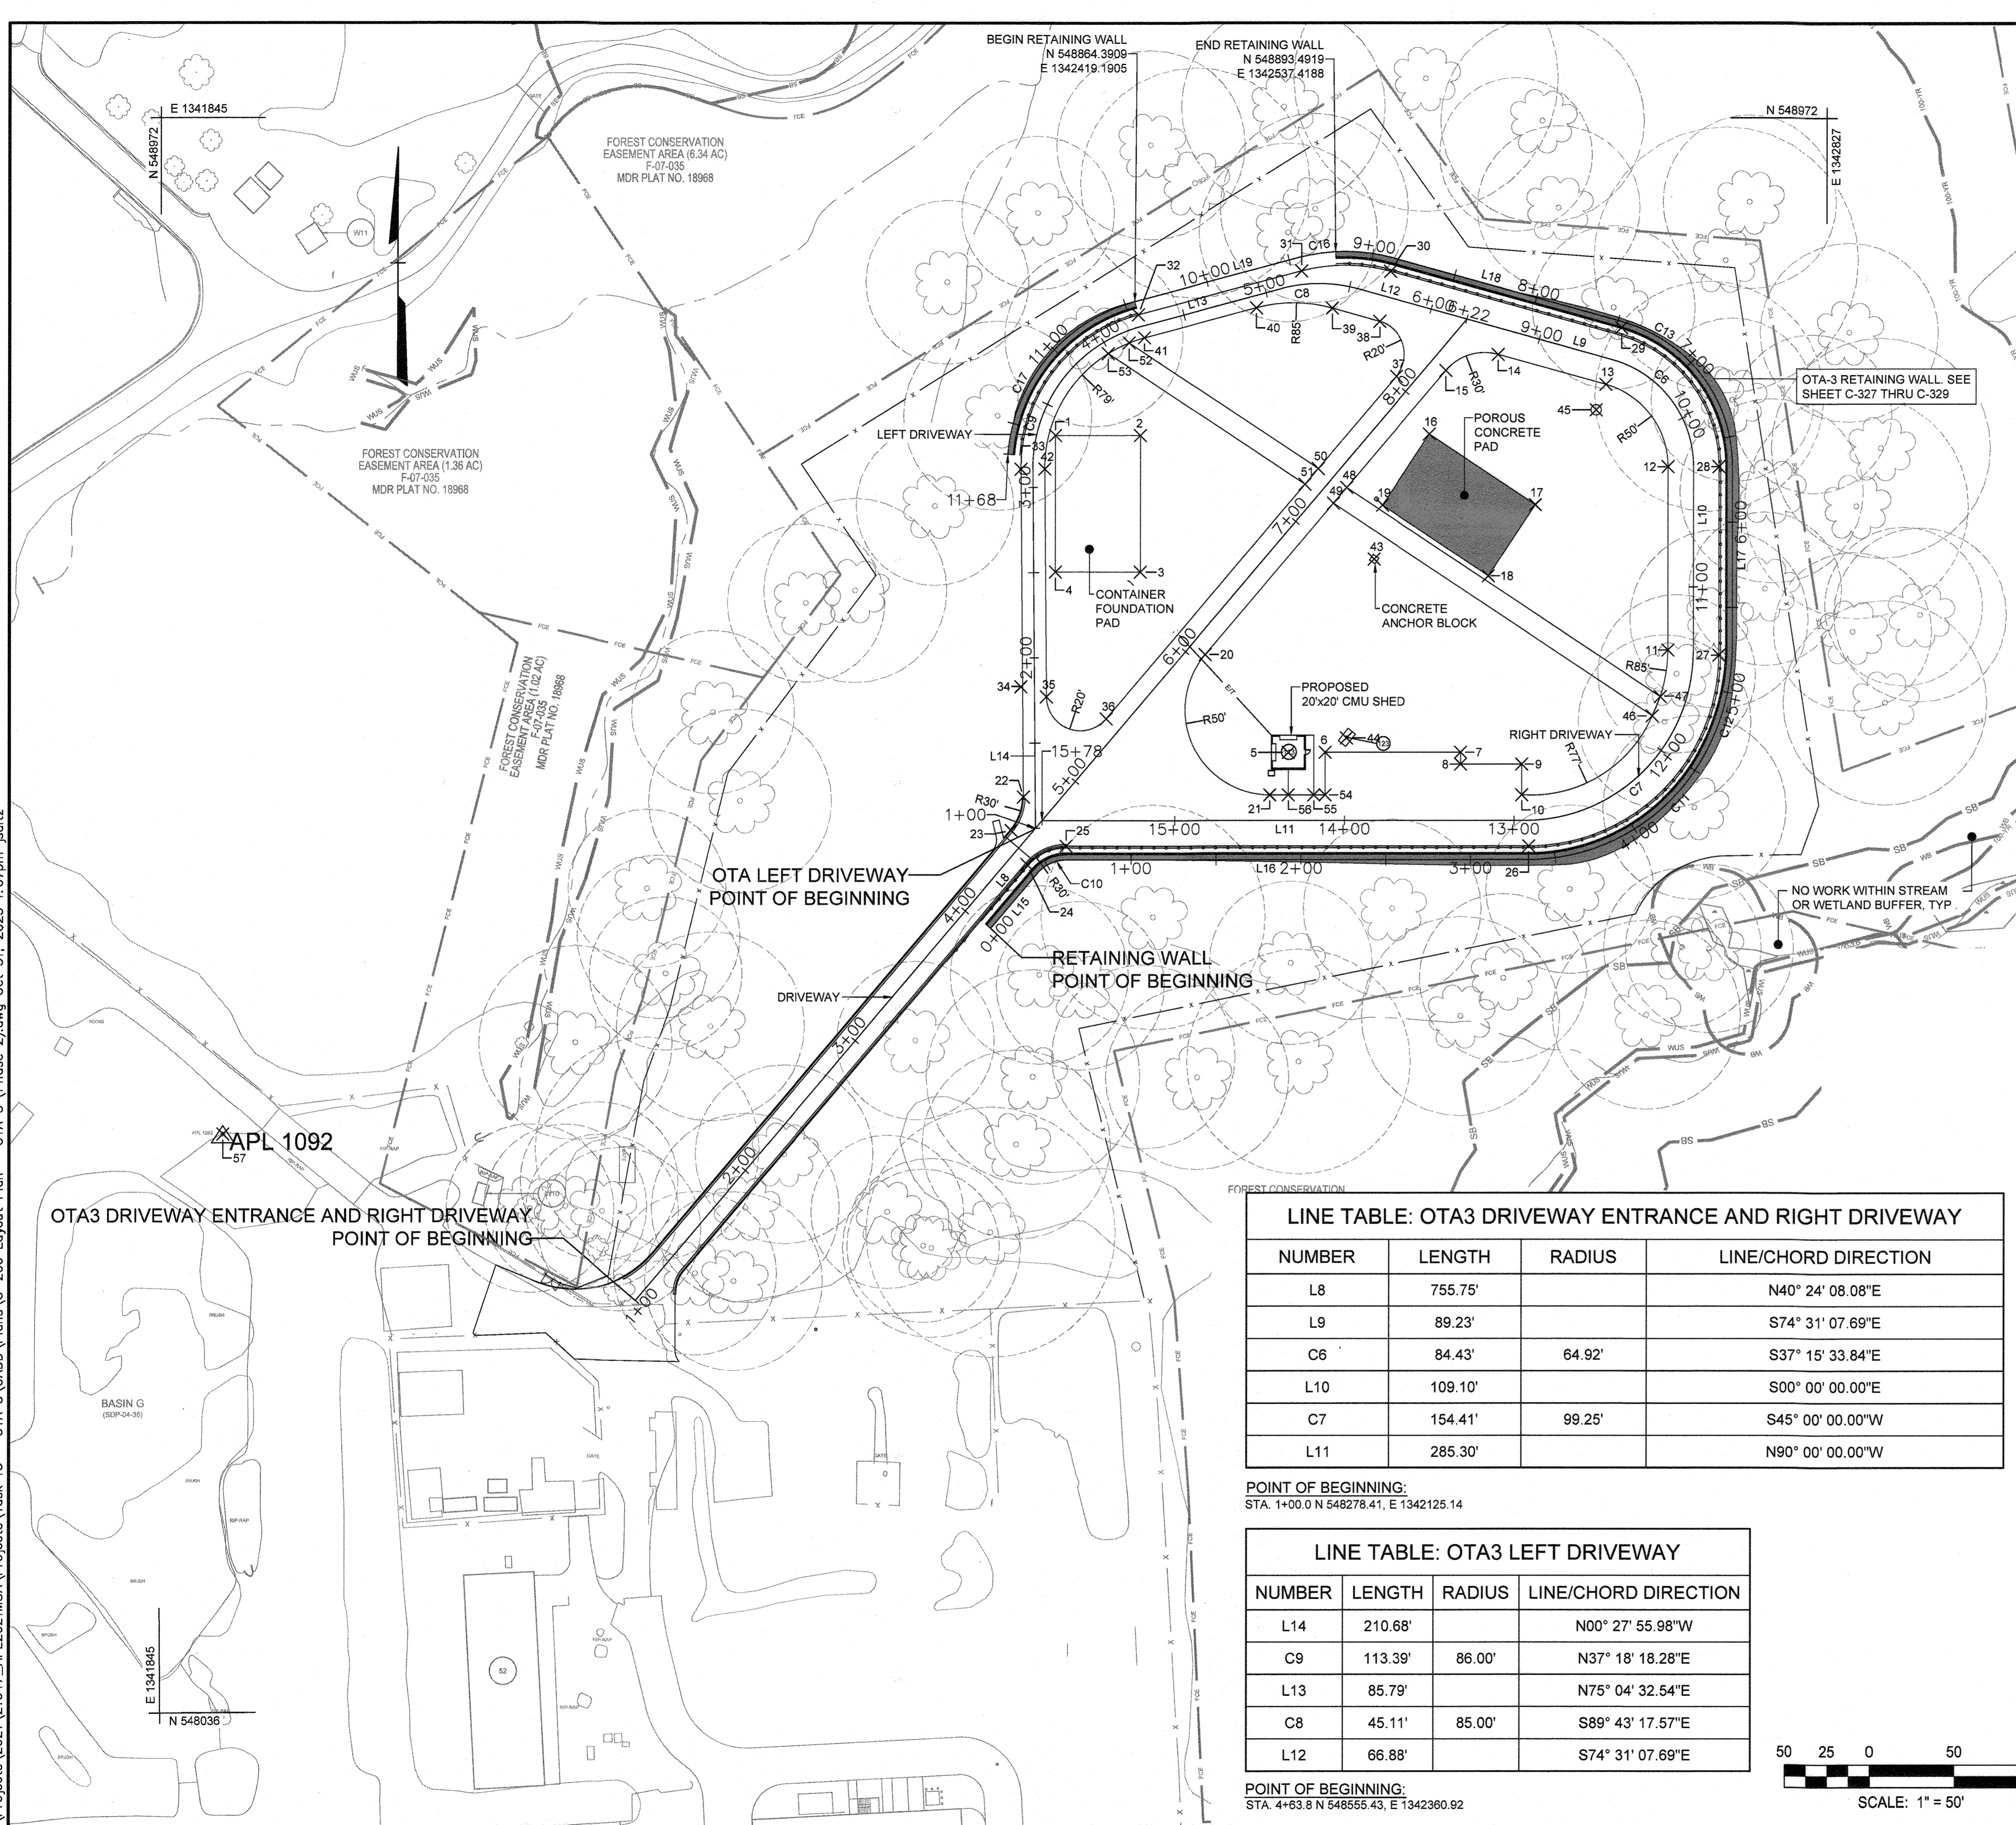

GENERAL NOTES

1. THE TOPOGRAPHIC INFORMATION SHOWN HEREON, WAS OBTAINED FROM AN AERIAL SURVEY FLOWN BY AXIS GEOSPATIAL ON APRIL 6, 2014 AND PROVIDED TO RK&K IN AUGUST OF 2017. THE UTILITY INFORMATION WAS PROVIDED ELECTRONICALLY TO RK&K BY JHU APL IN AUGUST OF 2017. TOPOGRAPHIC AND UTILITY INFORMATION MAY NOT REFLECT CURRENT CONDITIONS. IT IS THE CONTRACTOR'S RESPONSIBILITY TO FIELD VERIFY ACTUAL SITE CONDITIONS PRIOR TO THE START OF ANY WORK. THERE IS NO WARRANTY OR GUARANTEE ON THE COMPLETENESS OR CORRECTNESS OF THE EXISTING CONDITION INFORMATION. ANY DISCREPANCY FOUND SHALL BE BROUGHT TO THE IMMEDIATE ATTENTION OF THE ENGINEER PRIOR TO THE START OF ANY WORK.
2. BEARINGS, COORDINATES AND ELEVATIONS SHOWN ON THIS PLAN ARE SHOWN IN MARYLAND STATE PLANE. ALL VERTICAL CONTROLS ARE BASED ON NAVD 88.
3. THE SITE IS PRIMARILY WOODED AND ALL TREES WILL BE REMOVED FROM THE SITE. THE PROPOSED TREE LINE WILL BE THE LIMIT OF DISTURBANCE (LOD).

| Point Table | | | |
|-------------|-----------|-------------|--------------|
| Point # | Elevation | Northing | Easting |
| 1 | 335.500 | 548785.8316 | 1342372.5333 |
| 2 | 333.983 | 548785.8316 | 1342422.5333 |
| 3 | 333.779 | 548705.8316 | 1342422.5333 |
| 4 | 335.500 | 548705.8316 | 1342372.5333 |
| 5 | 331.385 | 548599.8170 | 1342509.7963 |
| 6 | 330.945 | 548599.9420 | 1342531.4571 |
| 7 | 329.421 | 548599.9420 | 1342611.4571 |
| 8 | 329.462 | 548592.9420 | 1342611.4571 |
| 9 | 328.771 | 548592.9420 | 1342647.4571 |
| 10 | 328.659 | 548574.9420 | 1342647.4571 |
| 11 | 326.130 | 548659.9420 | 1342733.5630 |
| 12 | 325.259 | 548767.4822 | 1342733.5630 |
| 13 | 325.754 | 548815.6981 | 1342696.9091 |
| 14 | 327.306 | 548833.2770 | 1342633.3325 |
| 15 | 328.146 | 548823.8100 | 1342602.4794 |
| 16 | 328.608 | 548786.5261 | 1342592.8005 |
| 17 | 327.367 | 548745.1075 | 1342655.3265 |
| 18 | 328.336 | 548703.4235 | 1342627.7141 |
| 19 | 329.543 | 548744.8421 | 1342565.1881 |
| 20 | 332.349 | 548657.3495 | 1342460.7992 |
| 21 | 331.606 | 548574.9420 | 1342498.8749 |
| 22 | 333.924 | 548573.7387 | 1342353.7679 |
| 23 | 334.343 | 548554.0505 | 1342346.6143 |
| 24 | 334.476 | 548534.2611 | 1342355.8389 |
| 25 | 333.829 | 548544.9420 | 1342378.9499 |
| 26 | 328.564 | 548544.9420 | 1342651.5630 |
| 27 | 326.132 | 548656.9420 | 1342763.5630 |
| 28 | 325.259 | 548767.4822 | 1342763.5630 |
| 29 | 325.398 | 548848.9164 | 1342706.1179 |
| 30 | 328.984 | 548882.0120 | 1342569.7681 |
| 31 | 331.024 | 548882.2869 | 1342517.3216 |
| 32 | 333.310 | 548856.6608 | 1342421.2509 |
| 33 | 335.441 | 548768.0423 | 1342352.2054 |
| 34 | 336.152 | 548638.4774 | 1342352.2395 |
| 35 | 336.010 | 548632.5350 | 1342367.2907 |
| 36 | 333.237 | 548619.7345 | 1342402.5202 |
| 37 | 328.637 | 548820.4024 | 1342573.3155 |
| 38 | 329.189 | 548852.6301 | 1342563.4585 |
| 39 | 330.265 | 548860.4338 | 1342535.4795 |
| 40 | 331.722 | 548860.6940 | 1342490.7430 |
| 41 | 333.617 | 548843.1331 | 1342424.8564 |
| 42 | 335.441 | 548766.1561 | 1342366.2049 |
| 43 | 329.857 | 548713.2561 | 1342560.2830 |
| 44 | 330.680 | 548608.3331 | 1342544.0392 |
| 45 | 325.847 | 548800.6908 | 1342691.1603 |

| Point Table | | | |
|-------------|-----------|-------------|--------------|
| Point # | Elevation | Northing | Easting |
| 46 | 326.572 | 548621.4265 | 1342724.3360 |
| 47 | 326.402 | 548632.6824 | 1342729.0733 |
| 48 | 329.979 | 548755.2154 | 1342544.0962 |
| 49 | 330.224 | 548746.0109 | 1342536.2619 |
| 50 | 330.033 | 548766.3405 | 1342527.3016 |
| 51 | 330.273 | 548757.1360 | 1342519.4674 |
| 52 | 333.906 | 548840.1524 | 1342415.8743 |
| 53 | 334.262 | 548833.9238 | 1342403.5475 |
| 54 | 330.977 | 548574.9420 | 1342531.4571 |
| 55 | 331.110 | 548574.9420 | 1342524.7983 |
| 56 | 331.410 | 548574.9420 | 1342509.7963 |
| 57 | 363.992 | 548375.6175 | 1341882.0668 |


| LINE TABLE: OTA3 - RETAINING WALL | | | |
|-----------------------------------|---------|---------|----------------------|
| NUMBER | LENGTH | RADIUS | LINE/CHORD DIRECTION |
| L15 | 42.52' | | N40° 24' 08.08"E |
| C10 | 19.15' | 22.85' | N64° 54' 41.25"E |
| L16 | 269.51' | | N90° 00' 00.00"E |
| C11 | 139.01' | 118.55' | N57° 46' 50.21"E |
| C12 | 53.16' | 133.68' | N13° 15' 47.48"E |
| L17 | 109.20' | | N00° 00' 01.79"E |
| C13 | 114.45' | 88.00' | N37° 15' 32.95"W |
| L18 | 140.24' | | N74° 31' 07.69"W |
| C16 | 57.31' | 108.00' | N89° 43' 17.57"W |
| L19 | 99.42' | | S75° 04' 32.54"W |
| C17 | 124.29' | 101.00' | S39° 49' 21.15"W |

| LINE TABLE: OTA3 DRIVEWAY ENTRANCE AND RIGHT DRIVEWAY | | | |
|---|---------|--------|----------------------|
| NUMBER | LENGTH | RADIUS | LINE/CHORD DIRECTION |
| L8 | 755.75' | | N40° 24' 08.08"E |
| L9 | 89.23' | | S74° 31' 07.69"E |
| C6 | 84.43' | 64.92' | S37° 15' 33.84"E |
| L10 | 109.10' | | S00° 00' 00.00"E |
| C7 | 154.41' | 99.25' | S45° 00' 00.00"W |
| L11 | 285.30' | | N90° 00' 00.00"W |

POINT OF BEGINNING:
STA. 1+00.0 N 548278.41, E 1342125.14

| LINE TABLE: OTA3 LEFT DRIVEWAY | | | |
|--------------------------------|---------|--------|----------------------|
| NUMBER | LENGTH | RADIUS | LINE/CHORD DIRECTION |
| L14 | 210.68' | | N00° 27' 55.98"W |
| C9 | 113.39' | 86.00' | N37° 18' 18.28"E |
| L13 | 85.79' | | N75° 04' 32.54"E |
| C8 | 45.11' | 85.00' | S89° 43' 17.57"E |
| L12 | 66.88' | | S74° 31' 07.69"E |

POINT OF BEGINNING:
STA. 4+63.8 N 548555.43, E 1342360.92

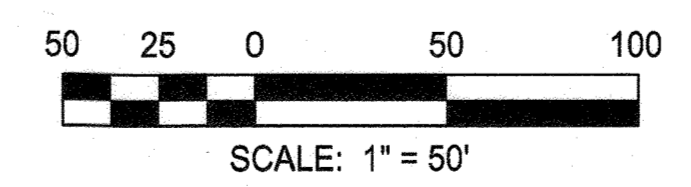

4 PURPOSE STATEMENT (11/1/23): DESIGN OF OUTDOOR TESTING AREA 3, INCLUDING THE SOURCE OF BORROW MATERIAL, REFERRED TO AS THE EAST AND WEST BORROW AREAS.

- LEGEND**
- LOD — LIMIT OF DISTURBANCE
 - PROP. 4' CHAIN LINK FENCE
 - PROP. GUARDRAIL
 - X — PROP. 10' SECURITY FENCE
 - SD — PROP. STORM DRAIN
 - UD — PROP. UNDERDRAIN
 - FCE — EXISTING FOREST CONSERVATION EASEMENT
 - WB — EXISTING WETLAND BUFFER
 - SB — EXISTING STREAM BUFFER

APPROVED: DEPARTMENT OF PLANNING AND ZONING
 Chief, Development Engineering Division
 Date: 12-5-23
 Chief, Division of Land Development
 Date: 2/22/24

RK&K
 RUMMEL, KLEPPER & KAHL, LLP
 PROFESSIONAL ENGINEERS AND ARCHITECTS
 700 East Pratt Street, Suite 500
 Baltimore, MD 21202
 Ph: 410.728.2900 Contact: Matt Thomason
 www.rk&k.com



DESIGN BY: SHK
 DRAWN BY: JMS/DTP
 CHECKED BY: CWWW
 DATE: 11/1/2023

| BY | NO. | REVISION | DATE |
|----|-----|---|---------|
| | | New Sheet - OTA-3 and Borrow Area Modifications | 11/1/23 |

OWNER/DEVELOPER
JOHNS HOPKINS APPLIED PHYSICS LABORATORY
 11100 JOHNS HOPKINS ROAD
 LAUREL, MARYLAND 20723

LAYOUT PLAN - OTA 3 (PHASE 2)
 JOHNS HOPKINS UNIVERSITY - APPLIED PHYSICS LABORATORY
OUTDOOR TESTING AREAS
 11100 JOHNS HOPKINS ROAD
 TAX MAP: 41 PARCEL: 123 GRID: 16 ZONED: PEC
 ELECTION DISTRICT: 5 HOWARD COUNTY, MARYLAND
 SHEET 09 OF 73

C-206
 RK&K PROJECT NUMBER 21047.013
 SCALE: As Shown

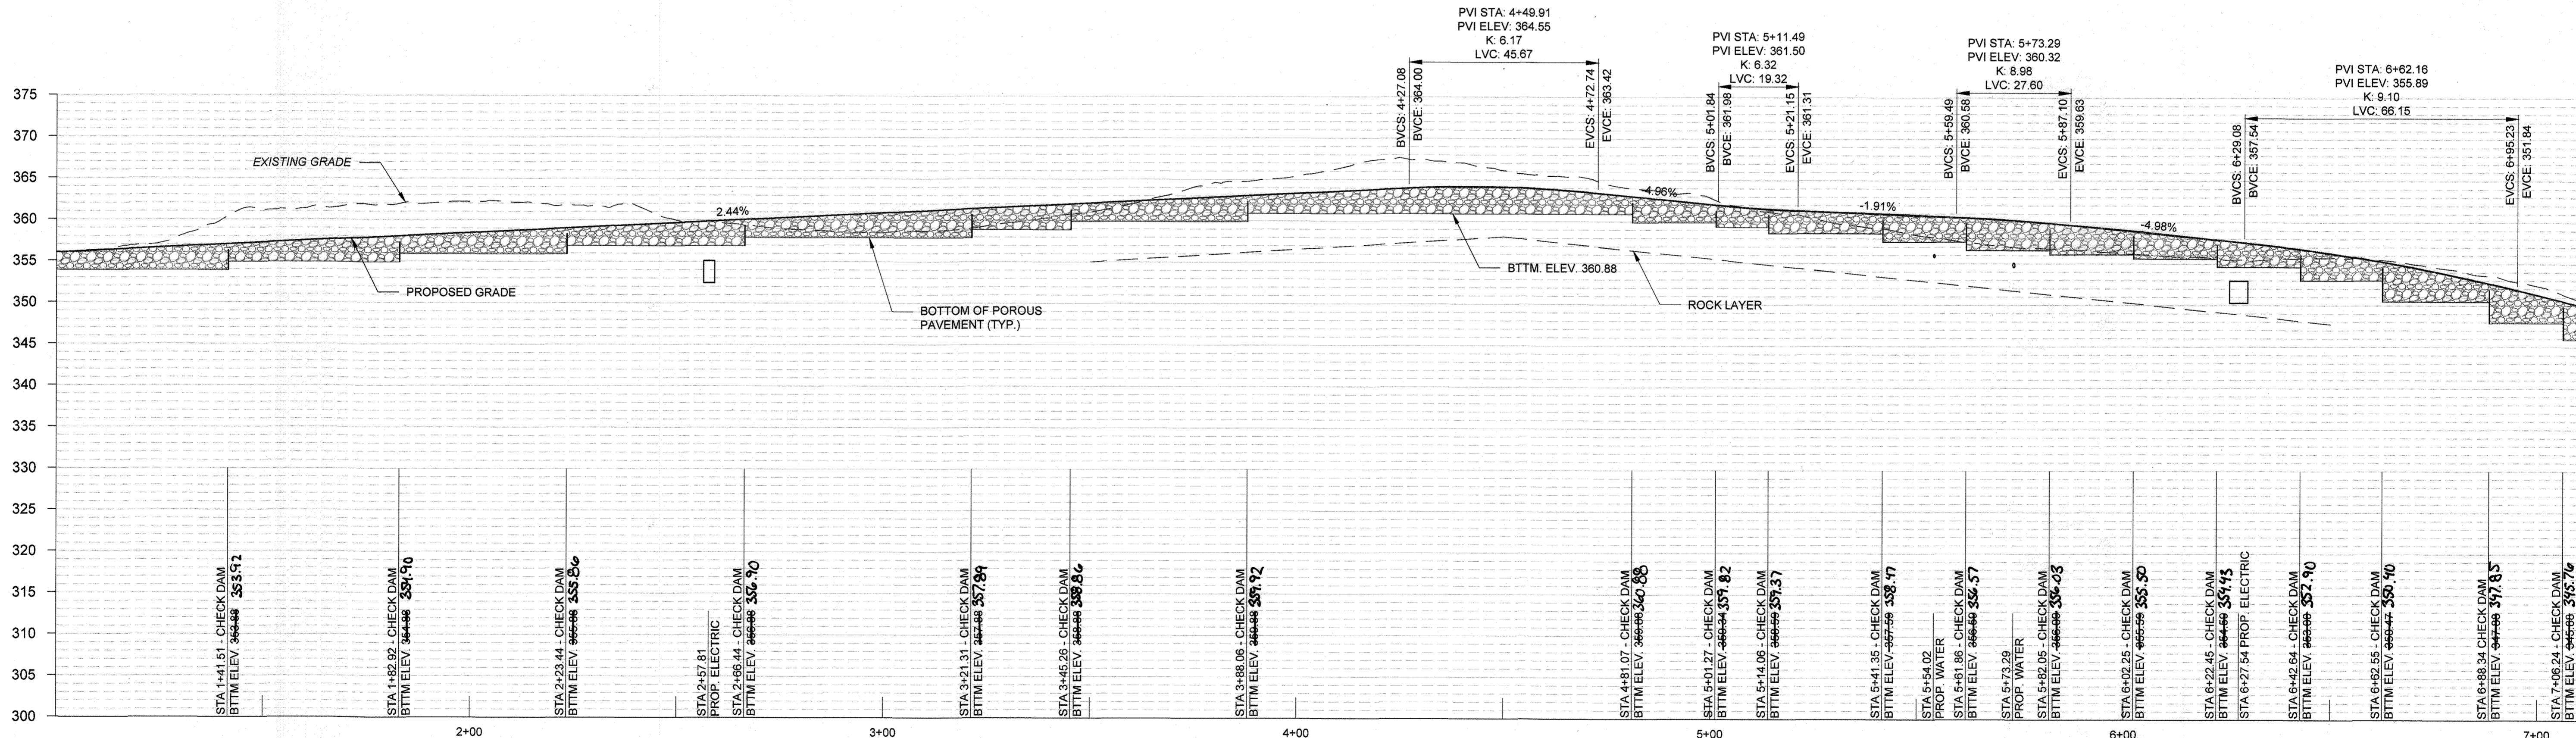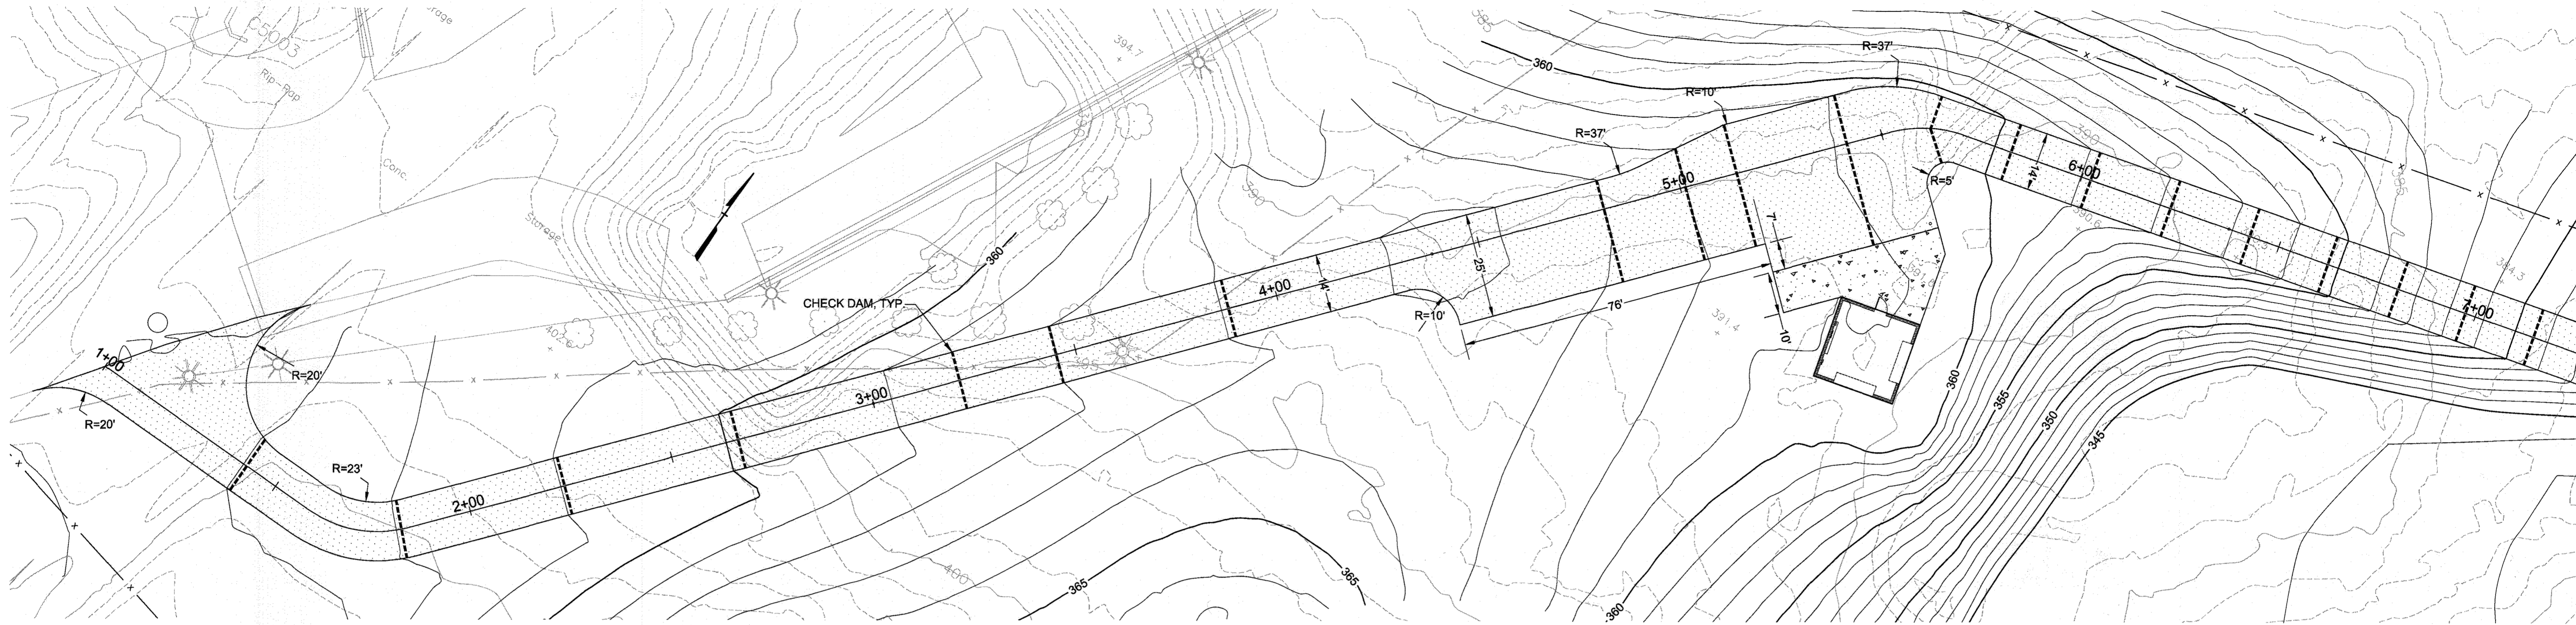



NOTES

- FOR POROUS PAVEMENT & CHECK DAM DETAILS, NOTES AND SPECIFICATIONS SEE SHEETS C-501 THROUGH C-506.
- FOR ROADWAY AND NON POROUS PAVING SECTIONS SEE SHEET C-215.
- FOR UNDERDRAIN LOCATIONS SEE SHEET C-501.

OTA-1 ROADWAY PROFILE
SCALE: HORIZ. 1" = 20'
VERT. 1" = 10'




AS-BUILT CERTIFICATION
I hereby certify, by my seal, that to the best of my knowledge and belief the facilities shown on this plan were constructed as shown on this "AS-BUILT" plan meet the Approved Plans and Specifications.
Charles W. W. Mitchell, PE #49932, 02/14/23

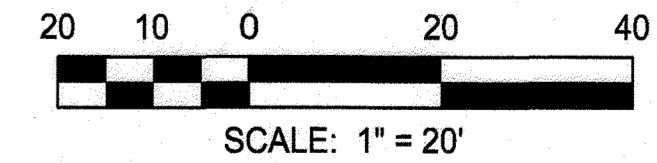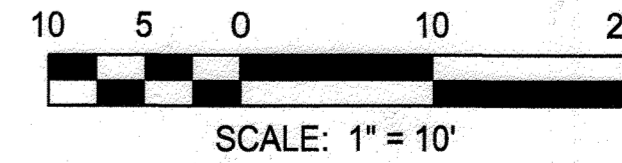

APPROVED: DEPARTMENT OF PLANNING AND ZONING
Chief, Development Engineering Division
 Date: 9-21-18
Chief, Division of Land Development
 Date: 9-25-18
Director
 Date: 9-20-18



PROFESSIONAL CERTIFICATION: I HEREBY CERTIFY THAT THESE DOCUMENTS WERE PREPARED OR APPROVED BY ME, AND THAT I AM A DULY LICENSED PROFESSIONAL ENGINEER UNDER THE LAWS OF THE STATE OF MARYLAND, LICENSE NO. 23012, EXPIRATION DATE: MARCH 6, 2019.

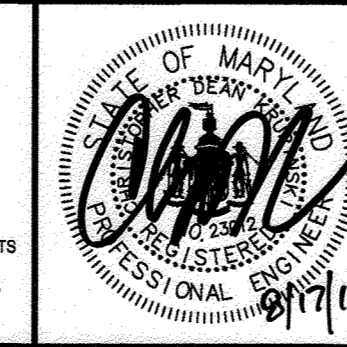

DESIGN BY: CWWW
 DRAWN BY: CWWW
 CHECKED BY: CDK
 DATE: 8/17/18


| BY | NO. | REVISION | DATE |
|----|-----|----------|------|
| | | | |

OWNER/DEVELOPER
JOHNS HOPKINS APPLIED PHYSICS LABORATORY
 11100 JOHNS HOPKINS ROAD
 LAUREL, MARYLAND 20723


ROADWAY PROFILES - OTA 1 (PHASE 1)
 AS-BUILT
 JOHNS HOPKINS UNIVERSITY - APPLIED PHYSICS LABORATORY
OUTDOOR TESTING AREAS
 11100 JOHNS HOPKINS ROAD
 TAX MAP: 41 PARCEL: 123 GRID: 18 ZONED: PEC
 ELECTION DISTRICT 5 - HOWARD COUNTY, MARYLAND
 SHEET 10 OF 23

C-207
 RK&K PROJECT NUMBER 17152
 SCALE: As Shown

MATCHLINE STA. 7+10
 FOR CONTINUATION SEE SHEET C-208

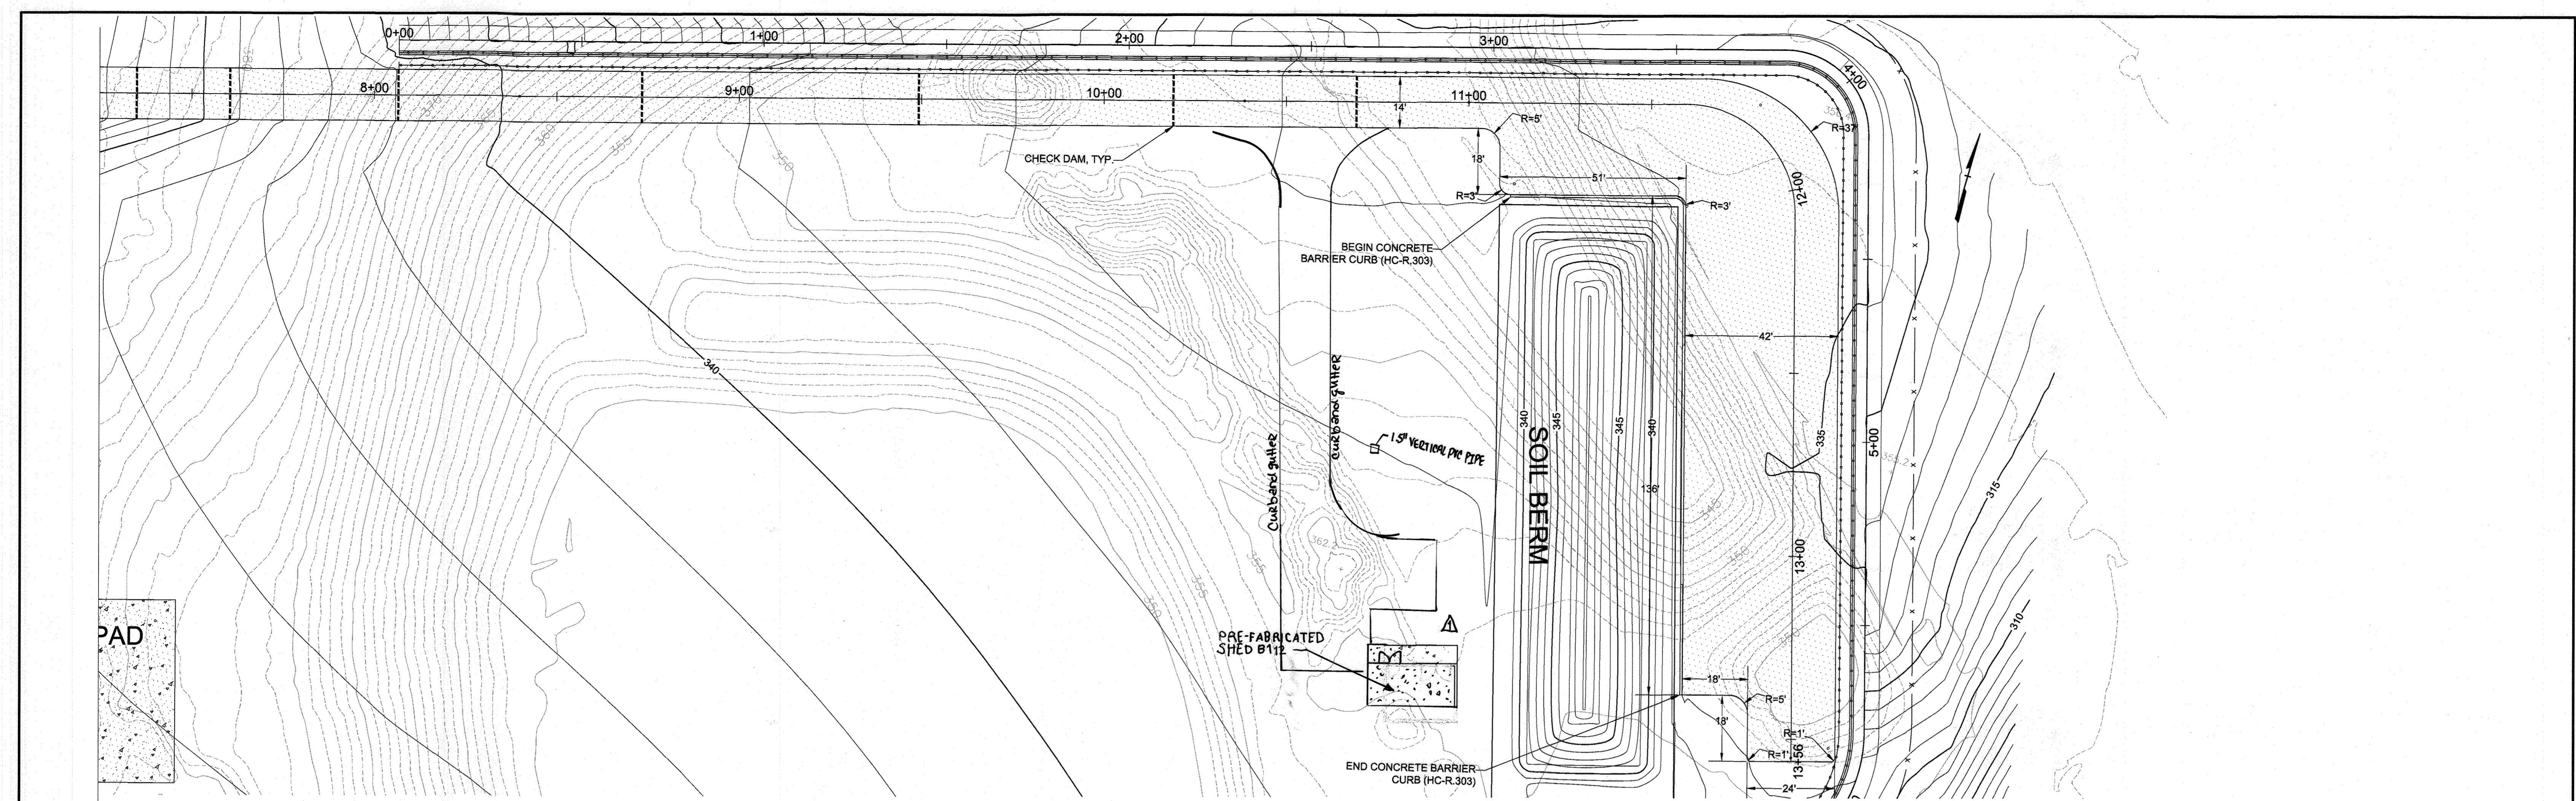

MATCHLINE STA. 7+10 FOR CONTINUATION SEE SHEET C-207

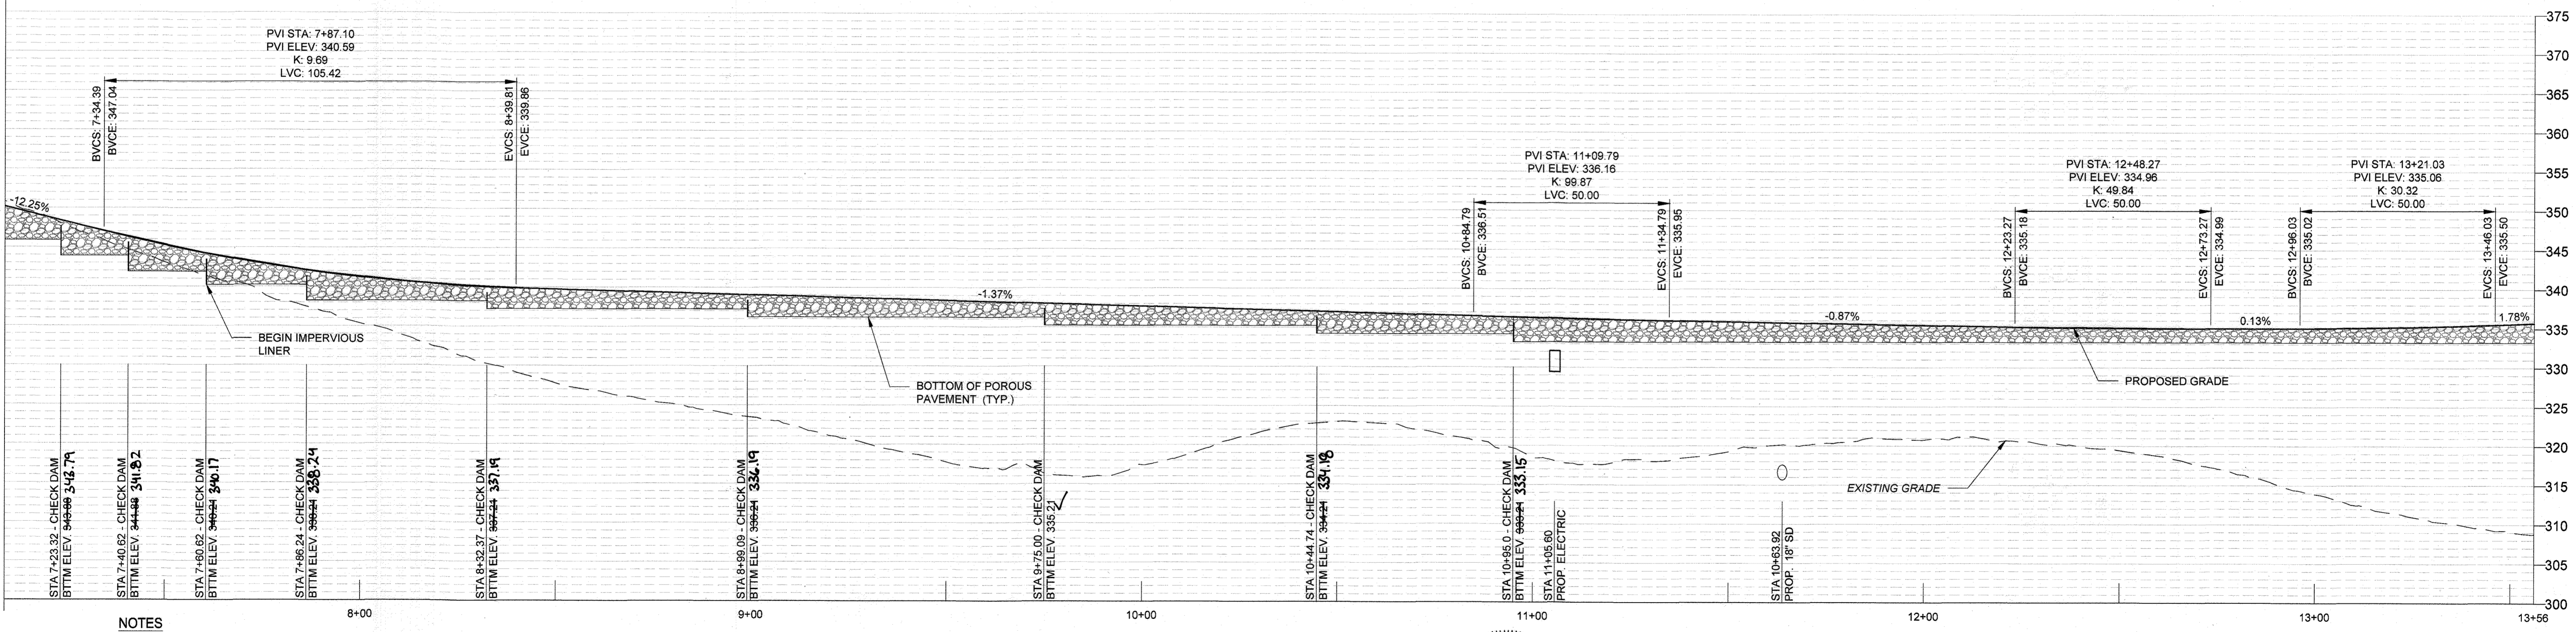

NOTES

- FOR POROUS PAVEMENT & CHECK DAM DETAILS, NOTES AND SPECIFICATIONS SEE SHEETS C-501 THROUGH C-506.
- FOR ROADWAY AND NON POROUS PAVING SECTIONS SEE SHEET C-215.
- FOR UNDERDRAIN LOCATIONS SEE SHEET C-501.



Purpose Statement (9/10/19): This red line submission adjusts the configuration of the proposed shed at OTA 1. Changes to utilities are also required and identified under this revision.

OTA-1 ROADWAY PROFILE

SCALE: HORIZ. 1" = 20'
VERT. 1" = 10'




AS-BUILT CERTIFICATION
I hereby certify, by my seal, that to the best of my knowledge and belief the facilities shown on this plan were constructed as shown on this "AS-BUILT" plan meet the Approved Plans and Specifications.
Charles W. W. Mitchell, PE #19432, 02/19/23

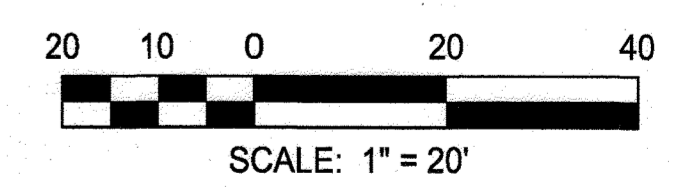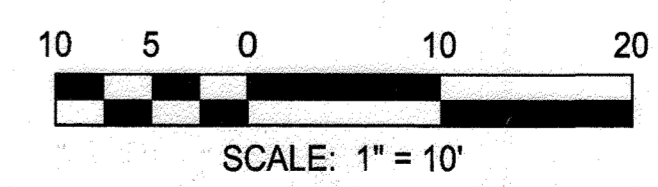

APPROVED: DEPARTMENT OF PLANNING AND ZONING
Chad R. ...
 Chief, Development Engineering Division
 Date: 9-21-18
T. ...
 Chief, Division of Land Development
 Date: 9-25-18
...
 Director
 Date: 9-26-18



PROFESSIONAL CERTIFICATION I HEREBY CERTIFY THAT THESE DOCUMENTS WERE PREPARED OR APPROVED BY ME, AND THAT I AM A DULY LICENSED PROFESSIONAL ENGINEER UNDER THE LAWS OF THE STATE OF MARYLAND, LICENSE NO. 22012, EXPIRATION DATE: MARCH 6, 2019.


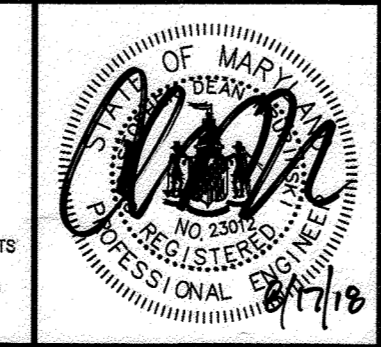


| | | | |
|--------------------|------|------------------------|---------|
| DESIGN BY: CWMM | AK&K | SHED LOCATION REVISION | 9/10/19 |
| DRAWN BY: CWMM | | | |
| CHECKED BY: CDK | | | |
| DATE: 8/17/18 | | | |
| BY | NO. | REVISION | DATE |

OWNER/DEVELOPER
JOHNS HOPKINS APPLIED PHYSICS LABORATORY
 11100 JOHNS HOPKINS ROAD
 LAUREL, MARYLAND 20723

ROADWAY PROFILES - OTA 1 (PHASE 1)
 AS-BUILT
 JOHNS HOPKINS UNIVERSITY - APPLIED PHYSICS LABORATORY
OUTDOOR TESTING AREAS
 11100 JOHNS HOPKINS ROAD
 TAX MAP: 41 PARCEL: 123 GRID: 18 ZONED: PEC
 ELECTION DISTRICT 5 - HOWARD COUNTY, MARYLAND
 SHEET 11 OF 73

C-208
 RK&K PROJECT NUMBER 17152
 SCALE: As Shown

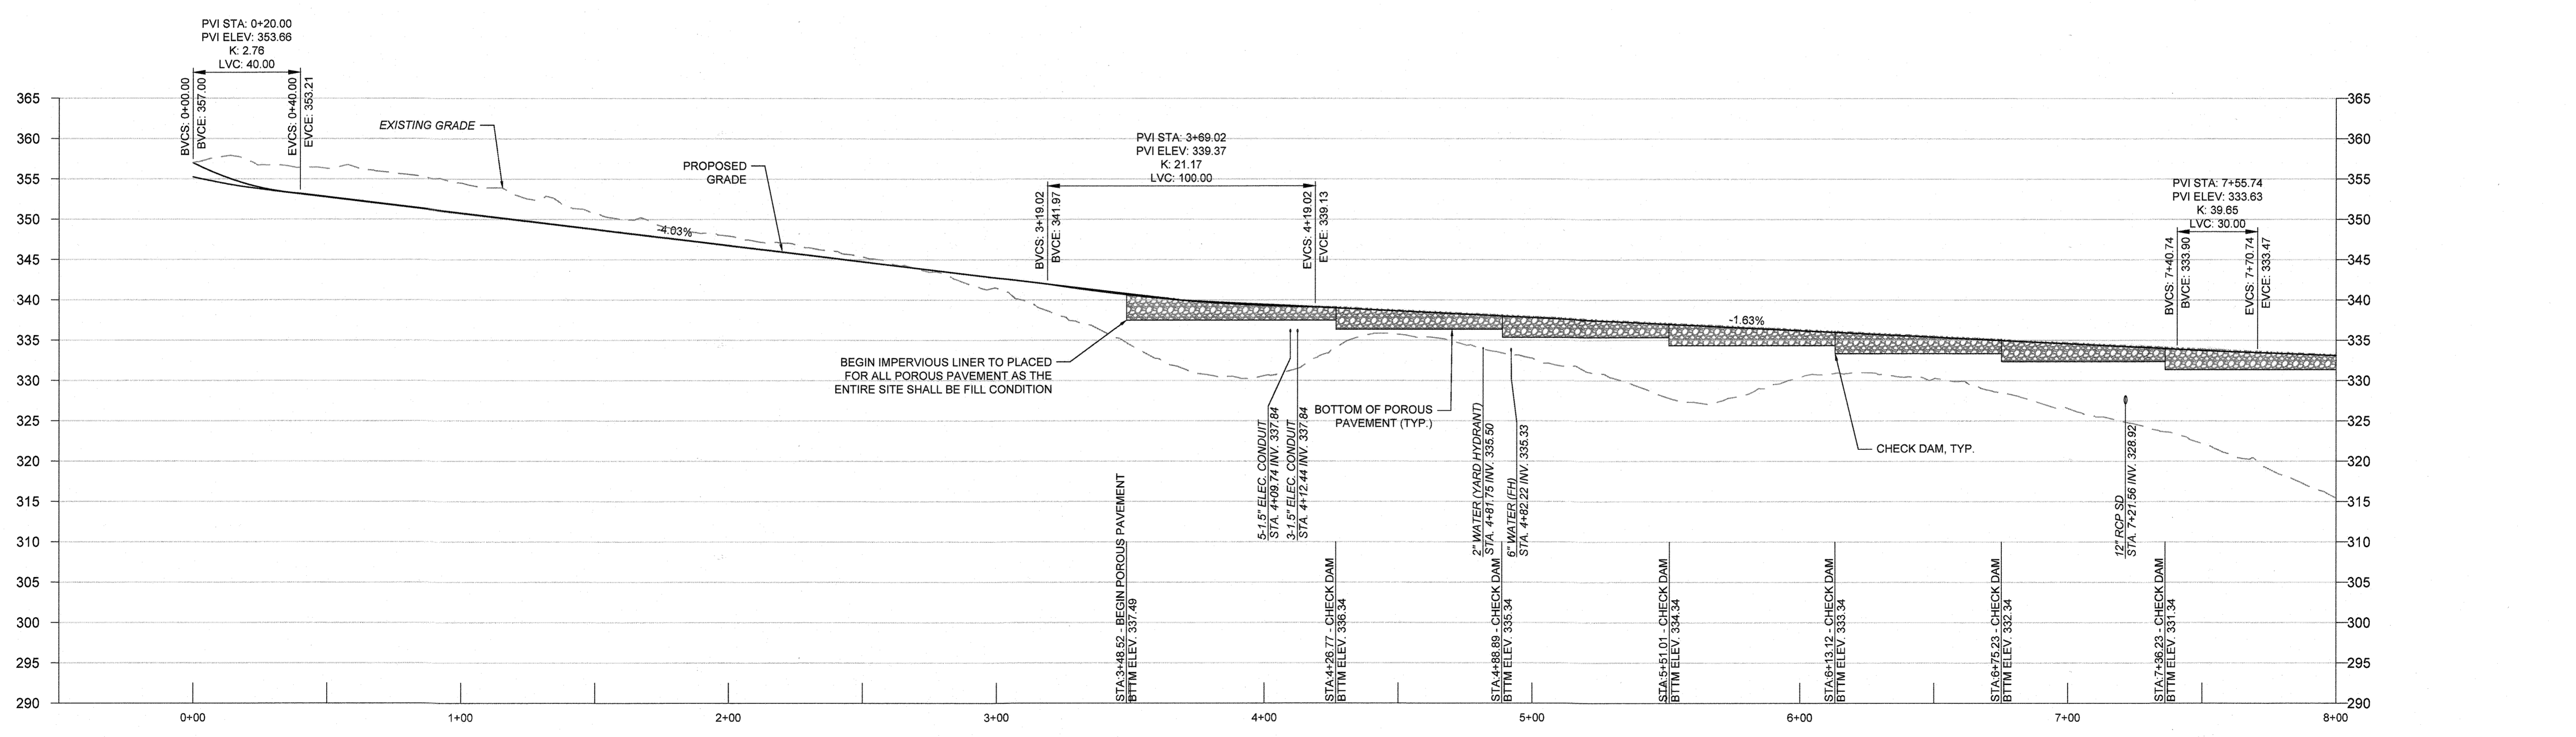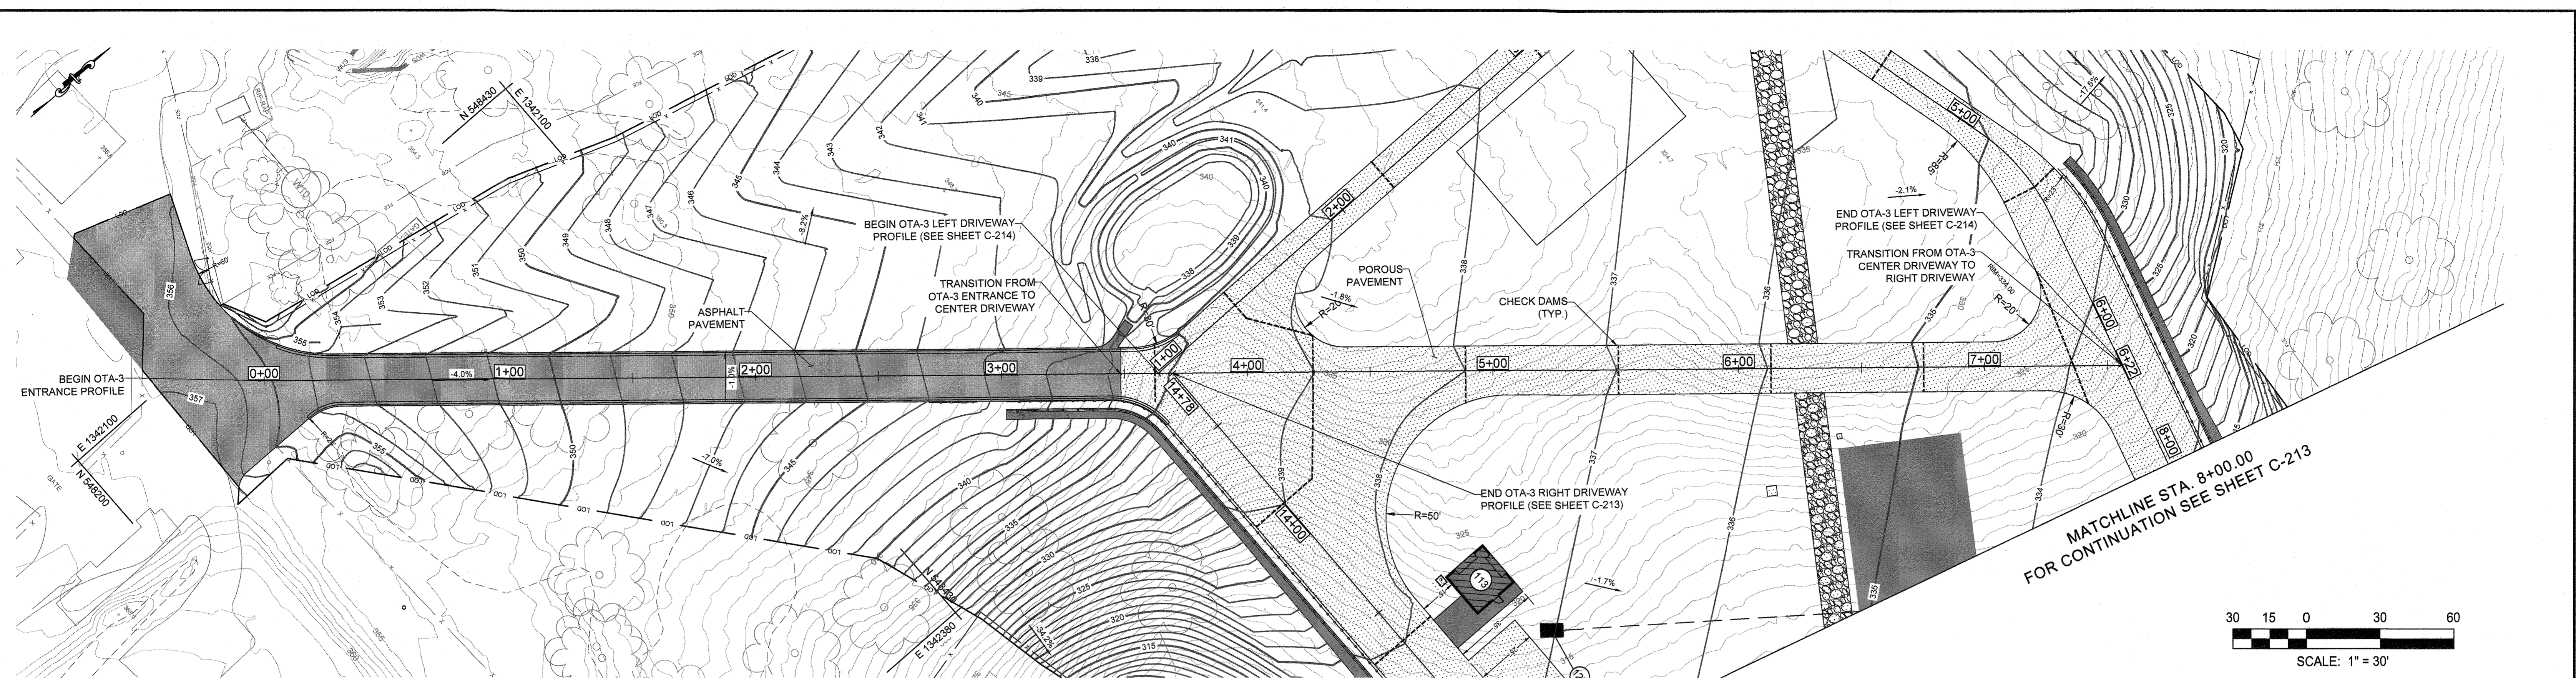

- NOTES**
1. FOR POROUS PAVEMENT & CHECK DAM DETAILS, NOTES AND SPECIFICATIONS SEE SHEETS C-501 THROUGH C-506.
 2. FOR ROADWAY AND NON POROUS PAVING SECTIONS SEE SHEET C-215.
 3. FOR UNDERDRAIN LOCATIONS SEE SHEET C-503.
 4. FOR LEGEND SEE SHEET C-203.


OTA-3 ENTRANCE AND CENTER DRIVEWAY PROFILE

SCALE: HORIZ. 1" = 30'
VERT. 1" = 10'

PURPOSE STATEMENT (11/1/23): DESIGN OF OUTDOOR TESTING AREA 3, INCLUDING THE SOURCE OF BORROW MATERIAL, REFERRED TO AS THE EAST AND WEST BORROW AREAS.

APPROVED: DEPARTMENT OF PLANNING AND ZONING
[Signature]
 Chief, Development Engineering Division
 Date: 12-5-23
 2/22/24
 2/22/24

RK&K
 RUMMEL, KLEPPER & KAHL, LLP
 ENGINEERS/CONSTRUCTION MANAGERS/PLANNERS/SCIENTISTS
 RESPONSIVE PEOPLE • CREATIVE SOLUTIONS
 700 East Pratt Street, Suite 500
 Baltimore, MD 21202
 Ph: 410.728.2200 Contact: Matt Thomason
 www.rkk.com





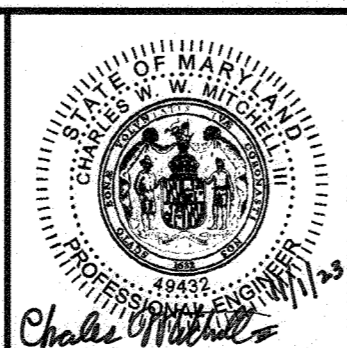


| | | | | | |
|-------------|-----------|------|-----|---|---------|
| DESIGN BY: | SHK | RK&K | 4 | New Sheet - OTA-3 and Borrow Area Modifications | 11/1/23 |
| DRAWN BY: | JMS/DTP | | | | |
| CHECKED BY: | CWWM | | | | |
| DATE: | 11/1/2023 | BY | NO. | REVISION | DATE |

OWNER/DEVELOPER
JOHNS HOPKINS APPLIED PHYSICS LABORATORY
 11100 JOHNS HOPKINS ROAD
 LAUREL, MARYLAND 20723

ROADWAY PROFILES - OTA 3 (PHASE 2)
 JOHNS HOPKINS UNIVERSITY - APPLIED PHYSICS LABORATORY
OUTDOOR TESTING AREAS
 11100 JOHNS HOPKINS ROAD
 TAX MAP: 41 PARCEL: 123 GRID: 16 ZONED: PEG
 ELECTION DISTRICT 5 - HOWARD COUNTY, MARYLAND
 SHEET 12 OF 73

C-212
 RK&K PROJECT NUMBER 21047.013
 SCALE: As Shown

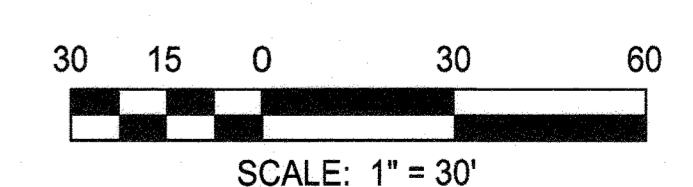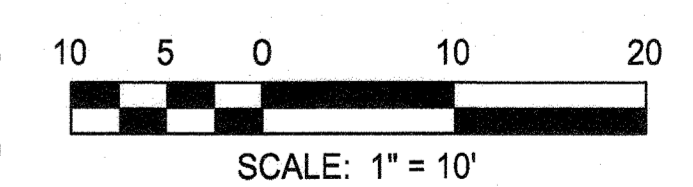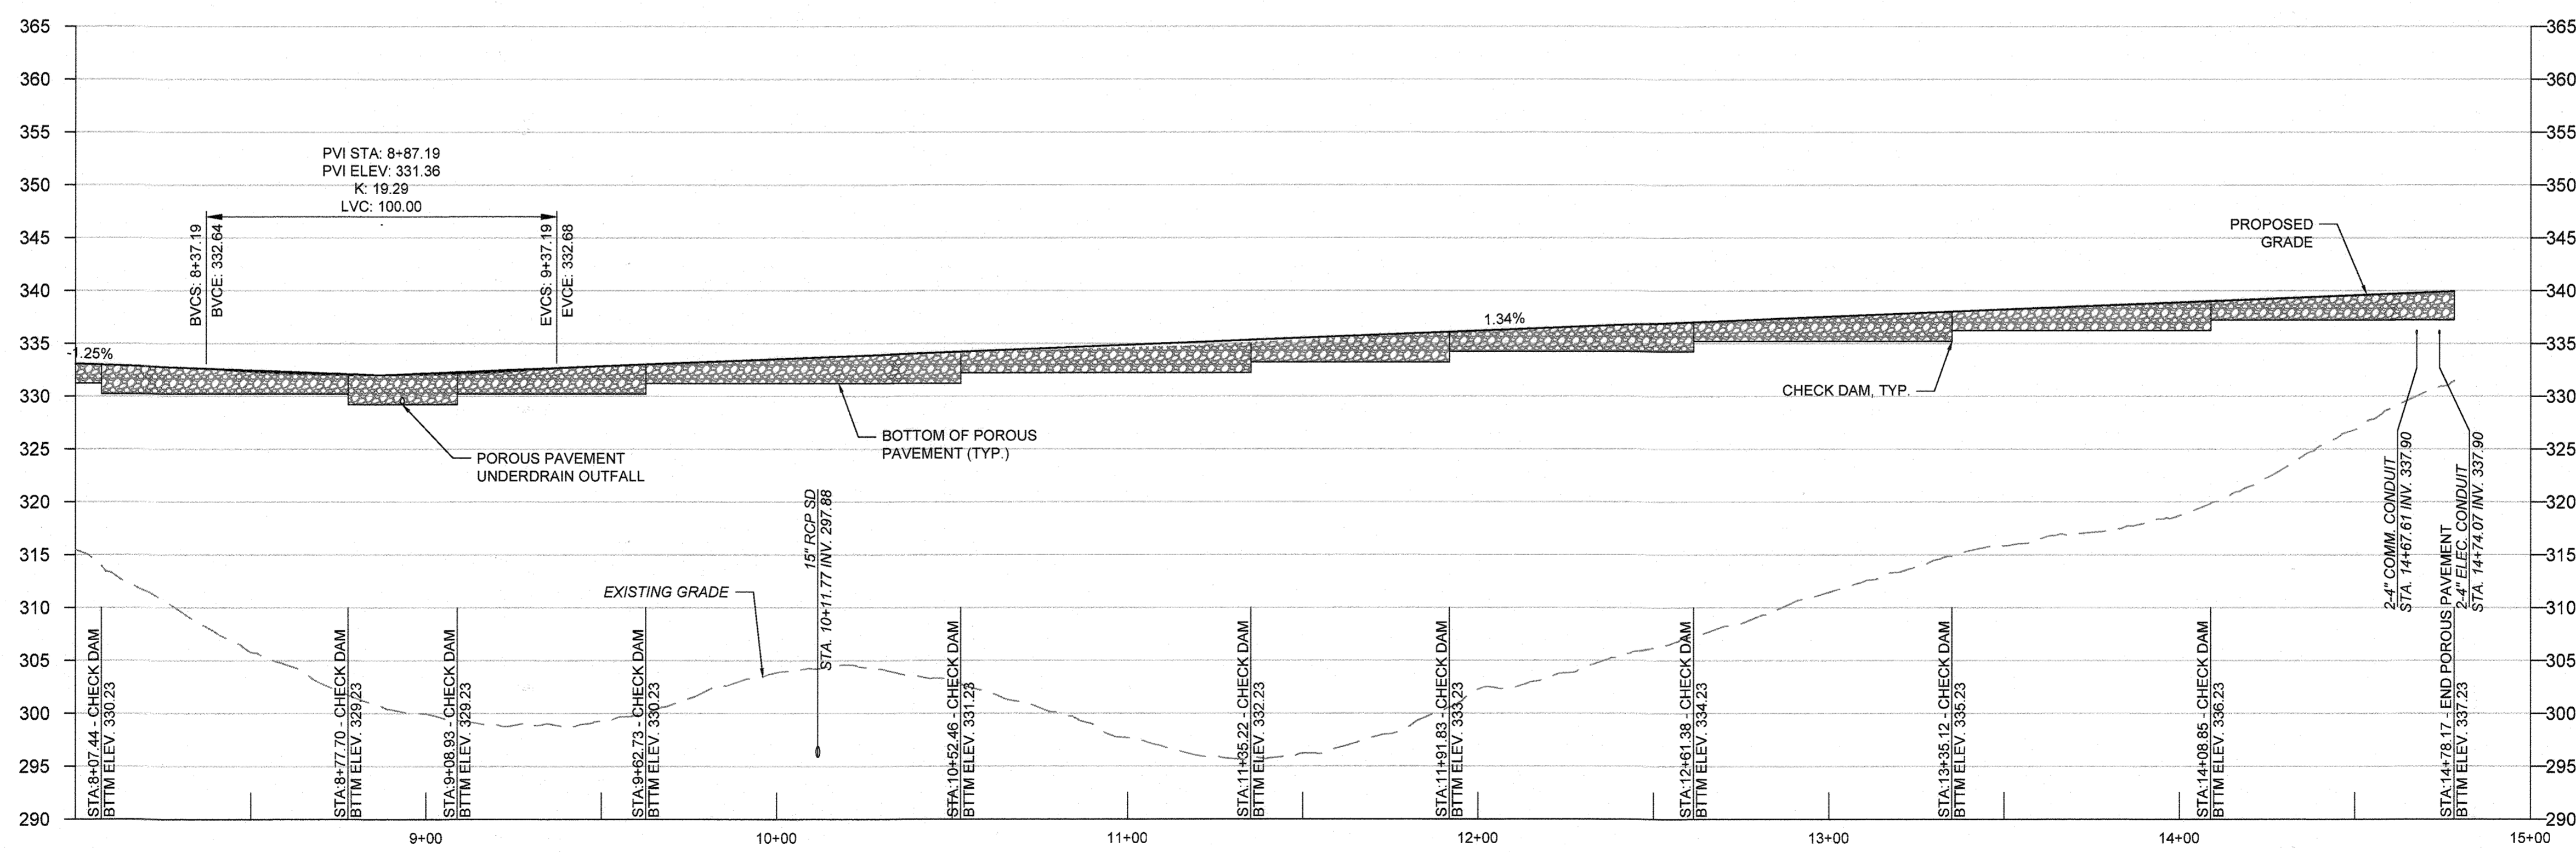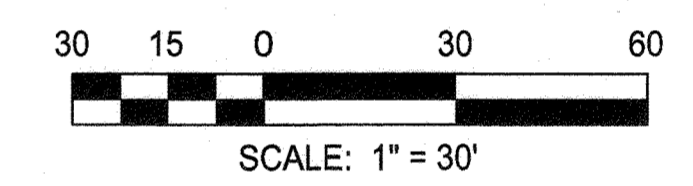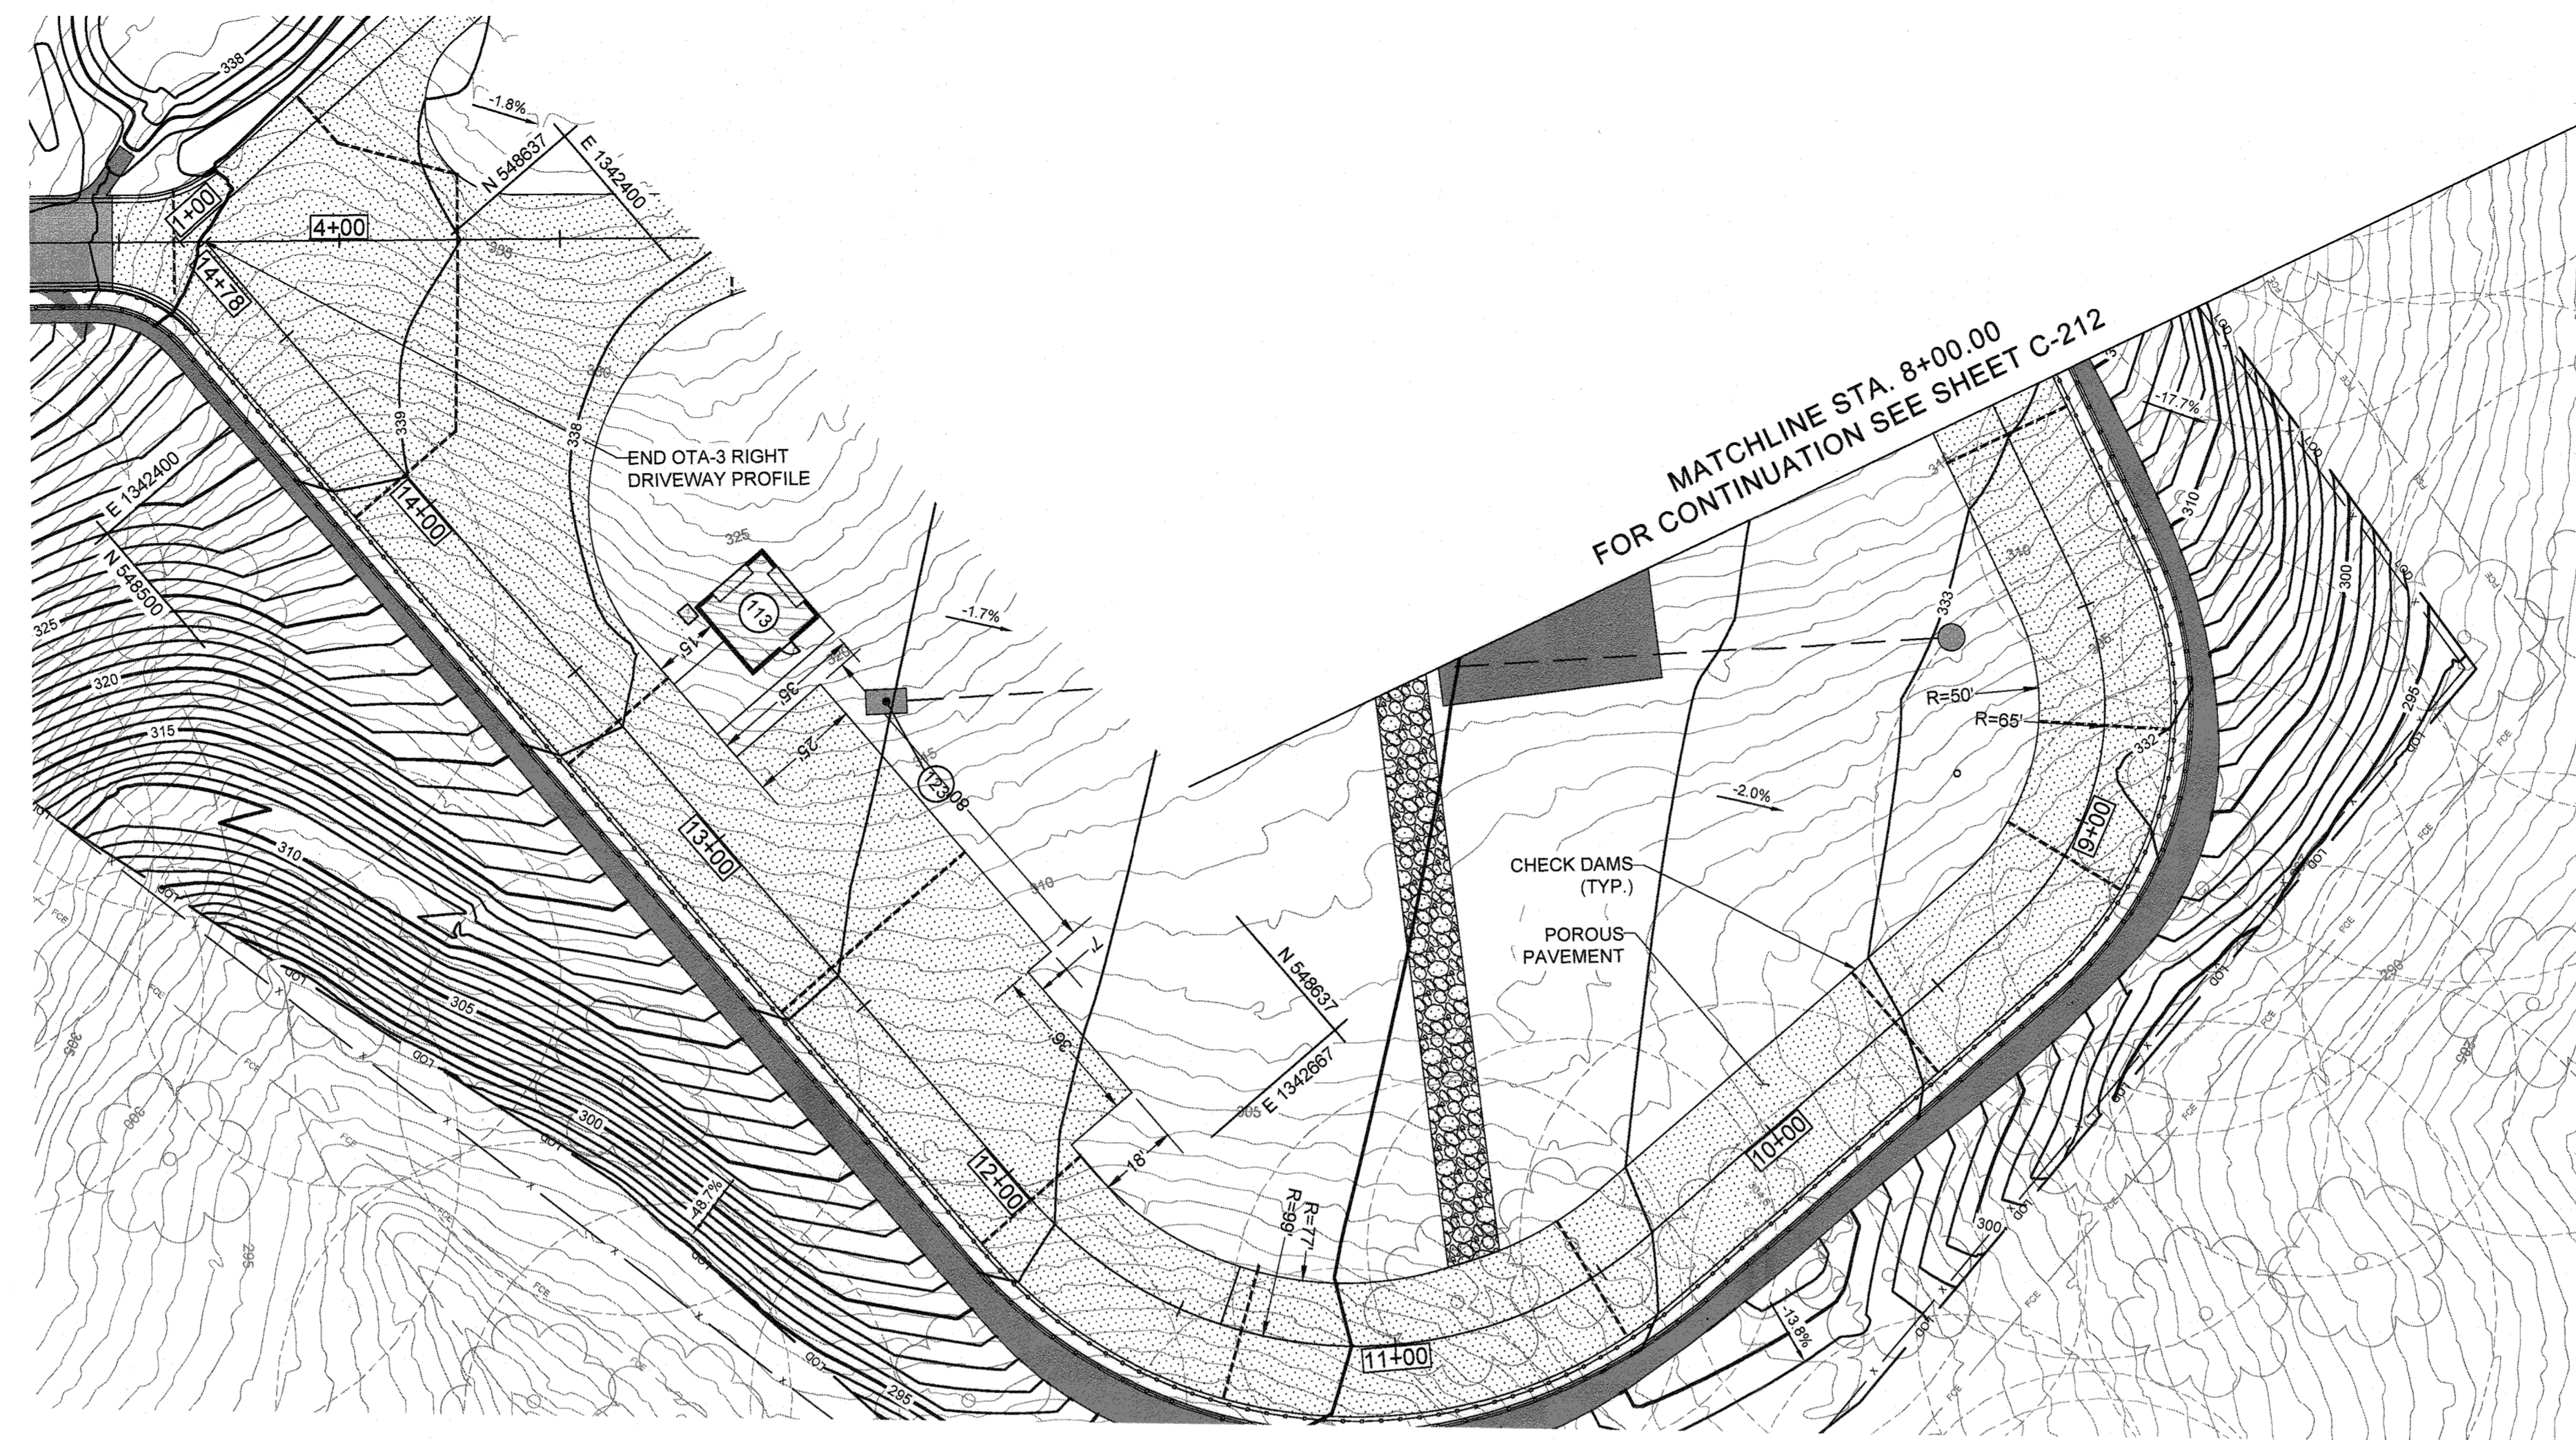

NOTES

- FOR POROUS PAVEMENT & CHECK DAM DETAILS, NOTES AND SPECIFICATIONS SEE SHEETS C-501 THROUGH C-506.
- FOR ROADWAY AND NON POROUS PAVING SECTIONS SEE SHEET C-215.
- FOR UNDERDRAIN LOCATIONS SEE SHEET C-503.
- FOR LEGEND SEE SHEET C-203.

OTA-3 RIGHT DRIVEWAY PROFILE

SCALE: HORIZ. 1" = 30'
VERT. 1" = 10'

△ PURPOSE STATEMENT (11/1/23): DESIGN OF OUTDOOR TESTING AREA 3, INCLUDING THE SOURCE OF BORROW MATERIAL REFERRED TO AS THE EAST AND WEST BORROW AREAS.

APPROVED: DEPARTMENT OF PLANNING AND ZONING
 Chief, Development Engineering Division
 Date: 12-5-23
 Chief, Division of Land Development
 Date: 2/22/24



PROFESSIONAL CERTIFICATION: I HEREBY CERTIFY THAT THESE DOCUMENTS WERE PREPARED OR APPROVED BY ME AND THAT I AM A DULY LICENSED PROFESSIONAL ENGINEER UNDER THE LAWS OF THE STATE OF MARYLAND, LICENSE NO. 46432, EXPIRATION DATE: MAY 31, 2024.





| | | | | | |
|-------------|-----------|------|-----|---|---------|
| DESIGN BY: | SHK | RK&K | 4 | New Sheet - OTA-3 and Borrow Area Modifications | 11/1/23 |
| DRAWN BY: | JMS/DTP | | | | |
| CHECKED BY: | CWWM | | | | |
| DATE: | 11/1/2023 | BY | NO. | REVISION | DATE |


OWNER/DEVELOPER
JOHNS HOPKINS APPLIED PHYSICS LABORATORY
 11100 JOHNS HOPKINS ROAD
 LAUREL, MARYLAND 20723

ROADWAY PROFILES - OTA 3 (PHASE 2)
 JOHNS HOPKINS UNIVERSITY - APPLIED PHYSICS LABORATORY
OUTDOOR TESTING AREAS
 11100 JOHNS HOPKINS ROAD
 TAX MAP: 41 PARCEL: 123 GRID: 16 ZONED: PEC
 ELECTION DISTRICT 5 HOWARD COUNTY, MARYLAND
 SHEET 13 OF 73

C-213
 RK&K PROJECT NUMBER 21047.013
 SCALE: As Shown

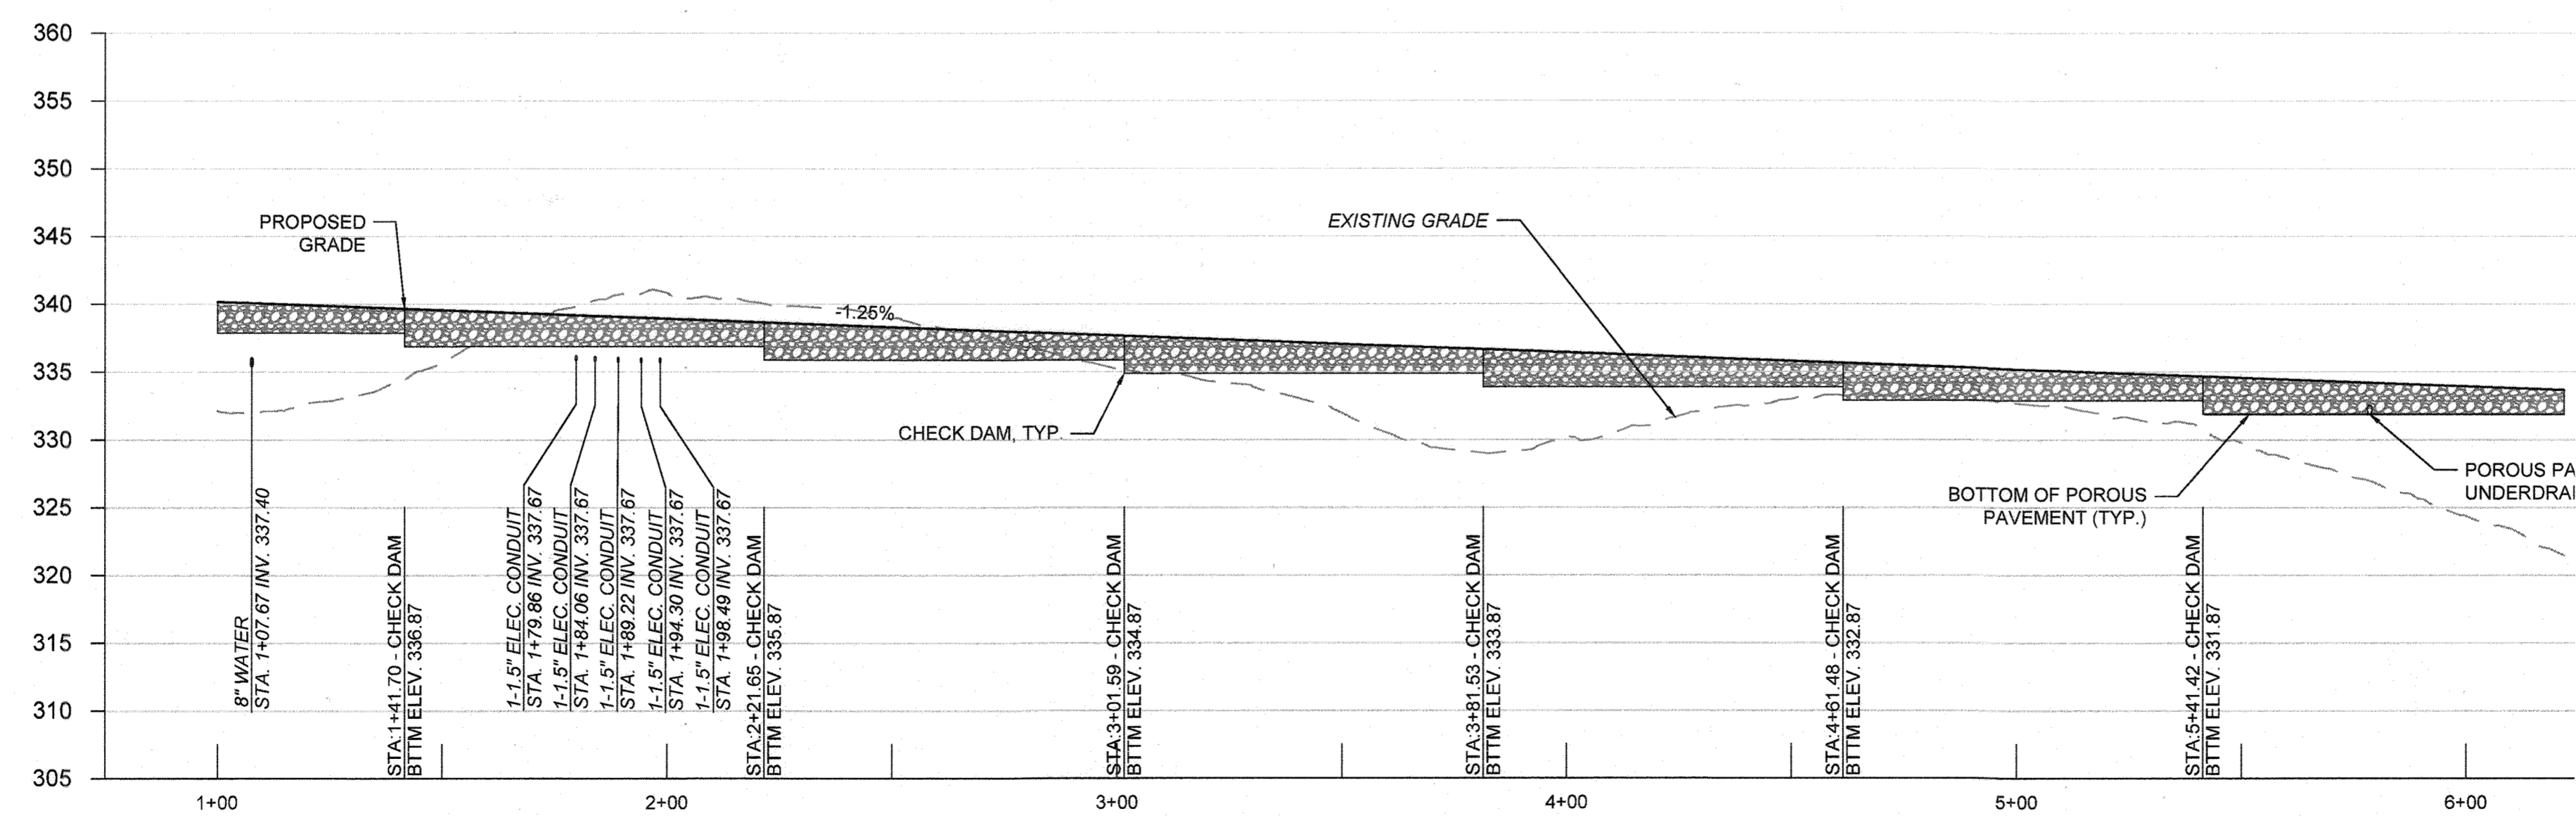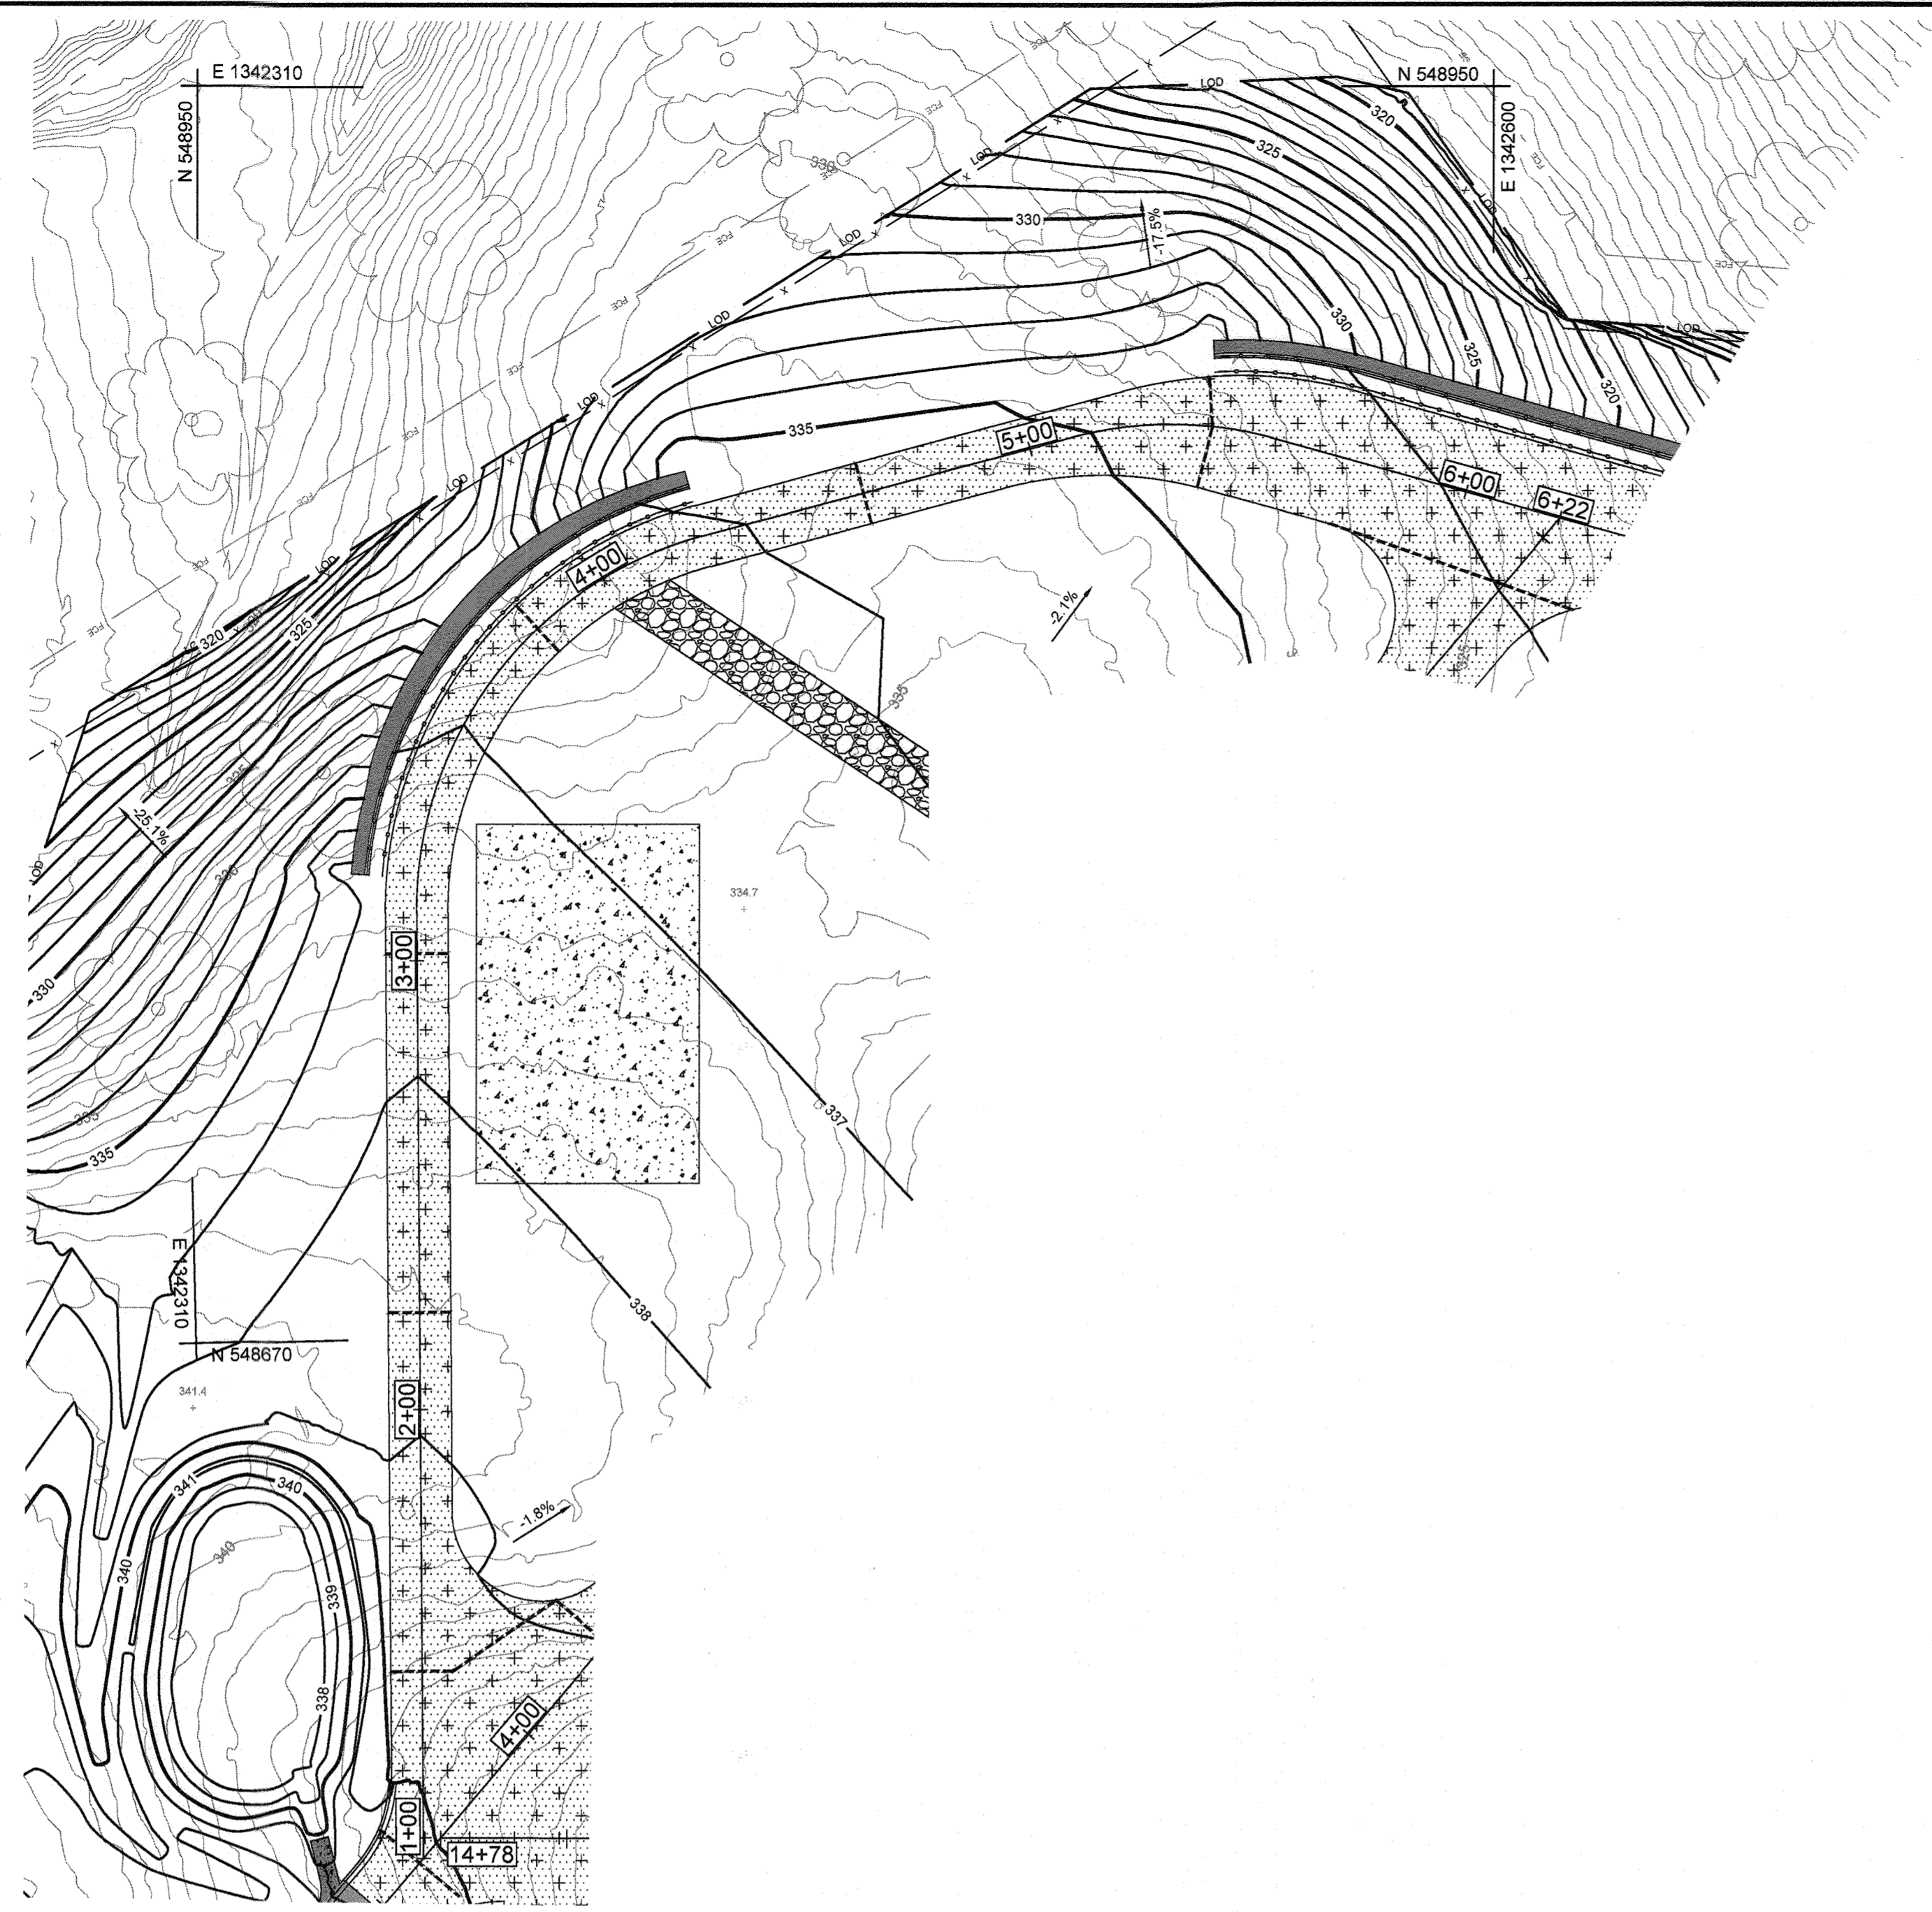

OTA-3 LEFT DRIVEWAY PROFILE
 SCALE: HORIZ 1" = 30'
 VERT. 1" = 10'

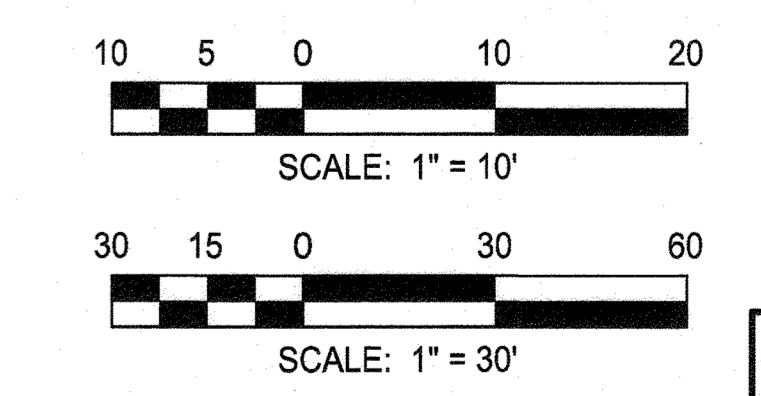

PURPOSE STATEMENT (11/1/23): DESIGN OF OUTDOOR TESTING AREA 3, INCLUDING THE SOURCE OF BORROW MATERIAL, REFERRED TO AS THE EAST AND WEST BORROW AREAS.

- NOTES**
- FOR POROUS PAVEMENT & CHECK DAM DETAILS, NOTES AND SPECIFICATIONS SEE SHEETS C-501 THROUGH C-506.
 - FOR ROADWAY AND NON POROUS PAVING SECTIONS SEE SHEET C-215.
 - FOR UNDERDRAIN LOCATIONS SEE SHEET C-503.
 - FOR LEGEND SEE SHEET C-203.

APPROVED: DEPARTMENT OF PLANNING AND ZONING
 Chief, Development Engineering Division
 Date: 12-5-23
 Chief, Division of Land Development
 Date: 2/22/24

RK&K
 RUMMEL, KLEPPER & KAHL, LLP
 700 East Pratt Street, Suite 500
 Baltimore, MD 21202
 Ph: 410.728.2800 Contact: Matt Thomsson www.rk&k.com


PROFESSIONAL CERTIFICATION: I HEREBY CERTIFY THAT THESE DOCUMENTS WERE PREPARED OR APPROVED BY ME, AND THAT I AM A DULY LICENSED PROFESSIONAL ENGINEER UNDER THE LAWS OF THE STATE OF MARYLAND. LICENSE NO. 46432, EXPIRATION DATE: MAY 31, 2024.

| | | | | |
|-------------------|------|-----|---|---------|
| DESIGN BY: SHK | RK&K | △ | New Sheet - OTA-3 and Borrow Area Modifications | 11/1/23 |
| DRAWN BY: JMS/DTP | | | | |
| CHECKED BY: CWWW | | | | |
| DATE: 11/1/2023 | BY | NO. | REVISION | DATE |


OWNER/DEVELOPER
 JOHNS HOPKINS UNIVERSITY
 APPLIED PHYSICS LABORATORY
 11100 JOHNS HOPKINS ROAD
 LAUREL, MARYLAND 20723

ROADWAY PROFILES - OTA 3 (PHASE 2)
 JOHNS HOPKINS UNIVERSITY - APPLIED PHYSICS LABORATORY
OUTDOOR TESTING AREAS
 11100 JOHNS HOPKINS ROAD
 TAX MAP: 41 PARCEL: 123 GRID: 18 ZONED: PEC
 ELECTION DISTRICT 5 - HOWARD COUNTY, MARYLAND
 SHEET 14 OF 73


C-214
 RK&K PROJECT NUMBER 21047.013
 SCALE: As Shown

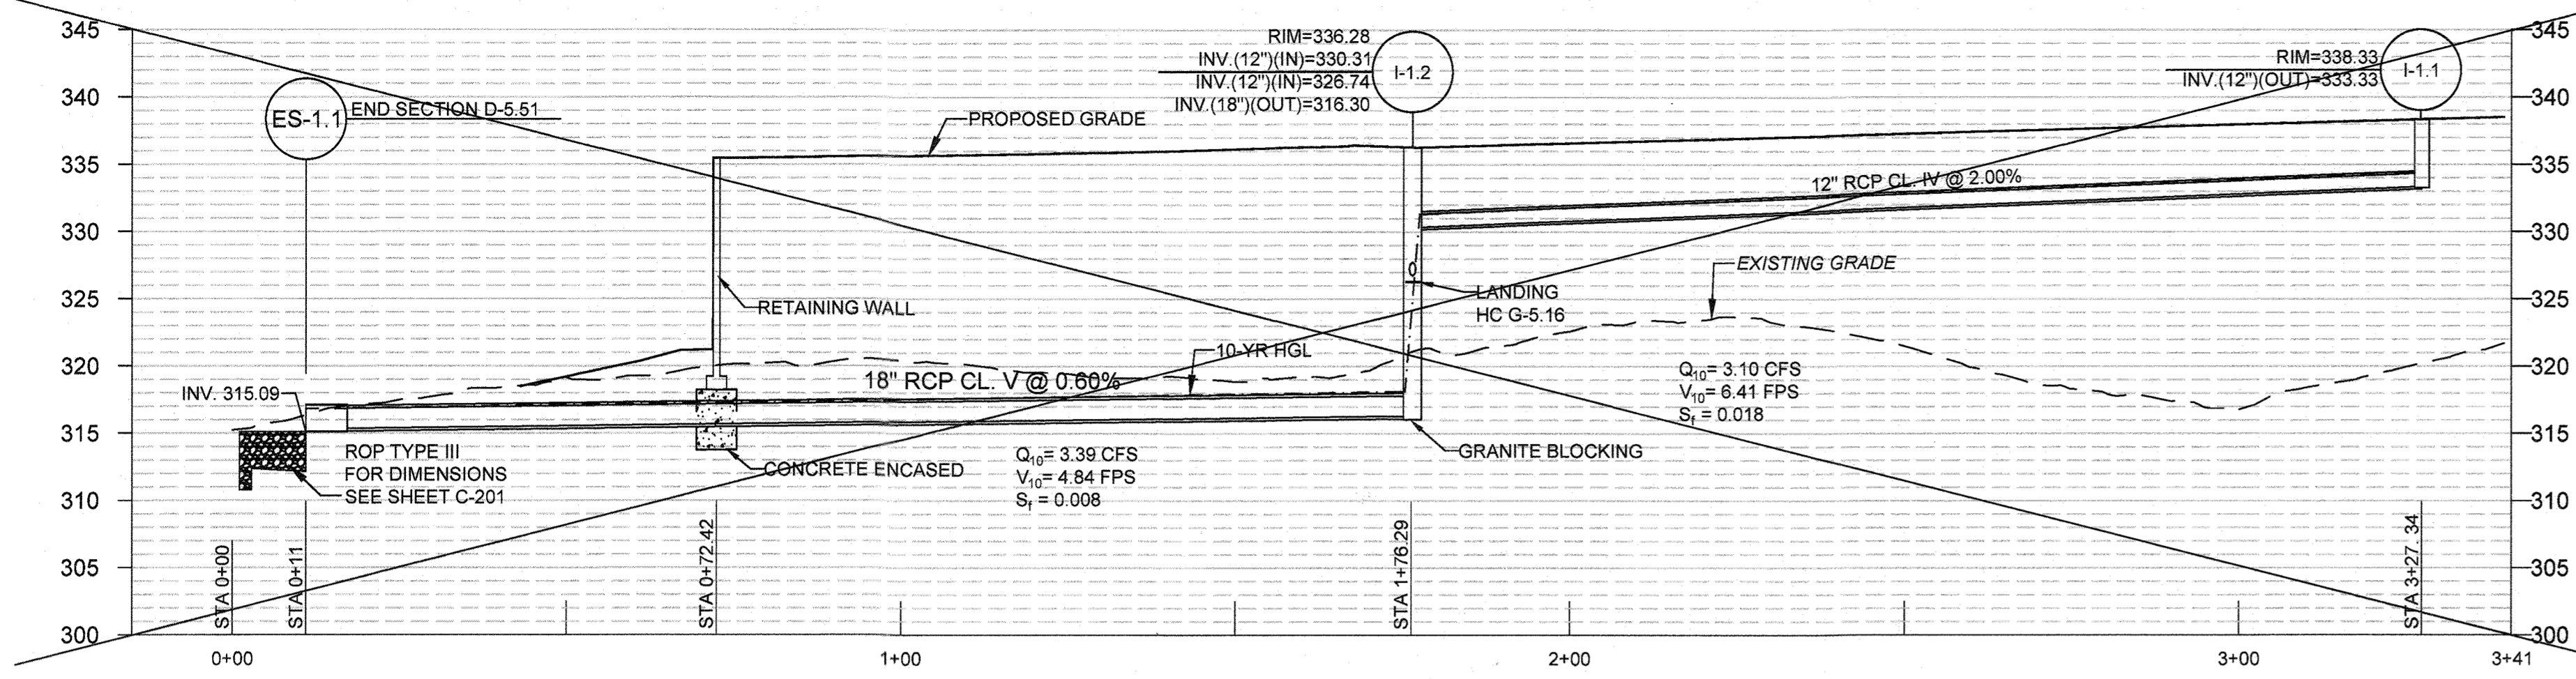


STRM I-1.1 TO ES 1.1
 SCALE: HORIZ. 1" = 20'
 VERT. 1" = 10'

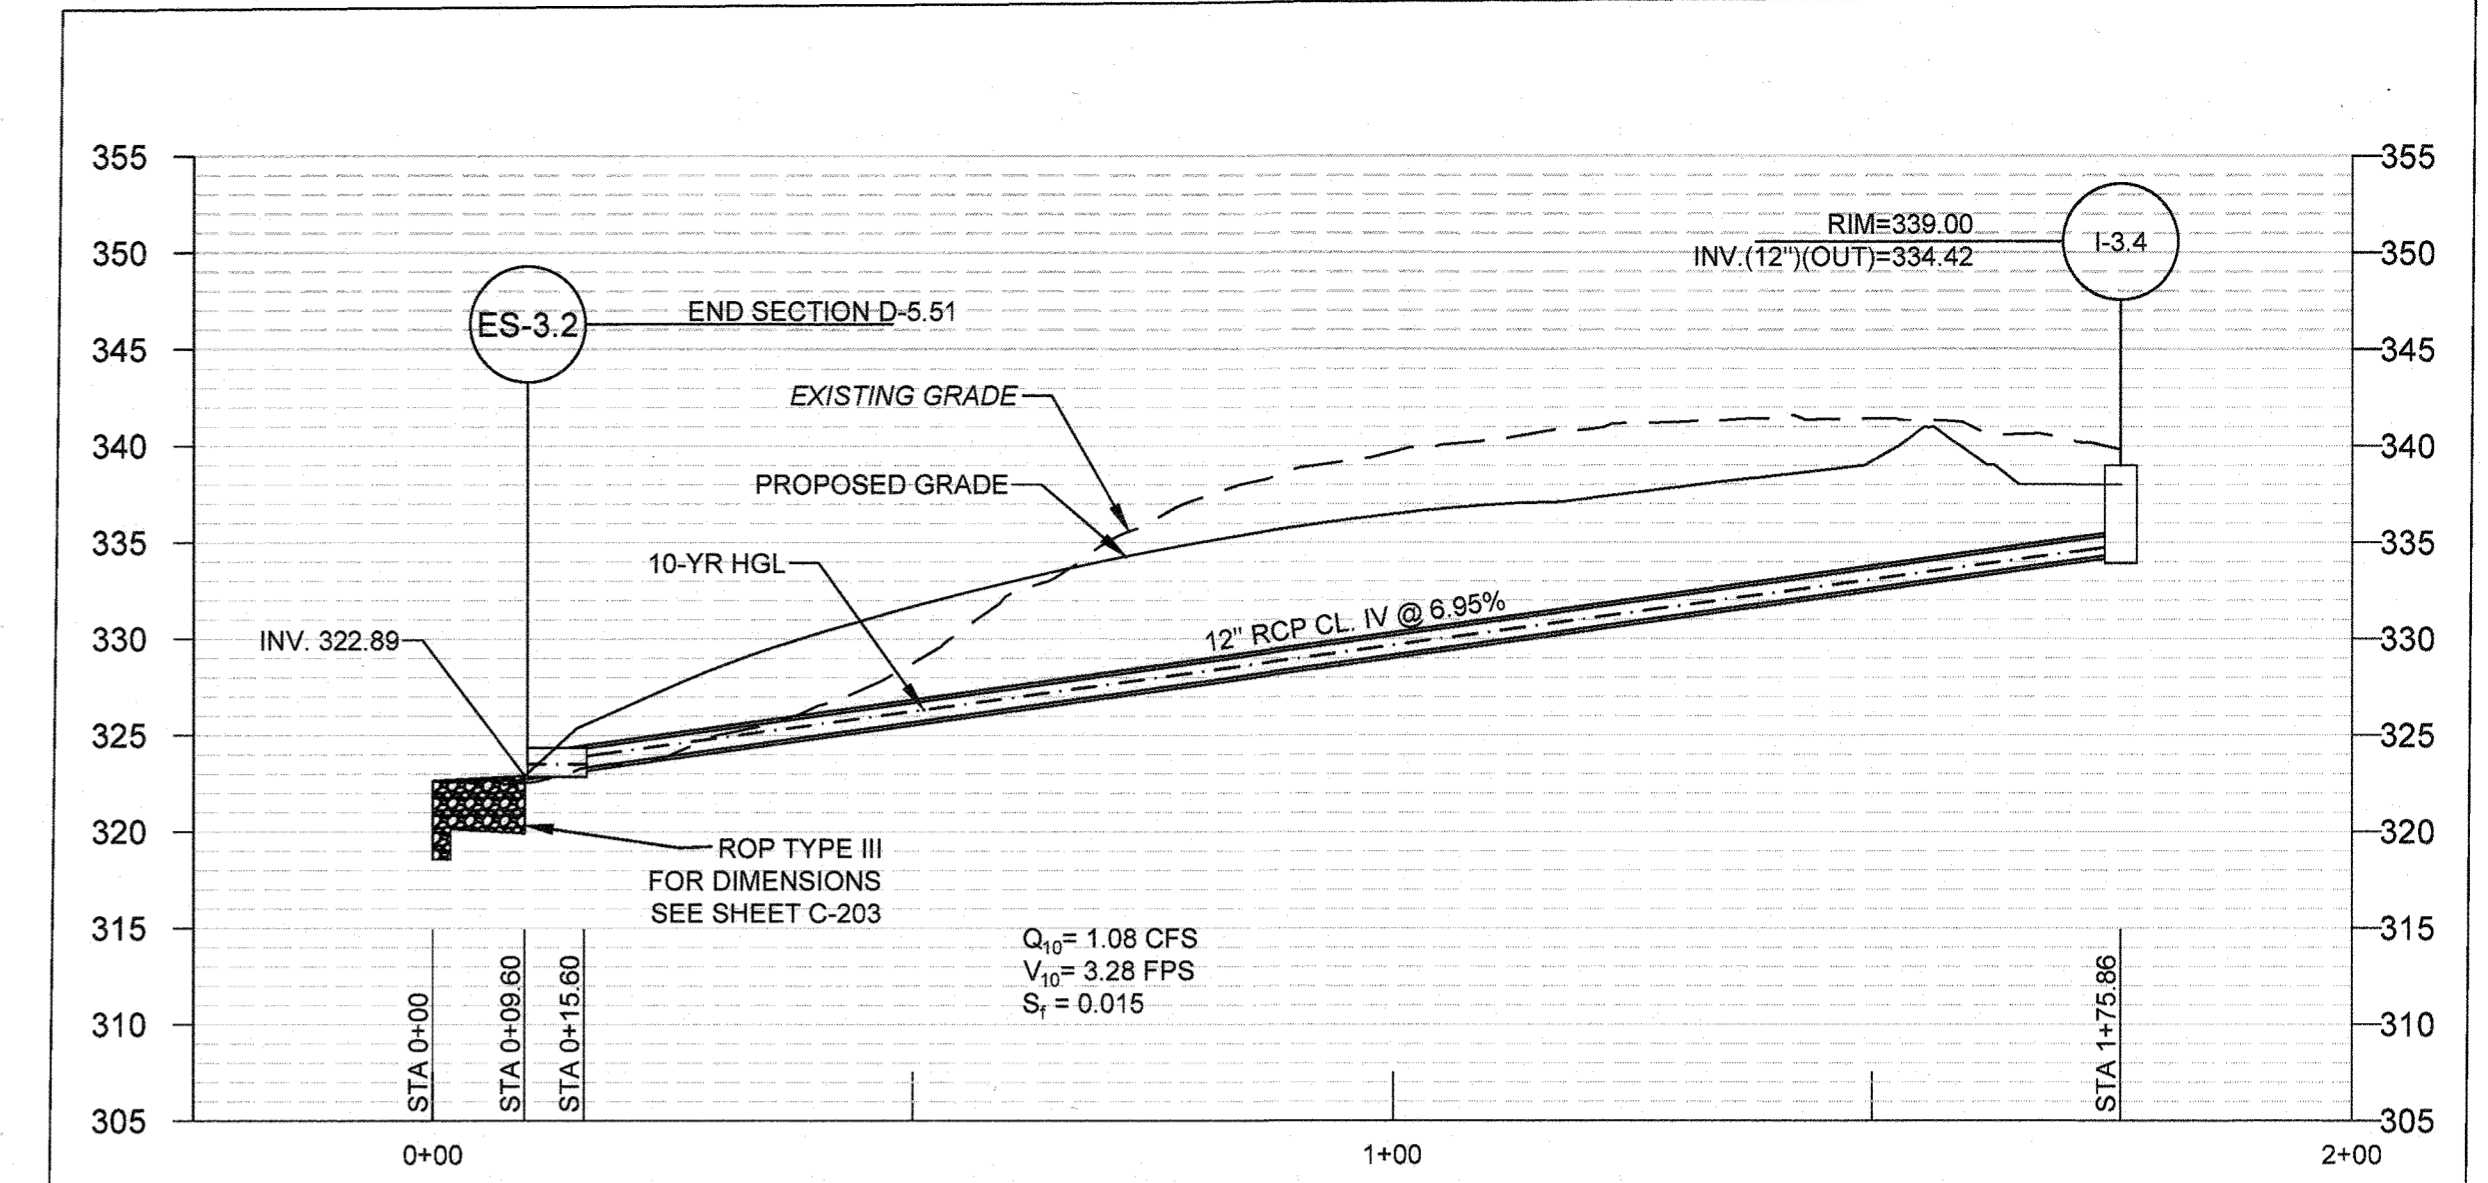


STRM I-3.4 TO ES-3.2
 SCALE: HORIZ. 1" = 50'
 VERT. 1" = 25'

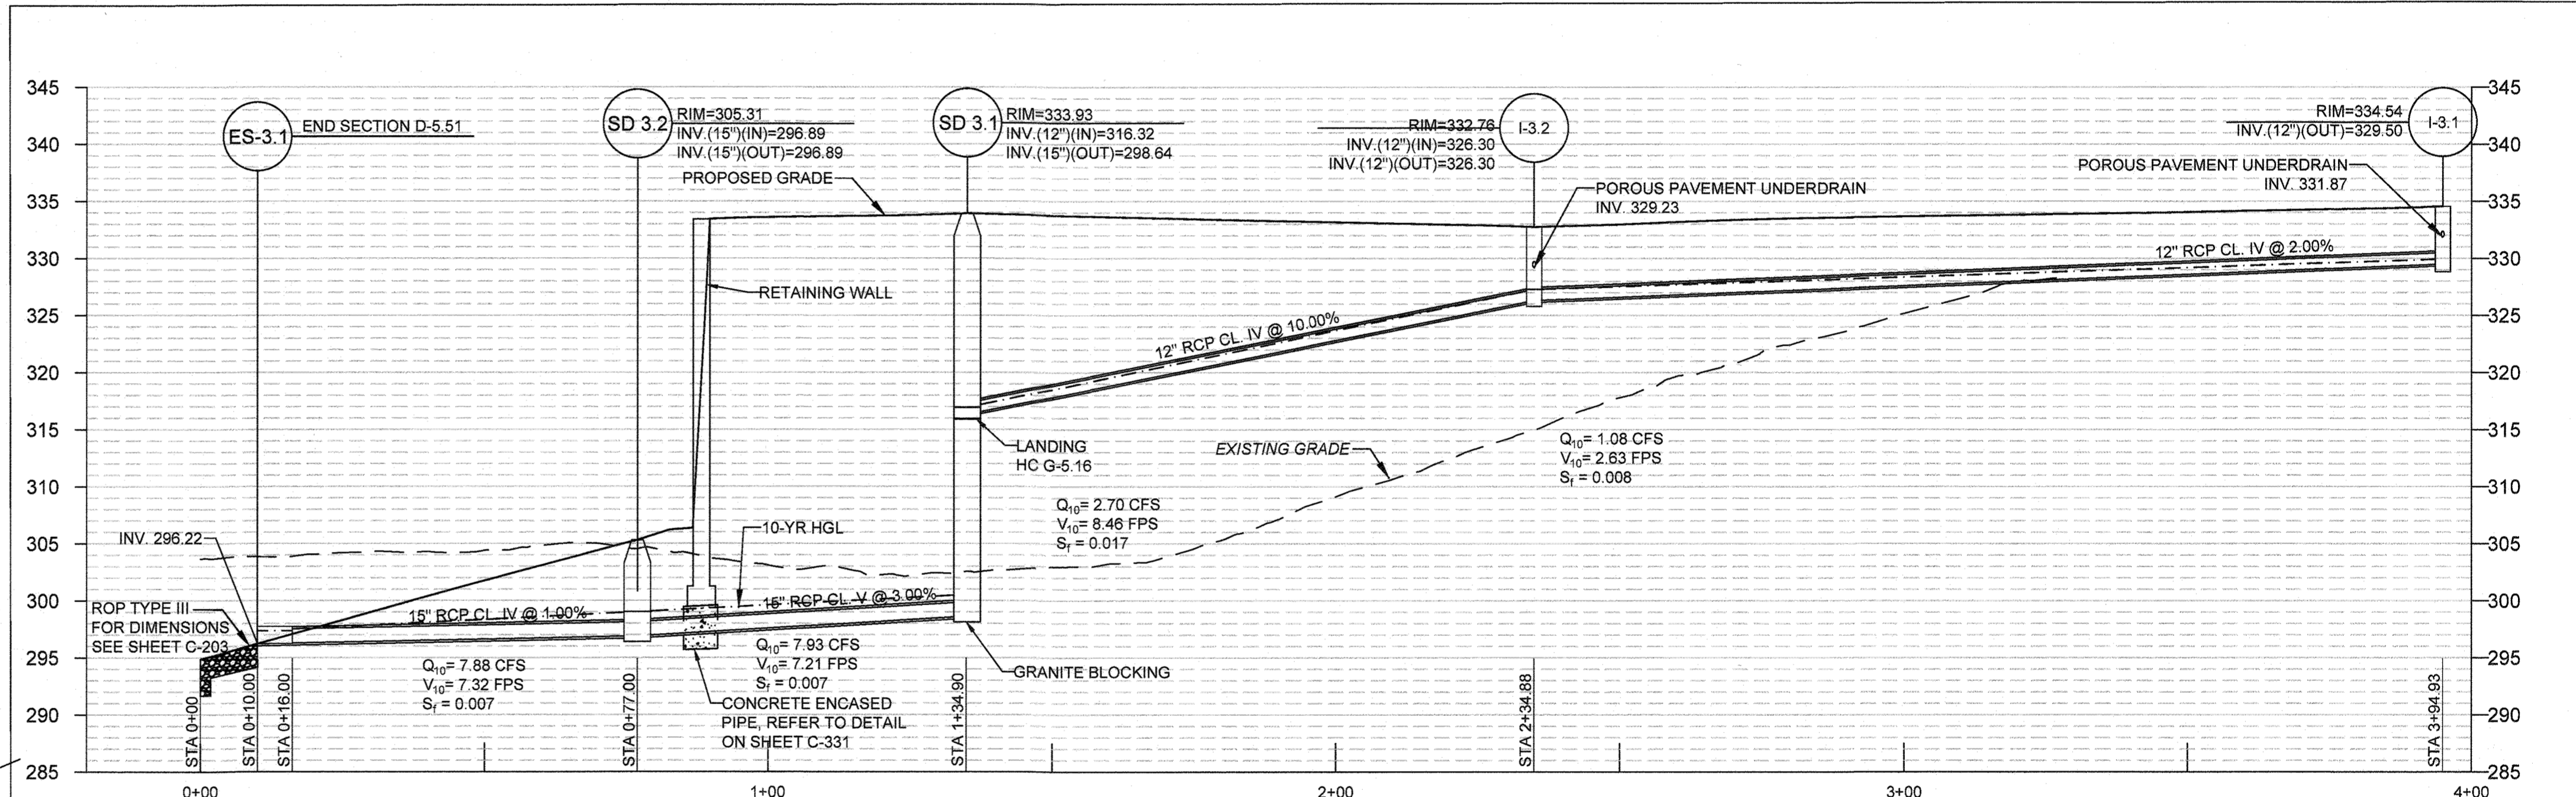

STRM I-3.1 TO ES-3.1
 SCALE: HORIZ. 1" = 50'
 VERT. 1" = 25'

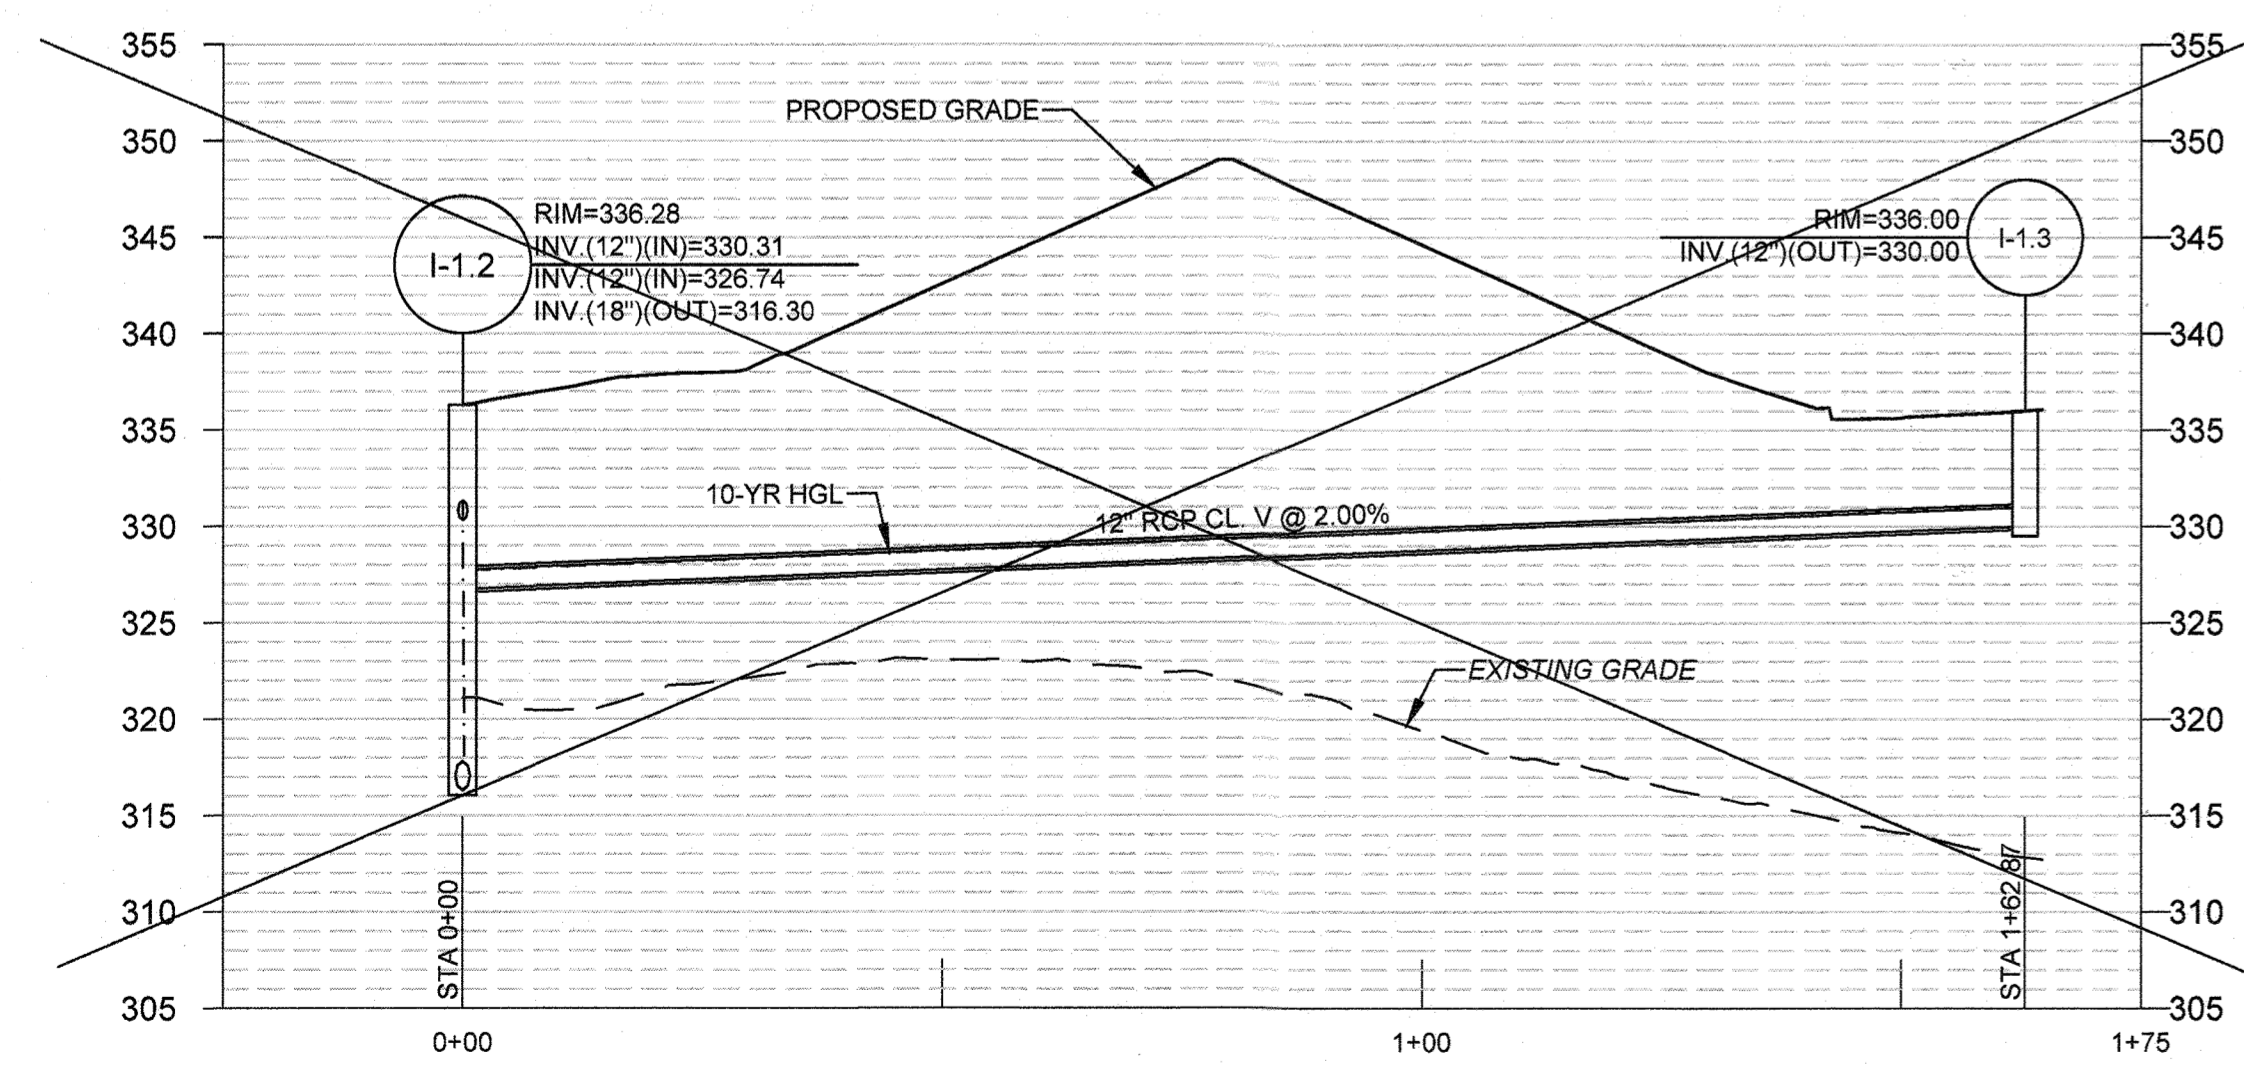


I-1.3 TO I-1.2
 SCALE: HORIZ. 1" = 20'
 VERT. 1" = 10'

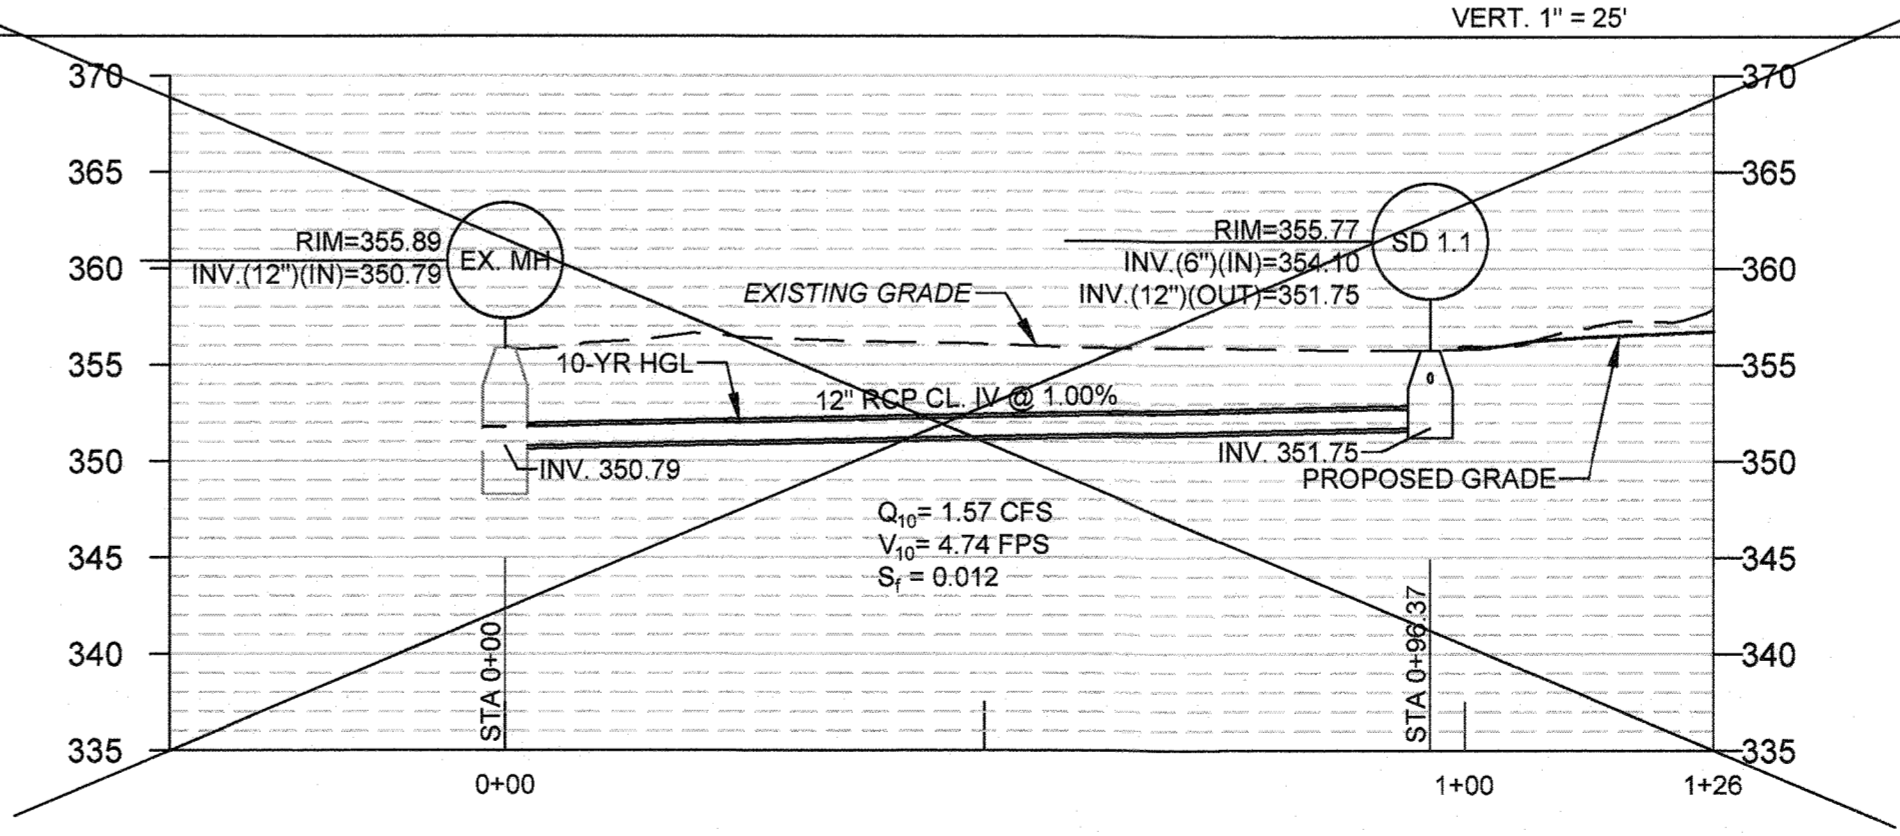


STRM SD-1.1 TO EX.
 SCALE: HORIZ. 1" = 20'
 VERT. 1" = 10'

NOTE: FOR STRUCTURE TABLE AND SCHEDULE SEE SHEET C-215

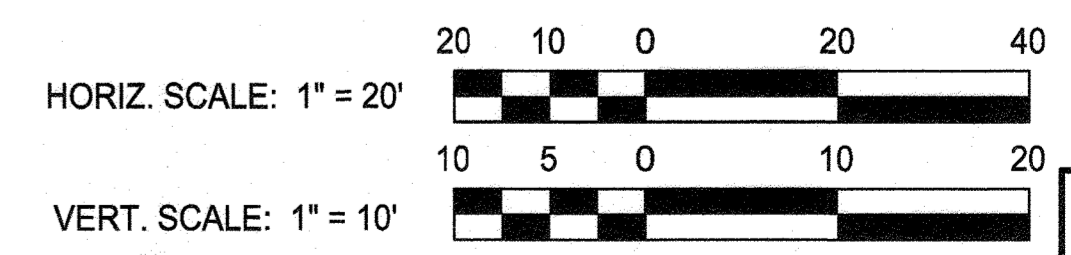

APPROVED: DEPARTMENT OF PLANNING AND ZONING
 Chief, Development Engineering Division
 Chief, Division of Land Development
 Date: 12-5-23
 Date: 2/22/24

RK&K
 RUMMEL, KLEPPER & KAHL, LLP
 ENGINEERS/CONSTRUCTION MANAGERS/PLANNERS/SCIENTISTS
 RESPONSIVE PEOPLE • CREATIVE SOLUTIONS
 700 East Pratt Street, Suite 500
 Baltimore, MD 21202
 PH: 410.728.2900 CONTACT: Matt Thomsson
 WWW.RK&K.COM

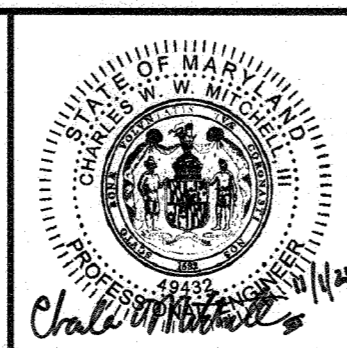

| | | |
|-------------|-----------|----------|
| DESIGN BY: | SHK | 4/7/22 |
| DRAWN BY: | JMS/DTP | 11/1/23 |
| CHECKED BY: | CWMM | |
| DATE: | 11/1/2023 | |
| BY | NO. | REVISION |
| | | DATE |

OWNER/DEVELOPER
JOHNS HOPKINS APPLIED PHYSICS LABORATORY
 11100 JOHNS HOPKINS ROAD
 LAUREL, MARYLAND 20723

STORM DRAIN PROFILES
 JOHNS HOPKINS UNIVERSITY - APPLIED PHYSICS LABORATORY
OUTDOOR TESTING AREAS
 11100 JOHNS HOPKINS ROAD
 TAX MAP: 41 PARCEL: 123 GRID: 16 ZONED: PEC
 ELECTION DISTRICT 5 - HOWARD COUNTY, MARYLAND
 SHEET 16 OF 73

RK&K PROJECT NUMBER: 21047.013
 SCALE: As Shown

1. TOPOGRAPHIC AND SURFACE INFORMATION SHOWN WAS OBTAINED FROM FIELD SURVEY BY RK&K, REVISED ON MAY 2, 2023. UTILITY INFORMATION SHOWN WAS PROVIDED BY A/JDATA, REVISED ON MAY 2, 2023.
2. IT IS THE CONTRACTOR'S RESPONSIBILITY TO FIELD VERIFY ACTUAL SITE CONDITIONS PRIOR TO THE START OF ANY WORK. THERE IS NO WARRANTY OR GUARANTEE ON THE COMPLETENESS OR CORRECTNESS OF THE EXISTING CONDITION INFORMATION. ANY DISCREPANCY FOUND SHALL BE BROUGHT TO THE IMMEDIATE ATTENTION OF THE ARCHITECT / ENGINEER PRIOR TO THE START OF ANY WORK.
3. BEARINGS AND HORIZONTAL COORDINATES SHOWN ON THIS PLAN ARE BASED UPON MARYLAND STATE PLANE COORDINATE SYSTEM NAD83. VERTICAL ELEVATIONS SHOWN ARE BASED UPON VERTICAL DATUM NAVD83.
4. THE CONTRACTOR SHALL BE RESPONSIBLE FOR NOTIFYING "MISS UTILITY" AT 1-800-257-7777 FIVE DAYS PRIOR TO THE START OF ANY EXCAVATION WORK.
5. THE CONTRACTOR SHALL VERIFY ALL EXISTING UTILITY INVERTS AND CLEARANCES FROM NEW WORK PRIOR TO START OF ANY WORK.
6. THE CONTRACTOR SHALL STAKE OUT THE LOCATION OF ALL NEW CONSTRUCTION AND VERIFY ALL JURISDICTIONAL SETBACKS AND BUFFERS PRIOR TO START OF ANY WORK.
7. EXISTING UTILITIES WHICH ARE NOT TO BE REMOVED OR ABANDONED SHALL REMAIN OPERATIONAL AT ALL TIMES. APPROPRIATE EXISTING UTILITIES SHALL REMAIN IN SERVICE UNTIL REPLACEMENT/RELOCATED UTILITIES ARE OPERATIONAL.

DEMOLITION NOTES


- 1 REMOVE EXISTING ELECTRIC CONDUIT/DUCTBANK AND ALL ASSOCIATED STRUCTURES AND POLE. POLES SALVAGED FOR REUSE.
- 2 REMOVE EXISTING WATER PIPE AND ALL ASSOCIATED STRUCTURES
- 3 REMOVE EXISTING STORM DRAIN PIPE AND ALL ASSOCIATED STRUCTURES, INLETS, AND RIP-RAP
- 4 REMOVE EXISTING SANITARY PIPE AND ALL ASSOCIATED STRUCTURES
- 5 REMOVE EXISTING GAS PIPE AND ALL ASSOCIATED STRUCTURES
- 6 REMOVE EXISTING TELECOMMUNICATIONS CONDUIT/DUCTBANK AND ALL ASSOCIATED STRUCTURES
- 7 REMOVE EXISTING CONCRETE OR ASPHALT PAVEMENT AND ALL ASSOCIATED CURB/GUTTER, PAVEMENT MARKINGS, AND SIGNAGE
- 8 REMOVE EXISTING SIDEWALK/STEPS
- 9 REMOVE EXISTING RETAINING WALL AND ALL ASSOCIATED FOOTINGS
- 10 REMOVE EXISTING TREES / BRUSH
- 11 REMOVE EXISTING TREE
- 12 REMOVE EXISTING SIGN
- 13 EXISTING UTILITY TO REMAIN AND BE PROTECTED DURING CONSTRUCTION
- 14 EXISTING SECURITY CAMERA POLE TO BE SALVAGED FOR REUSE, CONTRACTOR TO COORDINATE WITH AP/
- 15 EXISTING CURB ISLAND AND ALL ASSOCIATED CURB AND CUTTER TO BE REMOVED FOR CONSTRUCTION VEHICLE ACCESS
- 16 CUT AND CAP / BULKHEAD EXISTING UTILITY
- 17 PROTECT EXISTING FENCE DURING CONSTRUCTION
- 18 REPLACE EXISTING CURB & GUTTER IN KIND TO NEAREST JOINT AFTER UTILITY INSTALLATION

DEMOLITION LEGEND


- LOD --- LIMITS OF DISTURBANCE
- - - - - REMOVE EXISTING UTILITY
- [Hatched Box] REMOVE CONCRETE OR ASPHALT PAVEMENT OR SIDEWALK/STEPS (SEE DEMOLITION NOTES)
- [Dotted Box] TEMPORARY PAVEMENT REMOVAL & RESTORATION IN KIND (UTILITY TRENCHING)
- [Solid Black Box] REPLACE EXISTING CURB & GUTTER IN KIND TO NEAREST JOINT AFTER UTILITY INSTALLATION

EXISTING LEGEND

- PROPERTY LINE
- CURB AND GUTTER
- TREE LINE / BRUSH LINE
- ☀ TREE / BUSH
- 405 MAJOR CONTOUR
- 404 MINOR CONTOUR
- DITCH
- E --- ELECTRIC
- T --- TELECOMMUNICATIONS
- G --- GAS
- SD --- STORM
- S --- SANITARY
- W --- WATER
- E --- ELECTRIC
- T --- COMM.
- F --- FIBER OPTIC
- G --- GAS
- SD --- STORM
- S --- SANITARY
- W --- WATER
- ⊙ ELECTRIC POLE / LIGHT POLE
- ⊙ ELECTRIC MANHOLE
- ⊙ ELECTRIC HANDHOLE
- ⊙ COMMUNICATIONS MANHOLE
- ⊙ COMMUNICATIONS HANDHOLE
- ⊙ STORM MANHOLE AND IDENTIFIER
- ⊙ STORM INLET AND IDENTIFIER
- ⊙ STORM CLEAN OUT
- ⊙ SANITARY MANHOLE AND IDENTIFIER
- ⊙ WATER VALVE
- ⊙ WATER STRUCTURE
- ⊙ FIRE HYDRANT
- ⊙ GAS VALVE

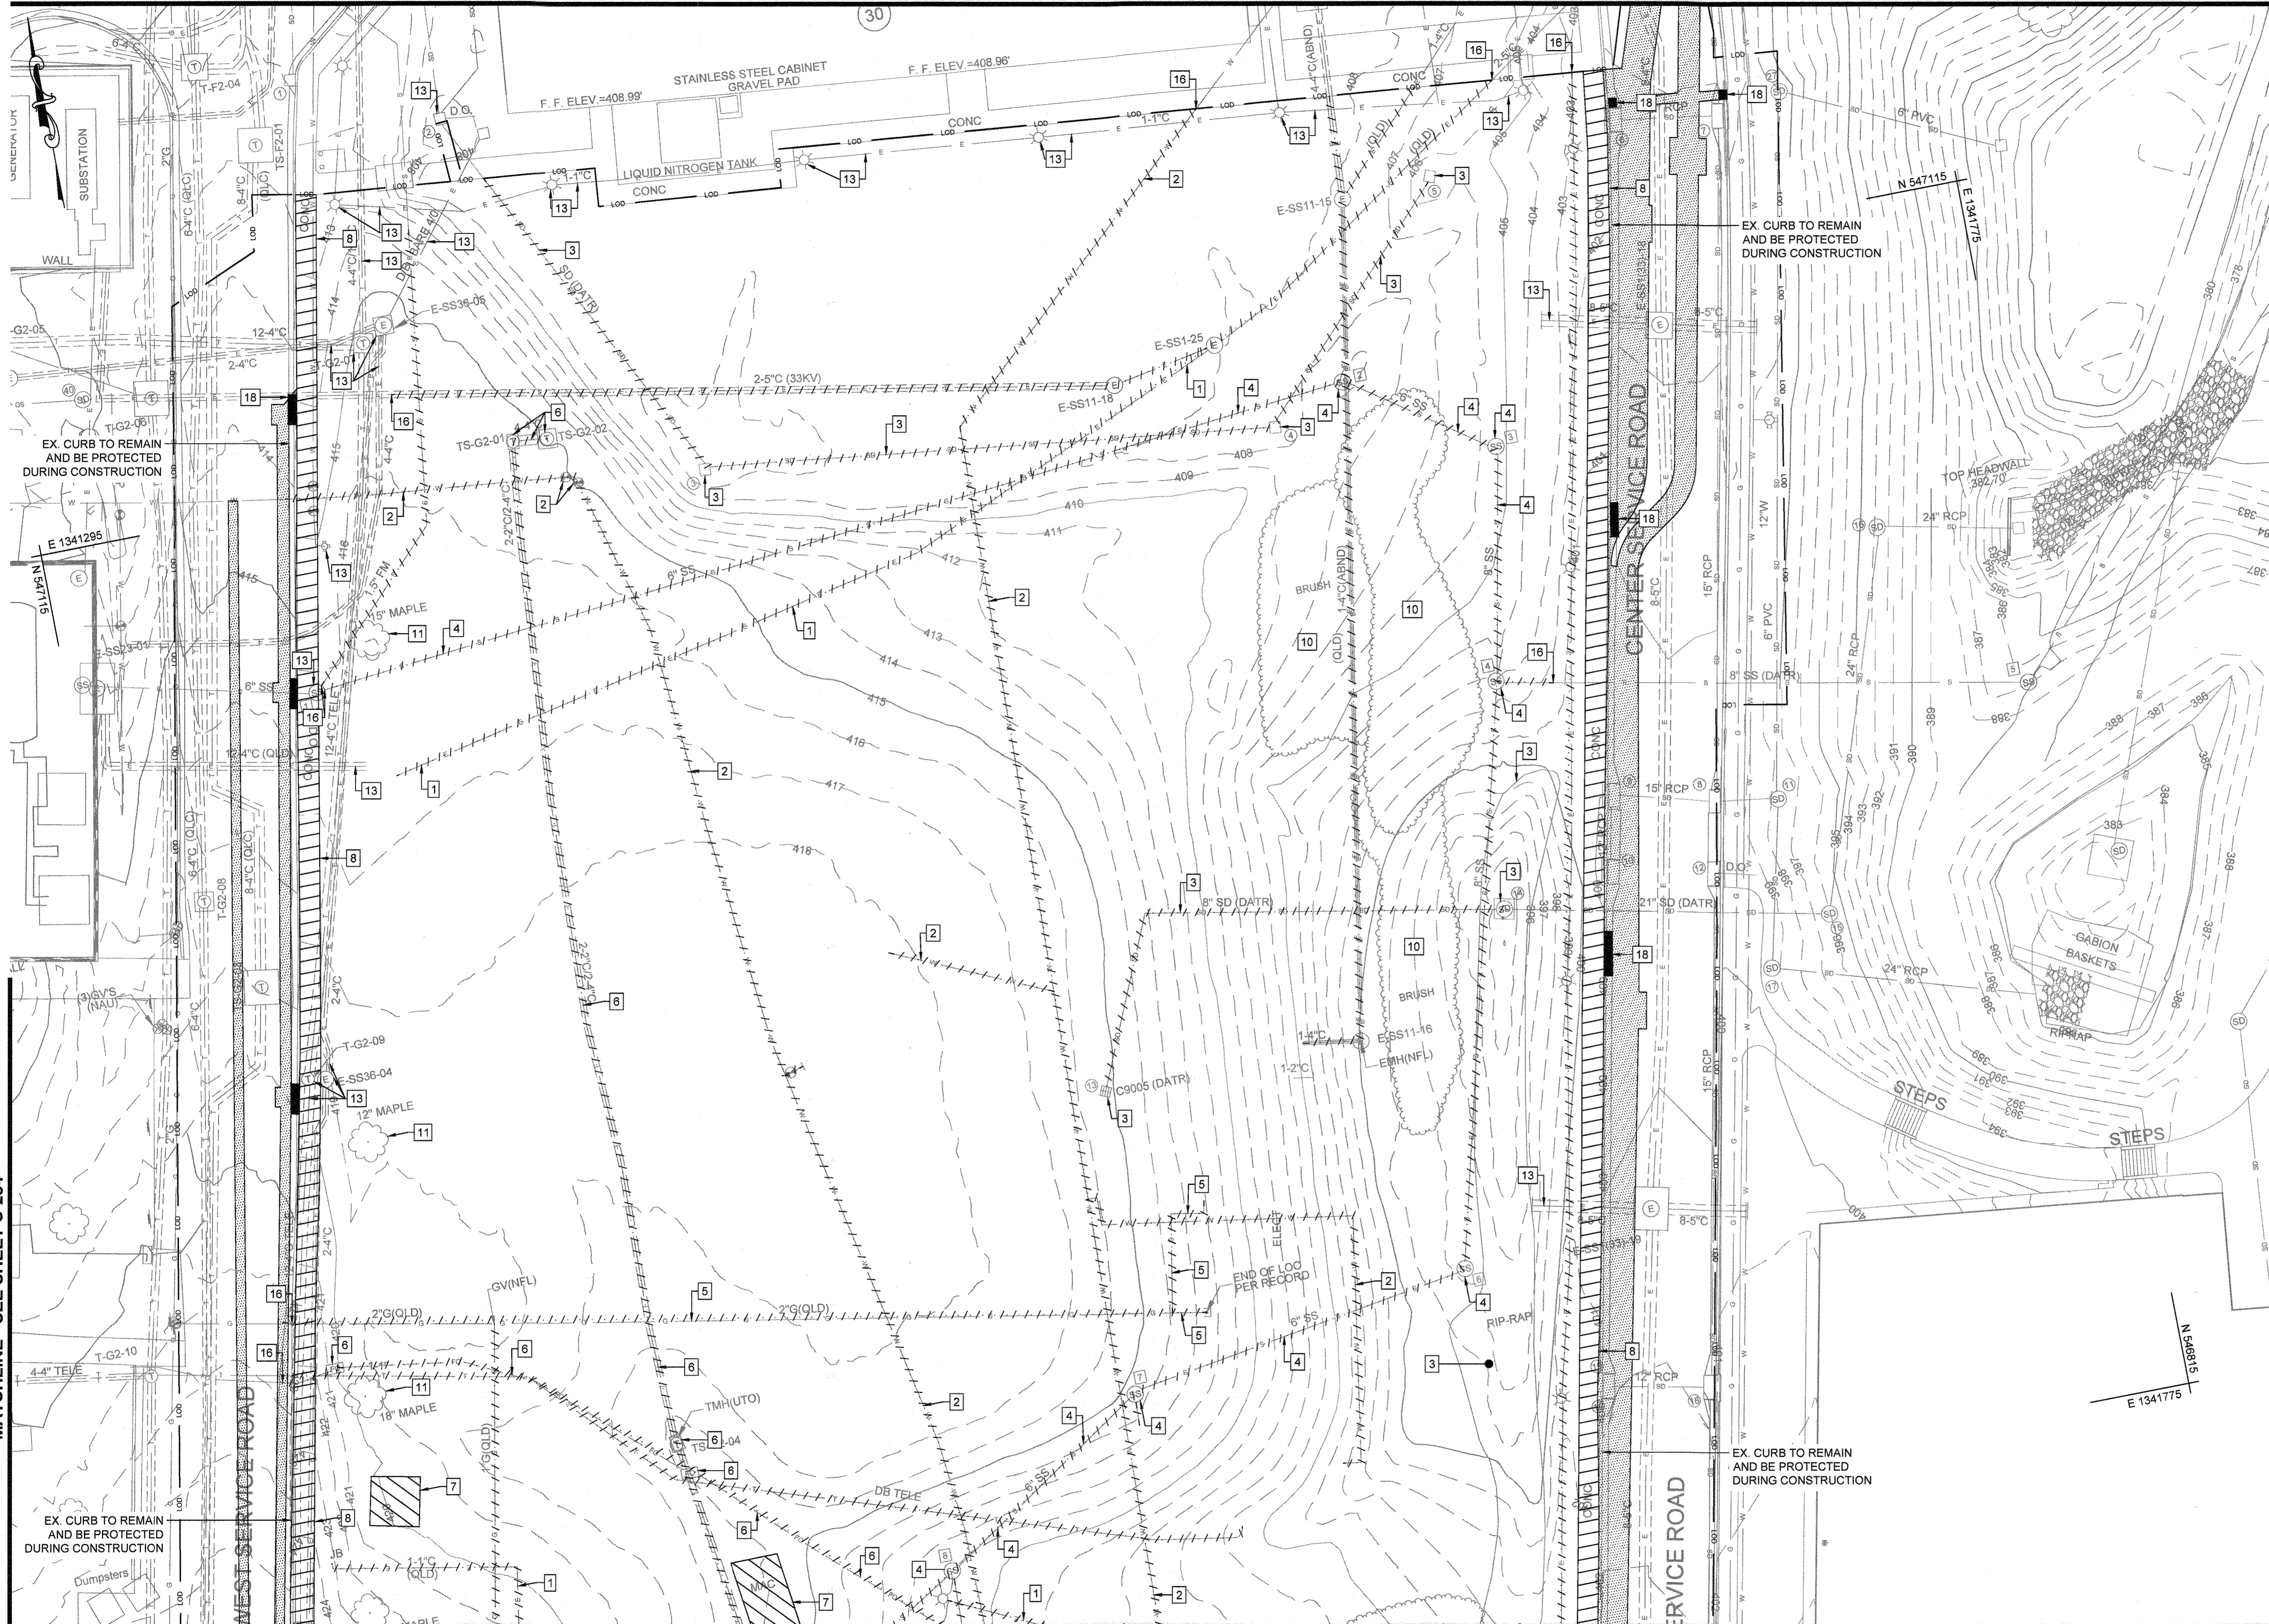

▲ PURPOSE STATEMENT (11/1/23): DESIGN OF OUTDOOR TESTING AREA 3, INCLUDING THE SOURCE OF BORROW MATERIAL REFERRED TO AS THE EAST AND WEST BORROW AREAS.

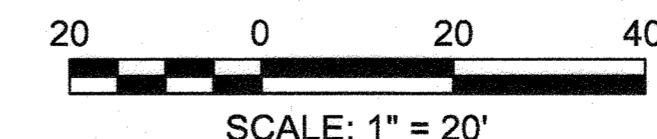


MATCHLINE - SEE SHEET C-284

APPROVED: DEPARTMENT OF PLANNING AND ZONING
 Chief, Development Engineering Division
 Chief, Division of Land Development
 Director

RK&K
 RUMMEL, KLEPPER & KAHL, LLP
 ENGINEERS/CONSTRUCTION MANAGERS/PLANNERS/SCIENTISTS
 RESPONSIVE PEOPLE. CREATIVE SOLUTIONS.
 700 East Pratt Street, Suite 500
 Baltimore, MD 21202
 PH: 410.728.2900
 www.rk&k.com

PROFESSIONAL CERTIFICATION. I HEREBY CERTIFY THAT THESE DOCUMENTS WERE PREPARED OR APPROVED BY ME, AND THAT I AM A DULY LICENSED PROFESSIONAL ENGINEER UNDER THE LAWS OF THE STATE OF MARYLAND. LICENSE NO. 49432, EXPIRATION DATE: MAY 31, 2024.

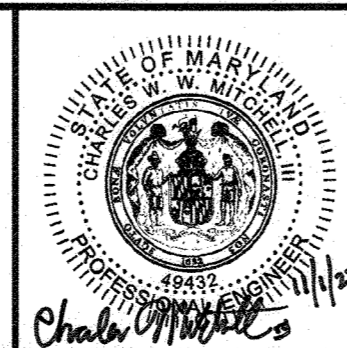

| | | | | | |
|-------------|-----------|------|-----|---|---------|
| DESIGN BY: | SHK | RK&K | ▲ | New Sheet - OTA-3 and Borrow Area Modifications | 11/1/23 |
| DRAWN BY: | JMS/DTP | | | | |
| CHECKED BY: | CWMM | | | | |
| DATE: | 11/1/2023 | BY | NO. | REVISION | DATE |

OWNER/DEVELOPER
JOHNS HOPKINS APPLIED PHYSICS LABORATORY
 11100 JOHNS HOPKINS ROAD
 LAUREL, MARYLAND 20723

EX. CONDITION & DEMO PLAN - EAST BORROW AREA (PHASE 2)
 JOHNS HOPKINS UNIVERSITY - APPLIED PHYSICS LABORATORY
OUTDOOR TESTING AREAS
 11100 JOHNS HOPKINS ROAD
 TAX MAP: 41 PARCEL: 123 GRID: 15 ZONED: PEC
 ELECTION DISTRICT 5 - HOWARD COUNTY, MARYLAND
 SHEET 17 OF 73

C-281
 RK&K PROJECT NUMBER
 21047.013
 SCALE:
 As Shown

1. TOPOGRAPHIC AND SURFACE INFORMATION SHOWN WAS OBTAINED FROM FIELD SURVEY BY RK&K, REVISED ON MAY 2, 2023. UTILITY INFORMATION SHOWN WAS PROVIDED BY AIJDATA, REVISED ON MAY 2, 2023.
2. IT IS THE CONTRACTOR'S RESPONSIBILITY TO FIELD VERIFY ACTUAL SITE CONDITIONS PRIOR TO THE START OF ANY WORK. THERE IS NO WARRANTY OR GUARANTEE ON THE COMPLETENESS OR CORRECTNESS OF THE EXISTING CONDITION INFORMATION. ANY DISCREPANCY FOUND SHALL BE BROUGHT TO THE IMMEDIATE ATTENTION OF THE ARCHITECT / ENGINEER PRIOR TO THE START OF ANY WORK.
3. BEARINGS AND HORIZONTAL COORDINATES SHOWN ON THIS PLAN ARE BASED UPON MARYLAND STATE PLANE COORDINATE SYSTEM NAD83. VERTICAL ELEVATIONS SHOWN ARE BASED UPON VERTICAL DATUM NAVD83.
4. THE CONTRACTOR SHALL BE RESPONSIBLE FOR NOTIFYING "MISS UTILITY" AT 1-800-257-7777 FIVE DAYS PRIOR TO THE START OF ANY EXCAVATION WORK.
5. THE CONTRACTOR SHALL VERIFY ALL EXISTING UTILITY INVERTS AND CLEARANCES FROM NEW WORK PRIOR TO START OF ANY WORK.
6. THE CONTRACTOR SHALL STAKE OUT THE LOCATION OF ALL NEW CONSTRUCTION AND VERIFY ALL JURISDICTIONAL SETBACKS AND BUFFERS PRIOR TO START OF ANY WORK.
7. EXISTING UTILITIES WHICH ARE NOT TO BE REMOVED OR ABANDONED SHALL REMAIN OPERATIONAL AT ALL TIMES. APPROPRIATE EXISTING UTILITIES SHALL REMAIN IN SERVICE UNTIL REPLACEMENT/RELOCATED UTILITIES ARE OPERATIONAL.

DEMOLITION NOTES


- 1 REMOVE EXISTING ELECTRIC CONDUIT/DUCTBANK AND ALL ASSOCIATED STRUCTURES AND POLE. POLES SALVAGED FOR REUSE.
- 2 REMOVE EXISTING WATER PIPE AND ALL ASSOCIATED STRUCTURES
- 3 REMOVE EXISTING STORM DRAIN PIPE AND ALL ASSOCIATED STRUCTURES, INLETS, AND RIP-RAP
- 4 REMOVE EXISTING SANITARY PIPE AND ALL ASSOCIATED STRUCTURES
- 5 REMOVE EXISTING GAS PIPE AND ALL ASSOCIATED STRUCTURES
- 6 REMOVE EXISTING TELECOMMUNICATIONS CONDUIT/DUCTBANK AND ALL ASSOCIATED STRUCTURES
- 7 REMOVE EXISTING CONCRETE OR ASPHALT PAVEMENT AND ALL ASSOCIATED CURB/GUTTER, PAVEMENT MARKINGS, AND SIGNAGE
- 8 REMOVE EXISTING SIDEWALK/STEPS
- 9 REMOVE EXISTING RETAINING WALL AND ALL ASSOCIATED FOOTINGS
- 10 REMOVE EXISTING TREES / BRUSH
- 11 REMOVE EXISTING TREE
- 12 REMOVE EXISTING SIGN
- 13 EXISTING UTILITY TO REMAIN AND BE PROTECTED DURING CONSTRUCTION
- 14 EXISTING SECURITY CAMERA POLE TO BE SALVAGED FOR REUSE, CONTRACTOR TO COORDINATE WITH APF
- 15 EXISTING CURB ISLAND AND ALL ASSOCIATED CURB AND CUTTER TO BE REMOVED FOR CONSTRUCTION VEHICLE ACCESS
- 16 CUT AND CAP / BULKHEAD EXISTING UTILITY
- 17 PROTECT EXISTING FENCE DURING CONSTRUCTION
- 18 REPLACE EXISTING CURB & GUTTER IN KIND TO NEAREST JOINT AFTER UTILITY INSTALLATION

DEMOLITION LEGEND

- LOD --- LIMITS OF DISTURBANCE
- - - - - REMOVE EXISTING UTILITY
- [Hatched Box] REMOVE CONCRETE OR ASPHALT PAVEMENT, OR SIDEWALK/STEPS (SEE DEMOLITION NOTES)
- [Dotted Box] TEMPORARY PAVEMENT REMOVAL & RESTORATION IN KIND (UTILITY TRENCHING)
- [Solid Black Box] REPLACE EXISTING CURB & GUTTER IN KIND TO NEAREST JOINT AFTER UTILITY INSTALLATION

EXISTING LEGEND


- [Dashed Line] PROPERTY LINE
- [Double Line] CURB AND GUTTER
- [Wavy Line] TREE LINE / BRUSH LINE
- [Tree Symbol] TREE / BUSH
- [Dotted Line] MAJOR CONTOUR
- [Dotted Line] MINOR CONTOUR
- [Dashed Line] DITCH
- [E] ELECTRIC
- [T] TELECOMMUNICATIONS
- [G] GAS
- [SD] STORM
- [S] SANITARY
- [W] WATER
- [E] ELECTRIC
- [T] COMM.
- [F] FIBER OPTIC
- [G] GAS
- [SD] STORM
- [S] SANITARY
- [W] WATER
- [E] ELECTRIC POLE / LIGHT POLE
- [E] ELECTRIC MANHOLE
- [E] ELECTRIC HANDHOLE
- [T] COMMUNICATIONS MANHOLE
- [T] COMMUNICATIONS HANDHOLE
- [SD] STORM MANHOLE AND IDENTIFIER
- [S] STORM INLET AND IDENTIFIER
- [SD] STORM CLEAN OUT
- [S] SANITARY MANHOLE AND IDENTIFIER
- [W] WATER VALVE
- [W] WATER STRUCTURE
- [W] FIRE HYDRANT
- [W] GAS VALVE

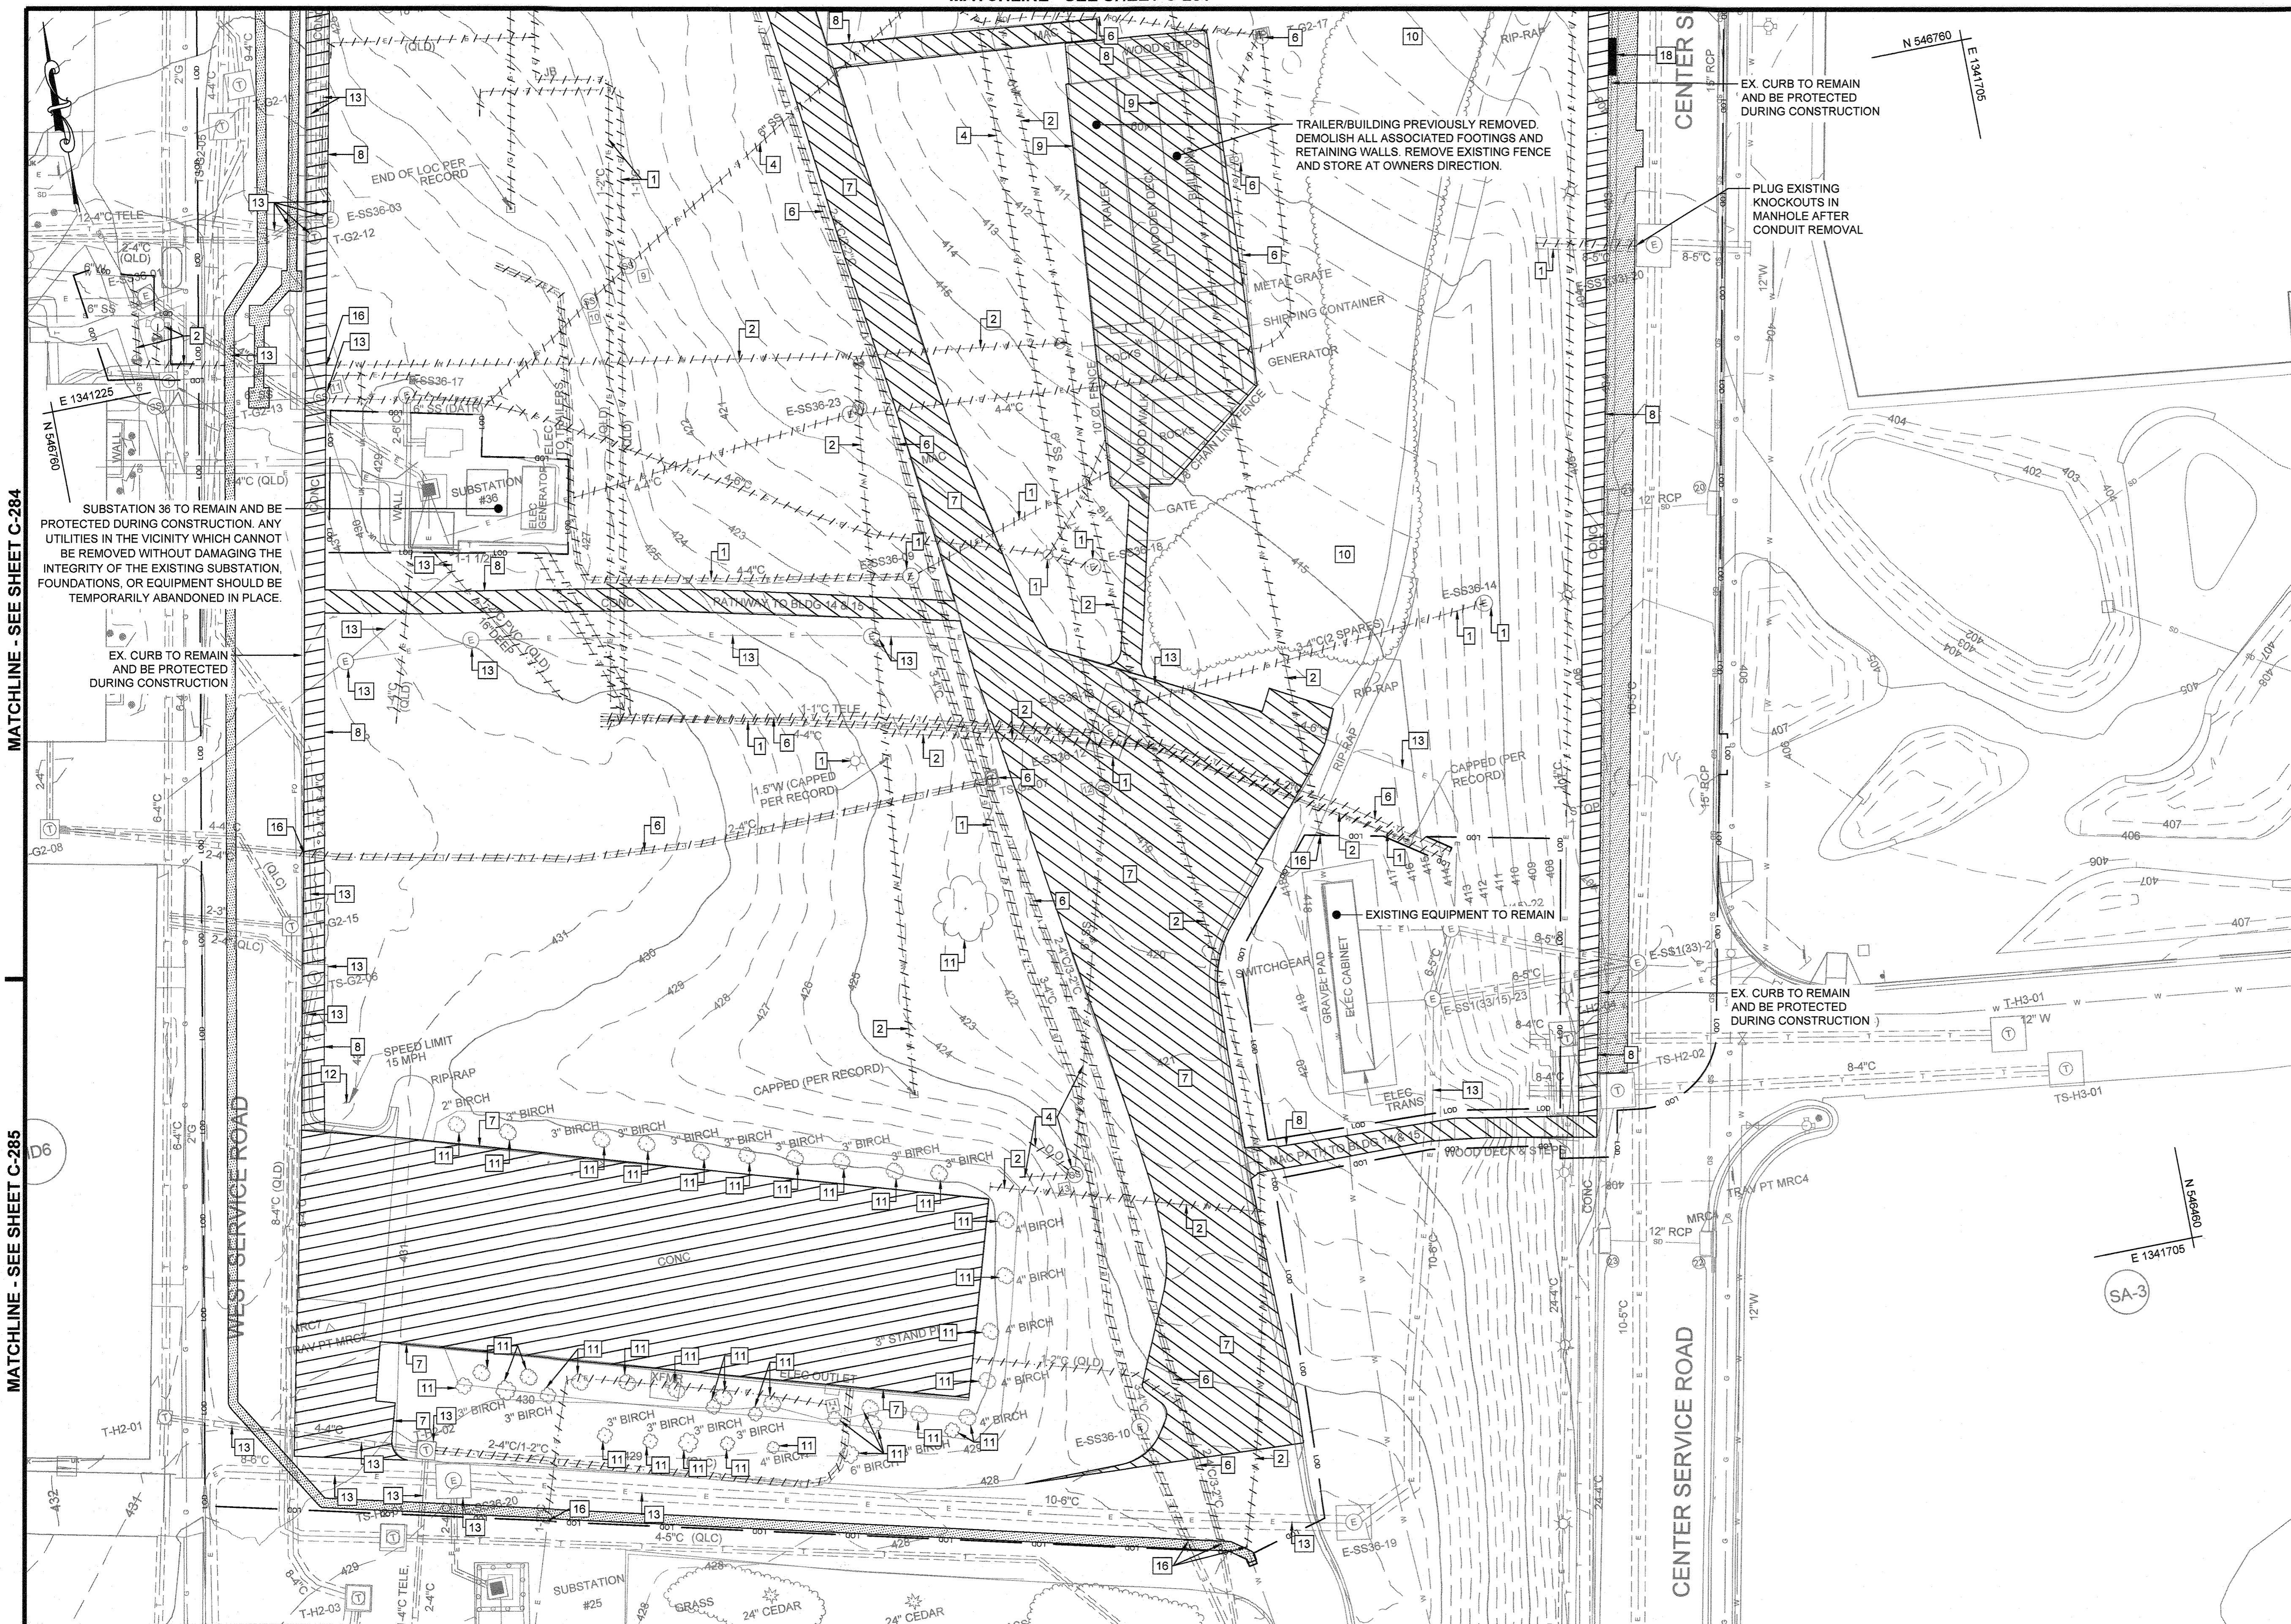

MATCHLINE - SEE SHEET C-284

MATCHLINE - SEE SHEET C-285


▲ PURPOSE STATEMENT (11/1/23): DESIGN OF OUTDOOR TESTING AREA 3, INCLUDING THE SOURCE OF BORROW MATERIAL, REFERRED TO AS THE EAST AND WEST BORROW AREAS.

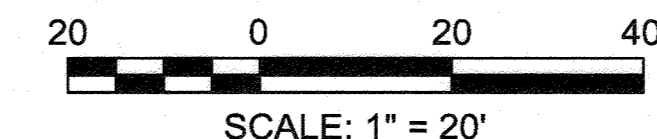

APPROVED: DEPARTMENT OF PLANNING AND ZONING
 Chief, Development Engineering Division
 Date: 12-5-23
 Chief, Division of Land Development
 Date: 12/21/24
 Director
 Date: 12/21/24



PROFESSIONAL CERTIFICATION. I HEREBY CERTIFY THAT THESE DOCUMENTS WERE PREPARED OR APPROVED BY ME AND THAT I AM A DULY LICENSED PROFESSIONAL ENGINEER UNDER THE LAWS OF THE STATE OF MARYLAND. LICENSE NO. 49432, EXPIRATION DATE: MAY 31, 2024.

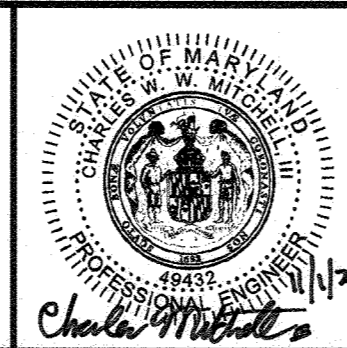

| | | | | |
|----------------------|------|-----|---|---------|
| DESIGN BY: SHK | RK&K | 4 | New Sheet - OTA-3 and Borrow Area Modifications | 11/1/23 |
| DRAWN BY: JMS/DTP | | | | |
| CHECKED BY: CWWW | | | | |
| DATE: 11/1/2023 | BY | NO. | REVISION | DATE |

OWNER/DEVELOPER
JOHNS HOPKINS APPLIED PHYSICS LABORATORY
 11100 JOHNS HOPKINS ROAD
 LAUREL, MARYLAND 20723

EX. CONDITION & DEMO PLAN - EAST BORROW AREA (PHASE 2)
 JOHNS HOPKINS UNIVERSITY - APPLIED PHYSICS LABORATORY
OUTDOOR TESTING AREAS
 11100 JOHNS HOPKINS ROAD
 TAX MAP: 41 PARCEL: 123 GRID: 18 ZONED: PEG
 ELECTION DISTRICT 5 - HOWARD COUNTY, MARYLAND
 SHEET 18 OF 73

RK&K PROJECT NUMBER: 21047.013
 SCALE: As Shown

GENERAL NOTES

1. TOPOGRAPHIC AND SURFACE INFORMATION SHOWN WAS OBTAINED FROM FIELD SURVEY BY RK&K, REVISED ON MAY 2, 2023. UTILITY INFORMATION SHOWN WAS PROVIDED BY AJJ/DATA, REVISED ON MAY 2, 2023.
2. IT IS THE CONTRACTOR'S RESPONSIBILITY TO FIELD VERIFY ACTUAL SITE CONDITIONS PRIOR TO THE START OF ANY WORK. THERE IS NO WARRANTY OR GUARANTEE ON THE COMPLETENESS OR CORRECTNESS OF THE EXISTING CONDITION INFORMATION. ANY DISCREPANCY FOUND SHALL BE BROUGHT TO THE IMMEDIATE ATTENTION OF THE ARCHITECT / ENGINEER PRIOR TO THE START OF ANY WORK.
3. BEARINGS AND HORIZONTAL COORDINATES SHOWN ON THIS PLAN ARE BASED UPON MARYLAND STATE PLANE COORDINATE SYSTEM NAD83. VERTICAL ELEVATIONS SHOWN ARE BASED UPON VERTICAL DATUM NAVD83.
4. THE CONTRACTOR SHALL BE RESPONSIBLE FOR NOTIFYING "MISS UTILITY" AT 1-800-257-7777 FIVE DAYS PRIOR TO THE START OF ANY EXCAVATION WORK.
5. THE CONTRACTOR SHALL VERIFY ALL EXISTING UTILITY INVERTS AND CLEARANCES FROM NEW WORK PRIOR TO START OF ANY WORK.
6. THE CONTRACTOR SHALL STAKE OUT THE LOCATION OF ALL NEW CONSTRUCTION AND VERIFY ALL JURISDICTIONAL SETBACKS AND BUFFERS PRIOR TO START OF ANY WORK.
7. EXISTING UTILITIES WHICH ARE NOT TO BE REMOVED OR ABANDONED SHALL REMAIN OPERATIONAL AT ALL TIMES. APPROPRIATE EXISTING UTILITIES SHALL REMAIN IN SERVICE UNTIL REPLACEMENT/RELOCATED UTILITIES ARE OPERATIONAL.

DEMOLITION NOTES

- 1 REMOVE EXISTING ELECTRIC CONDUIT/DUCTBANK AND ALL ASSOCIATED STRUCTURES AND POLE. POLES SALVAGED FOR REUSE.
- 2 REMOVE EXISTING WATER PIPE AND ALL ASSOCIATED STRUCTURES
- 3 REMOVE EXISTING STORM DRAIN PIPE AND ALL ASSOCIATED STRUCTURES, INLETS, AND RIP-RAP
- 4 REMOVE EXISTING SANITARY PIPE AND ALL ASSOCIATED STRUCTURES
- 5 REMOVE EXISTING GAS PIPE AND ALL ASSOCIATED STRUCTURES
- 6 REMOVE EXISTING TELECOMMUNICATIONS CONDUIT/DUCTBANK AND ALL ASSOCIATED STRUCTURES
- 7 REMOVE EXISTING CONCRETE OR ASPHALT PAVEMENT AND ALL ASSOCIATED CURB/GUTTER, PAVEMENT MARKINGS, AND SIGNAGE
- 8 REMOVE EXISTING SIDEWALK/STEPS
- 9 REMOVE EXISTING RETAINING WALL AND ALL ASSOCIATED FOOTINGS
- 10 REMOVE EXISTING TREES / BRUSH
- 11 REMOVE EXISTING TREE
- 12 REMOVE EXISTING SIGN
- 13 EXISTING UTILITY TO REMAIN AND BE PROTECTED DURING CONSTRUCTION
- 14 EXISTING SECURITY CAMERA POLE TO BE SALVAGED FOR REUSE, CONTRACTOR TO COORDINATE WITH APL
- 15 EXISTING CURB ISLAND AND ALL ASSOCIATED CURB AND CUTTER TO BE REMOVED FOR CONSTRUCTION VEHICLE ACCESS
- 16 CUT AND CAP / BULKHEAD EXISTING UTILITY
- 17 PROTECT EXISTING FENCE DURING CONSTRUCTION
- 18 REPLACE EXISTING CURB & GUTTER IN KIND TO NEAREST JOINT AFTER UTILITY INSTALLATION

DEMOLITION LEGEND

- L.O.D. --- LIMITS OF DISTURBANCE
- - - - - REMOVE EXISTING UTILITY
- [Hatched Box] REMOVE CONCRETE OR ASPHALT PAVEMENT OR SIDEWALK/STEPS (SEE DEMOLITION NOTES)
- [Dotted Box] TEMPORARY PAVEMENT REMOVAL & RESTORATION IN KIND (UTILITY TRENCHING)
- [Solid Black Box] REPLACE EXISTING CURB & GUTTER IN KIND TO NEAREST JOINT AFTER UTILITY INSTALLATION


EXISTING LEGEND

- PROPERTY LINE
- CURB AND GUTTER
- TREE LINE / BRUSH LINE
- ☀ TREE / BUSH
- 406 MAJOR CONTOUR
- 404 MINOR CONTOUR
- - - - - DITCH
- E --- E --- ELECTRIC
- T --- T --- TELECOMMUNICATIONS
- G --- G --- GAS
- SD --- SD --- STORM
- S --- S --- SANITARY
- W --- W --- WATER
- E --- E --- ELECTRIC COMM.
- T --- T --- COMM.
- FO --- FO --- FIBER OPTIC
- G --- G --- GAS
- SD --- SD --- STORM
- S --- S --- SANITARY
- W --- W --- WATER
- ⊙ ELECTRIC POLE / LIGHT POLE
- ⊙ ELECTRIC MANHOLE
- ⊙ ELECTRIC HANDHOLE
- ⊙ COMMUNICATIONS MANHOLE
- ⊙ COMMUNICATIONS HANDHOLE
- ⊙ STORM MANHOLE AND IDENTIFIER
- ⊙ STORM INLET AND IDENTIFIER
- ⊙ STORM CLEAN OUT
- ⊙ SANITARY MANHOLE AND IDENTIFIER
- ⊙ WATER VALVE
- ⊙ WATER STRUCTURE
- ⊙ FIRE HYDRANT
- ⊙ GAS VALVE



MATCHLINE - SEE SHEET C-281


▲ PURPOSE STATEMENT (11/1/23): DESIGN OF OUTDOOR TESTING AREA 3, INCLUDING THE SOURCE OF BORROW MATERIAL, REFERRED TO AS THE EAST AND WEST BORROW AREAS.

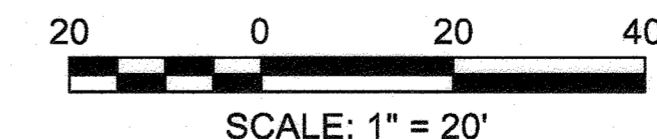

APPROVED: DEPARTMENT OF PLANNING AND ZONING
 Chief, Development Engineering Division
 Chief, Division of Land Development
 Director




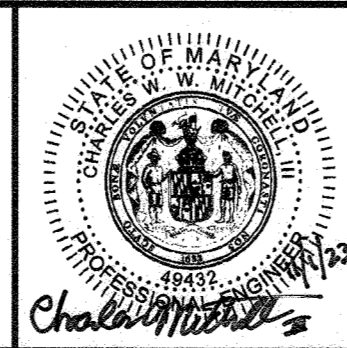

| | | | | |
|-------------|-----------|------|---|----------|
| DESIGN BY: | SHK | RK&K | ▲ New Sheet - OTA-3 and Borrow Area Modifications | 11/1/23 |
| DRAWN BY: | JMS/DTP | | | |
| CHECKED BY: | CWMM | | | |
| DATE: | 11/1/2023 | BY | NO. | REVISION |
| | | | | DATE |

OWNER/DEVELOPER
JOHNS HOPKINS APPLIED PHYSICS LABORATORY
 11100 JOHNS HOPKINS ROAD
 LAUREL, MARYLAND 20723

EX. CONDITION & DEMO PLAN - EAST BORROW AREA (PHASE 2)
 JOHNS HOPKINS UNIVERSITY - APPLIED PHYSICS LABORATORY
OUTDOOR TESTING AREAS

11100 JOHNS HOPKINS ROAD
 TAX MAP: 41 PARCEL: 123 GRID: 18 ZONED: PEG
 ELECTION DISTRICT 5 - HOWARD COUNTY, MARYLAND
 SHEET 19 OF 73

RK&K PROJECT NUMBER
 21047.013
 SCALE:
 As Shown

GENERAL NOTES

1. TOPOGRAPHIC AND SURFACE INFORMATION SHOWN WAS OBTAINED FROM FIELD SURVEY BY RK&K, REVISED ON MAY 2, 2023. UTILITY INFORMATION SHOWN WAS PROVIDED BY AJJDATA, REVISED ON MAY 2, 2023.
2. IT IS THE CONTRACTOR'S RESPONSIBILITY TO FIELD VERIFY ACTUAL SITE CONDITIONS PRIOR TO THE START OF ANY WORK. THERE IS NO WARRANTY OR GUARANTEE ON THE COMPLETENESS OR CORRECTNESS OF THE EXISTING CONDITION INFORMATION. ANY DISCREPANCY FOUND SHALL BE BROUGHT TO THE IMMEDIATE ATTENTION OF THE ARCHITECT / ENGINEER PRIOR TO THE START OF ANY WORK.
3. BEARINGS AND HORIZONTAL COORDINATES SHOWN ON THIS PLAN ARE BASED UPON MARYLAND STATE PLANE COORDINATE SYSTEM NAD83. VERTICAL ELEVATIONS SHOWN ARE BASED UPON VERTICAL DATUM NAVD83.
4. THE CONTRACTOR SHALL BE RESPONSIBLE FOR NOTIFYING "MISS UTILITY" AT 1-800-257-7777 FIVE DAYS PRIOR TO THE START OF ANY EXCAVATION WORK.
5. THE CONTRACTOR SHALL VERIFY ALL EXISTING UTILITY INVERTS AND CLEARANCES FROM NEW WORK PRIOR TO START OF ANY WORK.
6. THE CONTRACTOR SHALL STAKE OUT THE LOCATION OF ALL NEW CONSTRUCTION AND VERIFY ALL JURISDICTIONAL SETBACKS AND BUFFERS PRIOR TO START OF ANY WORK.
7. EXISTING UTILITIES WHICH ARE NOT TO BE REMOVED OR ABANDONED SHALL REMAIN OPERATIONAL AT ALL TIMES. APPROPRIATE EXISTING UTILITIES SHALL REMAIN IN SERVICE UNTIL REPLACEMENT/RELOCATED UTILITIES ARE OPERATIONAL.

DEMOLITION NOTES


- 1 REMOVE EXISTING ELECTRIC CONDUIT/DUCTBANK AND ALL ASSOCIATED STRUCTURES AND POLE. POLES SALVAGED FOR REUSE.
- 2 REMOVE EXISTING WATER PIPE AND ALL ASSOCIATED STRUCTURES
- 3 REMOVE EXISTING STORM DRAIN PIPE AND ALL ASSOCIATED STRUCTURES, INLETS, AND RIP-RAP
- 4 REMOVE EXISTING SANITARY PIPE AND ALL ASSOCIATED STRUCTURES
- 5 REMOVE EXISTING GAS PIPE AND ALL ASSOCIATED STRUCTURES
- 6 REMOVE EXISTING TELECOMMUNICATIONS CONDUIT/DUCTBANK AND ALL ASSOCIATED STRUCTURES
- 7 REMOVE EXISTING CONCRETE OR ASPHALT PAVEMENT AND ALL ASSOCIATED CURB/GUTTER, PAVEMENT MARKINGS, AND SIGNAGE
- 8 REMOVE EXISTING SIDEWALK/STEPS
- 9 REMOVE EXISTING RETAINING WALL AND ALL ASSOCIATED FOOTINGS
- 10 REMOVE EXISTING TREES / BRUSH
- 11 REMOVE EXISTING TREE
- 12 REMOVE EXISTING SIGN
- 13 EXISTING UTILITY TO REMAIN AND BE PROTECTED DURING CONSTRUCTION
- 14 EXISTING SECURITY CAMERA POLE TO BE SALVAGED FOR REUSE; CONTRACTOR TO COORDINATE WITH APJ
- 15 EXISTING CURB ISLAND AND ALL ASSOCIATED CURB AND CUTTER TO BE REMOVED FOR CONSTRUCTION VEHICLE ACCESS
- 16 CUT AND CAP / BULKHEAD EXISTING UTILITY
- 17 PROTECT EXISTING FENCE DURING CONSTRUCTION
- 18 REPLACE EXISTING CURB & GUTTER IN KIND TO NEAREST JOINT AFTER UTILITY INSTALLATION

DEMOLITION LEGEND

- LOD --- LIMITS OF DISTURBANCE
- - - - - REMOVE EXISTING UTILITY
- [Hatched Box] REMOVE CONCRETE OR ASPHALT PAVEMENT OR SIDEWALK/STEPS (SEE DEMOLITION NOTES)
- [Dotted Box] TEMPORARY PAVEMENT REMOVAL & RESTORATION IN KIND (UTILITY TRENCHING)
- [Solid Black Box] REPLACE EXISTING CURB & GUTTER IN KIND TO NEAREST JOINT AFTER UTILITY INSTALLATION

EXISTING LEGEND


- PROPERTY LINE
- CURB AND GUTTER
- TREE LINE / BRUSH LINE
- TREE / BUSH
- MAJOR CONTOUR
- MINOR CONTOUR
- DITCH
- ELECTRIC
- COMMUNICATIONS
- GAS
- STORM
- SANITARY
- WATER
- ELECTRIC
- COMM.
- FIBER OPTIC
- GAS
- STORM
- SANITARY
- WATER
- ELECTRIC POLE / LIGHT POLE
- ELECTRIC MANHOLE
- ELECTRIC HANDHOLE
- COMMUNICATIONS MANHOLE
- COMMUNICATIONS HANDHOLE
- STORM MANHOLE AND IDENTIFIER
- STORM INLET AND IDENTIFIER
- STORM CLEAN OUT
- SANITARY MANHOLE AND IDENTIFIER
- WATER VALVE
- WATER STRUCTURE
- FIRE HYDRANT
- GAS VALVE

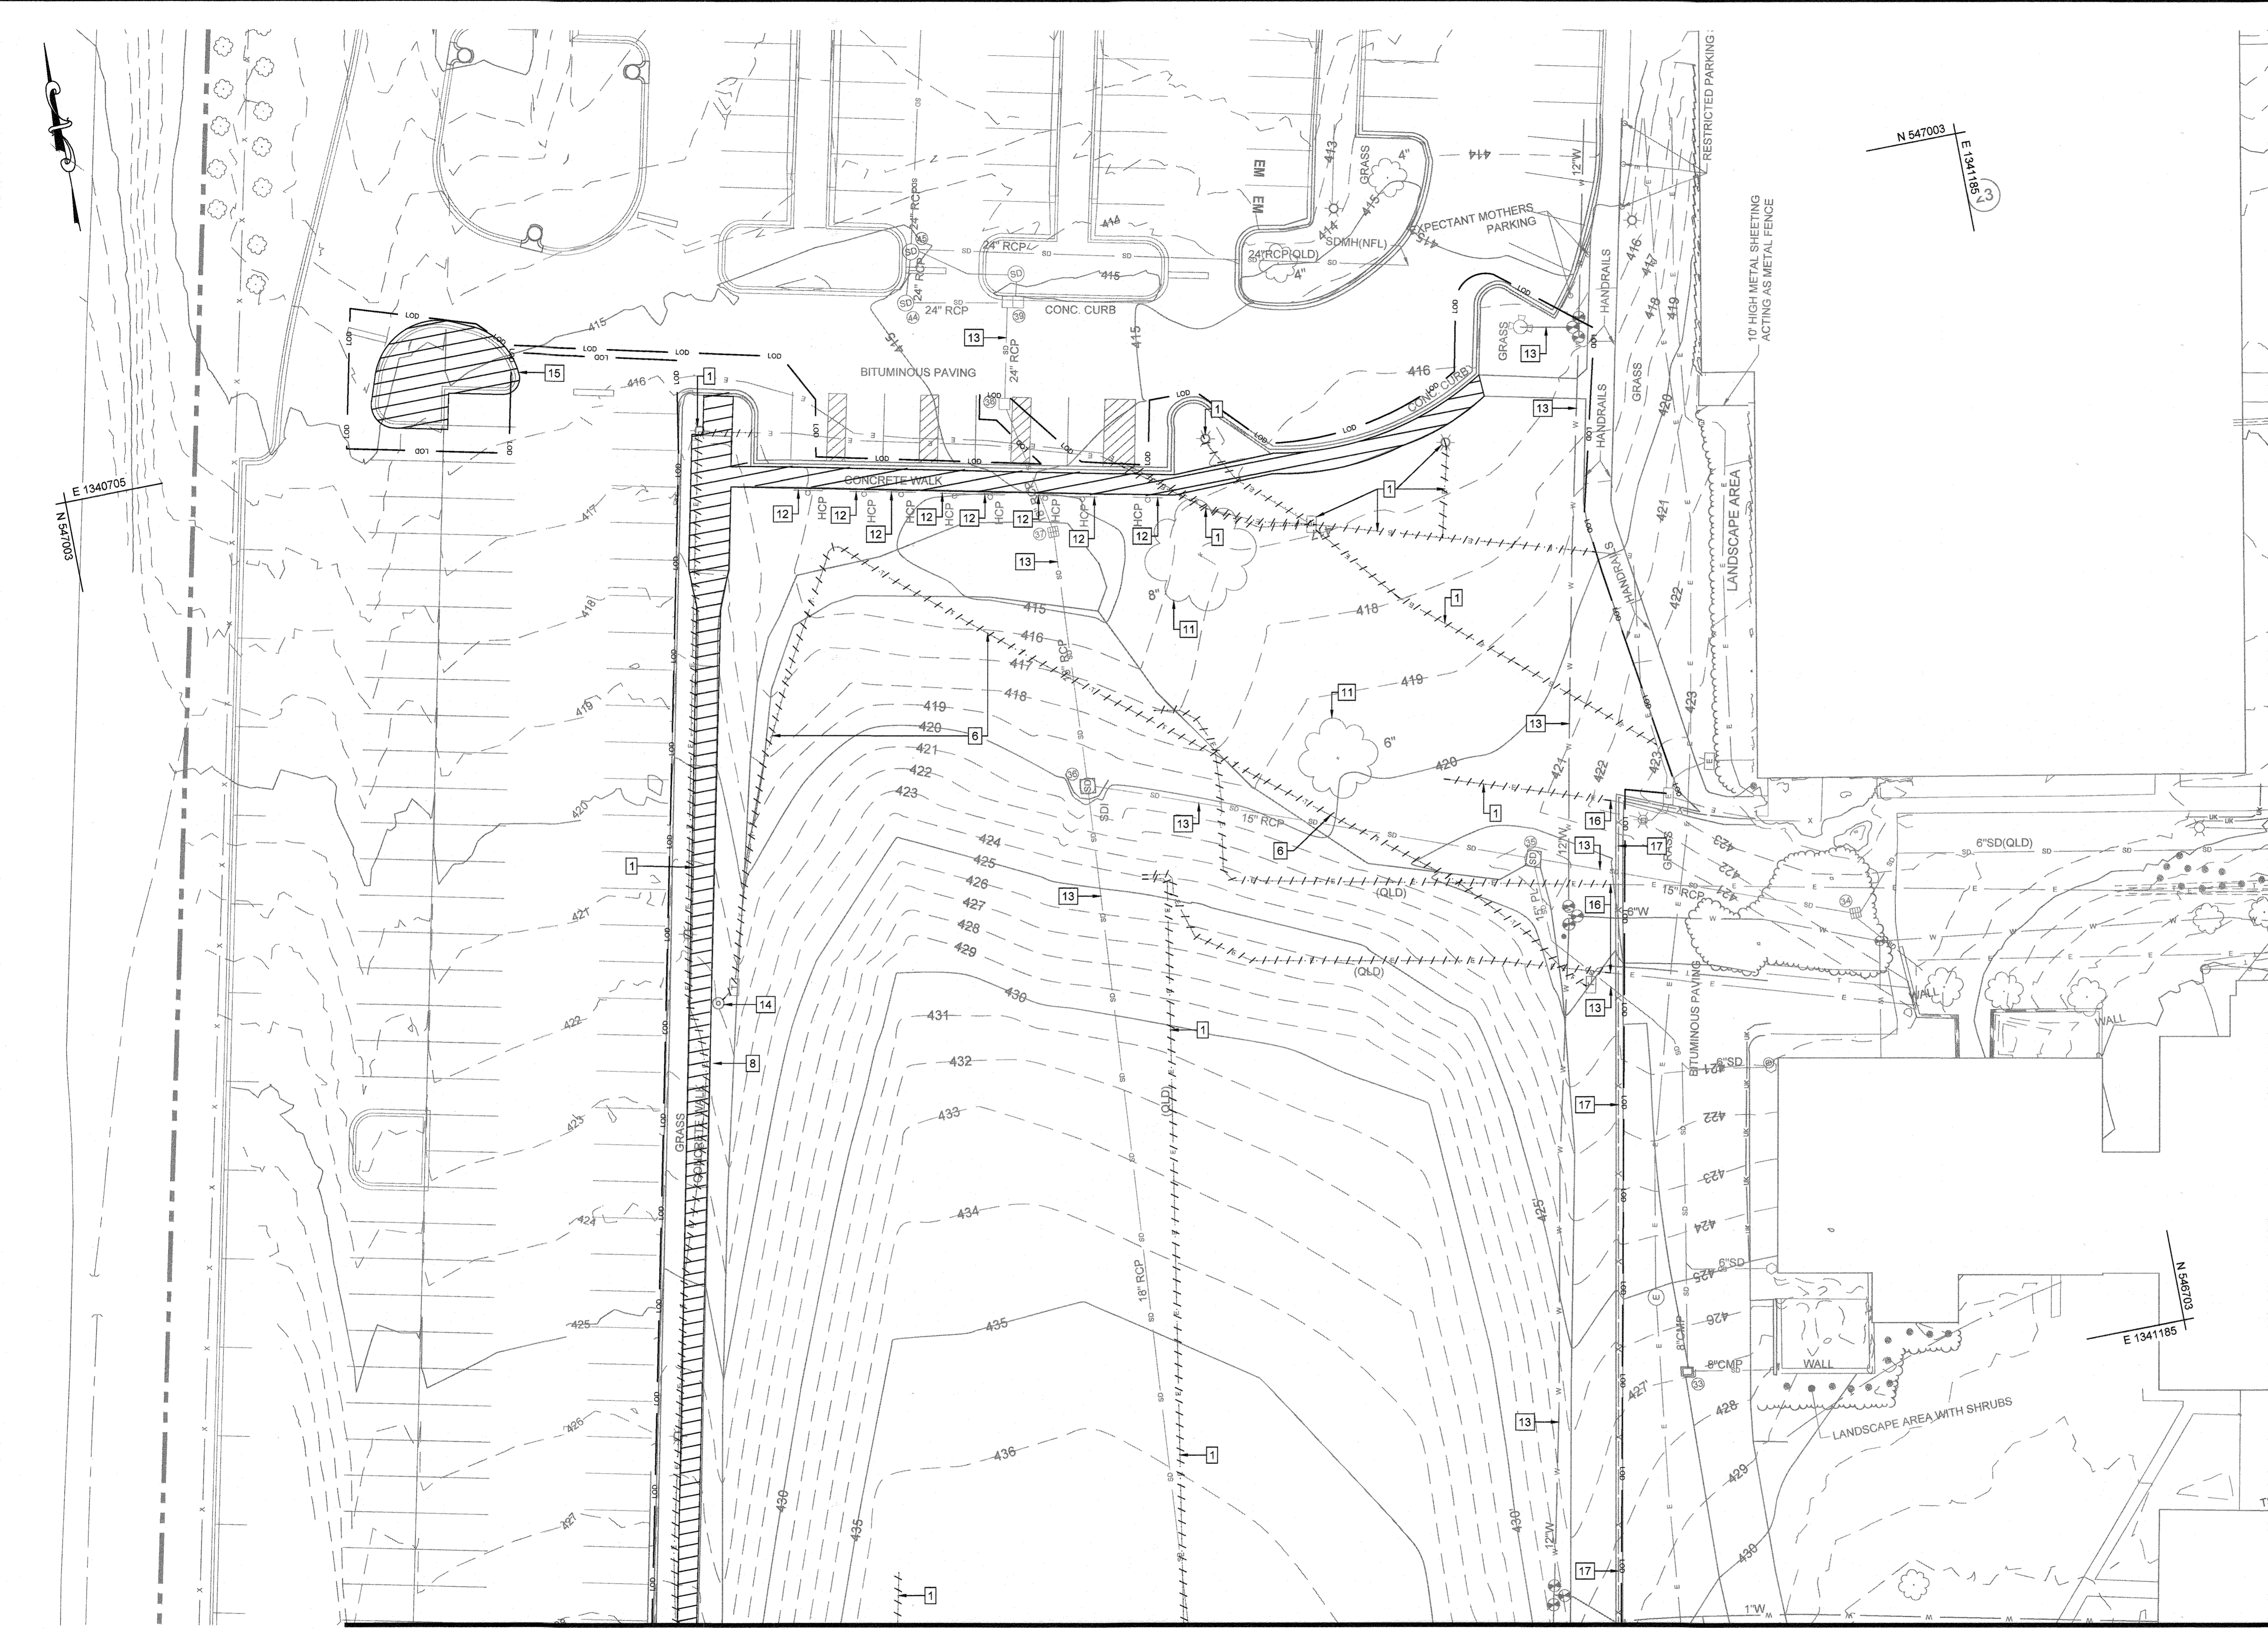

MATCHLINE - SEE SHEET C-281

MATCHLINE - SEE SHEET C-282


MATCHLINE - SEE SHEET C-285

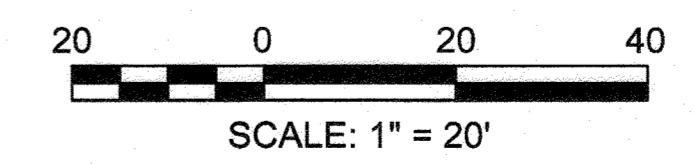

▲ PURPOSE STATEMENT (11/1/23): DESIGN OF OUTDOOR TESTING AREA 3, INCLUDING THE SOURCE OF BORROW MATERIAL, REFERRED TO AS THE EAST AND WEST BORROW AREAS.

APPROVED: DEPARTMENT OF PLANNING AND ZONING
 Chief, Development Engineering Division
 Date: 12.5.23
 Chief, Division of Land Development
 Date: 12/24/24

RK&K
 RUMMEL, KLEPPER & KAHL, LLP
 ENGINEERS, ARCHITECTS, PLANNERS, DESIGNERS
 700 East Pratt Street, Suite 500
 Baltimore, MD 21202
 Ph: 410.726.2900
 www.rk&k.com

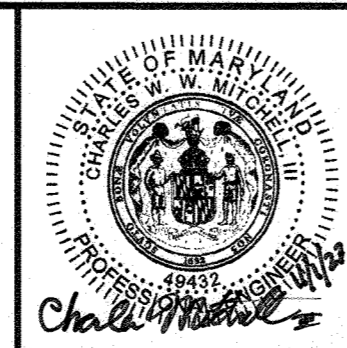

| | | | | | |
|-------------|-----------|------|-----|---|---------|
| DESIGN BY: | SHK | RK&K | ▲ | New Sheet - OTA-3 and Borrow Area Modifications | 11/1/23 |
| DRAWN BY: | JMS/DTP | | | | |
| CHECKED BY: | CWMM | | | | |
| DATE: | 11/1/2023 | BY | NO. | REVISION | DATE |

OWNER/DEVELOPER
JOHNS HOPKINS
APPLIED PHYSICS LABORATORY
 11100 JOHNS HOPKINS ROAD
 LAUREL, MARYLAND 20723

EX. CONDITION & DEMO PLAN - WEST BORROW AREA (PHASE 2)
 JOHNS HOPKINS UNIVERSITY - APPLIED PHYSICS LABORATORY
OUTDOOR TESTING AREAS
 11100 JOHNS HOPKINS ROAD
 TAX MAP: 41 PARCEL: 123 GRID: 16 ZONED: PEC
 ELECTION DISTRICT 5 - HOWARD COUNTY, MARYLAND
 SHEET 20 OF 73

RK&K PROJECT NUMBER: 21047.013
 SCALE: As Shown

MATCHLINE - SEE SHEET C-284

GENERAL NOTES

1. TOPOGRAPHIC AND SURFACE INFORMATION SHOWN WAS OBTAINED FROM FIELD SURVEY BY RK&K, REVISED ON MAY 2, 2023. UTILITY INFORMATION SHOWN WAS PROVIDED BY AIIIDATA, REVISED ON MAY 2, 2023.
2. IT IS THE CONTRACTOR'S RESPONSIBILITY TO FIELD VERIFY ACTUAL SITE CONDITIONS PRIOR TO THE START OF ANY WORK. THERE IS NO WARRANTY OR GUARANTEE ON THE COMPLETENESS OR CORRECTNESS OF THE EXISTING CONDITION INFORMATION. ANY DISCREPANCY FOUND SHALL BE BROUGHT TO THE IMMEDIATE ATTENTION OF THE ARCHITECT / ENGINEER PRIOR TO THE START OF ANY WORK.
3. BEARINGS AND HORIZONTAL COORDINATES SHOWN ON THIS PLAN ARE BASED UPON MARYLAND STATE PLANE COORDINATE SYSTEM NAD83. VERTICAL ELEVATIONS SHOWN ARE BASED UPON VERTICAL DATUM NAVD88.
4. THE CONTRACTOR SHALL BE RESPONSIBLE FOR NOTIFYING "MISS UTILITY" AT 1-800-257-7777 FIVE DAYS PRIOR TO THE START OF ANY EXCAVATION WORK.
5. THE CONTRACTOR SHALL VERIFY ALL EXISTING UTILITY INVERTS AND CLEARANCES FROM NEW WORK PRIOR TO START OF ANY WORK.
6. THE CONTRACTOR SHALL STAKE OUT THE LOCATION OF ALL NEW CONSTRUCTION AND VERIFY ALL JURISDICTIONAL SETBACKS AND BUFFERS PRIOR TO START OF ANY WORK.
7. EXISTING UTILITIES WHICH ARE NOT TO BE REMOVED OR ABANDONED SHALL REMAIN OPERATIONAL AT ALL TIMES. APPROPRIATE EXISTING UTILITIES SHALL REMAIN IN SERVICE UNTIL REPLACEMENT/RELOCATED UTILITIES ARE OPERATIONAL.

DEMOLITION NOTES


- 1 REMOVE EXISTING ELECTRIC CONDUIT/DUCTBANK AND ALL ASSOCIATED STRUCTURES AND POLE. POLES SALVAGED FOR REUSE.
- 2 REMOVE EXISTING WATER PIPE AND ALL ASSOCIATED STRUCTURES
- 3 REMOVE EXISTING STORM DRAIN PIPE AND ALL ASSOCIATED STRUCTURES, INLETS, AND RIP-RAP
- 4 REMOVE EXISTING SANITARY PIPE AND ALL ASSOCIATED STRUCTURES
- 5 REMOVE EXISTING GAS PIPE AND ALL ASSOCIATED STRUCTURES
- 6 REMOVE EXISTING TELECOMMUNICATIONS CONDUIT/DUCTBANK AND ALL ASSOCIATED STRUCTURES
- 7 REMOVE EXISTING CONCRETE OR ASPHALT PAVEMENT AND ALL ASSOCIATED CURB/GUTTER, PAVEMENT MARKINGS, AND SIGNAGE
- 8 REMOVE EXISTING SIDEWALK/STEPS
- 9 REMOVE EXISTING RETAINING WALL AND ALL ASSOCIATED FOOTINGS
- 10 REMOVE EXISTING TREES / BRUSH
- 11 REMOVE EXISTING TREE
- 12 REMOVE EXISTING SIGN
- 13 EXISTING UTILITY TO REMAIN AND BE PROTECTED DURING CONSTRUCTION
- 14 EXISTING SECURITY CAMERA POLE TO BE SALVAGED FOR REUSE, CONTRACTOR TO COORDINATE WITH APL
- 15 EXISTING CURB ISLAND AND ALL ASSOCIATED CURB AND CUTTER TO BE REMOVED FOR CONSTRUCTION VEHICLE ACCESS
- 16 CUT AND CAP / BULKHEAD EXISTING UTILITY
- 17 PROTECT EXISTING FENCE DURING CONSTRUCTION
- 18 REPLACE EXISTING CURB & GUTTER IN KIND TO NEAREST JOINT AFTER UTILITY INSTALLATION

DEMOLITION LEGEND

- LOD --- LIMITS OF DISTURBANCE
- - - - - REMOVE EXISTING UTILITY
- [Hatched Box] REMOVE CONCRETE OR ASPHALT PAVEMENT, OR SIDEWALK/STEPS (SEE DEMOLITION NOTES)
- [Dotted Box] TEMPORARY PAVEMENT REMOVAL & RESTORATION IN KIND (UTILITY TRENCHING)
- [Solid Black Box] REPLACE EXISTING CURB & GUTTER IN KIND TO NEAREST JOINT AFTER UTILITY INSTALLATION

EXISTING LEGEND


- PROPERTY LINE
- CURB AND GUTTER
- TREE LINE / BRUSH LINE
- TREE / BUSH
- MAJOR CONTOUR
- MINOR CONTOUR
- DITCH
- E --- ELECTRIC
- T --- TELECOMMUNICATIONS
- G --- GAS
- SD --- STORM
- S --- SANITARY
- W --- WATER
- E --- ELECTRIC
- T --- COMM.
- F --- FIBER OPTIC
- G --- GAS
- SD --- STORM
- S --- SANITARY
- W --- WATER
- E --- ELECTRIC POLE / LIGHT POLE
- E --- ELECTRIC MANHOLE
- E --- ELECTRIC HANDHOLE
- T --- COMMUNICATIONS MANHOLE
- T --- COMMUNICATIONS HANDHOLE
- S --- STORM MANHOLE AND IDENTIFIER
- S --- STORM INLET AND IDENTIFIER
- S --- STORM CLEAN OUT
- S --- SANITARY MANHOLE AND IDENTIFIER
- S --- WATER VALVE
- W --- WATER STRUCTURE
- W --- FIRE HYDRANT
- W --- GAS VALVE

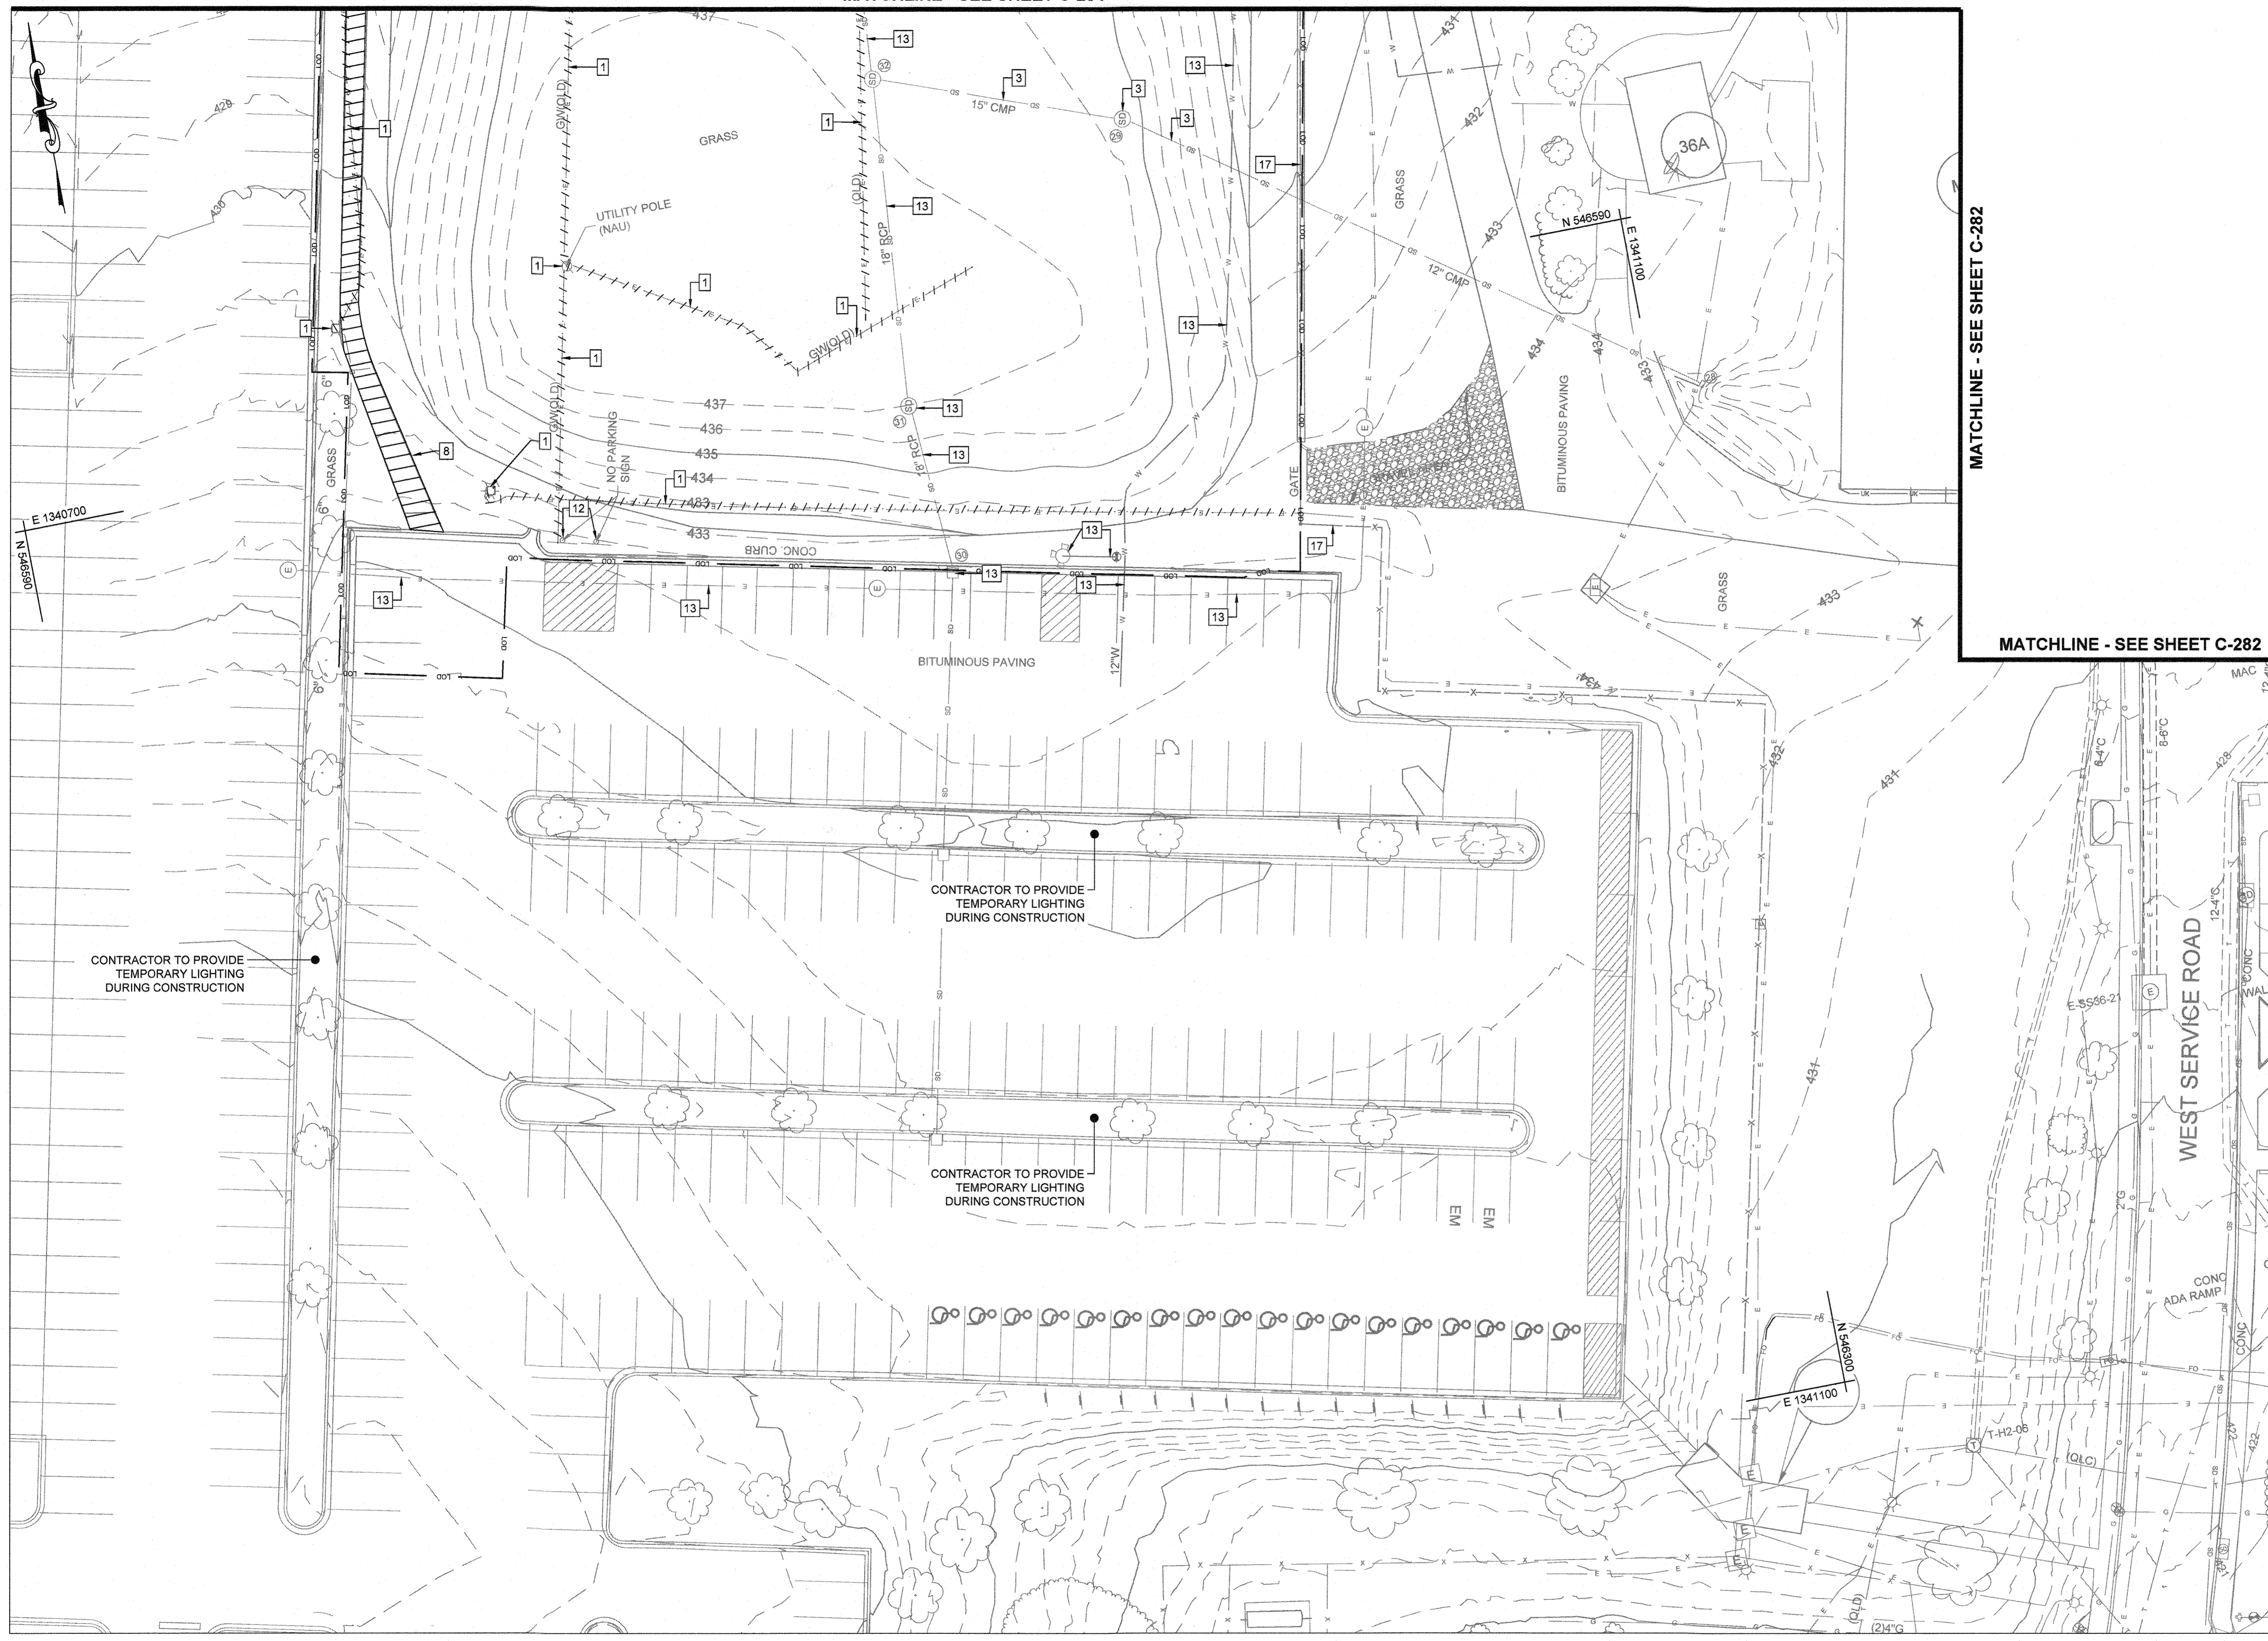

MATCHLINE - SEE SHEET C-282


MATCHLINE - SEE SHEET C-282

▲ PURPOSE STATEMENT (11/1/23): DESIGN OF OUTDOOR TESTING AREA 3, INCLUDING THE SOURCE OF BORROW MATERIAL, REFERRED TO AS THE EAST AND WEST BORROW AREAS.

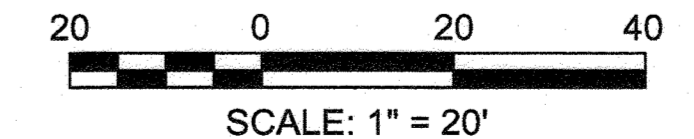

APPROVED: DEPARTMENT OF PLANNING AND ZONING
 Chief, Development Engineering Division
 Date: 12/5/23
 Chief, Division of Land Development
 Date: 2/22/24

RK&K
 RUMMEL, KLEPPER & KAHL, LLP
 ENGINEERS/ARCHITECTS/PLANNERS/SCIENTISTS
 RESPONSIVE PEOPLE. CREATIVE SOLUTIONS.
 700 East Pratt Street, Suite 500
 Baltimore, MD 21202
 Ph: 410.728.2900 Fax: 410.728.2901 www.rkk.com

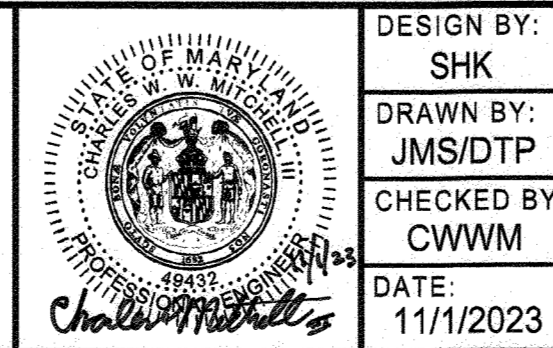

| | | | | | |
|-------------|-----------|------|-----|---|---------|
| DESIGN BY: | SHK | RK&K | 4 | New Sheet - OTA-3 and Borrow Area Modifications | 11/1/23 |
| DRAWN BY: | JMS/DTP | | | | |
| CHECKED BY: | CWWM | | | | |
| DATE: | 11/1/2023 | BY | NO. | REVISION | DATE |

OWNER/DEVELOPER
JOHNS HOPKINS APPLIED PHYSICS LABORATORY
 11100 JOHNS HOPKINS ROAD
 LAUREL, MARYLAND 20723

EX. CONDITION & DEMO PLAN - WEST BORROW AREA (PHASE 2)
 JOHNS HOPKINS UNIVERSITY - APPLIED PHYSICS LABORATORY
OUTDOOR TESTING AREAS
 11100 JOHNS HOPKINS ROAD
 PARCEL: 123 GRID: 18 ZONED: PEC
 ELECTION DISTRICT 5 - HOWARD COUNTY, MARYLAND
 SHEET 21 OF 73

C-285
 RK&K PROJECT NUMBER
 21047.013
 SCALE:
 As Shown

1. TOPOGRAPHIC AND SURFACE INFORMATION SHOWN WAS OBTAINED FROM FIELD SURVEY BY RK&K, REVISED ON MAY 2, 2023. UTILITY INFORMATION SHOWN WAS PROVIDED BY AII/DATA, REVISED ON MAY 2, 2023.
2. IT IS THE CONTRACTOR'S RESPONSIBILITY TO FIELD VERIFY ACTUAL SITE CONDITIONS PRIOR TO THE START OF ANY WORK. THERE IS NO WARRANTY OR GUARANTEE ON THE COMPLETENESS OR CORRECTNESS OF THE EXISTING CONDITION INFORMATION. ANY DISCREPANCY FOUND SHALL BE BROUGHT TO THE IMMEDIATE ATTENTION OF THE ARCHITECT / ENGINEER PRIOR TO THE START OF ANY WORK.
3. BEARINGS AND HORIZONTAL COORDINATES SHOWN ON THIS PLAN ARE BASED UPON MARYLAND STATE PLANE COORDINATE SYSTEM NAD83. VERTICAL ELEVATIONS SHOWN ARE BASED UPON VERTICAL DATUM NAVD83.
4. THE CONTRACTOR SHALL BE RESPONSIBLE FOR NOTIFYING "MISS UTILITY" AT 1-800-257-7777 FIVE DAYS PRIOR TO THE START OF ANY EXCAVATION WORK.
5. THE CONTRACTOR SHALL VERIFY ALL EXISTING UTILITY INVERTS AND CLEARANCES FROM NEW WORK PRIOR TO START OF ANY WORK.
6. THE CONTRACTOR SHALL STAKE OUT THE LOCATION OF ALL NEW CONSTRUCTION AND VERIFY ALL JURISDICTIONAL SETBACKS AND BUFFERS PRIOR TO START OF ANY WORK.
7. EXISTING UTILITIES WHICH ARE NOT TO BE REMOVED OR ABANDONED SHALL REMAIN OPERATIONAL AT ALL TIMES. APPROPRIATE EXISTING UTILITIES SHALL REMAIN IN SERVICE UNTIL REPLACEMENT/RELOCATED UTILITIES ARE OPERATIONAL.



PROPOSED GRADING LEGEND


| | |
|--------------|-------------------------|
| — 420 — | MAJOR CONTOUR |
| — 421 — | MINOR CONTOUR |
| × EX. 406.04 | EXISTING SPOT ELEVATION |
| × 406.04 | PROPOSED SPOT ELEVATION |
| 3.5% | SLOPE |

EXISTING LEGEND

| | |
|---------|---------------------------------|
| --- | PROPERTY LINE |
| --- | CURB AND GUTTER |
| --- | TREE LINE / BRUSH LINE |
| ⊙ | TREE / BUSH |
| — 406 — | MAJOR CONTOUR |
| — 404 — | MINOR CONTOUR |
| --- | DITCH |
| E | ELECTRIC |
| T | COMMUNICATIONS |
| G | GAS |
| SD | STORM |
| S | SANITARY |
| W | WATER |
| E | ELECTRIC |
| T | COMM. |
| FO | FIBER OPTIC |
| G | GAS |
| SD | STORM |
| S | SANITARY |
| W | WATER |
| ⊙ | ELECTRIC POLE / LIGHT POLE |
| ⊙ | ELECTRIC MANHOLE |
| ⊙ | ELECTRIC HANDHOLE |
| ⊙ | COMMUNICATIONS MANHOLE |
| ⊙ | COMMUNICATIONS HANDHOLE |
| ⊙ | STORM MANHOLE AND IDENTIFIER |
| ⊙ | STORM INLET AND IDENTIFIER |
| ⊙ | STORM CLEAN OUT |
| ⊙ | SANITARY MANHOLE AND IDENTIFIER |
| ⊙ | WATER VALVE |
| ⊙ | WATER STRUCTURE |
| ⊙ | FIRE HYDRANT |
| ⊙ | GAS VALVE |




▲ PURPOSE STATEMENT (11/1/23). DESIGN OF OUTDOOR TESTING AREA 3, INCLUDING THE SOURCE OF BORROW MATERIAL, REFERRED TO AS THE EAST AND WEST BORROW AREAS.

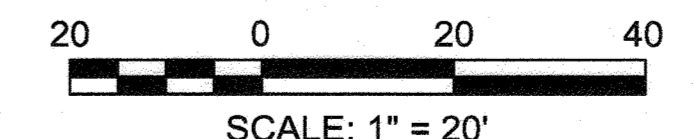

APPROVED: DEPARTMENT OF PLANNING AND ZONING
 Chief, Development Engineering Division
 Chief, Division of Land Development
 Director



PROFESSIONAL CERTIFICATION. I HEREBY CERTIFY THAT THESE DOCUMENTS WERE PREPARED OR APPROVED BY ME, AND THAT I AM A DULY LICENSED PROFESSIONAL ENGINEER UNDER THE LAWS OF THE STATE OF MARYLAND. LICENSE NO. 48432, EXPIRATION DATE: MAY 31, 2024.

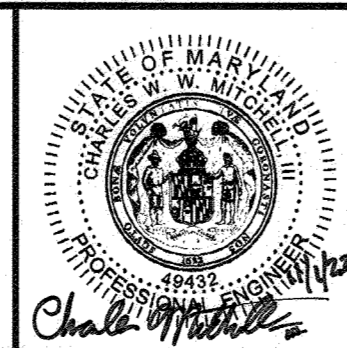

| | | | | | |
|-------------|-----------|------|-----|---|---------|
| DESIGN BY: | SHK | RK&K | ▲ | New Sheet - OTA-3 and Borrow Area Modifications | 11/1/23 |
| DRAWN BY: | JMS/DTP | | | | |
| CHECKED BY: | CWMM | | | | |
| DATE | 11/1/2023 | BY | NO. | REVISION | DATE |

OWNER/DEVELOPER
**JOHNS HOPKINS
 APPLIED PHYSICS LABORATORY**
 11100 JOHNS HOPKINS ROAD
 LAUREL, MARYLAND 20723

**SITE AND GRADING PLAN - EAST
 BORROW AREA (PHASE 2)**
 JOHNS HOPKINS UNIVERSITY - APPLIED PHYSICS LABORATORY
OUTDOOR TESTING AREAS
 11100 JOHNS HOPKINS ROAD
 TAX MAP: 41 - PARCEL: 123 - GRID: 18 - ZONE: PEC
 ELECTION DISTRICT 5 - HOWARD COUNTY, MARYLAND
 SHEET 22 OF 73

C-286
 RK&K PROJECT NUMBER
 21047.013
 SCALE:
 As Shown

- TOPOGRAPHIC AND SURFACE INFORMATION SHOWN WAS OBTAINED FROM FIELD SURVEY BY RK&K, REVISED ON MAY 2, 2023. UTILITY INFORMATION SHOWN WAS PROVIDED BY AII/DATA, REVISED ON MAY 2, 2023.
- IT IS THE CONTRACTOR'S RESPONSIBILITY TO FIELD VERIFY ACTUAL SITE CONDITIONS PRIOR TO THE START OF ANY WORK. THERE IS NO WARRANTY OR GUARANTEE ON THE COMPLETENESS OR CORRECTNESS OF THE EXISTING CONDITION INFORMATION. ANY DISCREPANCY FOUND SHALL BE BROUGHT TO THE IMMEDIATE ATTENTION OF THE ARCHITECT / ENGINEER PRIOR TO THE START OF ANY WORK.
- BEARINGS AND HORIZONTAL COORDINATES SHOWN ON THIS PLAN ARE BASED UPON MARYLAND STATE PLANE COORDINATE SYSTEM NAD83. VERTICAL ELEVATIONS SHOWN ARE BASED UPON VERTICAL DATUM NAVD88.
- THE CONTRACTOR SHALL BE RESPONSIBLE FOR NOTIFYING "MISS UTILITY" AT 1-800-257-7777 FIVE DAYS PRIOR TO THE START OF ANY EXCAVATION WORK.
- THE CONTRACTOR SHALL VERIFY ALL EXISTING UTILITY INVERTS AND CLEARANCES FROM NEW WORK PRIOR TO START OF ANY WORK.
- THE CONTRACTOR SHALL STAKE OUT THE LOCATION OF ALL NEW CONSTRUCTION AND VERIFY ALL JURISDICTIONAL SETBACKS AND BUFFERS PRIOR TO START OF ANY WORK.
- EXISTING UTILITIES WHICH ARE NOT TO BE REMOVED OR ABANDONED SHALL REMAIN OPERATIONAL AT ALL TIMES. APPROPRIATE EXISTING UTILITIES SHALL REMAIN IN SERVICE UNTIL REPLACEMENT/RELOCATED UTILITIES ARE OPERATIONAL.

**EAST BORROW AREA
LANDCOVER SUMMARY**


| | |
|----------------------------|------------|
| LIMITS OF DISTURBANCE..... | 263,170 SF |
| EX. IMPERVIOUS AREA..... | 79,300 SF |
| PROP. IMPERVIOUS AREA..... | 0 SF |
| CUT..... | 44,125 CY |
| FILL..... | 2,450 CY |
| NET CUT..... | 41,675 CY |

PROPOSED GRADING LEGEND


| | |
|--------------|-------------------------|
| — 420 — | MAJOR CONTOUR |
| — 421 — | MINOR CONTOUR |
| × EX. 406.04 | EXISTING SPOT ELEVATION |
| × 406.04 | PROPOSED SPOT ELEVATION |
| 3.5% | SLOPE |

EXISTING LEGEND

| | |
|-----|---------------------------------|
| --- | PROPERTY LINE |
| --- | CURB AND GUTTER |
| --- | TREE LINE / BRUSH LINE |
| ⊙ | TREE / BUSH |
| 406 | MAJOR CONTOUR |
| 404 | MINOR CONTOUR |
| --- | DITCH |
| E | ELECTRIC |
| T | COMMUNICATIONS |
| G | GAS |
| SD | STORM |
| S | SANITARY |
| W | WATER |
| E | ELECTRIC |
| T | COMM |
| F | FIBER OPTIC |
| G | GAS |
| SD | STORM |
| S | SANITARY |
| W | WATER |
| ⊙ | ELECTRIC POLE / LIGHT POLE |
| ⊙ | ELECTRIC MANHOLE |
| ⊙ | ELECTRIC HANDHOLE |
| ⊙ | COMMUNICATIONS MANHOLE |
| ⊙ | STORM MANHOLE AND IDENTIFIER |
| ⊙ | STORM INLET AND IDENTIFIER |
| ⊙ | STORM CLEAN OUT |
| ⊙ | SANITARY MANHOLE AND IDENTIFIER |
| ⊙ | WATER VALVE |
| ⊙ | WATER STRUCTURE |
| ⊙ | FIRE HYDRANT |
| ⊙ | GAS VALVE |

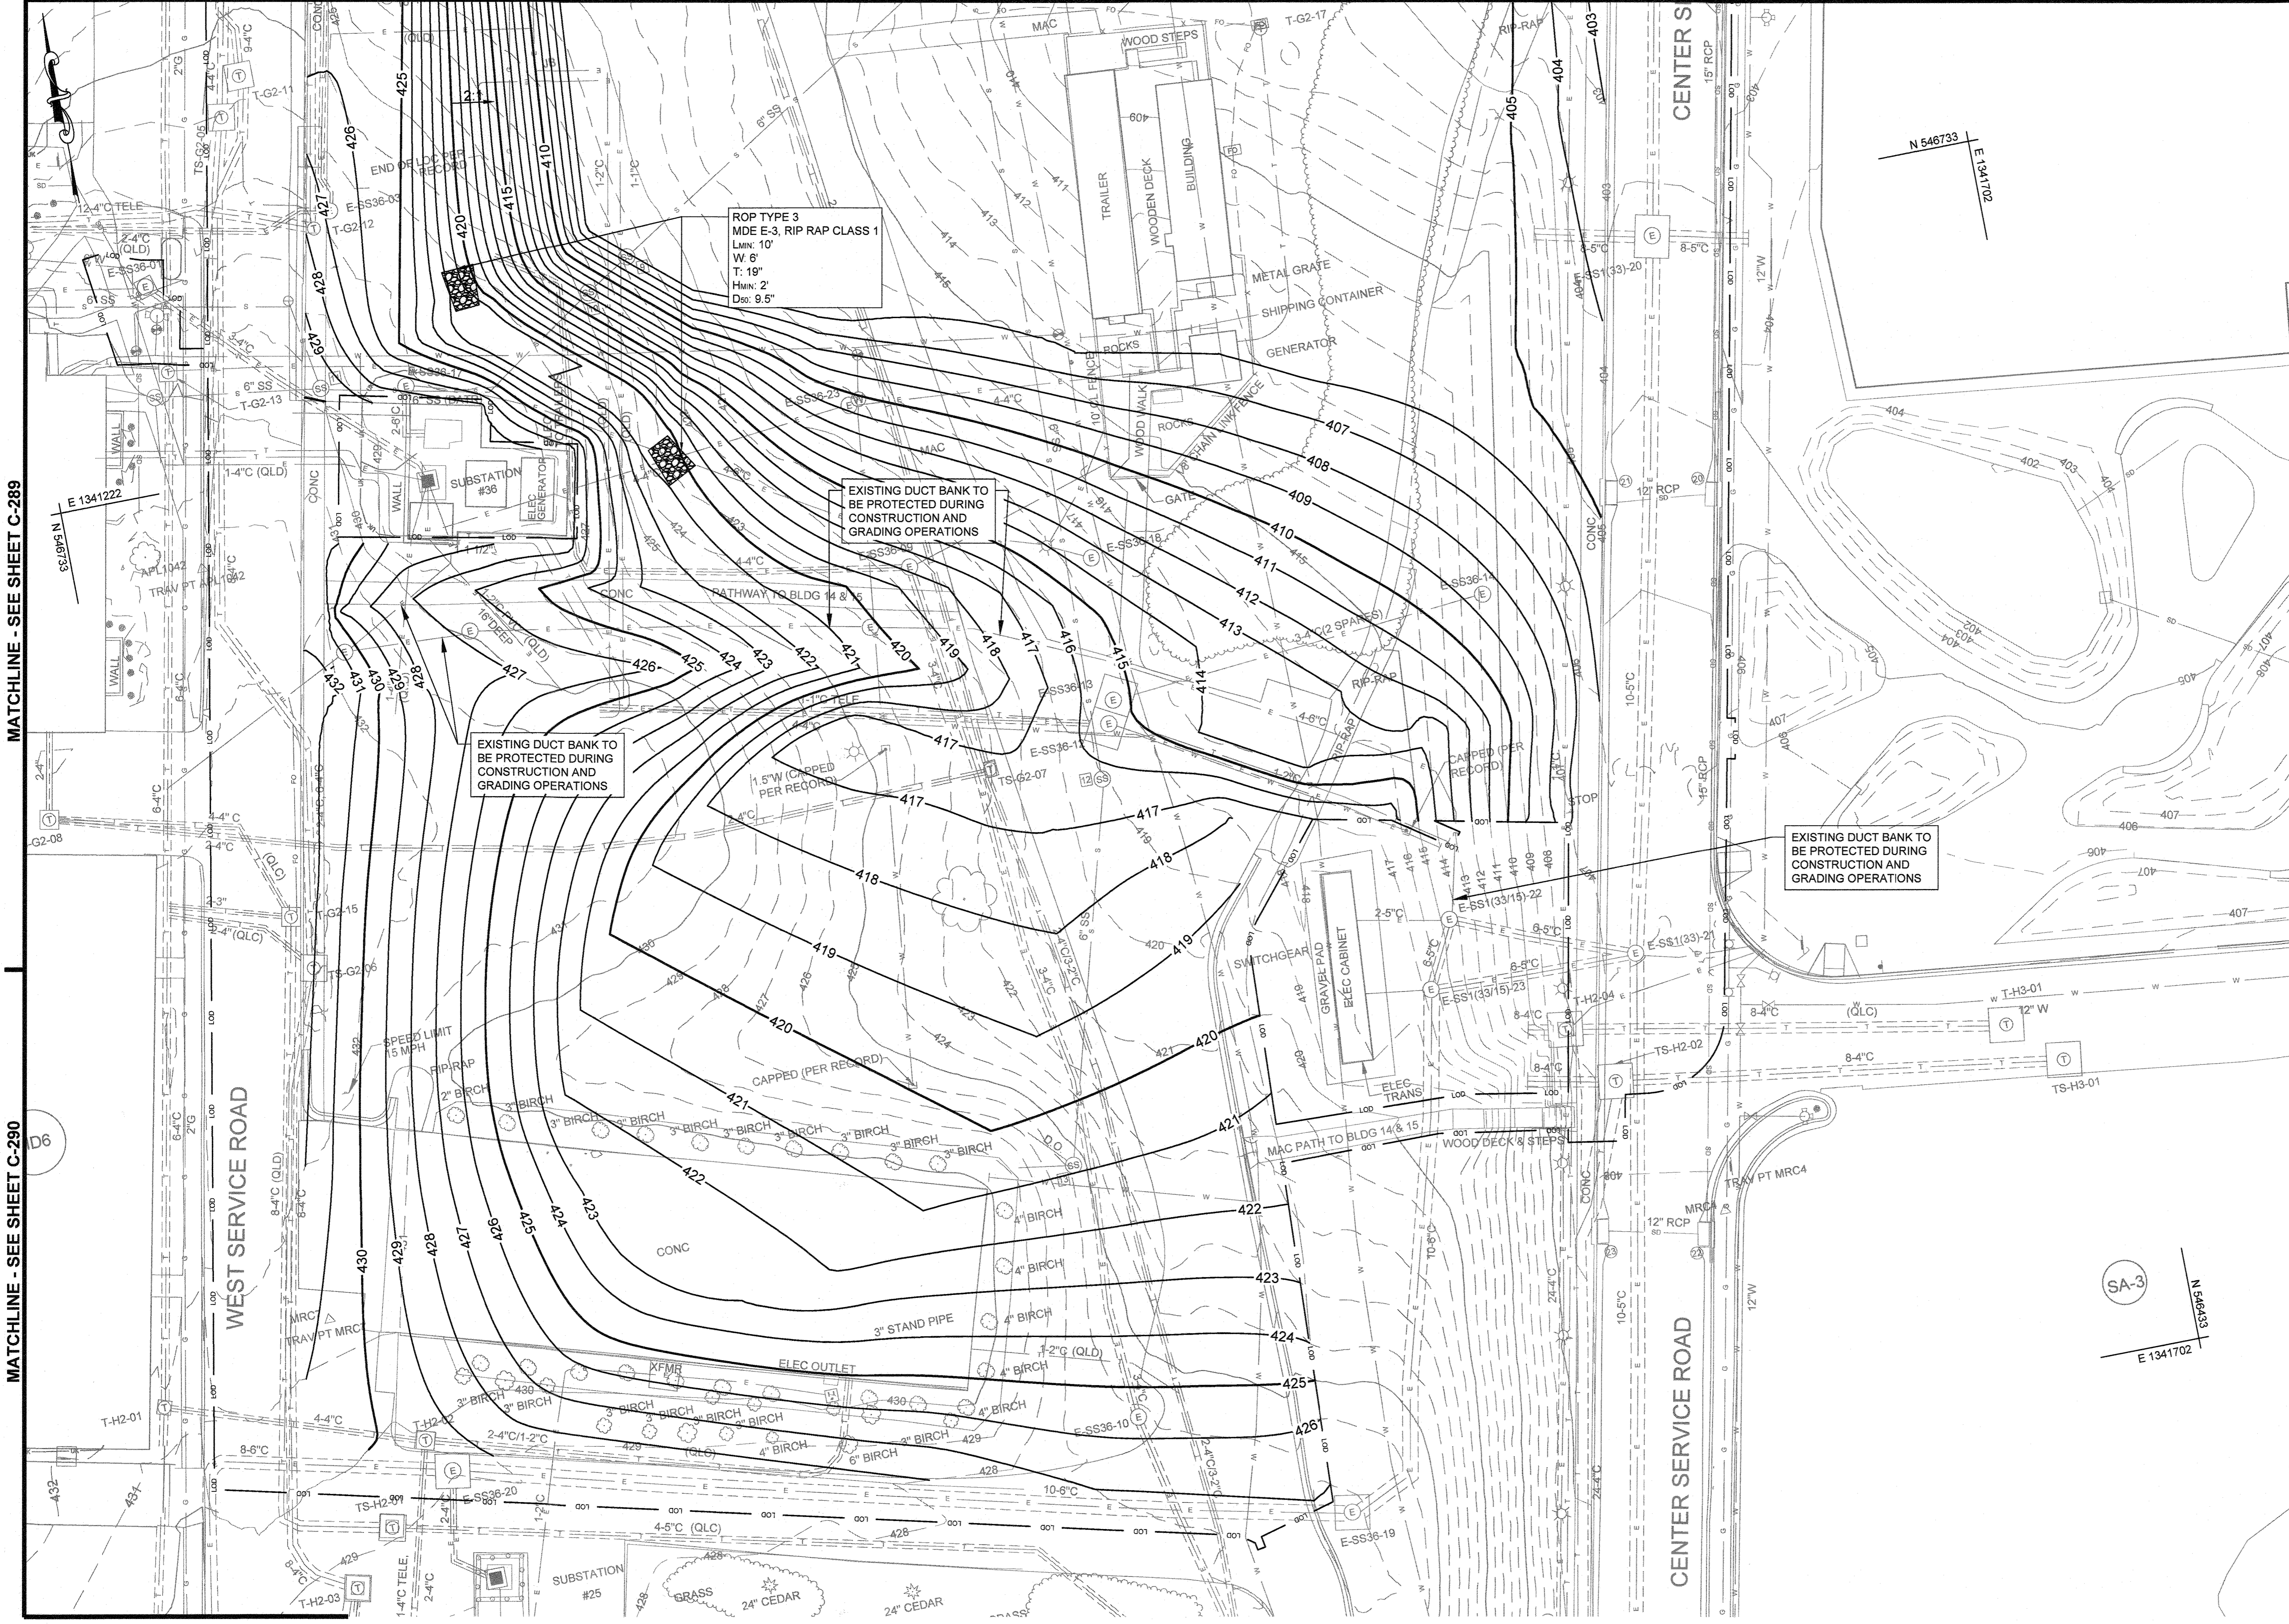

▲ PURPOSE STATEMENT (11/1/23): DESIGN OF OUTDOOR TESTING AREA 3, INCLUDING THE SOURCE OF BORROW MATERIAL, REFERRED TO AS THE EAST AND WEST BORROW AREAS.

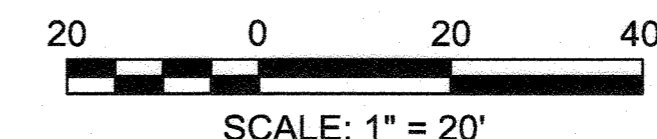

MATCHLINE - SEE SHEET C-289

MATCHLINE - SEE SHEET C-290

APPROVED: DEPARTMENT OF PLANNING AND ZONING
 Chief, Development Engineering Division
 Date: 12.5.23
 Chief, Division of Land Development
 Date: 2/22/24



PROFESSIONAL CERTIFICATION: I HEREBY CERTIFY THAT THESE DOCUMENTS WERE PREPARED OR APPROVED BY ME, AND THAT I AM A DULY LICENSED PROFESSIONAL ENGINEER UNDER THE LAWS OF THE STATE OF MARYLAND, LICENSE NO. 48432, EXPIRATION DATE: MAY 31, 2024.



| | | | |
|-------------|-----------|-----------|-----------|
| DESIGN BY: | SHK | DATE: | 11/1/2023 |
| DRAWN BY: | JMS/DTP | BY: | NO. |
| CHECKED BY: | CWMM | NO. | |
| DATE: | 11/1/2023 | REVISION: | |
| NO. | | DATE: | |

OWNER/DEVELOPER
**JOHNS HOPKINS
 APPLIED PHYSICS LABORATORY**
 11100 JOHNS HOPKINS ROAD
 LAUREL, MARYLAND 20723

**SITE AND GRADING PLAN - EAST
 BORROW AREA (PHASE 2)**
 JOHNS HOPKINS UNIVERSITY - APPLIED PHYSICS LABORATORY
OUTDOOR TESTING AREAS
 11100 JOHNS HOPKINS ROAD
 PARCEL: 123 GRID: 16 ZONED: PEG
 ELECTION DISTRICT 5 - HOWARD COUNTY, MARYLAND
 SHEET 23 OF 73

C-287
 RK&K PROJECT NUMBER
 21047.013
 SCALE:
 As Shown

GENERAL NOTES

1. TOPOGRAPHIC AND SURFACE INFORMATION SHOWN WAS OBTAINED FROM FIELD SURVEY BY RK&K, REVISED ON MAY 2, 2023. UTILITY INFORMATION SHOWN WAS PROVIDED BY AII/DATA, REVISED ON MAY 2, 2023.
2. IT IS THE CONTRACTOR'S RESPONSIBILITY TO FIELD VERIFY ACTUAL SITE CONDITIONS PRIOR TO THE START OF ANY WORK. THERE IS NO WARRANTY OR GUARANTEE ON THE COMPLETENESS OR CORRECTNESS OF THE EXISTING CONDITION INFORMATION. ANY DISCREPANCY FOUND SHALL BE BROUGHT TO THE IMMEDIATE ATTENTION OF THE ARCHITECT / ENGINEER PRIOR TO THE START OF ANY WORK.
3. BEARINGS AND HORIZONTAL COORDINATES SHOWN ON THIS PLAN ARE BASED UPON MARYLAND STATE PLANE COORDINATE SYSTEM NAD83. VERTICAL ELEVATIONS SHOWN ARE BASED UPON VERTICAL DATUM NAVD83.
4. THE CONTRACTOR SHALL BE RESPONSIBLE FOR NOTIFYING "MISS UTILITY" AT 1-800-257-7777 FIVE DAYS PRIOR TO THE START OF ANY EXCAVATION WORK.
5. THE CONTRACTOR SHALL VERIFY ALL EXISTING UTILITY INVERTS AND CLEARANCES FROM NEW WORK PRIOR TO START OF ANY WORK.
6. THE CONTRACTOR SHALL STAKE OUT THE LOCATION OF ALL NEW CONSTRUCTION AND VERIFY ALL JURISDICTIONAL SETBACKS AND BUFFERS PRIOR TO START OF ANY WORK.
7. EXISTING UTILITIES WHICH ARE NOT TO BE REMOVED OR ABANDONED SHALL REMAIN OPERATIONAL AT ALL TIMES. APPROPRIATE EXISTING UTILITIES SHALL REMAIN IN SERVICE UNTIL REPLACEMENT/RELOCATED UTILITIES ARE OPERATIONAL.

**EAST BORROW AREA
LANDCOVER SUMMARY**

| | |
|----------------------------|------------|
| LIMITS OF DISTURBANCE..... | 263,170 SF |
| EX. IMPERVIOUS AREA..... | 79,300 SF |
| PROP. IMPERVIOUS AREA..... | 0 SF |
| CUT..... | 44,125 CY |
| FILL..... | 2,450 CY |
| NET CUT..... | 41,675 CY |

PROPOSED GRADING LEGEND

| | |
|--------------|-------------------------|
| 420 | MAJOR CONTOUR |
| 421 | MINOR CONTOUR |
| x EX. 406.04 | EXISTING SPOT ELEVATION |
| x 406.04 | PROPOSED SPOT ELEVATION |
| 3.5% | SLOPE |


EXISTING LEGEND

| | |
|-----|---------------------------------|
| --- | PROPERTY LINE |
| --- | CURB AND GUTTER |
| --- | TREE LINE / BRUSH LINE |
| ⊙ | TREE / BUSH |
| --- | MAJOR CONTOUR |
| --- | MINOR CONTOUR |
| --- | DITCH |
| E | ELECTRIC |
| T | COMMUNICATIONS |
| G | GAS |
| SD | STORM |
| S | SANITARY |
| W | WATER |
| E | ELECTRIC |
| T | COMM. |
| FO | FIBER OPTIC |
| G | GAS |
| SD | STORM |
| S | SANITARY |
| W | WATER |
| ⊙ | ELECTRIC POLE / LIGHT POLE |
| ⊙ | ELECTRIC MANHOLE |
| ⊙ | ELECTRIC HANDLE |
| ⊙ | COMMUNICATIONS MANHOLE |
| ⊙ | COMMUNICATIONS HANDLE |
| ⊙ | STORM MANHOLE AND IDENTIFIER |
| ⊙ | STORM INLET AND IDENTIFIER |
| ⊙ | STORM CLEAN OUT |
| ⊙ | SANITARY MANHOLE AND IDENTIFIER |
| ⊙ | WATER VALVE |
| ⊙ | WATER STRUCTURE |
| ⊙ | FIRE HYDRANT |
| ⊙ | GAS VALVE |



MATCHLINE - SEE SHEET C-286


▲ PURPOSE STATEMENT (11/1/23): DESIGN OF OUTDOOR TESTING AREA 3, INCLUDING THE SOURCE OF BORROW MATERIAL, REFERRED TO AS THE EAST AND WEST BORROW AREAS.

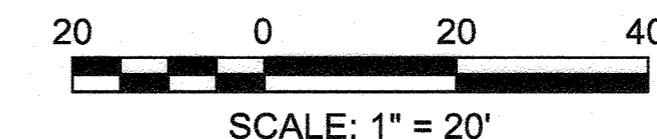

APPROVED: DEPARTMENT OF PLANNING AND ZONING
 Chief, Development Engineering Division
 Chief, Division of Land Development
 Director




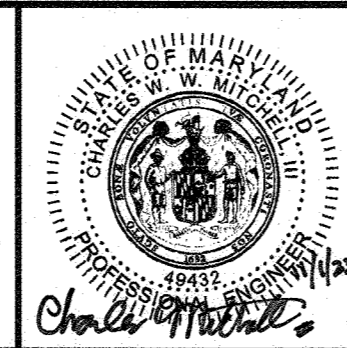

| | | | | | |
|-------------|-----------|------|-----|---|---------|
| DESIGN BY: | SHK | RK&K | 4 | New Sheet - OTA-3 and Borrow Area Modifications | 11/1/23 |
| DRAWN BY: | JMS/DTP | | | | |
| CHECKED BY: | CWMM | | | | |
| DATE: | 11/1/2023 | BY | NO. | REVISION | DATE |

OWNER/DEVELOPER
**JOHNS HOPKINS
 APPLIED PHYSICS LABORATORY**
 11100 JOHNS HOPKINS ROAD
 LAUREL, MARYLAND 20723

**SITE AND GRADING PLAN - EAST
 BORROW AREA (PHASE 2)**
 JOHNS HOPKINS UNIVERSITY - APPLIED PHYSICS LABORATORY
OUTDOOR TESTING AREAS

11100 JOHNS HOPKINS ROAD
 TAX MAP: 41 PARCEL: 123 GRID: 16 ZONED: PEC
 ELECTION DISTRICT 5 - HOWARD COUNTY, MARYLAND
 SHEET 24 OF 73

C-288
 RK&K PROJECT NUMBER
 21047.013
 SCALE:
 As Shown

GENERAL NOTES

1. TOPOGRAPHIC AND SURFACE INFORMATION SHOWN WAS OBTAINED FROM FIELD SURVEY BY RK&K, REVISED ON MAY 2, 2023. UTILITY INFORMATION SHOWN WAS PROVIDED BY AII/DATA, REVISED ON MAY 2, 2023.
2. IT IS THE CONTRACTOR'S RESPONSIBILITY TO FIELD VERIFY ACTUAL SITE CONDITIONS PRIOR TO THE START OF ANY WORK. THERE IS NO WARRANTY OR GUARANTEE ON THE COMPLETENESS OR CORRECTNESS OF THE EXISTING CONDITION INFORMATION. ANY DISCREPANCY FOUND SHALL BE BROUGHT TO THE IMMEDIATE ATTENTION OF THE ARCHITECT / ENGINEER PRIOR TO THE START OF ANY WORK.
3. BEARINGS AND HORIZONTAL COORDINATES SHOWN ON THIS PLAN ARE BASED UPON MARYLAND STATE PLANE COORDINATE SYSTEM NAD83. VERTICAL ELEVATIONS SHOWN ARE BASED UPON VERTICAL DATUM NAVD88.
4. THE CONTRACTOR SHALL BE RESPONSIBLE FOR NOTIFYING "MISS UTILITY" AT 1-800-257-7777 FIVE DAYS PRIOR TO THE START OF ANY EXCAVATION WORK.
5. THE CONTRACTOR SHALL VERIFY ALL EXISTING UTILITY INVERTS AND CLEARANCES FROM NEW WORK PRIOR TO START OF ANY WORK.
6. THE CONTRACTOR SHALL STAKE OUT THE LOCATION OF ALL NEW CONSTRUCTION AND VERIFY ALL JURISDICTIONAL SETBACKS AND BUFFERS PRIOR TO START OF ANY WORK.
7. EXISTING UTILITIES WHICH ARE NOT TO BE REMOVED OR ABANDONED SHALL REMAIN OPERATIONAL AT ALL TIMES. APPROPRIATE EXISTING UTILITIES SHALL REMAIN IN SERVICE UNTIL REPLACEMENT/RELOCATED UTILITIES ARE OPERATIONAL.

**WEST BORROW AREA
LANDCOVER SUMMARY**


| | |
|----------------------------|------------|
| LIMITS OF DISTURBANCE..... | 116,760 SF |
| EX. IMPERVIOUS AREA..... | 4,200 SF |
| PROP. IMPERVIOUS AREA..... | 0 SF |
| CUT..... | 14,850 CY |
| FILL..... | 470 CY |
| NET CUT..... | 14,380 CY |

PROPOSED GRADING LEGEND

| | |
|--------------|-------------------------|
| — 420 — | MAJOR CONTOUR |
| — 421 — | MINOR CONTOUR |
| × EX. 406.04 | EXISTING SPOT ELEVATION |
| × 406.04 | PROPOSED SPOT ELEVATION |
| 3.5% | SLOPE |


EXISTING LEGEND

| | |
|---------|---------------------------------|
| --- | PROPERTY LINE |
| --- | CURB AND GUTTER |
| --- | TREE LINE / BRUSH LINE |
| ⊙ | TREE / BUSH |
| — 406 — | MAJOR CONTOUR |
| — 404 — | MINOR CONTOUR |
| --- | DITCH |
| E | ELECTRIC |
| T | COMMUNICATIONS |
| G | GAS |
| SD | STORM |
| S | SANITARY |
| W | WATER |
| E | ELECTRIC |
| T | COMM. |
| F | FIBER OPTIC |
| G | GAS |
| SD | STORM |
| S | SANITARY |
| W | WATER |
| ⊙ | ELECTRIC POLE / LIGHT POLE |
| ⊙ | ELECTRIC MANHOLE |
| ⊙ | ELECTRIC HANDHOLE |
| ⊙ | COMMUNICATIONS MANHOLE |
| ⊙ | COMMUNICATIONS HANDHOLE |
| ⊙ | STORM MANHOLE AND IDENTIFIER |
| ⊙ | STORM INLET AND IDENTIFIER |
| ⊙ | STORM CLEAN OUT |
| ⊙ | SANITARY MANHOLE AND IDENTIFIER |
| ⊙ | WATER VALVE |
| ⊙ | WATER STRUCTURE |
| ⊙ | FIRE HYDRANT |
| ⊙ | GAS VALVE |

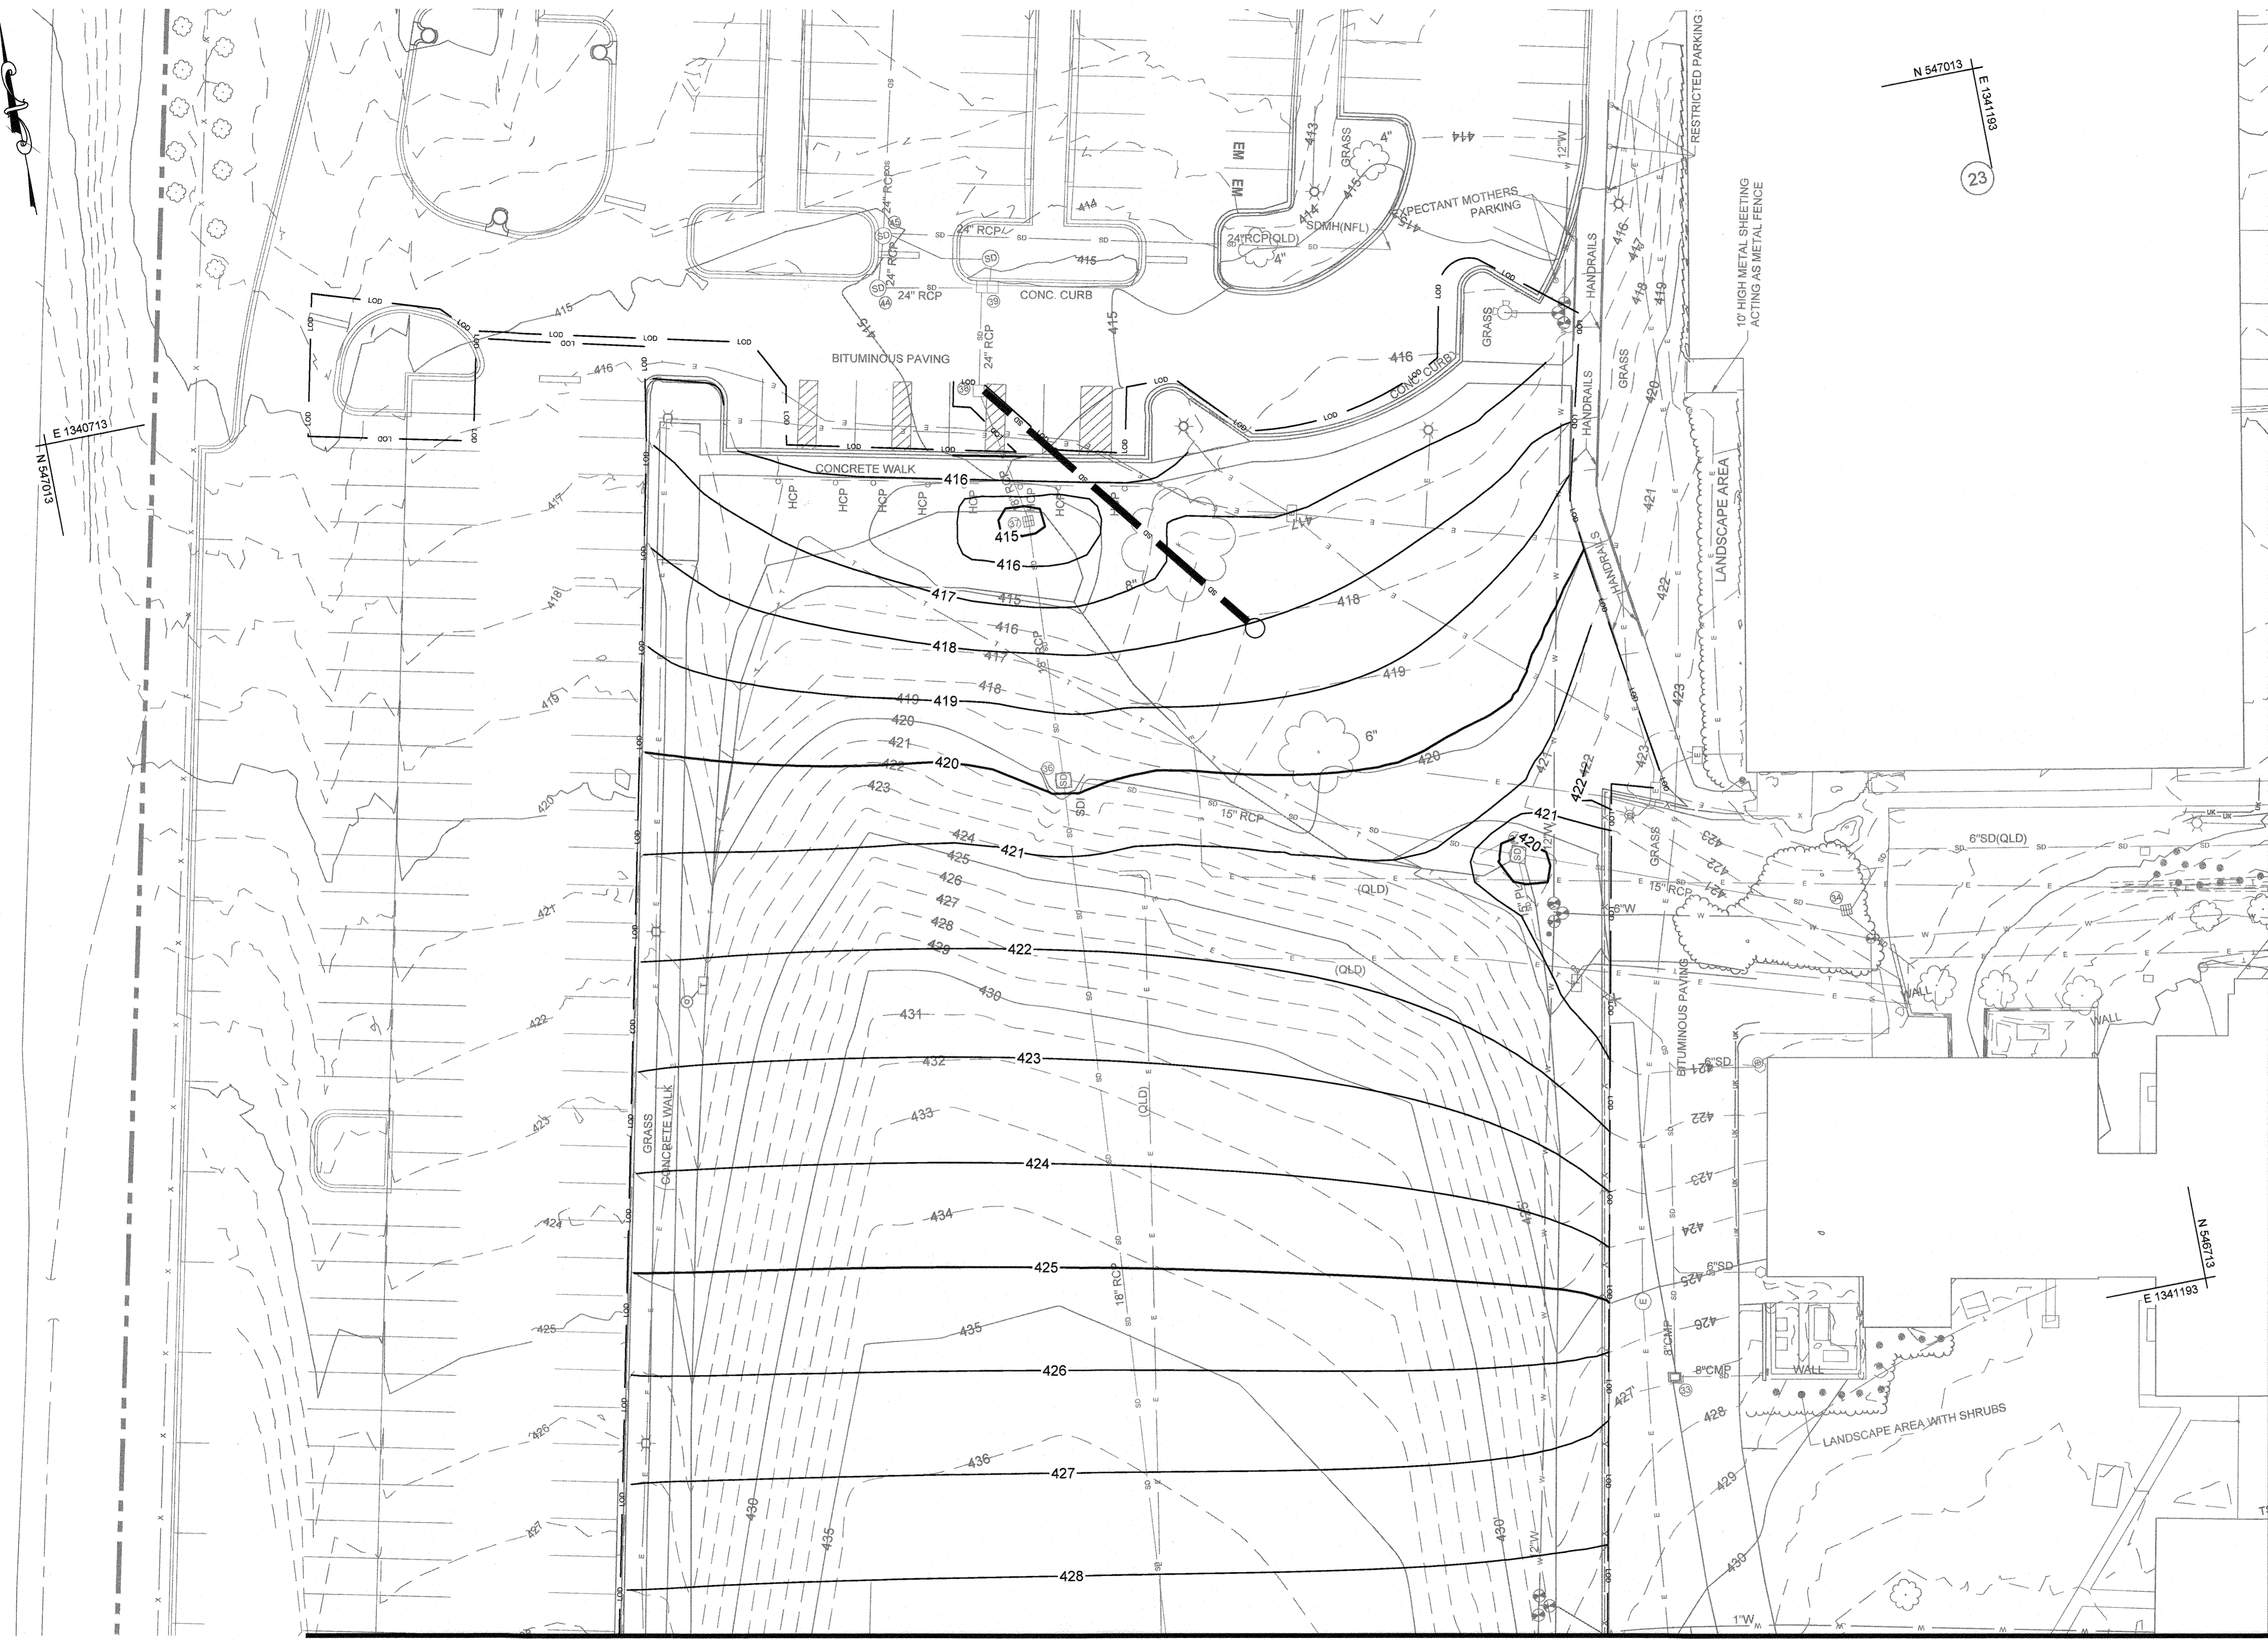

MATCHLINE - SEE SHEET C-290


▲ PURPOSE STATEMENT (11/1/23): DESIGN OF OUTDOOR TESTING AREA 3, INCLUDING THE SOURCE OF BORROW MATERIAL, REFERRED TO AS THE EAST AND WEST BORROW AREAS.

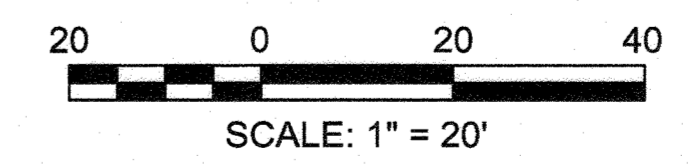

APPROVED: DEPARTMENT OF PLANNING AND ZONING
 Chief, Development Engineering Division
 Chief, Division of Land Development
 Director

RK&K
 RUMMEL, KLEPPER & KAHL, LLP
 ENGINEERS/CONSTRUCTION MANAGERS/PLANNERS/SCIENTISTS
 RESPONSIVE PEOPLE. CREATIVE SOLUTIONS.
 700 East Pratt Street, Suite 500
 Baltimore, MD 21202
 Ph: 410.728.2900 Contact: Matt Thomsson
 www.rk&k.com

PROFESSIONAL CERTIFICATION, I HEREBY CERTIFY THAT THESE DOCUMENTS WERE PREPARED OR APPROVED BY ME, AND THAT I AM A DULY LICENSED PROFESSIONAL ENGINEER UNDER THE LAWS OF THE STATE OF MARYLAND, LICENSE NO. 49432, EXPIRATION DATE: MAY 31, 2024.

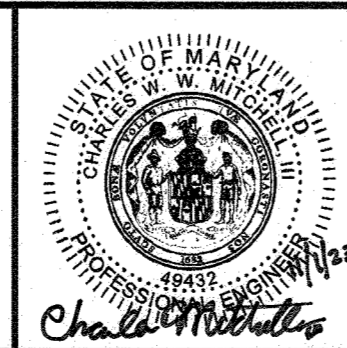

| | | | | |
|----------------------|------|-----|---|---------|
| DESIGN BY: SHK | RK&K | ▲ | New Sheet - OTA-3 and Borrow Area Modifications | 11/1/23 |
| DRAWN BY: JMS/DTP | | | | |
| CHECKED BY: CWW/M | | | | |
| DATE: 11/1/2023 | BY | NO. | REVISION | DATE |

OWNER/DEVELOPER
**JOHNS HOPKINS
 APPLIED PHYSICS LABORATORY**
 11100 JOHNS HOPKINS ROAD
 LAUREL, MARYLAND 20723


**SITE AND GRADING PLAN - WEST
 BORROW AREA (PHASE 2)**
 JOHNS HOPKINS UNIVERSITY - APPLIED PHYSICS LABORATORY
OUTDOOR TESTING AREAS
 11100 JOHNS HOPKINS ROAD
 TAX MAP: 41 PARCEL: 123 GRID: 15 ZONED: PEC
 ELECTION DISTRICT 5 - HOWARD COUNTY, MARYLAND
 SHEET 25 OF 73

C-289
 RK&K PROJECT NUMBER
 21047.013
 SCALE:
 As Shown

MATCHLINE - SEE SHEET C-289

GENERAL NOTES

1. TOPOGRAPHIC AND SURFACE INFORMATION SHOWN WAS OBTAINED FROM FIELD SURVEY BY RK&K, REVISED ON MAY 2, 2023. UTILITY INFORMATION SHOWN WAS PROVIDED BY AII/DATA, REVISED ON MAY 2, 2023.
2. IT IS THE CONTRACTOR'S RESPONSIBILITY TO FIELD VERIFY ACTUAL SITE CONDITIONS PRIOR TO THE START OF ANY WORK. THERE IS NO WARRANTY OR GUARANTEE ON THE COMPLETENESS OR CORRECTNESS OF THE EXISTING CONDITION INFORMATION. ANY DISCREPANCY FOUND SHALL BE BROUGHT TO THE IMMEDIATE ATTENTION OF THE ARCHITECT / ENGINEER PRIOR TO THE START OF ANY WORK.
3. BEARINGS AND HORIZONTAL COORDINATES SHOWN ON THIS PLAN ARE BASED UPON MARYLAND STATE PLANE COORDINATE SYSTEM NAD83. VERTICAL ELEVATIONS SHOWN ARE BASED UPON VERTICAL DATUM NAVD83.
4. THE CONTRACTOR SHALL BE RESPONSIBLE FOR NOTIFYING "MISS UTILITY" AT 1-800-257-7777 FIVE DAYS PRIOR TO THE START OF ANY EXCAVATION WORK.
5. THE CONTRACTOR SHALL VERIFY ALL EXISTING UTILITY INVERTS AND CLEARANCES FROM NEW WORK PRIOR TO START OF ANY WORK.
6. THE CONTRACTOR SHALL STAKE OUT THE LOCATION OF ALL NEW CONSTRUCTION AND VERIFY ALL JURISDICTIONAL SETBACKS AND BUFFERS PRIOR TO START OF ANY WORK.
7. EXISTING UTILITIES WHICH ARE NOT TO BE REMOVED OR ABANDONED SHALL REMAIN OPERATIONAL AT ALL TIMES. APPROPRIATE EXISTING UTILITIES SHALL REMAIN IN SERVICE UNTIL REPLACEMENT/RELOCATED UTILITIES ARE OPERATIONAL.

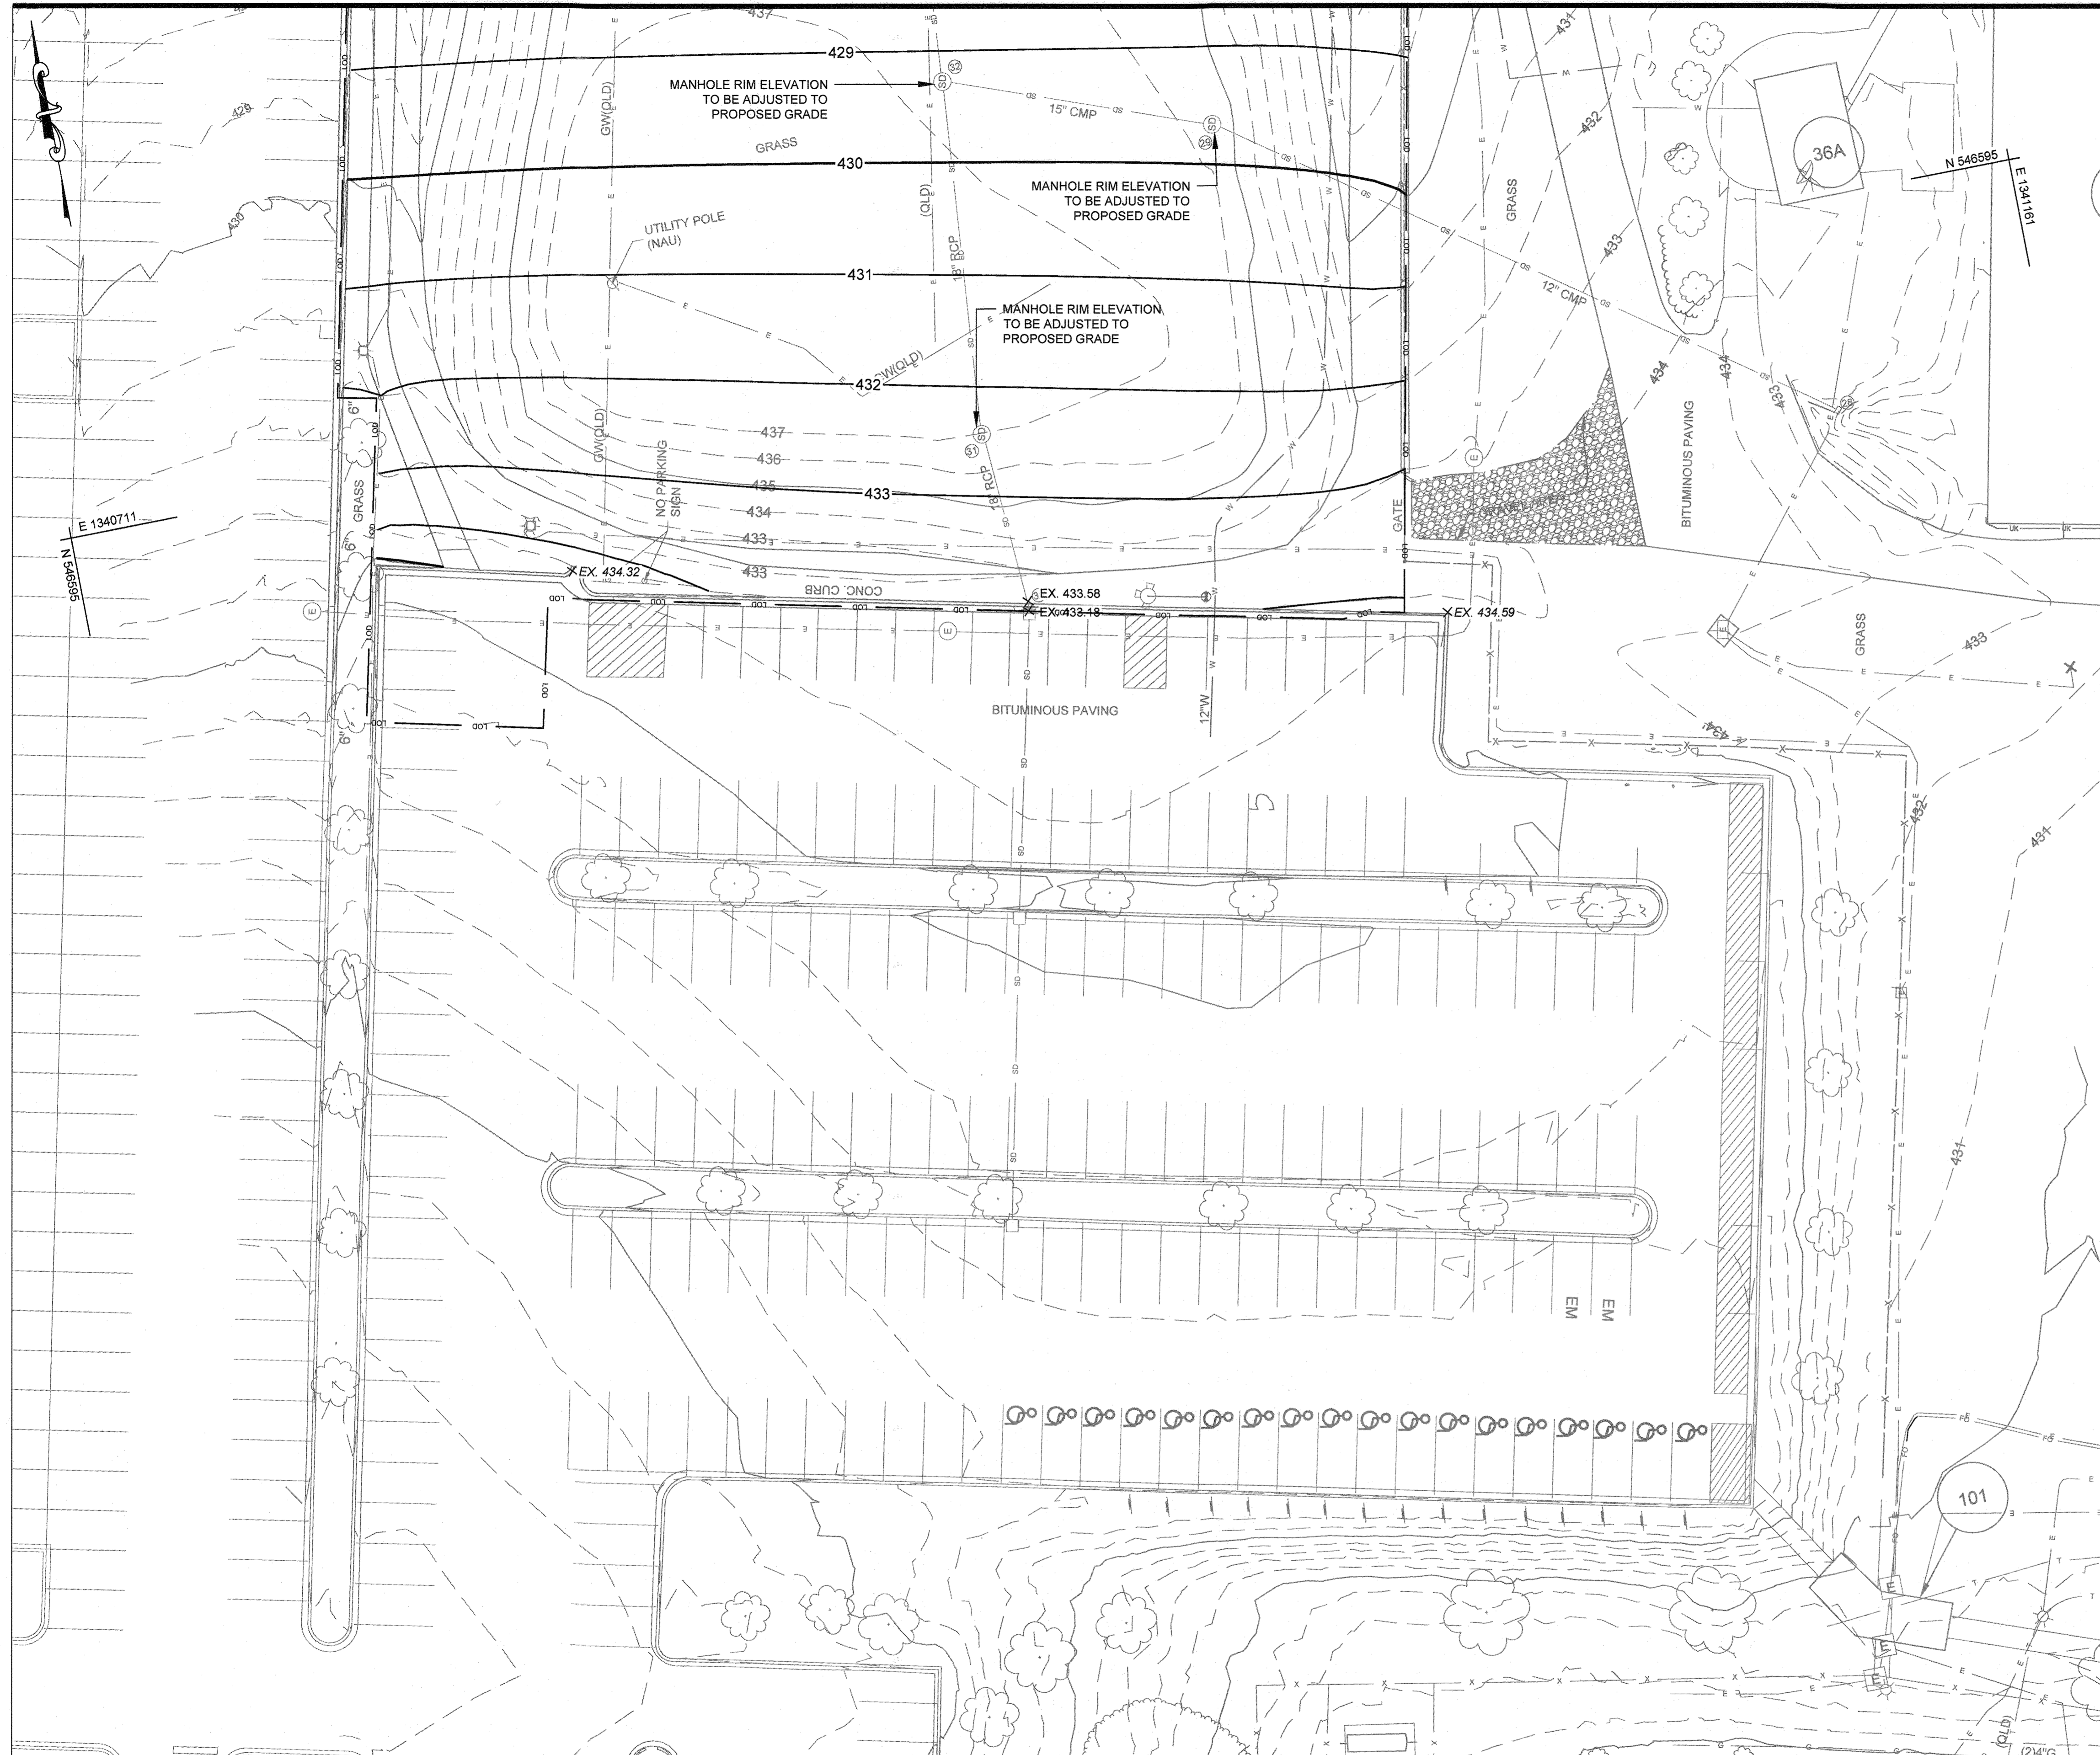

MATCHLINE - SEE SHEET C-287

MATCHLINE - SEE SHEET C-287

WEST BORROW AREA
LANDCOVER SUMMARY

| | |
|----------------------------|------------|
| LIMITS OF DISTURBANCE..... | 116,760 SF |
| EX. IMPERVIOUS AREA..... | 4,200 SF |
| PROP. IMPERVIOUS AREA..... | 0 SF |
| CUT..... | 14,850 CY |
| FILL..... | 470 CY |
| NET CUT..... | 14,380 CY |


PROPOSED GRADING LEGEND

| | |
|--------------|-------------------------|
| 420 | MAJOR CONTOUR |
| 421 | MINOR CONTOUR |
| X EX. 406.04 | EXISTING SPOT ELEVATION |
| X 406.04 | PROPOSED SPOT ELEVATION |
| 3.5% | SLOPE |

EXISTING LEGEND

| | |
|-----|---------------------------------|
| --- | PROPERTY LINE |
| --- | CURB AND GUTTER |
| --- | TREE LINE / BRUSH LINE |
| --- | TREE / BUSH |
| --- | MAJOR CONTOUR |
| --- | MINOR CONTOUR |
| --- | DITCH |
| E | ELECTRIC |
| T | COMMUNICATIONS |
| G | GAS |
| SD | STORM |
| S | SANITARY |
| W | WATER |
| E | ELECTRIC |
| T | COMM. |
| FO | FIBER OPTIC |
| G | GAS |
| SD | STORM |
| S | SANITARY |
| W | WATER |
| E | ELECTRIC POLE / LIGHT POLE |
| E | ELECTRIC MANHOLE |
| E | ELECTRIC HANDHOLE |
| T | COMMUNICATIONS MANHOLE |
| T | COMMUNICATIONS HANDHOLE |
| SD | STORM MANHOLE AND IDENTIFIER |
| SD | STORM INLET AND IDENTIFIER |
| SD | STORM CLEAN OUT |
| SD | SANITARY MANHOLE AND IDENTIFIER |
| SD | WATER VALVE |
| SD | WATER STRUCTURE |
| SD | FIRE HYDRANT |
| SD | GAS VALVE |

PURPOSE STATEMENT (11/1/23): DESIGN OF OUTDOOR TESTING AREA 3, INCLUDING THE SOURCE OF BORROW MATERIAL, REFERRED TO AS THE EAST AND WEST BORROW AREAS.

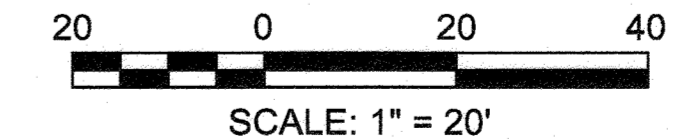


APPROVED: DEPARTMENT OF PLANNING AND ZONING
 Chief, Development Engineering Division
 Chief, Division of Land Development
 Director

Date: 12-5-23
 Date: 12/21/24
 Date: 12/22/24



PROFESSIONAL CERTIFICATION. I HEREBY CERTIFY THAT THESE DOCUMENTS WERE PREPARED OR APPROVED BY ME, AND THAT I AM A DULY LICENSED PROFESSIONAL ENGINEER UNDER THE LAWS OF THE STATE OF MARYLAND. LICENSE NO. 49432, EXPIRATION DATE: MAY 31, 2024.

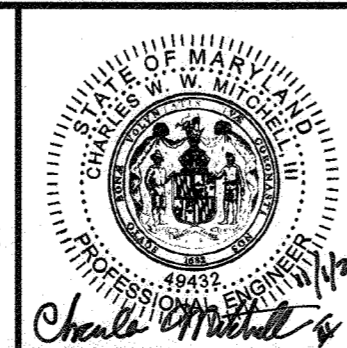


| | | | | | |
|-------------|-----------|------|---|---|---------|
| DESIGN BY: | SHK | RK&K | 4 | New Sheet - OTA-3 and Borrow Area Modifications | 11/1/23 |
| DRAWN BY: | JMS/DTP | | | | |
| CHECKED BY: | CWMM | | | | |
| DATE: | 11/1/2023 | | | | |
| BY | NO. | | | REVISION | DATE |

OWNER/DEVELOPER
**JOHNS HOPKINS
 APPLIED PHYSICS LABORATORY**
 11100 JOHNS HOPKINS ROAD
 LAUREL, MARYLAND 20723

**SITE AND GRADING PLAN - WEST
 BORROW AREA (PHASE 2)**
 JOHNS HOPKINS UNIVERSITY - APPLIED PHYSICS LABORATORY
OUTDOOR TESTING AREAS
 11100 JOHNS HOPKINS ROAD
 TAX MAP: 41 PARCEL: 123 GRID: 16 ZONED: PEC
 ELECTION DISTRICT 5 - HOWARD COUNTY, MARYLAND
 SHEET 26 OF 73

C-290
 RK&K PROJECT NUMBER
 21047.013
 SCALE:
 As Shown


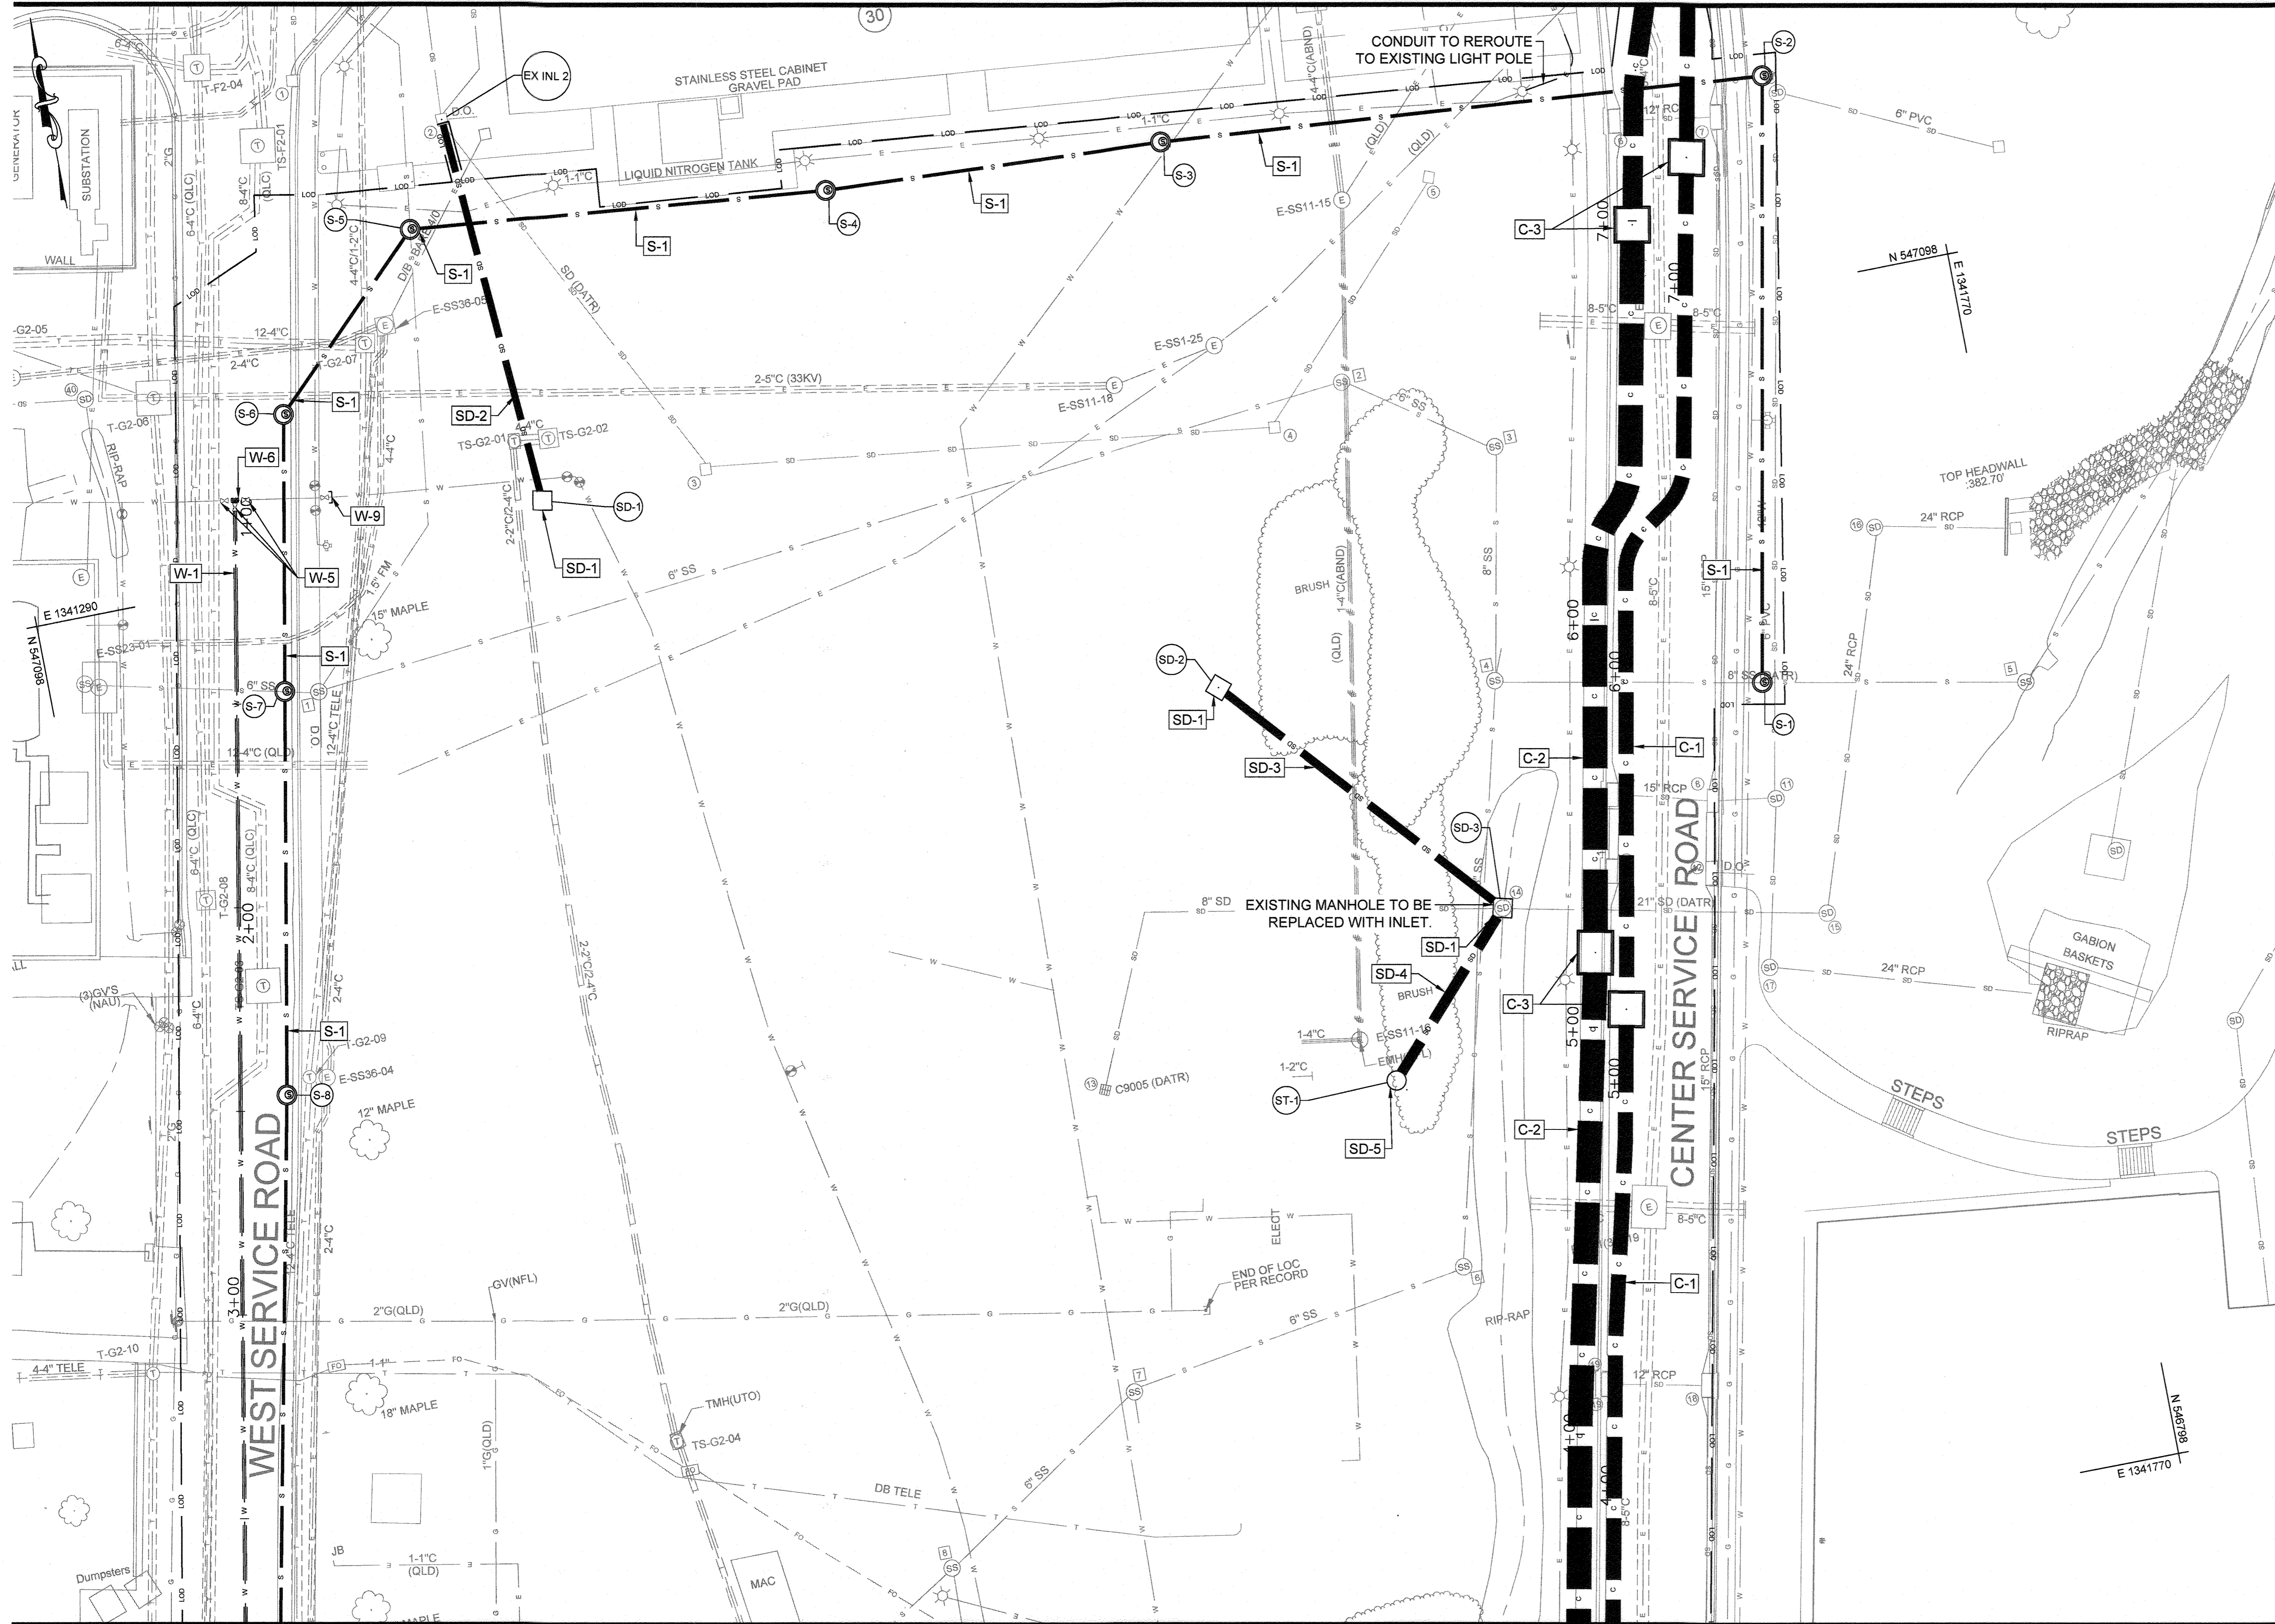


1. TOPOGRAPHIC AND SURFACE INFORMATION SHOWN WAS OBTAINED FROM FIELD SURVEY BY RK&K, COMPLETED DECEMBER 23, 2021. UTILITY INFORMATION SHOWN WAS PROVIDED BY A/J/DATA ON FEBRUARY 4, 2022.
2. IT IS THE CONTRACTOR'S RESPONSIBILITY TO FIELD VERIFY ACTUAL SITE CONDITIONS PRIOR TO THE START OF ANY WORK. THERE IS NO WARRANTY OR GUARANTEE ON THE COMPLETENESS OR CORRECTNESS OF THE EXISTING CONDITION INFORMATION. ANY DISCREPANCY FOUND SHALL BE BROUGHT TO THE IMMEDIATE ATTENTION OF THE ARCHITECT/ENGINEER PRIOR TO THE START OF ANY WORK.
3. BEARINGS AND HORIZONTAL COORDINATES SHOWN ON THIS PLAN ARE BASED UPON MARYLAND STATE PLANE COORDINATE SYSTEM NAD83. VERTICAL ELEVATIONS SHOWN ARE BASED UPON VERTICAL DATUM NAVD88.
4. THE LOCATION OF EXISTING UNDERGROUND UTILITIES IS SHOWN IN AN APPROXIMATE WAY ONLY, BASED UPON FIELD OBSERVATIONS AND RECORD DOCUMENTS. THEY HAVE NOT BEEN COMPARED TO OR VERIFIED WITH FIELD TEST PITS. THE CONTRACTOR SHALL BE RESPONSIBLE TO VERIFY TO HIS OWN SATISFACTION THE EXACT LOCATION, SIZE AND TYPE OF ALL EXISTING UNDERGROUND UTILITIES BEFORE COMMENCING ANY WORK. THE CONTRACTOR MUST NOTIFY THE UTILITY COMPANIES INVOLVED PRIOR TO THE START OF THE WORK. CONTRACTOR AGREES TO BE FULLY RESPONSIBLE FOR THE COST OF ANY AND ALL DAMAGES WHICH OCCUR AS A RESULT OF A FAILURE TO EXACTLY LOCATE AND PRESERVE ANY AND ALL EXISTING UTILITIES TO REMAIN.
5. THE CONTRACTOR SHALL BE RESPONSIBLE FOR NOTIFYING "MISS UTILITY" AT 1-800-257-7777 FIVE DAYS PRIOR TO THE START OF ANY EXCAVATION WORK.
6. THE CONTRACTOR SHALL VERIFY ALL EXISTING UTILITY INVERTS AND CLEARANCES FROM NEW WORK PRIOR TO START OF ANY WORK.
7. THE CONTRACTOR SHALL STATE THE LOCATION OF ALL NEW CONSTRUCTION AND VERIFY ALL JURISDICTIONAL SETBACKS AND BUFFERS PRIOR TO START OF ANY WORK.
8. EXISTING UTILITIES WHICH ARE NOT TO BE REMOVED OR ABANDONED SHALL REMAIN OPERATIONAL AT ALL TIMES. APPROPRIATE EXISTING UTILITIES SHALL REMAIN IN SERVICE UNTIL REPLACEMENT/RELOCATED UTILITIES ARE OPERATIONAL.
9. CONTRACTOR SHALL PROVIDE POSITIVE DRAINAGE AWAY FROM ALL EXISTING AND PROPOSED BUILDING ENTRANCES DURING ALL PHASES OF CONSTRUCTION, UNLESS OTHERWISE NOTED IN THESE DOCUMENTS. CONTRACTOR SHALL NOTIFY ENGINEER / OWNER IF EXISTING OR PROPOSED CONDITIONS RESTRICT ABILITY TO ACHIEVE POSITIVE DRAINAGE FROM BUILDINGS PRIOR TO THE START OF CONSTRUCTION.

UTILITY KEY NOTES

- C-1 PROPOSED 12-WAY SECURE COMMUNICATION DUCT BANK*
 - C-2 PROPOSED 24-WAY COMMUNICATION DUCT BANK*
 - C-3 TELECOMMUNICATIONS VAULT (SEE SHEETS C-297, C-298, C-294B)
 - C-4 CONNECT TO EXISTING COMMUNICATION MANHOLE (SEE SHEET C-294A)
 - S-1 8" SANITARY SEWER (GRAVITY) SCH 40 PVC
 - W-1 8" WATER DIP
 - W-2 TAP INTO EX. WATER MAIN WITH 22.5" HB WITH 8" VALVE AND VAULT STRAPPED TO WEST SIDE, FOLLOWED BY 4' PIPE AND 11.25" HB
 - W-3 45" HB
 - W-4 8"x6" TEE & BUTTRESS TO CONNECT TO EX. WATER
 - W-5 8" VALVE AND VAULT STRAPPED TO ALL THREE SIDES OF PROPOSED TEE
 - W-6 8"x8" TEE & BUTTRESS TO CONNECT TO EX. WATER
 - W-7 ANY EXISTING 4" WATER FROM THE PROPOSED TEE TO THIS POINT TO BE REPLACED WITH 6" WATER
 - W-8 EXISTING FIRE HYDRANT LINE TO BE REPLACED WITH 6" WATER, 6" VALVE & VAULT, AND NEW FIRE HYDRANT
 - W-9 8" VALVE AND VAULT STRAPPED TO PROPOSED CAP (ROADWAY VALVE BOX, PER HC DETAILS. SEE UTILITY DETAILS)
 - SD-1 4'x4' YARD INLET (HC D-412)
 - SD-2 15" STORM DRAIN
 - SD-3 18" STORM DRAIN
 - SD-4 TEMPORARY 24" STORM DRAIN SEDIMENT TRAP OUTFALL
 - SD-5 33" DIA. RISER STRUCTURE
- *WHEN 1 FT APART FROM OUTER DIAMETER, GAP TO BE FILLED WITH #57 STONE
- FOR BORROW AREA STRUCTURE TABLES, SEE SHEET C-294

▲ PURPOSE STATEMENT (11/1/23): DESIGN OF OUTDOOR TESTING AREA 3, INCLUDING THE SOURCE OF BORROW MATERIAL, REFERRED TO AS THE EAST AND WEST BORROW AREAS.

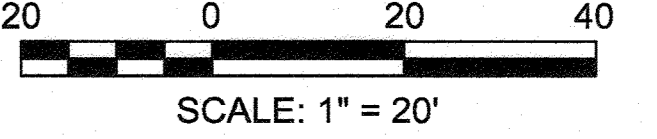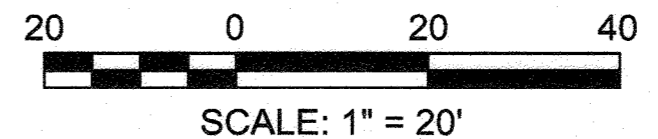

APPROVED: DEPARTMENT OF PLANNING AND ZONING
 Chief, Development Engineering Division
 Chief, Division of Land Development
 Director

Date: 11/22/24
 Date: 2/22/24

RK&K
 RUMMEL, KLEPPER & KAMM, LLP
 ENGINEERS/CONSTRUCTION MANAGERS/PLANNERS/SCIENTISTS
 RESPONSIVE PEOPLE • CREATIVE SOLUTIONS
 700 East Pratt Street, Suite 500
 Baltimore, MD 21202
 PH: 410.729.2900
 www.rk.com

PROFESSIONAL CERTIFICATION, I HEREBY CERTIFY THAT THESE DOCUMENTS WERE PREPARED OR APPROVED BY ME, AND THAT I AM A DULY LICENSED PROFESSIONAL ENGINEER UNDER THE LAWS OF THE STATE OF MARYLAND, LICENSE NO. 49432, EXPIRATION DATE: MAY 31, 2024.

DESIGN BY: SHK
 DRAWN BY: JMS/DTP
 CHECKED BY: CWWW
 DATE: 11/1/2023

| NO. | REVISION | DATE |
|-----|---|---------|
| 1 | New Sheet - OTA-3 and Borrow Area Modifications | 11/1/23 |

OWNER/DEVELOPER
JOHNS HOPKINS APPLIED PHYSICS LABORATORY
 11100 JOHNS HOPKINS ROAD
 LAUREL, MARYLAND 20723


UTILITY PLAN - EAST BORROW AREA (PHASE 2)
 JOHNS HOPKINS UNIVERSITY - APPLIED PHYSICS LABORATORY
OUTDOOR TESTING AREAS
 11100 JOHNS HOPKINS ROAD
 TAX MAP: 41 PARCEL: 123 GRID: 16 ZONED: PEC
 ELECTION DISTRICT 5 - HOWARD COUNTY, MARYLAND
 SHEET 27 OF 73

C-291
 RK&K PROJECT NUMBER 21047.013
 SCALE: As Shown


1. TOPOGRAPHIC AND SURFACE INFORMATION SHOWN WAS OBTAINED FROM FIELD SURVEY BY RK&K, COMPLETED DECEMBER 23, 2021. UTILITY INFORMATION SHOWN WAS PROVIDED BY AII/DATA ON FEBRUARY 4, 2022.
2. IT IS THE CONTRACTOR'S RESPONSIBILITY TO FIELD VERIFY ACTUAL SITE CONDITIONS PRIOR TO THE START OF ANY WORK. THERE IS NO WARRANTY OR GUARANTEE ON THE COMPLETENESS OR CORRECTNESS OF THE EXISTING CONDITION INFORMATION. ANY DISCREPANCY FOUND SHALL BE BROUGHT TO THE IMMEDIATE ATTENTION OF THE ARCHITECT/ENGINEER PRIOR TO THE START OF ANY WORK.
3. BEARINGS AND HORIZONTAL COORDINATES SHOWN ON THIS PLAN ARE BASED UPON MARYLAND STATE PLANE COORDINATE SYSTEM NAD83. VERTICAL ELEVATIONS SHOWN ARE BASED UPON VERTICAL DATUM NAVD88.
4. THE LOCATION OF EXISTING UNDERGROUND UTILITIES IS SHOWN IN AN APPROXIMATE WAY ONLY. BASED UPON FIELD OBSERVATIONS AND RECORD DOCUMENTS. THEY HAVE NOT BEEN COMPARED TO OR VERIFIED WITH FIELD TEST PITS. THE CONTRACTOR SHALL BE RESPONSIBLE TO VERIFY TO HIS OWN SATISFACTION THE EXACT LOCATION, SIZE AND TYPE OF ALL EXISTING UNDERGROUND UTILITIES BEFORE COMMENCING ANY WORK. THE CONTRACTOR MUST NOTIFY THE UTILITY COMPANIES INVOLVED PRIOR TO THE START OF THE WORK. CONTRACTOR AGREES TO BE FULLY RESPONSIBLE FOR THE COST OF ANY AND ALL DAMAGES WHICH OCCUR AS A RESULT OF A FAILURE TO EXACTLY LOCATE AND PRESERVE ANY AND ALL EXISTING UTILITIES TO REMAIN.
5. THE CONTRACTOR SHALL BE RESPONSIBLE FOR NOTIFYING "MISS UTILITY" AT 1-800-257-7777 FIVE DAYS PRIOR TO THE START OF ANY EXCAVATION WORK.
6. THE CONTRACTOR SHALL VERIFY ALL EXISTING UTILITY INVERTS AND CLEARANCES FROM NEW WORK PRIOR TO START OF ANY WORK.
7. THE CONTRACTOR SHALL STAKE OUT THE LOCATION OF ALL NEW CONSTRUCTION AND VERIFY ALL JURISDICTIONAL SETBACKS AND BUFFERS PRIOR TO START OF ANY WORK.
8. EXISTING UTILITIES WHICH ARE NOT TO BE REMOVED OR ABANDONED SHALL REMAIN OPERATIONAL AT ALL TIMES. APPROPRIATE EXISTING UTILITIES SHALL REMAIN IN SERVICE UNTIL REPLACEMENT/RELOCATED UTILITIES ARE OPERATIONAL.
9. CONTRACTOR SHALL PROVIDE POSITIVE DRAINAGE AWAY FROM ALL EXISTING AND PROPOSED BUILDING ENTRANCES DURING ALL PHASES OF CONSTRUCTION, UNLESS OTHERWISE NOTED IN THESE DOCUMENTS. CONTRACTOR SHALL NOTIFY ENGINEER / OWNER IF EXISTING OR PROPOSED CONDITIONS RESTRICT ABILITY TO ACHIEVE POSITIVE DRAINAGE FROM BUILDINGS PRIOR TO THE START OF CONSTRUCTION.

UTILITY KEY NOTES

- C-1 PROPOSED 12-WAY SECURE COMMUNICATION DUCT BANK*
 - C-2 PROPOSED 24-WAY COMMUNICATION DUCT BANK*
 - C-3 TELECOMMUNICATIONS VAULT (SEE SHEETS C-297, C-298, C-294B)
 - C-4 CONNECT TO EXISTING COMMUNICATION MANHOLE (SEE SHEET C-294A)
 - S-1 8" SANITARY SEWER (GRAVITY) SCH 40 PVC
 - W-1 8" WATER DIP
 - W-2 TAP INTO EX. WATER MAIN WITH 22.5" HB WITH 8" VALVE AND VAULT STRAPPED TO WEST SIDE, FOLLOWED BY 4' PIPE AND 11.25" HB
 - W-3 45" HB
 - W-4 8"x8" TEE & BUTTRESS TO CONNECT TO EX. WATER
 - W-5 8" VALVE AND VAULT STRAPPED TO ALL THREE SIDES OF PROPOSED TEE
 - W-6 8"x8" TEE & BUTTRESS TO CONNECT TO EX. WATER
 - W-7 ANY EXISTING 4" WATER FROM THE PROPOSED TEE TO THIS POINT TO BE REPLACED WITH 6" WATER
 - W-8 EXISTING FIRE HYDRANT LINE TO BE REPLACED WITH 6" WATER, 6" VALVE & VAULT, AND NEW FIRE HYDRANT
 - W-9 8" VALVE AND VAULT STRAPPED TO PROPOSED CAP (ROADWAY VALVE BOX, PER HC DETAILS. SEE UTILITY DETAILS)
 - SD-1 4'x4' YARD INLET (HC D-412)
 - SD-2 15" STORM DRAIN
 - SD-3 18" STORM DRAIN
 - SD-4 TEMPORARY 24" STORM DRAIN SEDIMENT TRAP OUTFALL
 - SD-5 33" DIA. RISER STRUCTURE
- *WHEN 1 FT APART FROM OUTER DIAMETER, GAP TO BE FILLED WITH #57 STONE
- FOR BORROW AREA STRUCTURE TABLES, SEE SHEET C-294

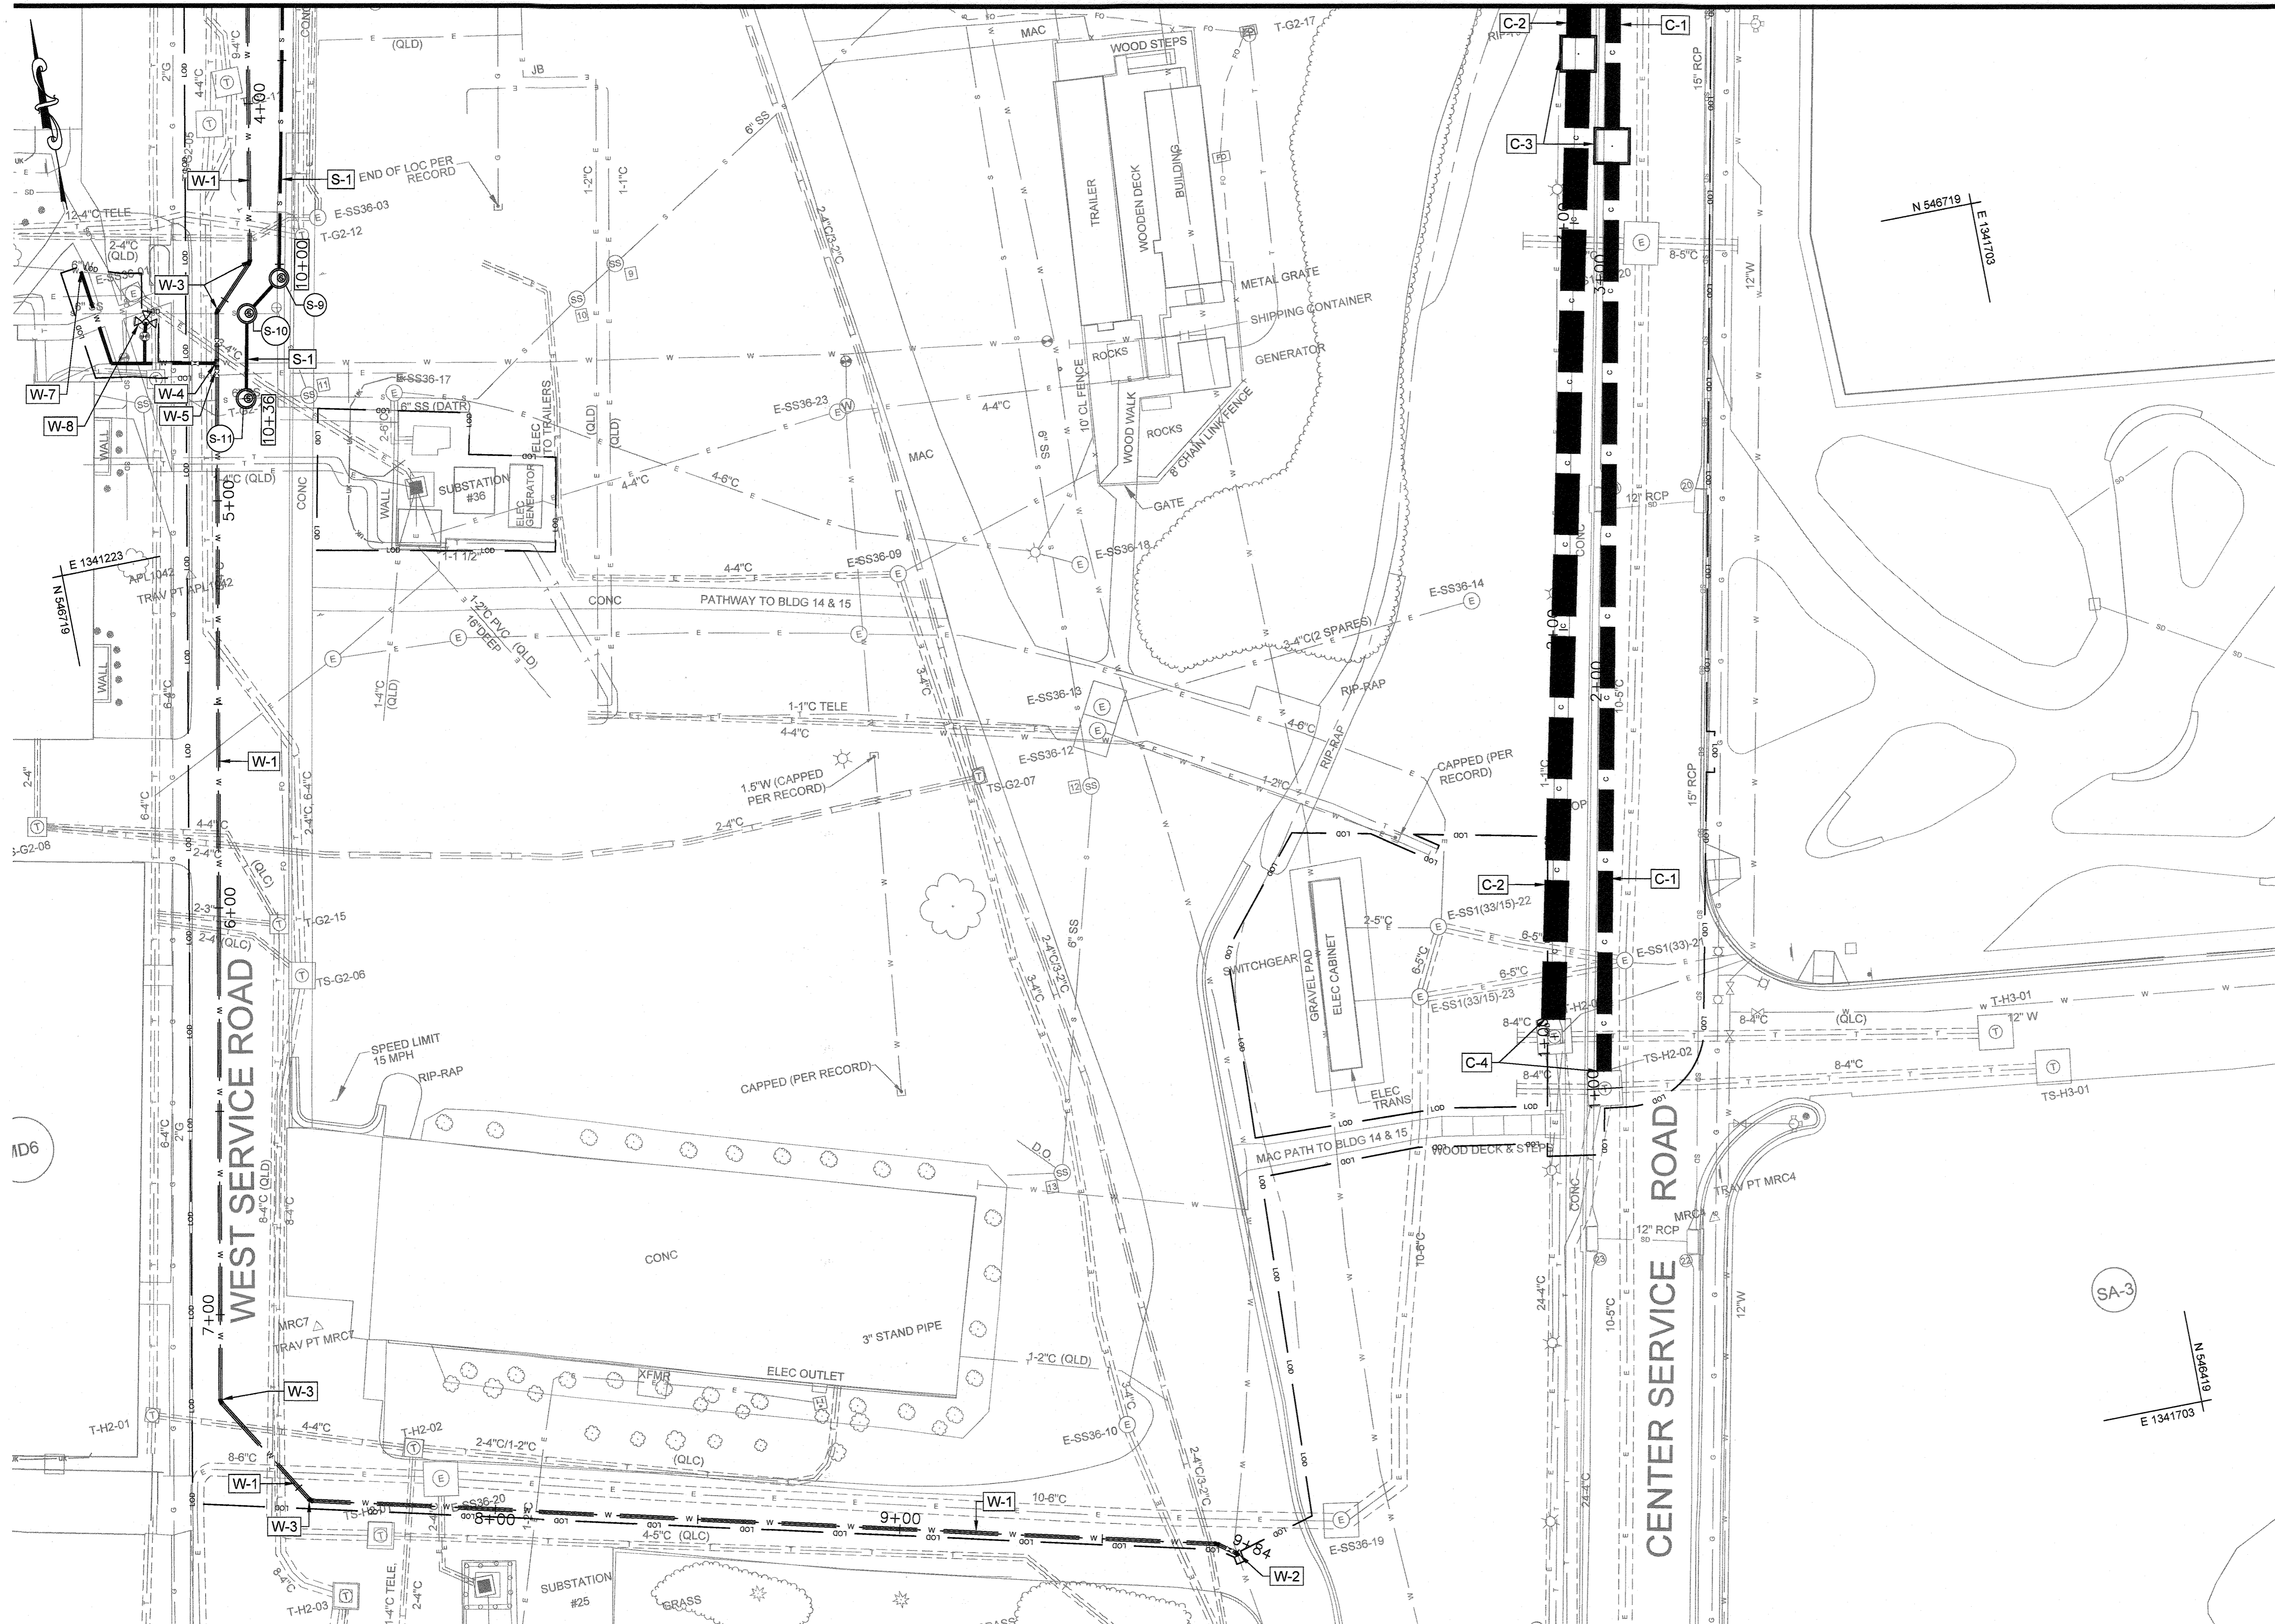

▲ PURPOSE STATEMENT (11/1/23): DESIGN OF OUTDOOR TESTING AREA 3, INCLUDING THE SOURCE OF BORROW MATERIAL REFERRED TO AS THE EAST AND WEST BORROW AREAS.

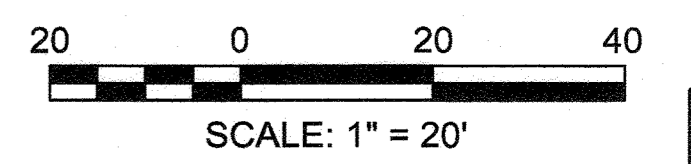


APPROVED: DEPARTMENT OF PLANNING AND ZONING
 Chief, Development Engineering Division
 Chief, Division of Land Development
 Director

Date: 12-5-23
 Date: 12/21/24

RK&K
 RUMMEL, KLEPPER & KAHN, LLP
 ENGINEERS/CONSTRUCTION MANAGERS/PLANNERS/SCIENTISTS
 RESPONSIVE PEOPLE • CREATIVE SOLUTIONS

700 East Pratt Street, Suite 500
 Baltimore, MD 21202
 Ph: 410.726.2900 Co. No: MD110018801 www.rkk.com

PROFESSIONAL CERTIFICATION: I HEREBY CERTIFY THAT THESE DOCUMENTS WERE PREPARED OR APPROVED BY ME AND THAT I AM A DULY LICENSED PROFESSIONAL ENGINEER UNDER THE LAWS OF THE STATE OF MARYLAND. LICENSE NO. 4842; EXPIRATION DATE: MAY 31, 2024.

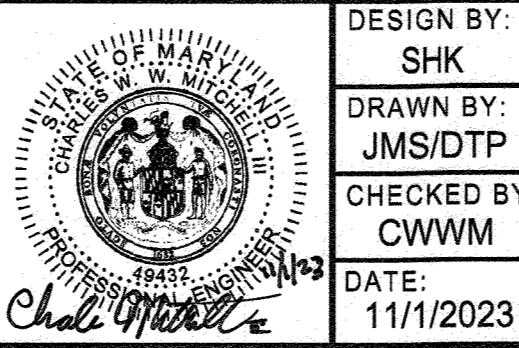

| | | | | | |
|-------------|-----------|------|---|---|---------|
| DESIGN BY: | SHK | RK&K | ▲ | New Sheet - OTA-3 and Borrow Area Modifications | 11/1/23 |
| DRAWN BY: | JMS/DTP | | | | |
| CHECKED BY: | CWMM | | | | |
| DATE: | 11/1/2023 | | | | |
| BY: | NO. | | | REVISION | DATE |

OWNER/DEVELOPER
JOHNS HOPKINS APPLIED PHYSICS LABORATORY
 11100 JOHNS HOPKINS ROAD
 LAUREL, MARYLAND 20723

UTILITY PLAN - EAST BORROW AREA (PHASE 2)
 JOHNS HOPKINS UNIVERSITY - APPLIED PHYSICS LABORATORY
OUTDOOR TESTING AREAS

11100 JOHNS HOPKINS ROAD
 TAX MAP: 41 PARCEL: 123 GRID: 16 ZONED: PEC
 ELECTION DISTRICT 5 - HOWARD COUNTY, MARYLAND
 SHEET 28 OF 73


RK&K PROJECT NUMBER: 21047.013
 SCALE: As Shown

GENERAL NOTES

1. TOPOGRAPHIC AND SURFACE INFORMATION SHOWN WAS OBTAINED FROM FIELD SURVEY BY RK&K, COMPLETED DECEMBER 23, 2021. UTILITY INFORMATION SHOWN WAS PROVIDED BY A/DATA ON FEBRUARY 4, 2022.
2. IT IS THE CONTRACTOR'S RESPONSIBILITY TO FIELD VERIFY ACTUAL SITE CONDITIONS PRIOR TO THE START OF ANY WORK. THERE IS NO WARRANTY OR GUARANTEE ON THE COMPLETENESS OR CORRECTNESS OF THE EXISTING CONDITION INFORMATION. ANY DISCREPANCY FOUND SHALL BE BROUGHT TO THE IMMEDIATE ATTENTION OF THE ARCHITECT/ENGINEER PRIOR TO THE START OF ANY WORK.
3. BEARINGS AND HORIZONTAL COORDINATES SHOWN ON THIS PLAN ARE BASED UPON MARYLAND STATE PLANE COORDINATE SYSTEM NAD83. VERTICAL ELEVATIONS SHOWN ARE BASED UPON VERTICAL DATUM NAVD88.
4. THE LOCATION OF EXISTING UNDERGROUND UTILITIES IS SHOWN IN AN APPROXIMATE WAY ONLY, BASED UPON FIELD OBSERVATIONS AND RECORD DOCUMENTS. THEY HAVE NOT BEEN COMPARED TO OR VERIFIED WITH FIELD TEST PITS. THE CONTRACTOR SHALL BE RESPONSIBLE TO VERIFY TO HIS OWN SATISFACTION THE EXACT LOCATION, SIZE AND TYPE OF ALL EXISTING UNDERGROUND UTILITIES BEFORE COMMENCING ANY WORK. THE CONTRACTOR MUST NOTIFY THE UTILITY COMPANIES INVOLVED PRIOR TO THE START OF THE WORK. CONTRACTOR AGREES TO BE FULLY RESPONSIBLE FOR THE COST OF ANY AND ALL DAMAGES WHICH OCCUR AS A RESULT OF A FAILURE TO EXACTLY LOCATE AND PRESERVE ANY AND ALL EXISTING UTILITIES TO REMAIN.
5. THE CONTRACTOR SHALL BE RESPONSIBLE FOR NOTIFYING "MISS UTILITY" AT 1-800-257-7777 FIVE DAYS PRIOR TO THE START OF ANY EXCAVATION WORK.
6. THE CONTRACTOR SHALL VERIFY ALL EXISTING UTILITY INVERTS AND CLEARANCES FROM NEW WORK PRIOR TO START OF ANY WORK.
7. THE CONTRACTOR SHALL STAKE OUT THE LOCATION OF ALL NEW CONSTRUCTION AND VERIFY ALL JURISDICTIONAL SETBACKS AND BUFFERS PRIOR TO START OF ANY WORK.
8. EXISTING UTILITIES WHICH ARE NOT TO BE REMOVED OR ABANDONED SHALL REMAIN OPERATIONAL AT ALL TIMES. APPROPRIATE EXISTING UTILITIES SHALL REMAIN IN SERVICE UNTIL REPLACEMENT/RELOCATED UTILITIES ARE OPERATIONAL.
9. CONTRACTOR SHALL PROVIDE POSITIVE DRAINAGE AWAY FROM ALL EXISTING AND PROPOSED BUILDING ENTRANCES DURING ALL PHASES OF CONSTRUCTION, UNLESS OTHERWISE NOTED IN THESE DOCUMENTS. CONTRACTOR SHALL NOTIFY ENGINEER / OWNER IF EXISTING OR PROPOSED CONDITIONS RESTRICT ABILITY TO ACHIEVE POSITIVE DRAINAGE FROM BUILDINGS PRIOR TO THE START OF CONSTRUCTION.


UTILITY KEY NOTES

- C-1** PROPOSED 12-WAY SECURE COMMUNICATION DUCT BANK*
 - C-2** PROPOSED 24-WAY COMMUNICATION DUCT BANK*
 - C-3** TELECOMMUNICATIONS VAULT (SEE SHEETS C-297, C-298, C-294B)
 - C-4** CONNECT TO EXISTING COMMUNICATION MANHOLE (SEE SHEET C-294A)
 - S-1** 8" SANITARY SEWER (GRAVITY) SCH 40 PVC
 - W-1** 8" WATER DIP
 - W-2** TAP INTO EX. WATER MAIN WITH 22.5" HB WITH 8" VALVE AND VAULT STRAPPED TO WEST SIDE, FOLLOWED BY 4" PIPE AND 11.25" HB
 - W-3** 45" HB
 - W-4** 8"x6" TEE & BUTTRESS TO CONNECT TO EX. WATER
 - W-5** 8" VALVE AND VAULT STRAPPED TO ALL THREE SIDES OF PROPOSED TEE
 - W-6** 8"x8" TEE & BUTTRESS TO CONNECT TO EX. WATER
 - W-7** ANY EXISTING 4" WATER FROM THE PROPOSED TEE TO THIS POINT TO BE REPLACED WITH 6" WATER
 - W-8** EXISTING FIRE HYDRANT LINE TO BE REPLACED WITH 6" WATER, 6" VALVE & VAULT, AND NEW FIRE HYDRANT
 - W-9** 8" VALVE AND VAULT STRAPPED TO PROPOSED CAP (ROADWAY VALVE BOX, PER HC DETAILS. SEE UTILITY DETAILS)
 - SD-1** 4"x4" YARD INLET (HC D-412)
 - SD-2** 15" STORM DRAIN
 - SD-3** 18" STORM DRAIN
 - SD-4** TEMPORARY 24" STORM DRAIN SEDIMENT TRAP OUTFALL
 - SD-5** 33" DIA. RISER STRUCTURE
- *WHEN 1 FT APART FROM OUTER DIAMETER, GAP TO BE FILLED WITH #57 STONE
- FOR BORROW AREA STRUCTURE TABLES, SEE SHEET C-294

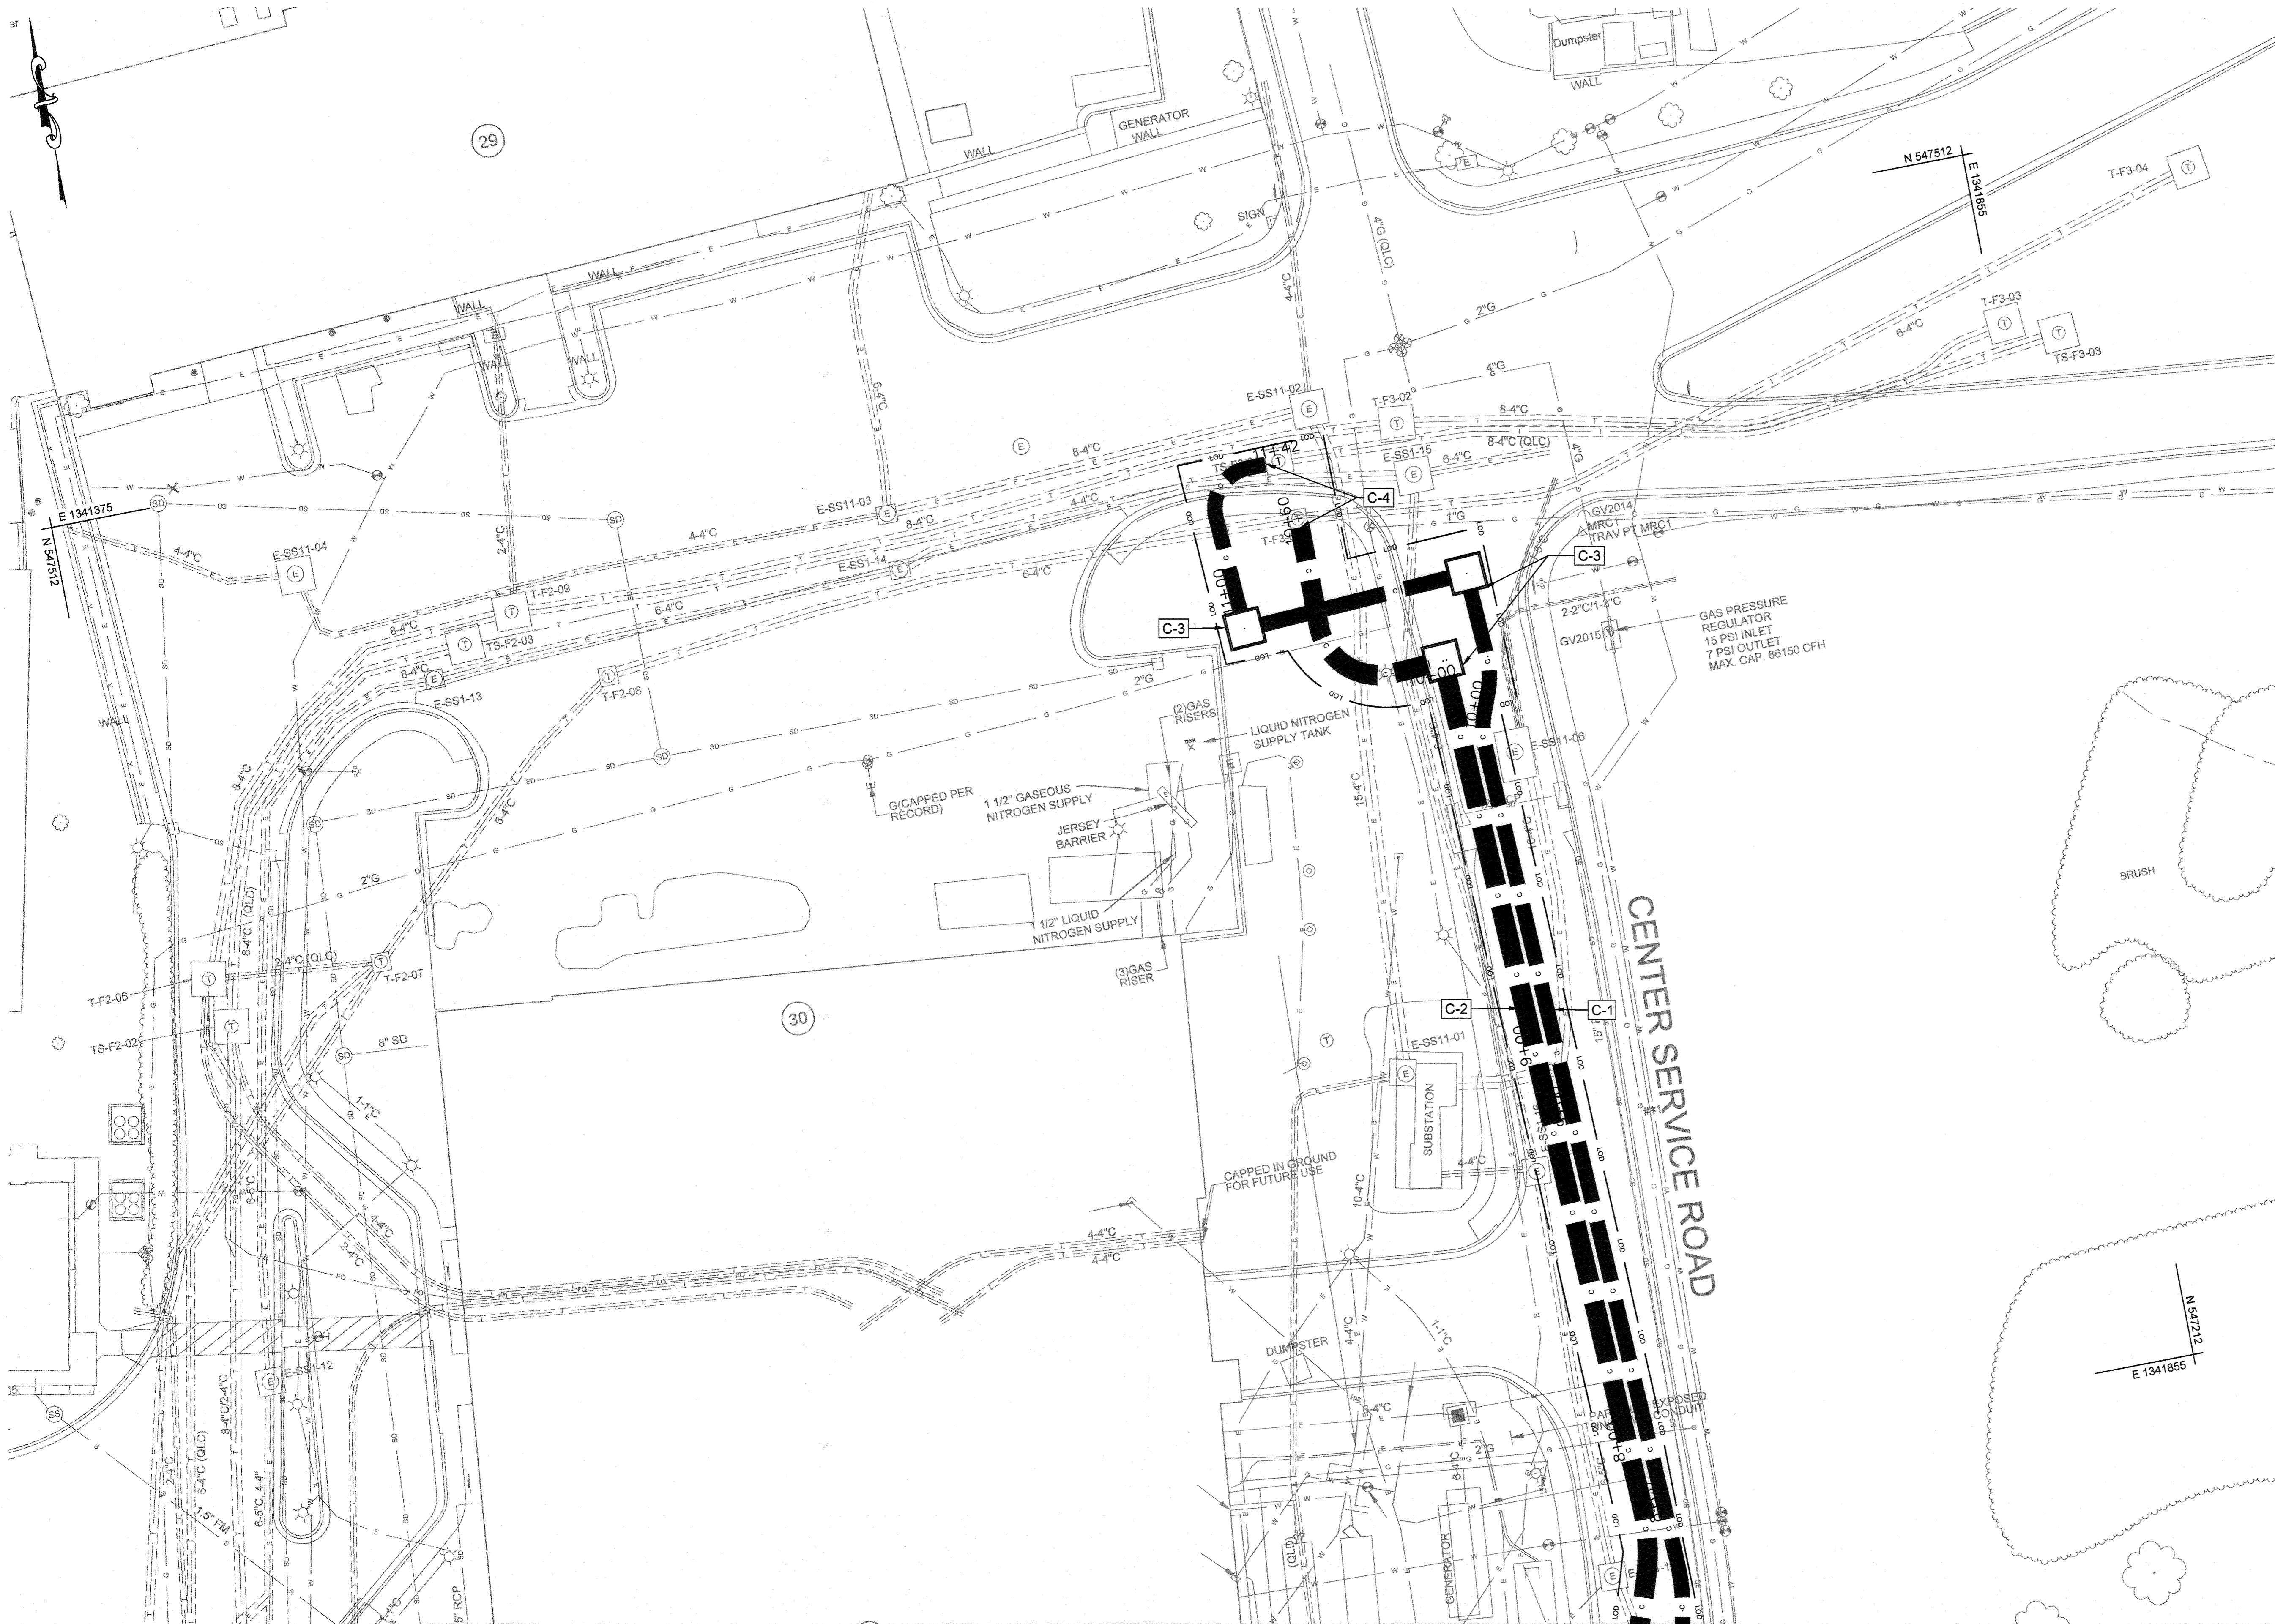

MATCHLINE - SEE SHEET C-291

▲ PURPOSE STATEMENT (11/1/23): DESIGN OF OUTDOOR TESTING AREA 3, INCLUDING THE SOURCE OF BORROW MATERIAL, REFERRED TO AS THE EAST AND WEST BORROW AREAS.

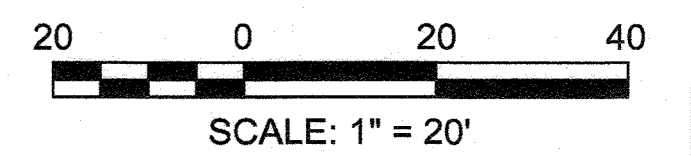

APPROVED: DEPARTMENT OF PLANNING AND ZONING
 Chief, Development Engineering Division
 Chief, Division of Land Development
 Director

Date: 12-5-23
 Date: 12/24
 Date: 12/22/24

RK&K
 ENGINEERS/CONSTRUCTION MANAGERS/PLANNERS/SCIENTISTS
 RESPONSIVE PEOPLE • CREATIVE SOLUTIONS
 700 East Pratt Street, Suite 500
 Baltimore, MD 21202

PROFESSIONAL CERTIFICATION: I HEREBY CERTIFY THAT THESE DOCUMENTS WERE PREPARED OR APPROVED BY ME, AND THAT I AM A DULY LICENSED PROFESSIONAL ENGINEER UNDER THE LAWS OF THE STATE OF MARYLAND. LICENSE NO. 4942, EXPIRATION DATE MAY 31, 2024.




| | | | | |
|----------------------|------|----------|---|---------|
| DESIGN BY: SHK | RK&K | ▲ | New Sheet - OTA-3 and Borrow Area Modifications | 11/1/23 |
| DRAWN BY: JMS/DTP | | | | |
| CHECKED BY: CWWW | | | | |
| DATE: 11/1/2023 | | | | |
| BY | NO. | REVISION | | DATE |


OWNER/DEVELOPER
 JOHNS HOPKINS
 APPLIED PHYSICS LABORATORY
 11100 JOHNS HOPKINS ROAD
 LAUREL, MARYLAND 20723

UTILITY PLAN - EAST BORROW AREA (PHASE 2)
 JOHNS HOPKINS UNIVERSITY - APPLIED PHYSICS LABORATORY
OUTDOOR TESTING AREAS
 11100 JOHNS HOPKINS ROAD
 TAX MAP: 41 PARCEL: 123 GRID: 18 ZONED: PEC
 ELECTION DISTRICT 5 - HOWARD COUNTY, MARYLAND
 SHEET 29 OF 73

RK&K PROJECT NUMBER: 21047.013
 SCALE: As Shown

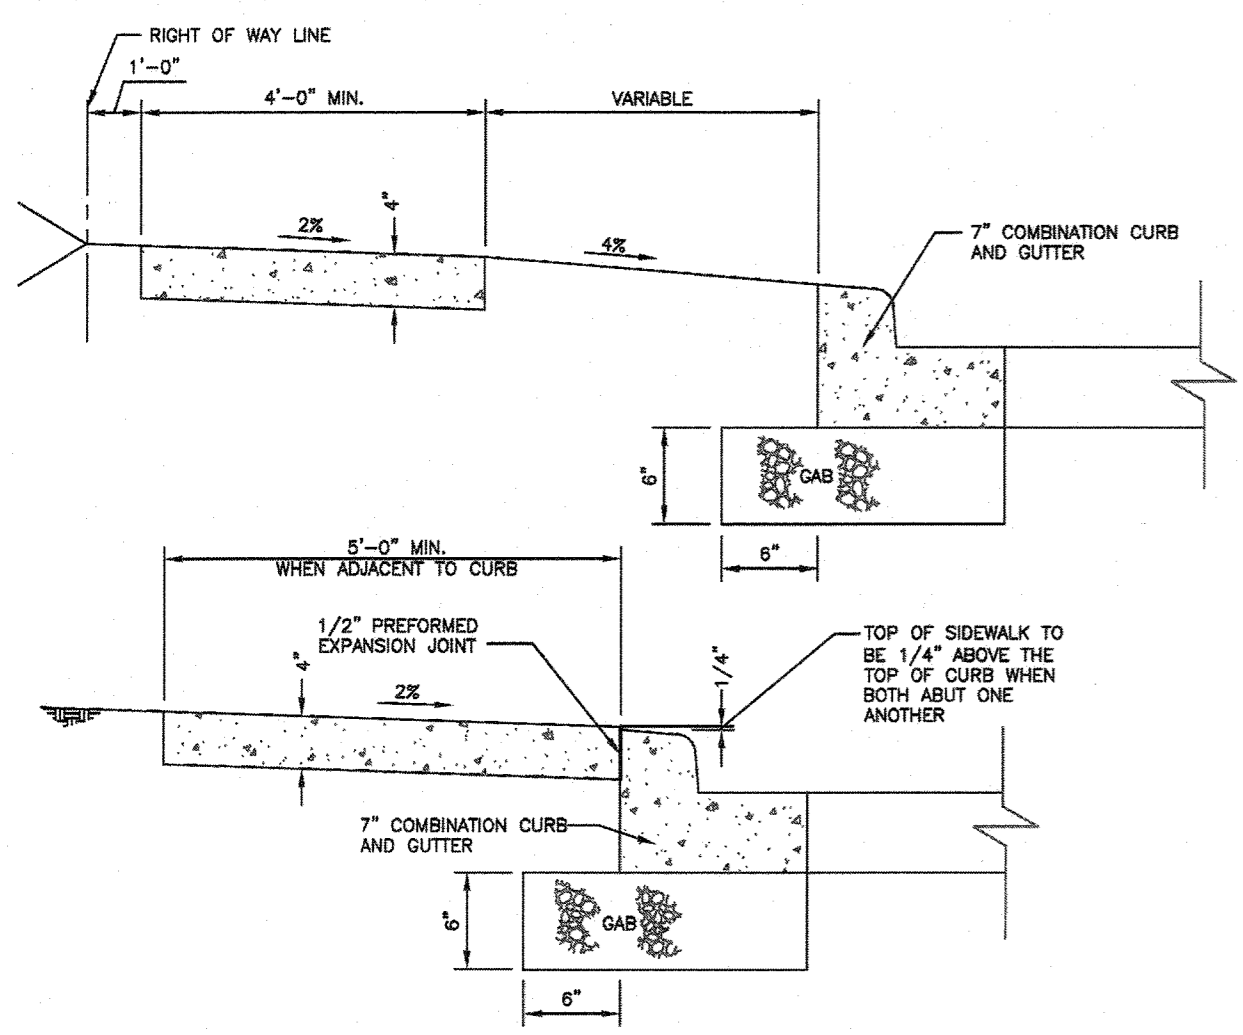

- NOTES:**
- SIDEWALK TO BE SCRIBED IN 5'-0" MAXIMUM SQUARES.
 - EXPANSION JOINTS ACROSS THE SIDEWALK NOT TO BE MORE THAN 15' APART, OR 16' FOR 4' WIDE SIDEWALK.
 - 1/2" PREFORMED EXPANSION MATERIAL IN EXPANSION JOINTS TO BE KEPT 1/4" BELOW SURFACE OF SIDEWALK.
 - CONCRETE TO BE MIX #3.
 - WHEN SIDEWALK ABUTS CURB, SIDEWALK SHALL BE 1/4" ABOVE CURB WITH 1/2" PREFORMED EXPANSION JOINT BETWEEN SIDEWALK AND CURB.
 - ON LONGITUDINAL SIDEWALK GRADES OF 2% OR GREATER, A CONCRETE HEADER, 6" THICK AND 8" DEEP BELOW THE NORMAL 4" SIDEWALK THICKNESS SHALL BE CONSTRUCTED FOR THE FULL WIDTH OF THE SIDEWALK AT INTERVALS OF 48 FEET. THE HEADERS SHALL BE PLACED AT THE EXPANSION JOINT LOCATIONS AND SHALL BE MONOLITHIC WITH THE SIDEWALK.
 - SIDEWALK WIDTH ADJACENT TO CURB SHALL BE 5'-0" MINIMUM EXCEPT SIDEWALK ADJACENT TO CURB IN CUL-DE-SAC BULBS MAY BE 4'-0" WIDE.
 - SIDEWALK LOCATED 2' OR MORE FROM CURB MAY BE 4'-0" IN WIDTH WITH A 5'x5' PAVED SECTION PLACED 200' APART.
 - 4'-0" SIDEWALK REQUIRES A PASSING AREA (SEE DETAIL R-4.01).

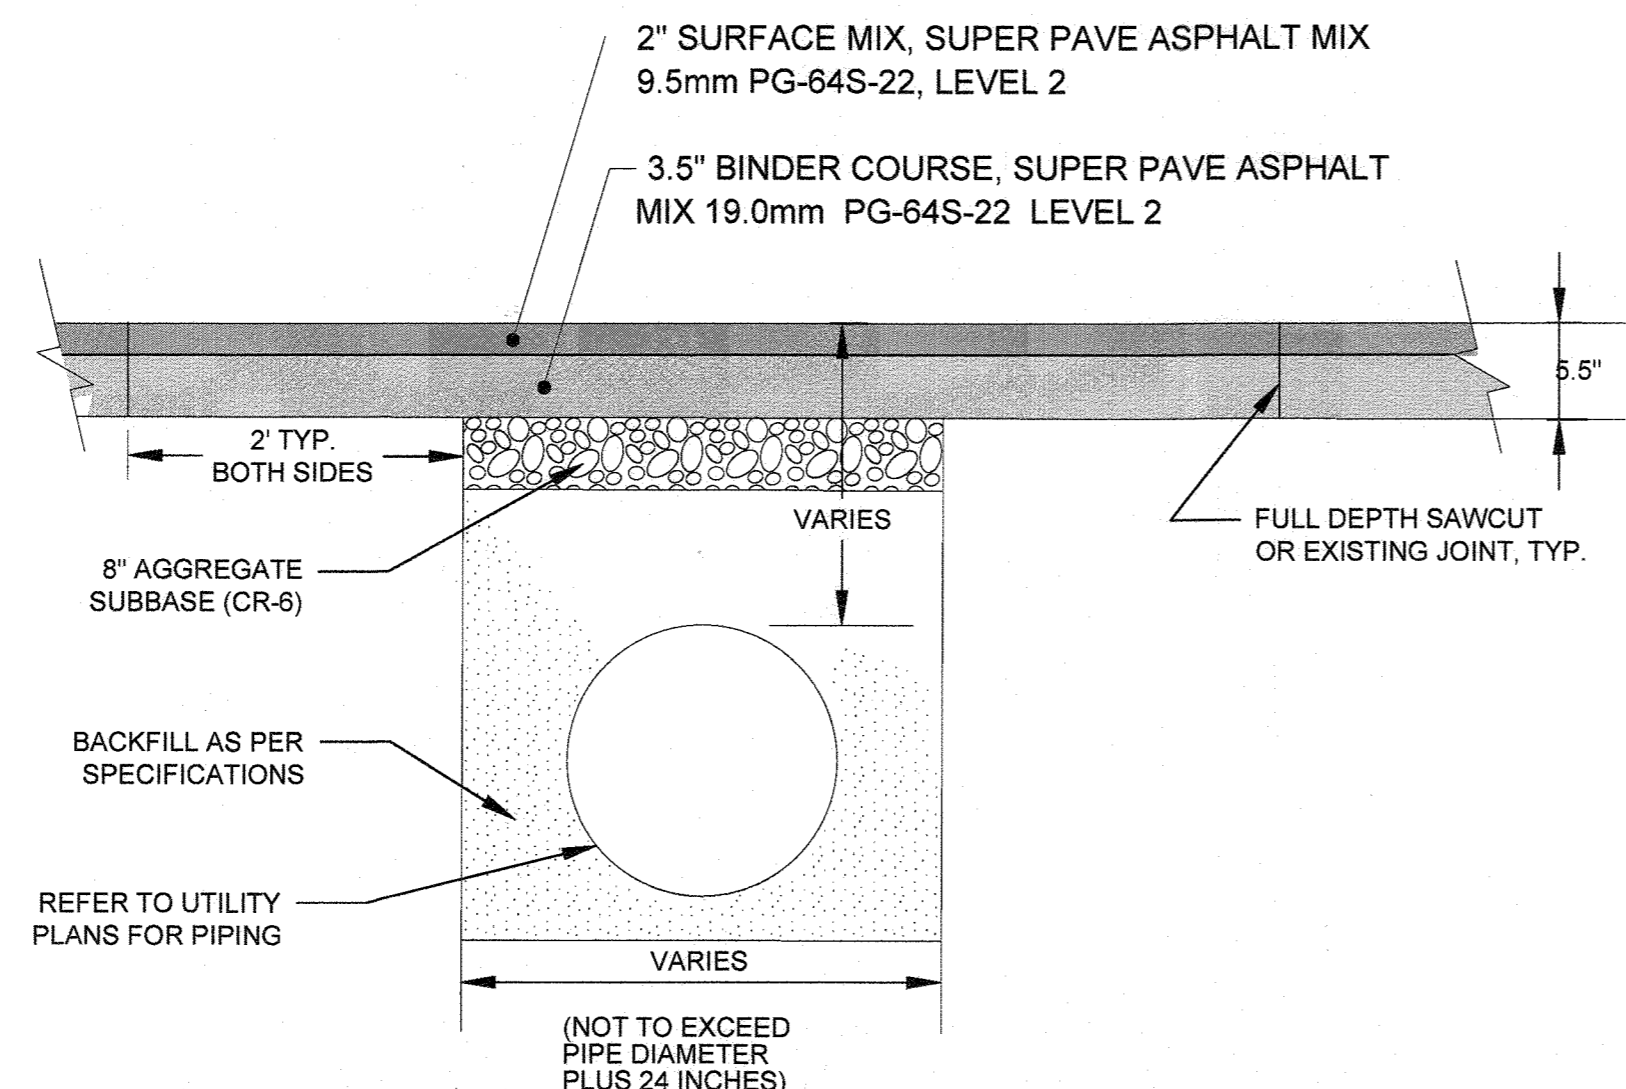

UTILITY TRENCH DETAIL IN VEHICULAR CONCRETE PAVEMENT
SCALE: NONE

NOTE: FOR ADDITIONAL UTILITY DETAILS, SEE SHEETS C-216 TO C-219

| SANITARY STRUCTURE TABLE | | | |
|--------------------------|-------------|------------|---|
| NAME | NORTHING | EASTING | DESCRIPTION |
| S-1 | 547003.4749 | 1341705.14 | PRECAST 48" SANITARY SEWER DOGHOUSE MANHOLE (HC G-5.14) |
| S-2 | 547149.6998 | 1341733.34 | PRECAST 48" SANITARY SEWER MANHOLE (HC G-5.12) |
| S-3 | 547161.9077 | 1341584.61 | PRECAST 48" SANITARY SEWER MANHOLE (HC G-5.12) |
| S-4 | 547166.0274 | 1341501.33 | PRECAST 48" SANITARY SEWER MANHOLE (HC G-5.12) |
| S-5 | 547176.0054 | 1341398.86 | PRECAST 48" SANITARY SEWER MANHOLE (HC G-5.12) |
| S-6 | 547137.3340 | 1341359.64 | PRECAST 48" SANITARY SEWER MANHOLE (HC G-5.12) |
| S-7 | 547070.5515 | 1341347.06 | PRECAST 48" SANITARY SEWER MANHOLE (HC G-5.12) |
| S-8 | 546973.1721 | 1341328.78 | PRECAST 48" SANITARY SEWER MANHOLE (HC G-5.12) |
| S-9 | 546780.3419 | 1341289.09 | PRECAST 48" SANITARY SEWER MANHOLE (HC G-5.12) |
| S-10 | 546773.3674 | 1341279.66 | PRECAST 48" SANITARY SEWER MANHOLE (HC G-5.12) |
| S-11 | 546752.8675 | 1341275.53 | PRECAST 48" SANITARY SEWER DOGHOUSE MANHOLE (HC G-5.14) |

| STORM DRAIN STRUCTURE TABLE | | | |
|-----------------------------|-------------|------------|--|
| NAME | NORTHING | EASTING | DESCRIPTION |
| EX INL 2 | 547201.0251 | 1341411.63 | RECTANGULAR JUNCTION STRUCTURE NF |
| EX INL 3B | 546982.3996 | 1340939.51 | RECTANGULAR JUNCTION STRUCTURE NF |
| SD-1 | 547104.5528 | 1341418.30 | YARD INLET (PRECAST) HC D-4.12 |
| SD-2 | 547027.6689 | 1341573.23 | YARD INLET (PRECAST) HC D-4.12 |
| SD-3 | 546961.1761 | 1341631.79 | YARD INLET (PRECAST) HC D-4.12 |
| ST-1 | 546924.5319 | 1341598.10 | 33" DIAMETER CMP RISER WITH TRASH RACK |
| ST-2 | 546912.6510 | 1340994.86 | 21" DIAMETER CMP RISER WITH TRASH RACK |

| TELECOMM STRUCTURE TABLE | | | |
|--------------------------|-------------|------------|-----------------|
| NAME | NORTHING | EASTING | DESCRIPTION |
| C-1 | 546773.3689 | 1341614.46 | 8'X8'8" VAULT |
| C-2 | 546946.0757 | 1341652.16 | 10'X8'8" VAULT |
| C-3 | 547119.8032 | 1341694.96 | 8'X8'X14' VAULT |
| C-4 | 547414.3942 | 1341705.66 | 8'X8'X11' VAULT |
| C-5 | 546749.5869 | 1341618.32 | 8'X8'X12' VAULT |
| C-6 | 546930.9547 | 1341657.05 | 8'X8'X10' VAULT |
| C-7 | 547133.5349 | 1341711.20 | 8'X8'X13' VAULT |
| C-8 | 547434.3504 | 1341715.39 | 8'X8'X10' VAULT |
| C-9 | 547431.5198 | 1341659.09 | 8'X8'X15' VAULT |
| T-F3-01 | 547455.5409 | 1341677.16 | T-F3-01 |
| T-H2-04 | 546537.6643 | 1341562.81 | T-H2-04 |
| TS-F3-01 | 547470.3482 | 1341675.14 | TS-F3-01 |
| TS-H2-02 | 546522.5340 | 1341572.63 | TS-H2-02 |

| | |
|---|---|
| Revised 5/30/2017 Resub 5/7/2021 Approved | Howard County, Maryland Department of Public Works CONCRETE SIDEWALK Detail R-3.05 |
|---|---|

▲ PURPOSE STATEMENT (11/1/23): DESIGN OF OUTDOOR TESTING AREA 3, INCLUDING THE SOURCE OF BORROW MATERIAL, REFERRED TO AS THE EAST AND WEST BORROW AREAS.

APPROVED: DEPARTMENT OF PLANNING AND ZONING

Chief, Development Engineering Division
Date: 12-5-23

Chief, Division of Land Development
Date: 2/22/24

RK&K
RUMMEL, KLEPPER & KAHL, LLP
ENGINEERS | CONSTRUCTION MANAGERS | PLANNERS | SCIENTISTS
RESPONSIVE PEOPLE. CREATIVE SOLUTIONS.
700 East Pratt Street, Suite 500
Baltimore, MD 21202
Ph: 410.728.2800 Contact: Matt Thomsson
www.rk&k.com


DESIGN BY: SHK
DRAWN BY: JMS/DTP
CHECKED BY: CWWW
DATE: 11/1/2023

| | | | |
|------|-----|---|---------|
| RK&K | 4 | New Sheet - OTA-3 and Borrow Area Modifications | 11/1/23 |
| BY | NO. | REVISION | DATE |

OWNER/DEVELOPER
JOHNS HOPKINS APPLIED PHYSICS LABORATORY
11100 JOHNS HOPKINS ROAD
LAUREL, MARYLAND 20723


SITE DETAILS - BORROW AREAS
JOHNS HOPKINS UNIVERSITY - APPLIED PHYSICS LABORATORY
OUTDOOR TESTING AREAS
11100 JOHNS HOPKINS ROAD
TAX MAP: 41 PARCEL: 123 GRID: 19 ZONED: PEC
ELECTION DISTRICT 5 - HOWARD COUNTY, MARYLAND
SHEET 30 OF 73

C-294
RK&K PROJECT NUMBER 21047.013
SCALE: As Shown

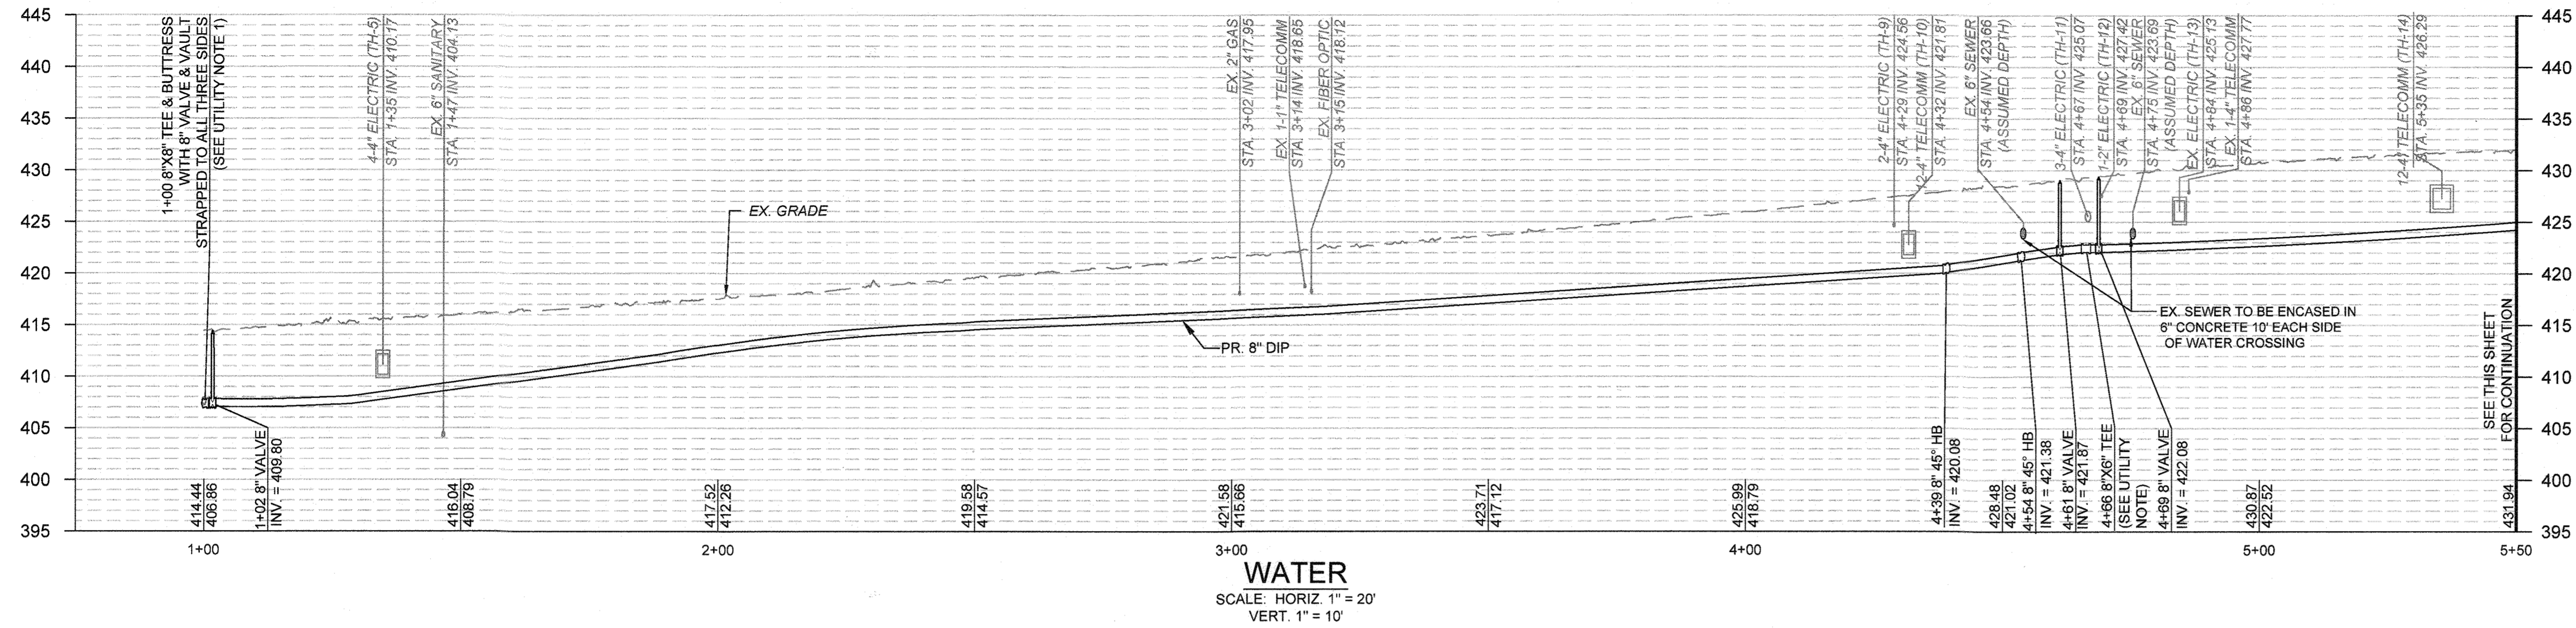

UTILITY NOTES



- CONTRACTOR TO CONFIRM DEPTH OF EXISTING UTILITY CROSSINGS AND TIE-IN POINTS PRIOR TO CONSTRUCTION. ALL EXISTING DEPTHS SHOWN HAVE BEEN ASSUMED AT STANDARD DEPTHS PER TYPICAL ENGINEERING PRACTICE.

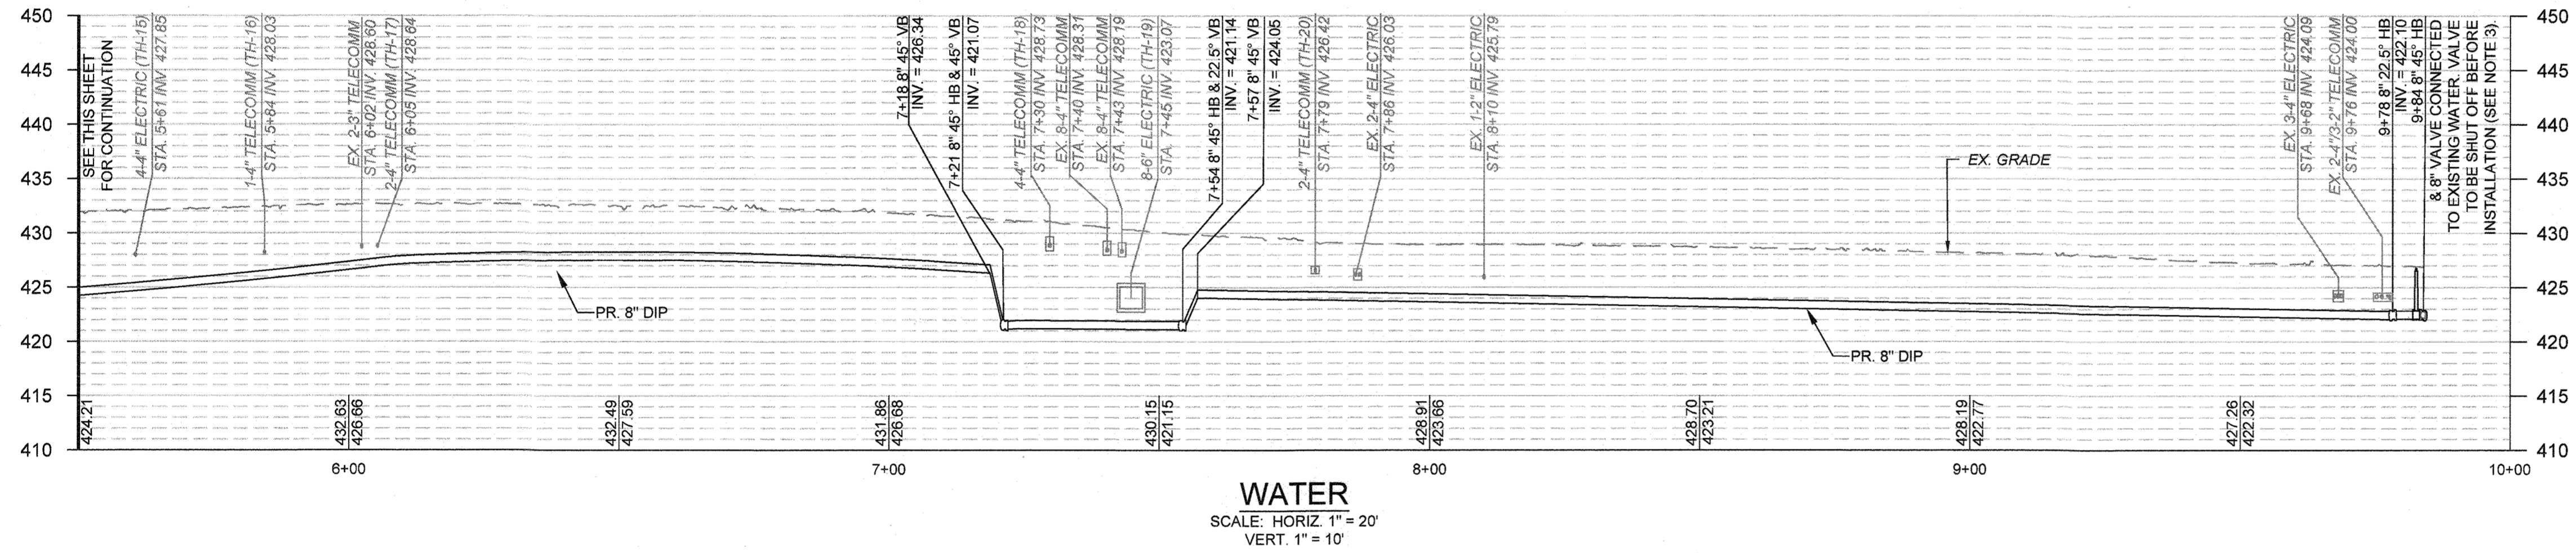

UTILITY NOTES

- CONTRACTOR TO CONFIRM DEPTH OF EXISTING UTILITY CROSSINGS AND TIE-IN POINTS. ALL EXISTING DEPTHS SHOWN HAVE BEEN ASSUMED AT STANDARD DEPTHS PER TYPICAL ENGINEERING PRACTICE.
- TEST PITS WILL BE CONDUCTED TO VERIFY DEPTHS OF SELECT UTILITIES TO REMAIN BEFORE CONSTRUCTION DOCUMENT ISSUANCE.
- CONTRACTOR TO COORDINATE WITH OWNER FOR TEMPORARY SHUT OFF OF EXISTING WATER AT LEAST ONE MONTH IN ADVANCE OF INSTALLATION.

PROFILE LEGEND

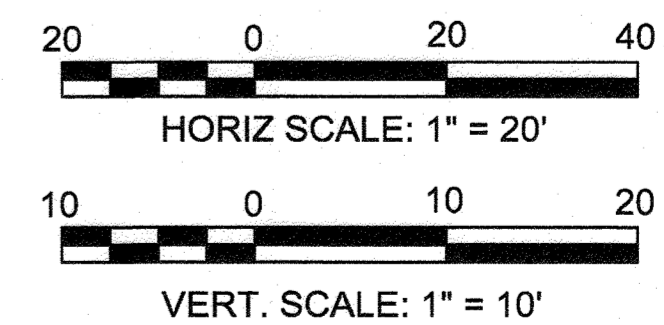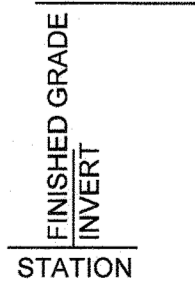

▲ PURPOSE STATEMENT (11/1/23): DESIGN OF OUTDOOR TESTING AREA 3, INCLUDING THE SOURCE OF BORROW MATERIAL, REFERRED TO AS THE EAST AND WEST BORROW AREAS.

APPROVED: DEPARTMENT OF PLANNING AND ZONING
 Chief, Development Engineering Division
 Chief, Division of Land Development
 Director

RK&K
 RUMMEL, KLEPPER & KAHN, LLP
 ENGINEERS/CONSTRUCTION MANAGERS/PLANNERS/SCIENTISTS
 RESPONSIVE PEOPLE • CREATIVE SOLUTIONS
 700 East Pratt Street, Suite 500
 Baltimore, MD 21202
 Ph: 410.728.2900 Contact: Matt Thompson
 www.rkk.com

PROFESSIONAL CERTIFICATION: I HEREBY CERTIFY THAT THESE DOCUMENTS WERE PREPARED OR APPROVED BY ME, AND THAT I AM A DAILY LICENSED PROFESSIONAL ENGINEER UNDER THE LAWS OF THE STATE OF MARYLAND. LICENSE NO. 49432, EXPIRATION DATE: MAY 31, 2024.









| | | | | | |
|-------------|-----------|------|---|---|---------|
| DESIGN BY: | SHK | RK&K | ▲ | New Sheet - OTA-3 and Borrow Area Modifications | 11/1/23 |
| DRAWN BY: | JMS/DTP | | | | |
| CHECKED BY: | CWMM | | | | |
| DATE: | 11/1/2023 | | | | |
| BY | NO. | | | REVISION | DATE |

OWNER/DEVELOPER
JOHNS HOPKINS
APPLIED PHYSICS LABORATORY
 11100 JOHNS HOPKINS ROAD
 LAUREL, MARYLAND 20723

WATER PROFILES - BORROW AREA
 (PHASE 2)
 JOHNS HOPKINS UNIVERSITY - APPLIED PHYSICS LABORATORY
OUTDOOR TESTING AREAS
 11100 JOHNS HOPKINS ROAD
 TAX MAP: 41 PARCEL: 123 GRID: 18 ZONED: PEC
 ELECTION DISTRICT 5 - HOWARD COUNTY, MARYLAND
 SHEET 31 OF 73

C-295
 RK&K PROJECT NUMBER
 21047.013
 SCALE:
 As Shown


C:\Cloud\Projects\2021\21047_APL2021\MSA\Projects\Task 13 - OTA 3\CADD\Plans\C-296 Sanitary Sewer Profiles - Borrow Area (Phase 2).dwg Oct 31, 2023 1:23pm jsalz

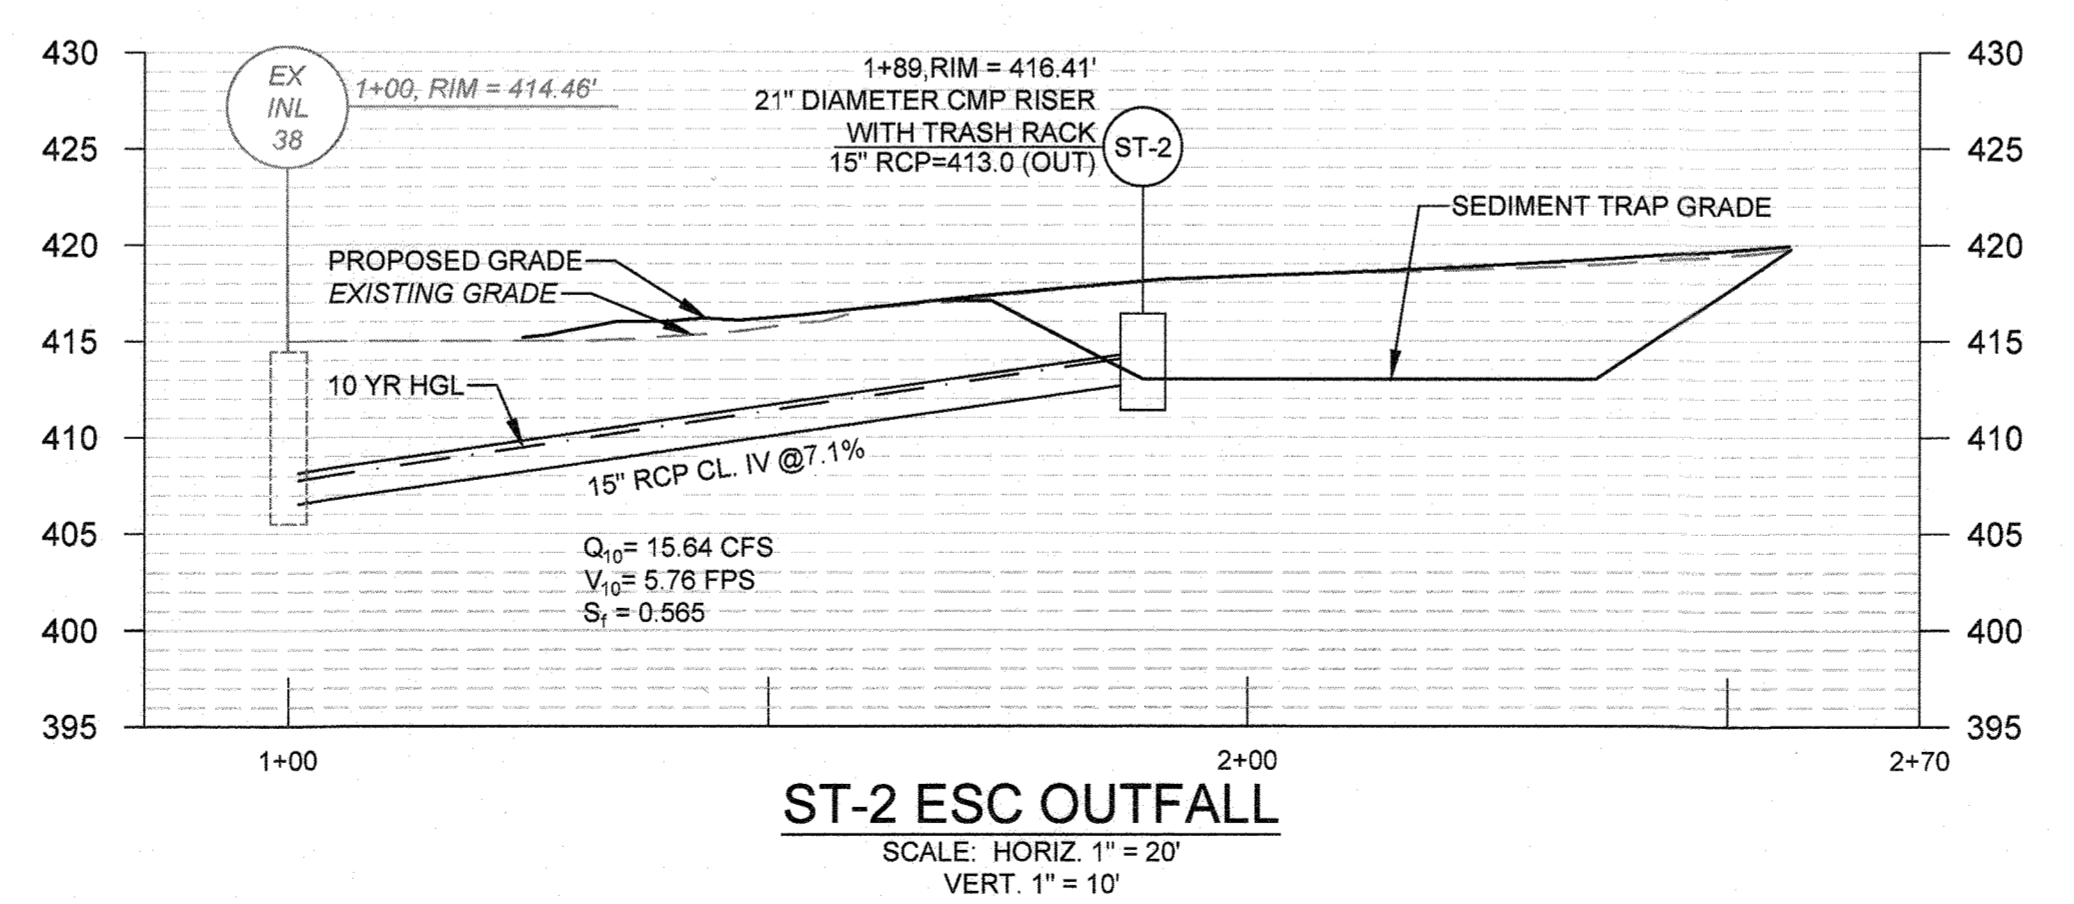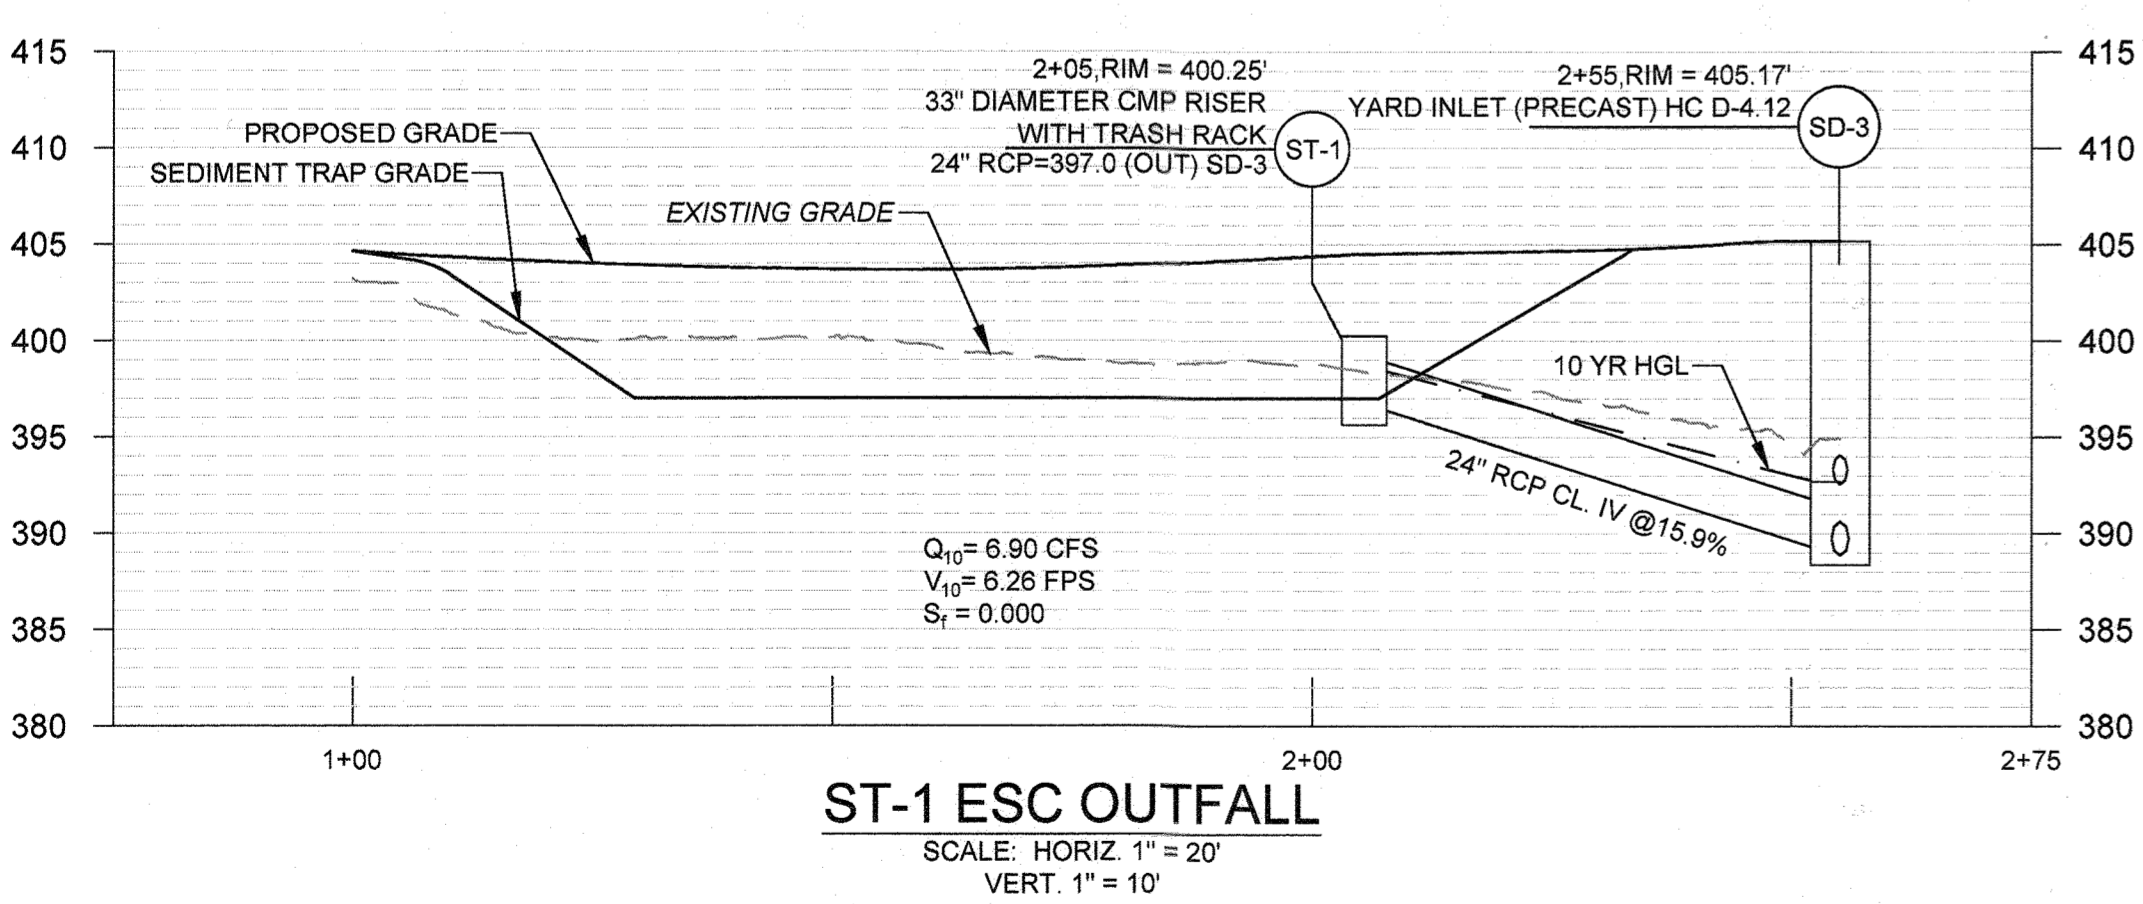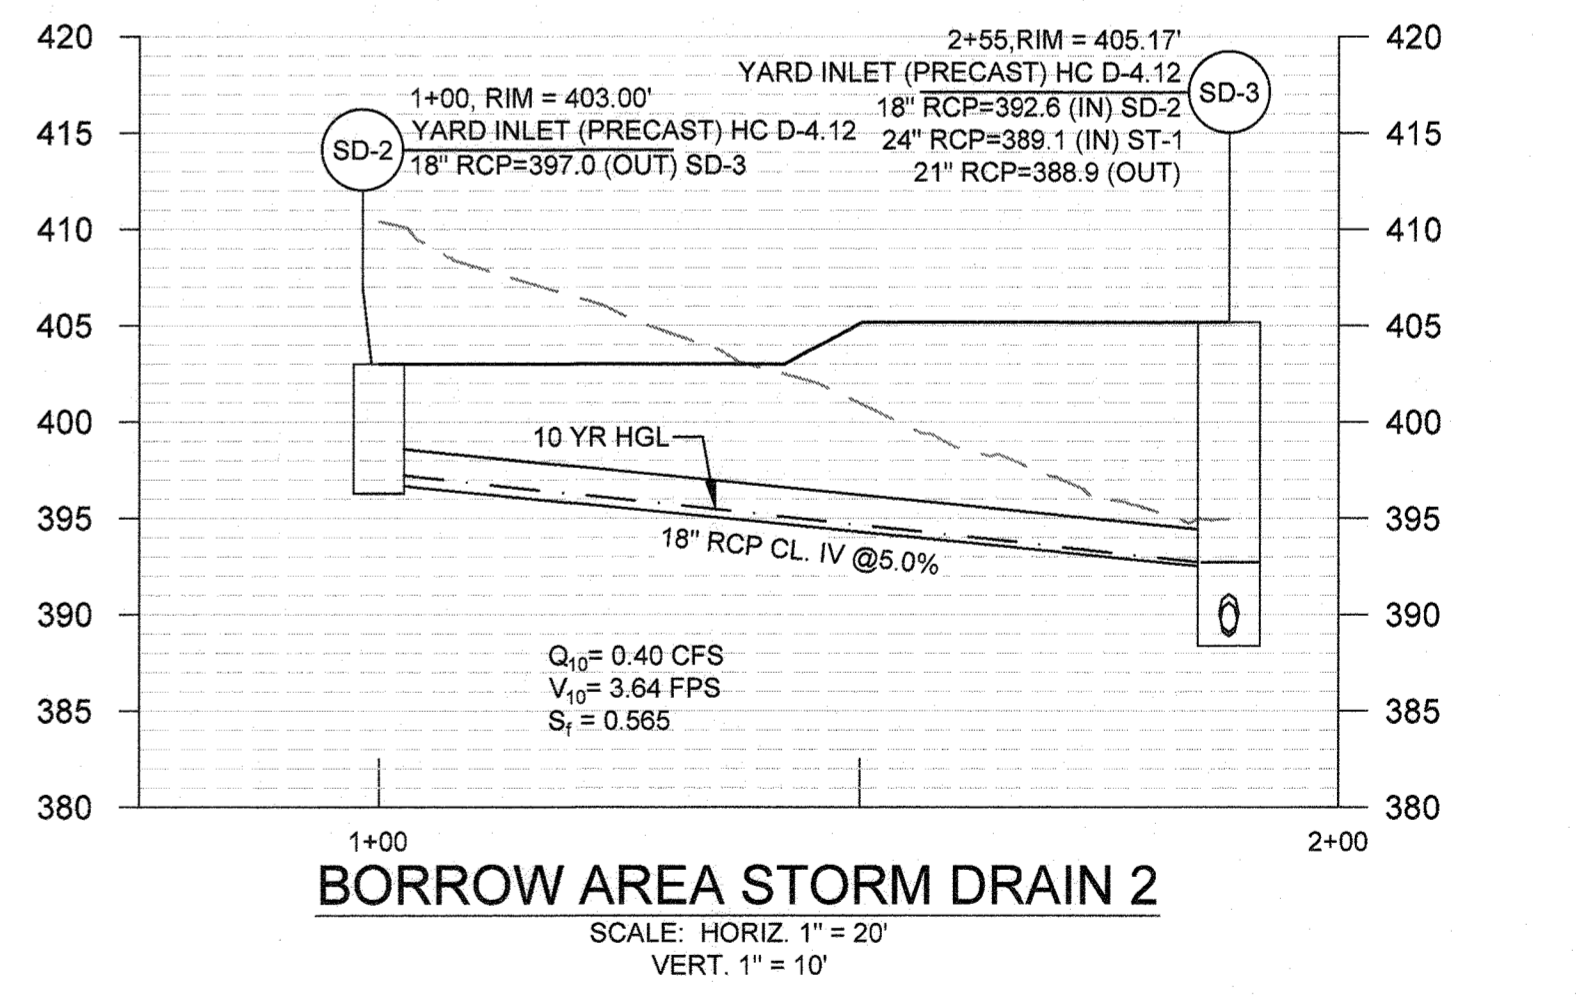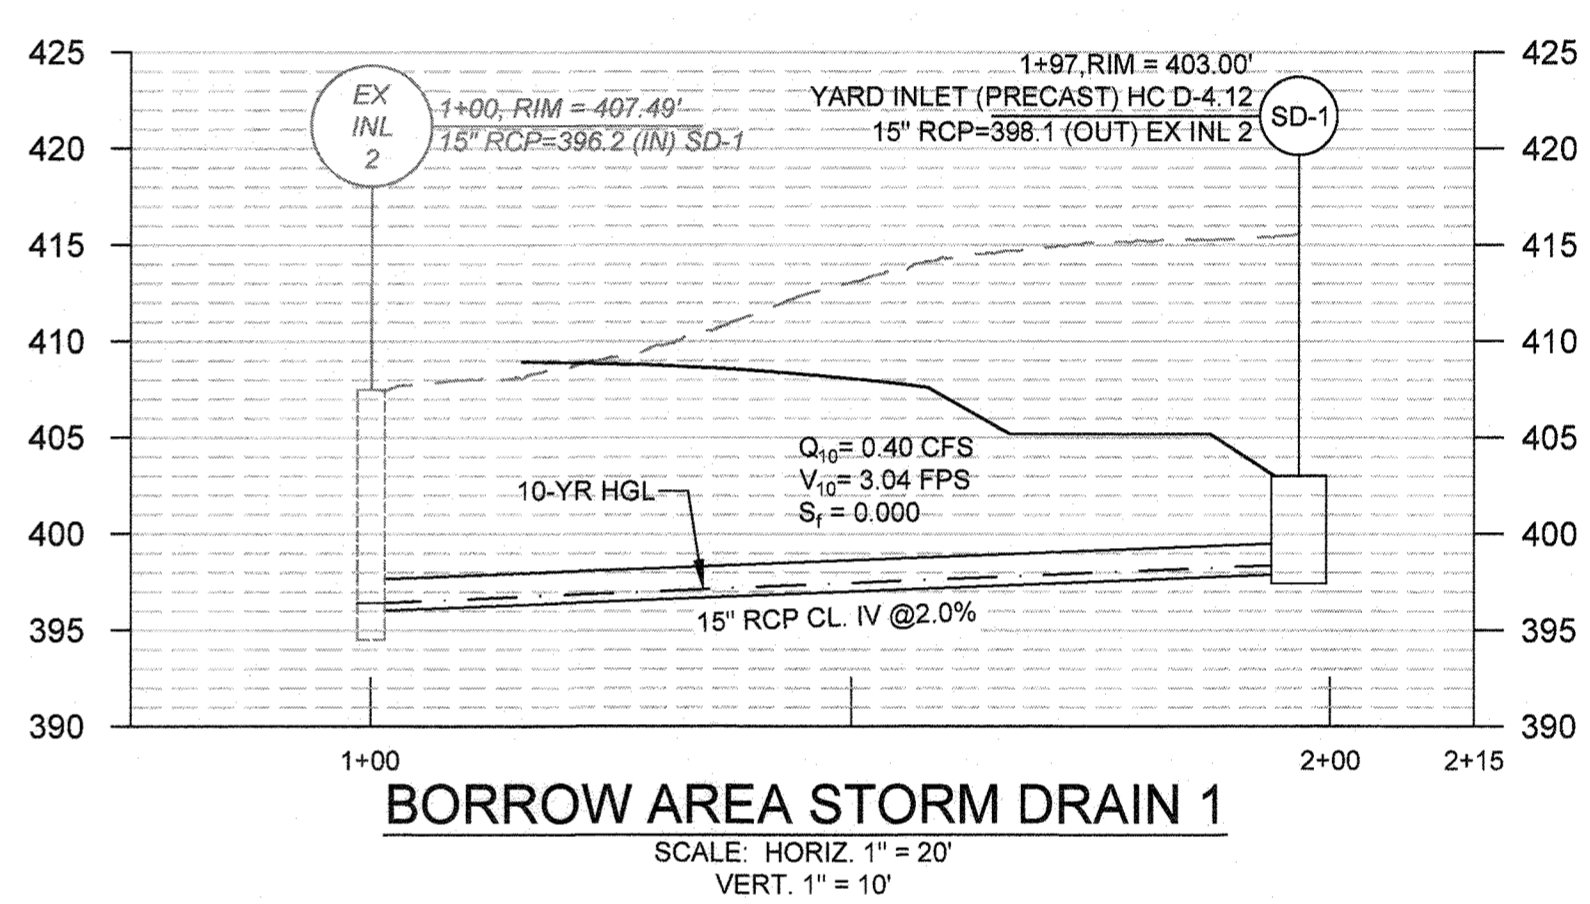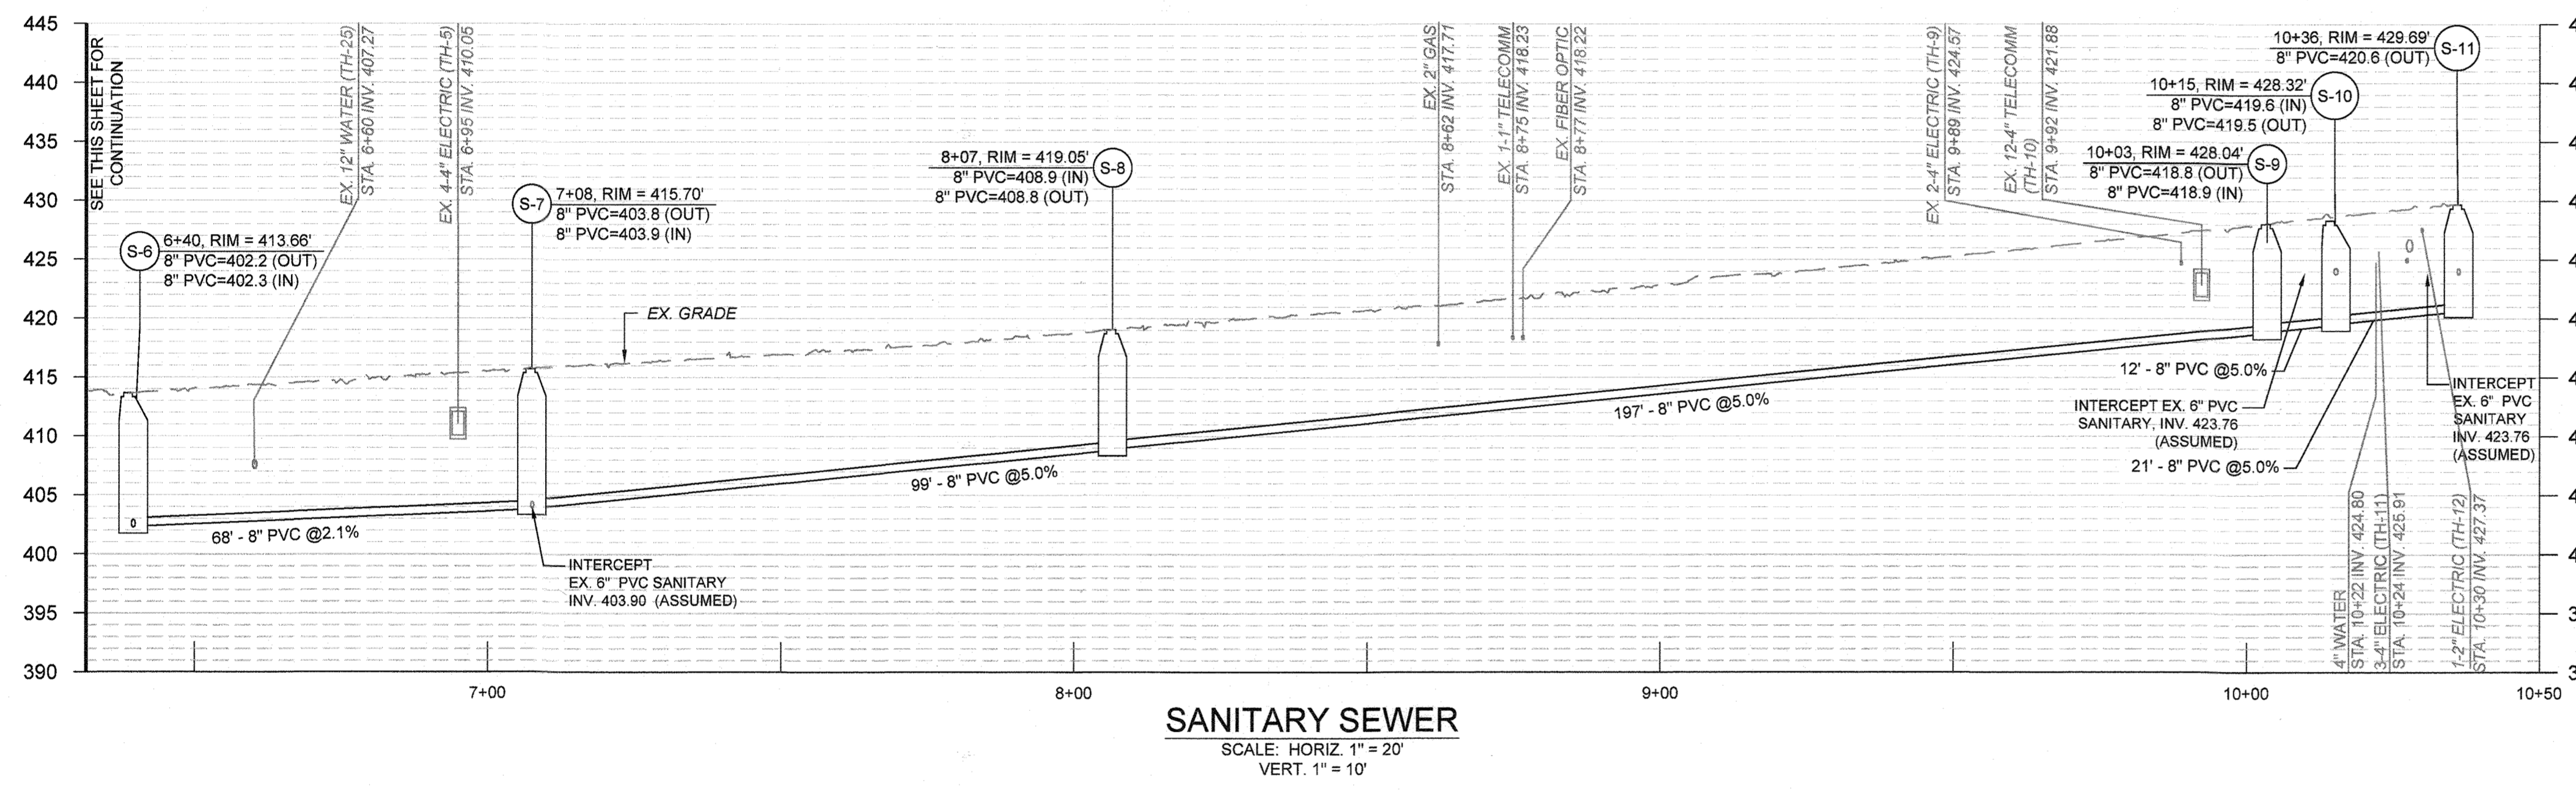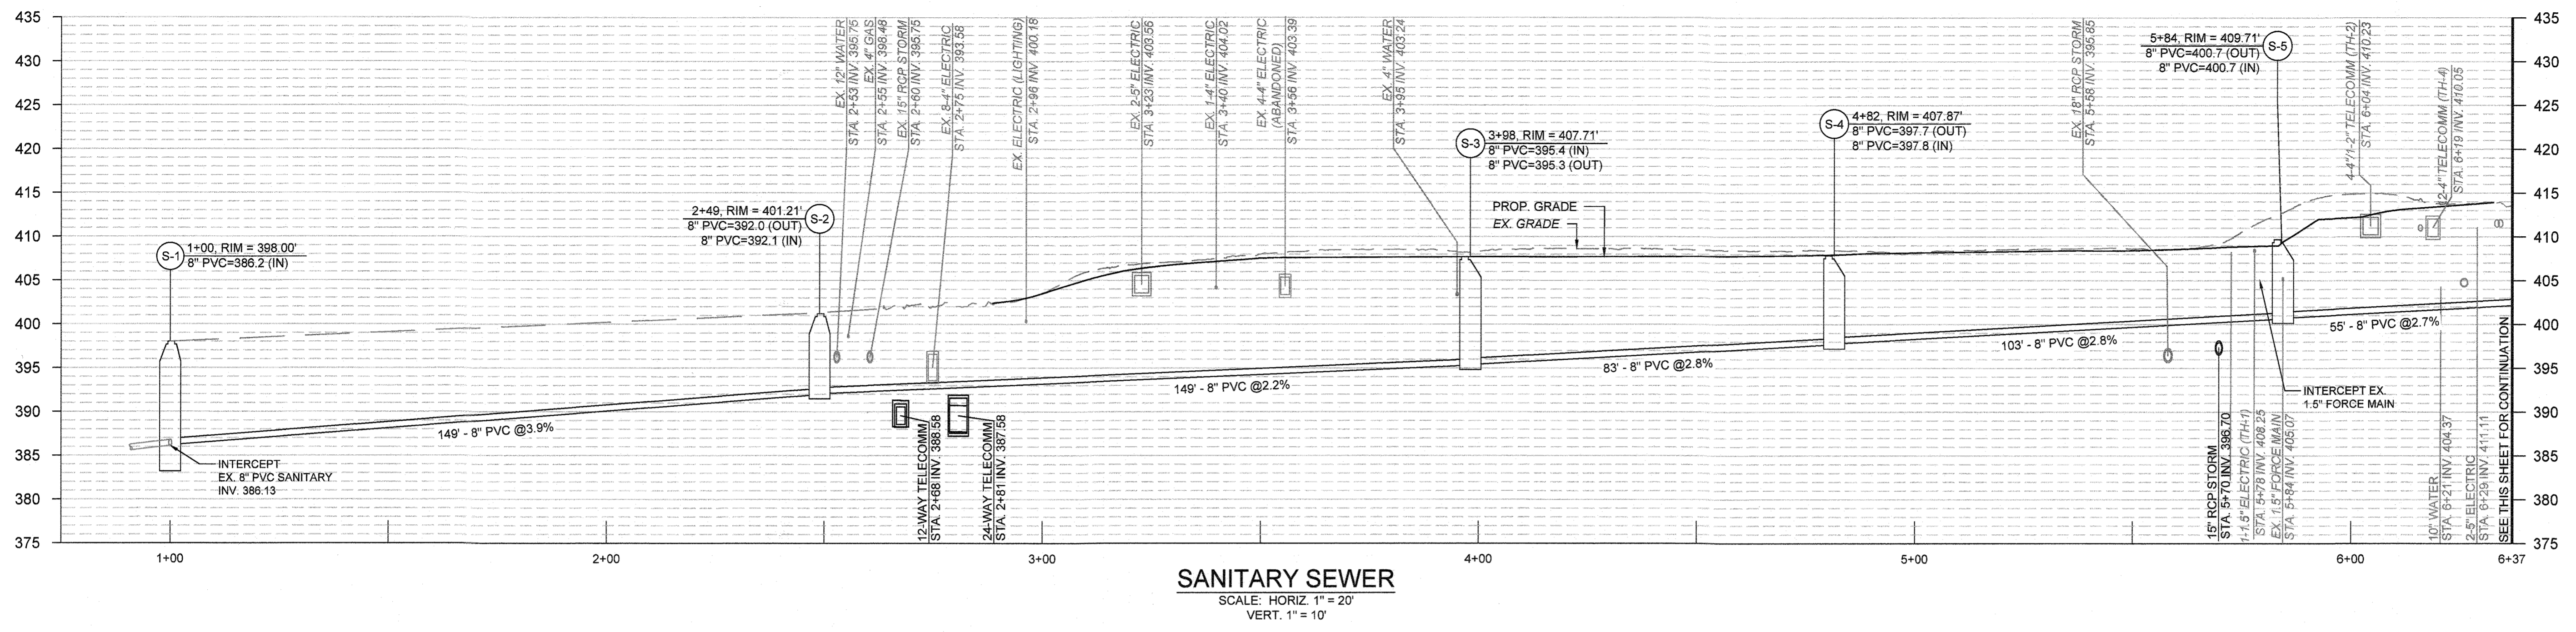

NOTE: ADDITIONAL SEDIMENT TRAP DESIGN INFORMATION CAN BE FOUND ON THE EROSION SEDIMENT CONTROL PROFILES ONSHEET C-698


NOTE: ADDITIONAL SEDIMENT TRAP DESIGN INFORMATION CAN BE FOUND ON THE EROSION SEDIMENT CONTROL PROFILES ONSHEET C-698

▲ PURPOSE STATEMENT (11/1/23): DESIGN OF OUTDOOR TESTING AREA 3, INCLUDING THE SOURCE OF BORROW MATERIAL, REFERRED TO AS THE EAST AND WEST BORROW AREAS.

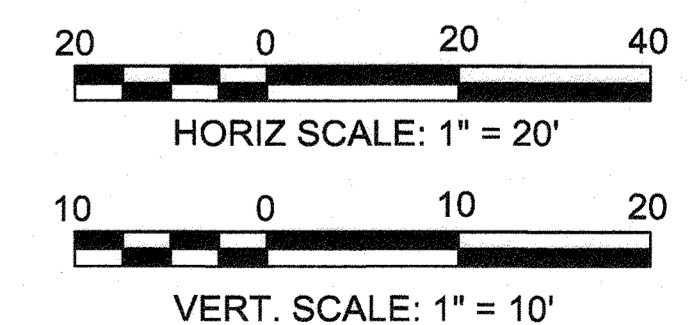

APPROVED: DEPARTMENT OF PLANNING AND ZONING
 Chief, Development Engineering Division
 Chief, Division of Land Development
 Director

RK&K
 RUMMEL, KLEPPER & KANG, LLP
 ENGINEERS/CONSTRUCTION MANAGERS/PLANNERS/SCIENTISTS
 RESPONSIVE PEOPLE • CREATIVE SOLUTIONS
 700 East Pratt Street, Suite 500
 Baltimore, MD 21202
 Ph: 410.728.2900 COLUMBIA: 410.528.1100
 www.rkk.com

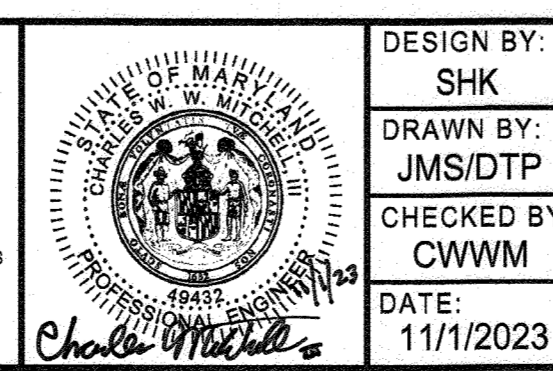


| | | | | |
|-------------|-----------|---|---|---------|
| DRAWN BY: | JMS/DTP | | | |
| CHECKED BY: | CWWM | | | |
| DATE: | 11/1/2023 | | | |
| BY: | NO. | | REVISION | DATE |


OWNER/DEVELOPER
JOHNS HOPKINS
APPLIED PHYSICS LABORATORY
 11100 JOHNS HOPKINS ROAD
 LAUREL, MARYLAND 20723

SANITARY SEWER PROFILES -
BORROW AREA (PHASE 2)
 JOHNS HOPKINS UNIVERSITY - APPLIED PHYSICS LABORATORY
OUTDOOR TESTING AREAS
 11100 JOHNS HOPKINS ROAD
 TAX MAP: 41 PARCEL: 123 GRID: 18 ZONED: PEC
 ELECTION DISTRICT 5 - HOWARD COUNTY, MARYLAND
 SHEET 32 OF 73

C-296
 RK&K PROJECT NUMBER
 21047.013
 SCALE:
 As Shown

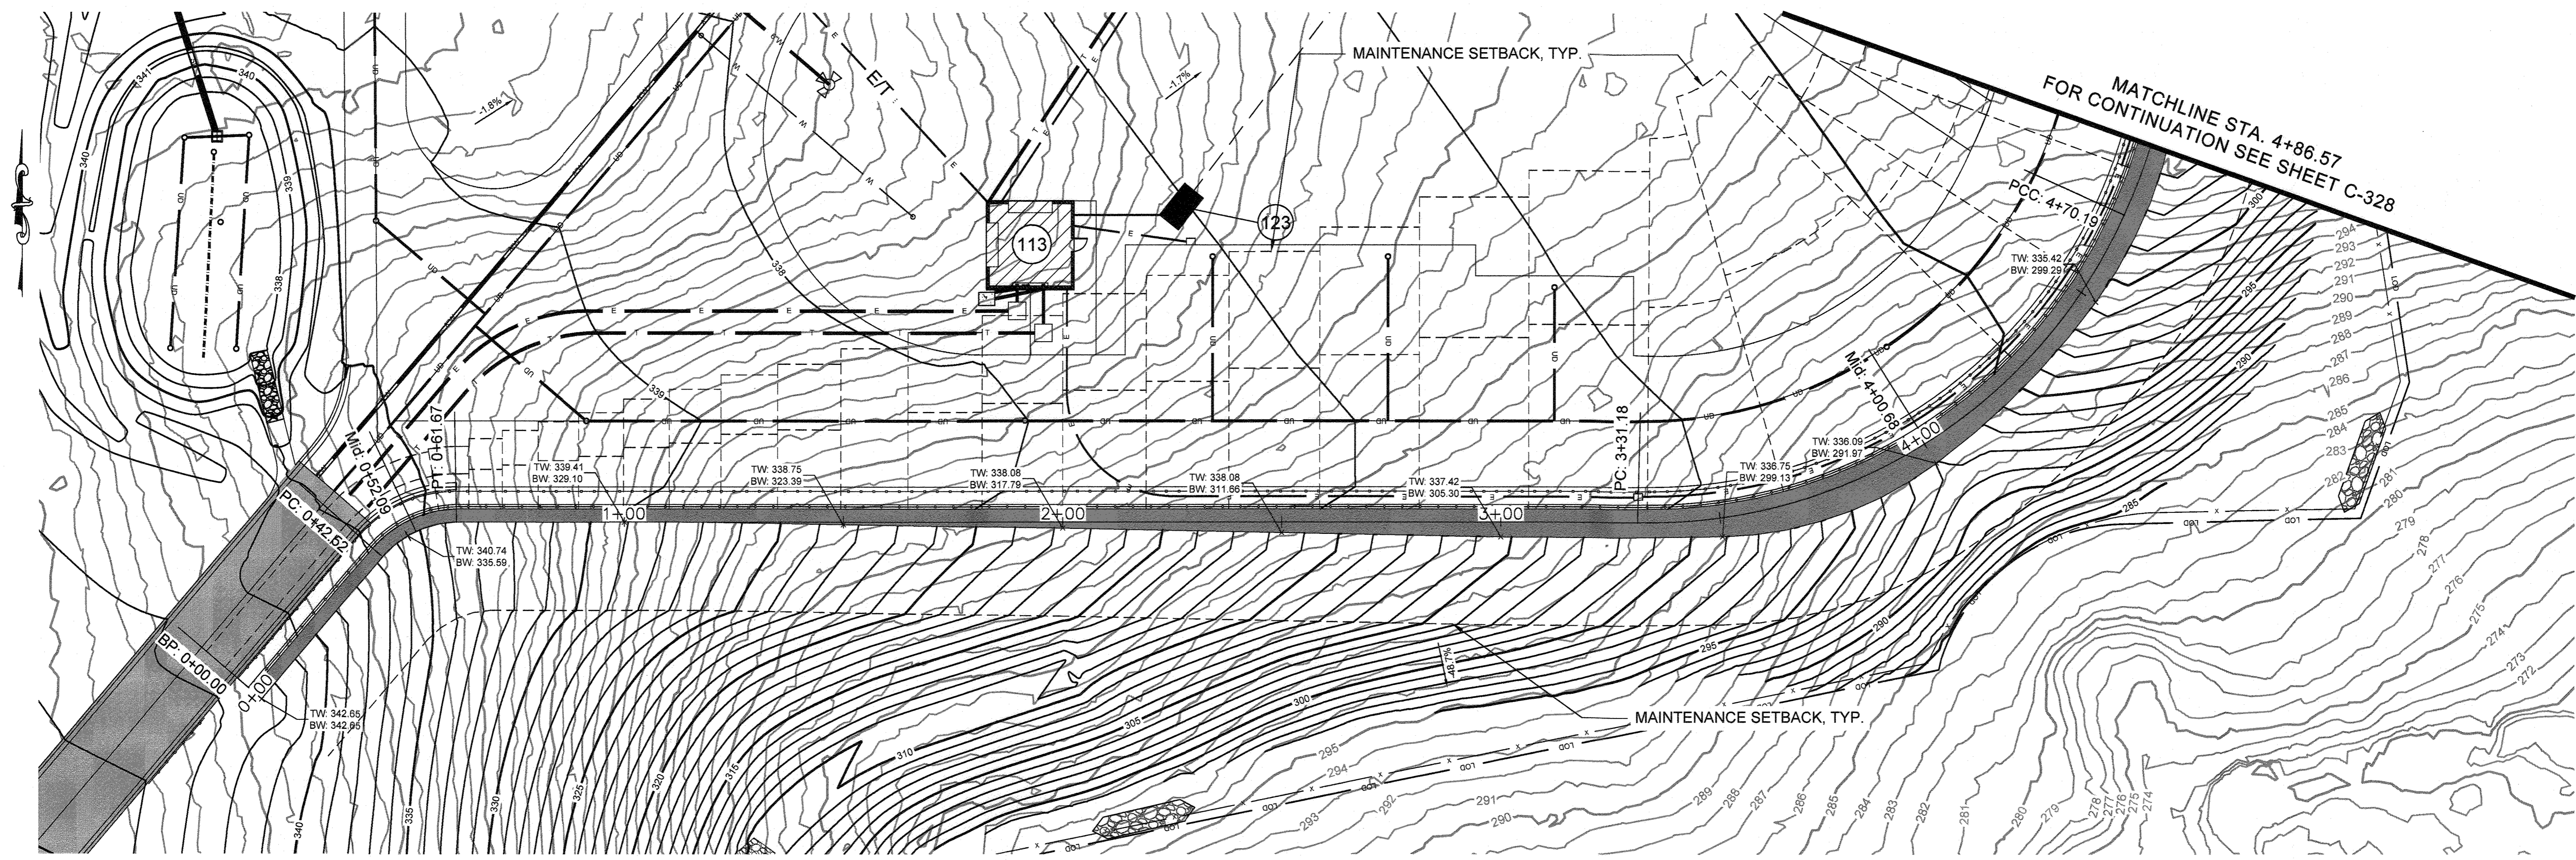


OTA-3 RETAINING WALL PLAN VIEW
SCALE: 1" = 20'

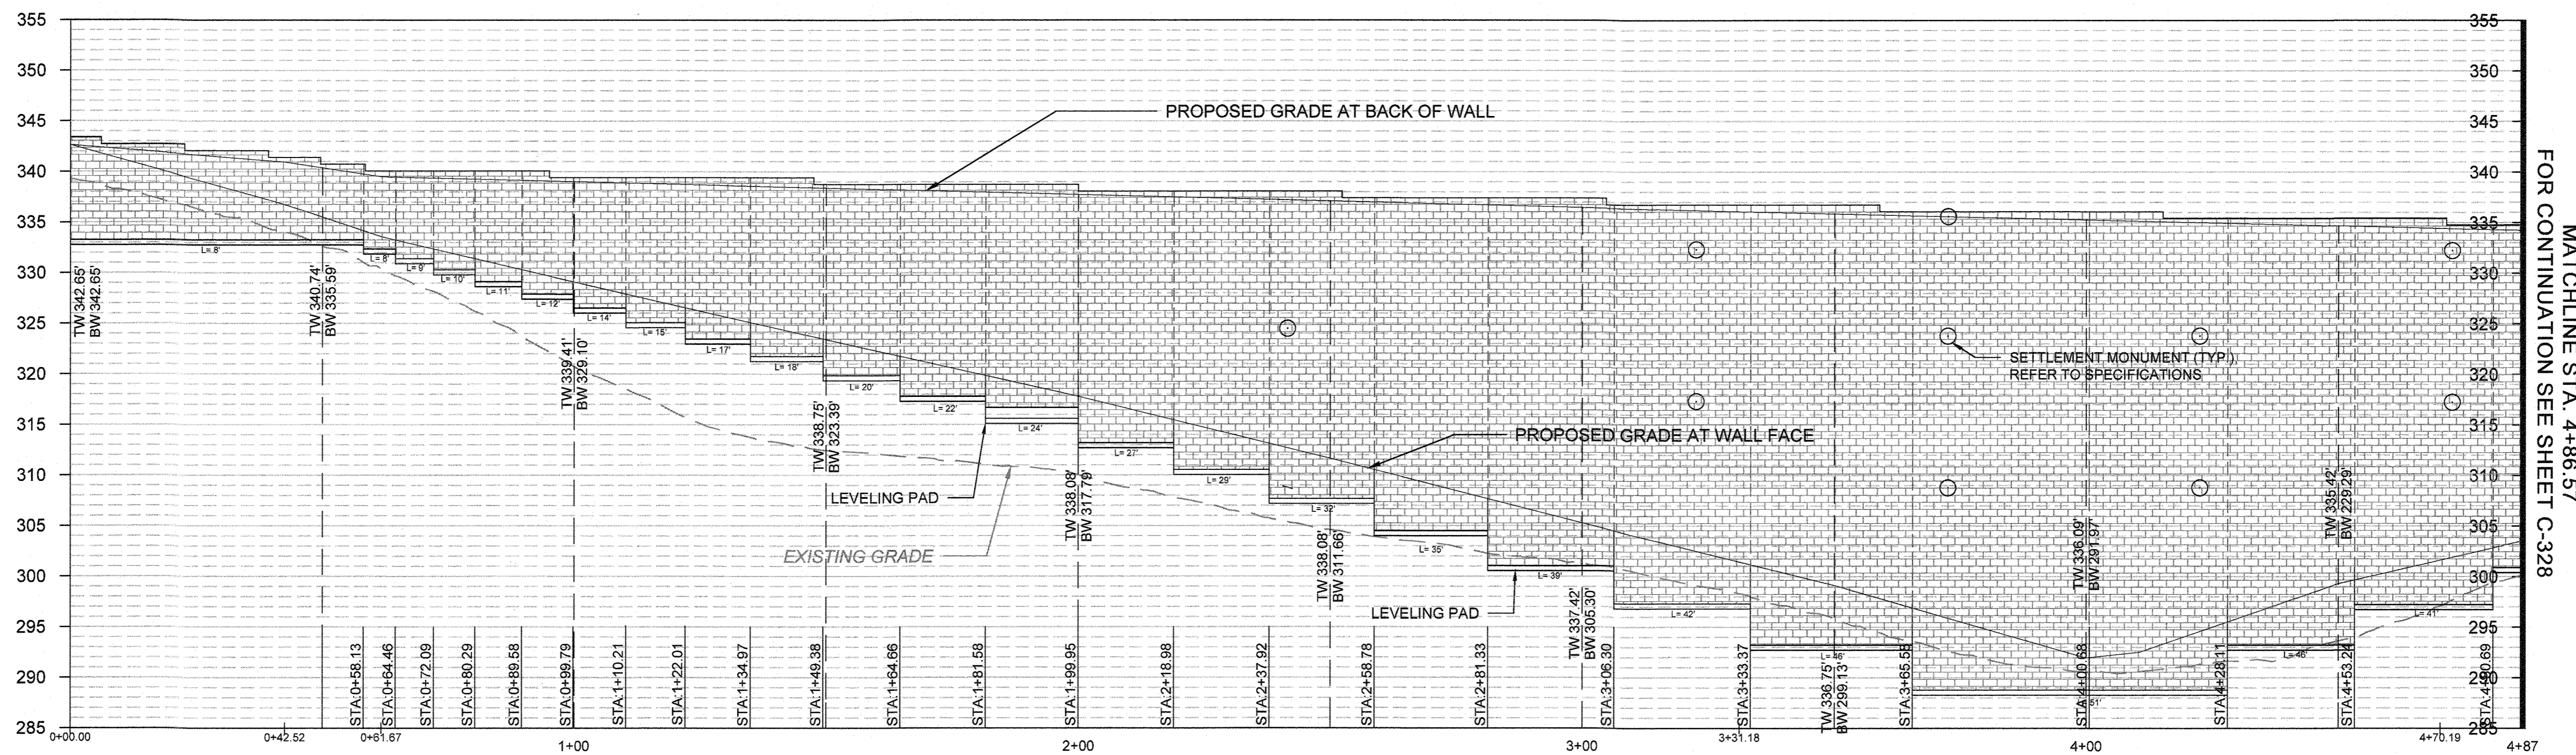

OTA-3 RETAINING WALL PROFILE
SCALE: HORIZ. 1" = 20'
VERT. 1" = 10'

- NOTE:**
- FOR WALL SECTIONS, SEE SHEET C-331.
 - LENGTHS FOR GEO-SYNTHETIC REINFORCEMENT (L) GIVEN ARE MINIMUMS. SEE TYPICAL SECTION FOR DETAILS.


PURPOSE STATEMENT (11/1/23) DESIGN OF OUTDOOR TESTING AREA 3, INCLUDING THE SOURCE OF BORROW MATERIAL. REFERRED TO AS THE EAST AND WEST BORROW AREAS.

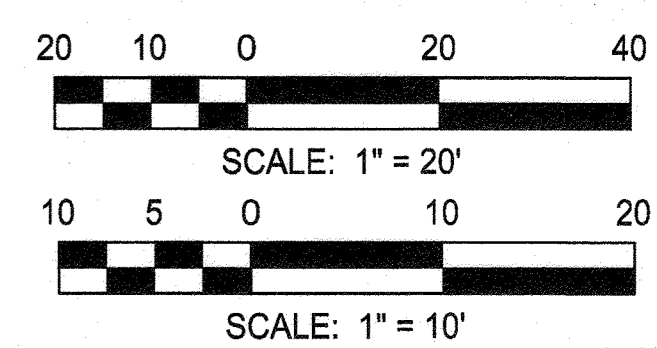

APPROVED: DEPARTMENT OF PLANNING AND ZONING
Chief, Development Engineering Division
 Date: 12.5.23
Chief, Division of Land Development
 Date: 12/21/24



PROFESSIONAL CERTIFICATION: I HEREBY CERTIFY THAT THESE DOCUMENTS WERE PREPARED OR APPROVED BY ME, AND THAT I AM A DULY LICENSED PROFESSIONAL ENGINEER UNDER THE LAWS OF THE STATE OF MARYLAND. LICENSE NO. 49432, EXPIRATION DATE: MAY 31, 2024.

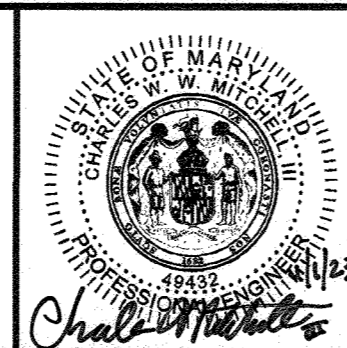


| | | | | | |
|-------------|-----------|------|-----|---|---------|
| DESIGN BY: | SHK | RK&K | 4 | New Sheet - OTA-3 and Borrow Area Modifications | 11/1/23 |
| DRAWN BY: | JMS/DTP | | | | |
| CHECKED BY: | CWMM | | | | |
| DATE: | 11/1/2023 | BY | NO. | REVISION | DATE |

OWNER/DEVELOPER
JOHNS HOPKINS APPLIED PHYSICS LABORATORY
 11100 JOHNS HOPKINS ROAD
 LAUREL, MARYLAND 20723


RETAINING WALL ELEVATION - OTA 3
 (PHASE 2)
 JOHNS HOPKINS UNIVERSITY - APPLIED PHYSICS LABORATORY
OUTDOOR TESTING AREAS
 11100 JOHNS HOPKINS ROAD
 TAX MAP: 41 PARCEL: 123 GIS: 16 ZONED: PEC
 ELECTION DISTRICT 5 - HOWARD COUNTY, MARYLAND
 SHEET 37 OF 73

C-327
 RK&K PROJECT NUMBER
 21047.013
 SCALE:
 As Shown

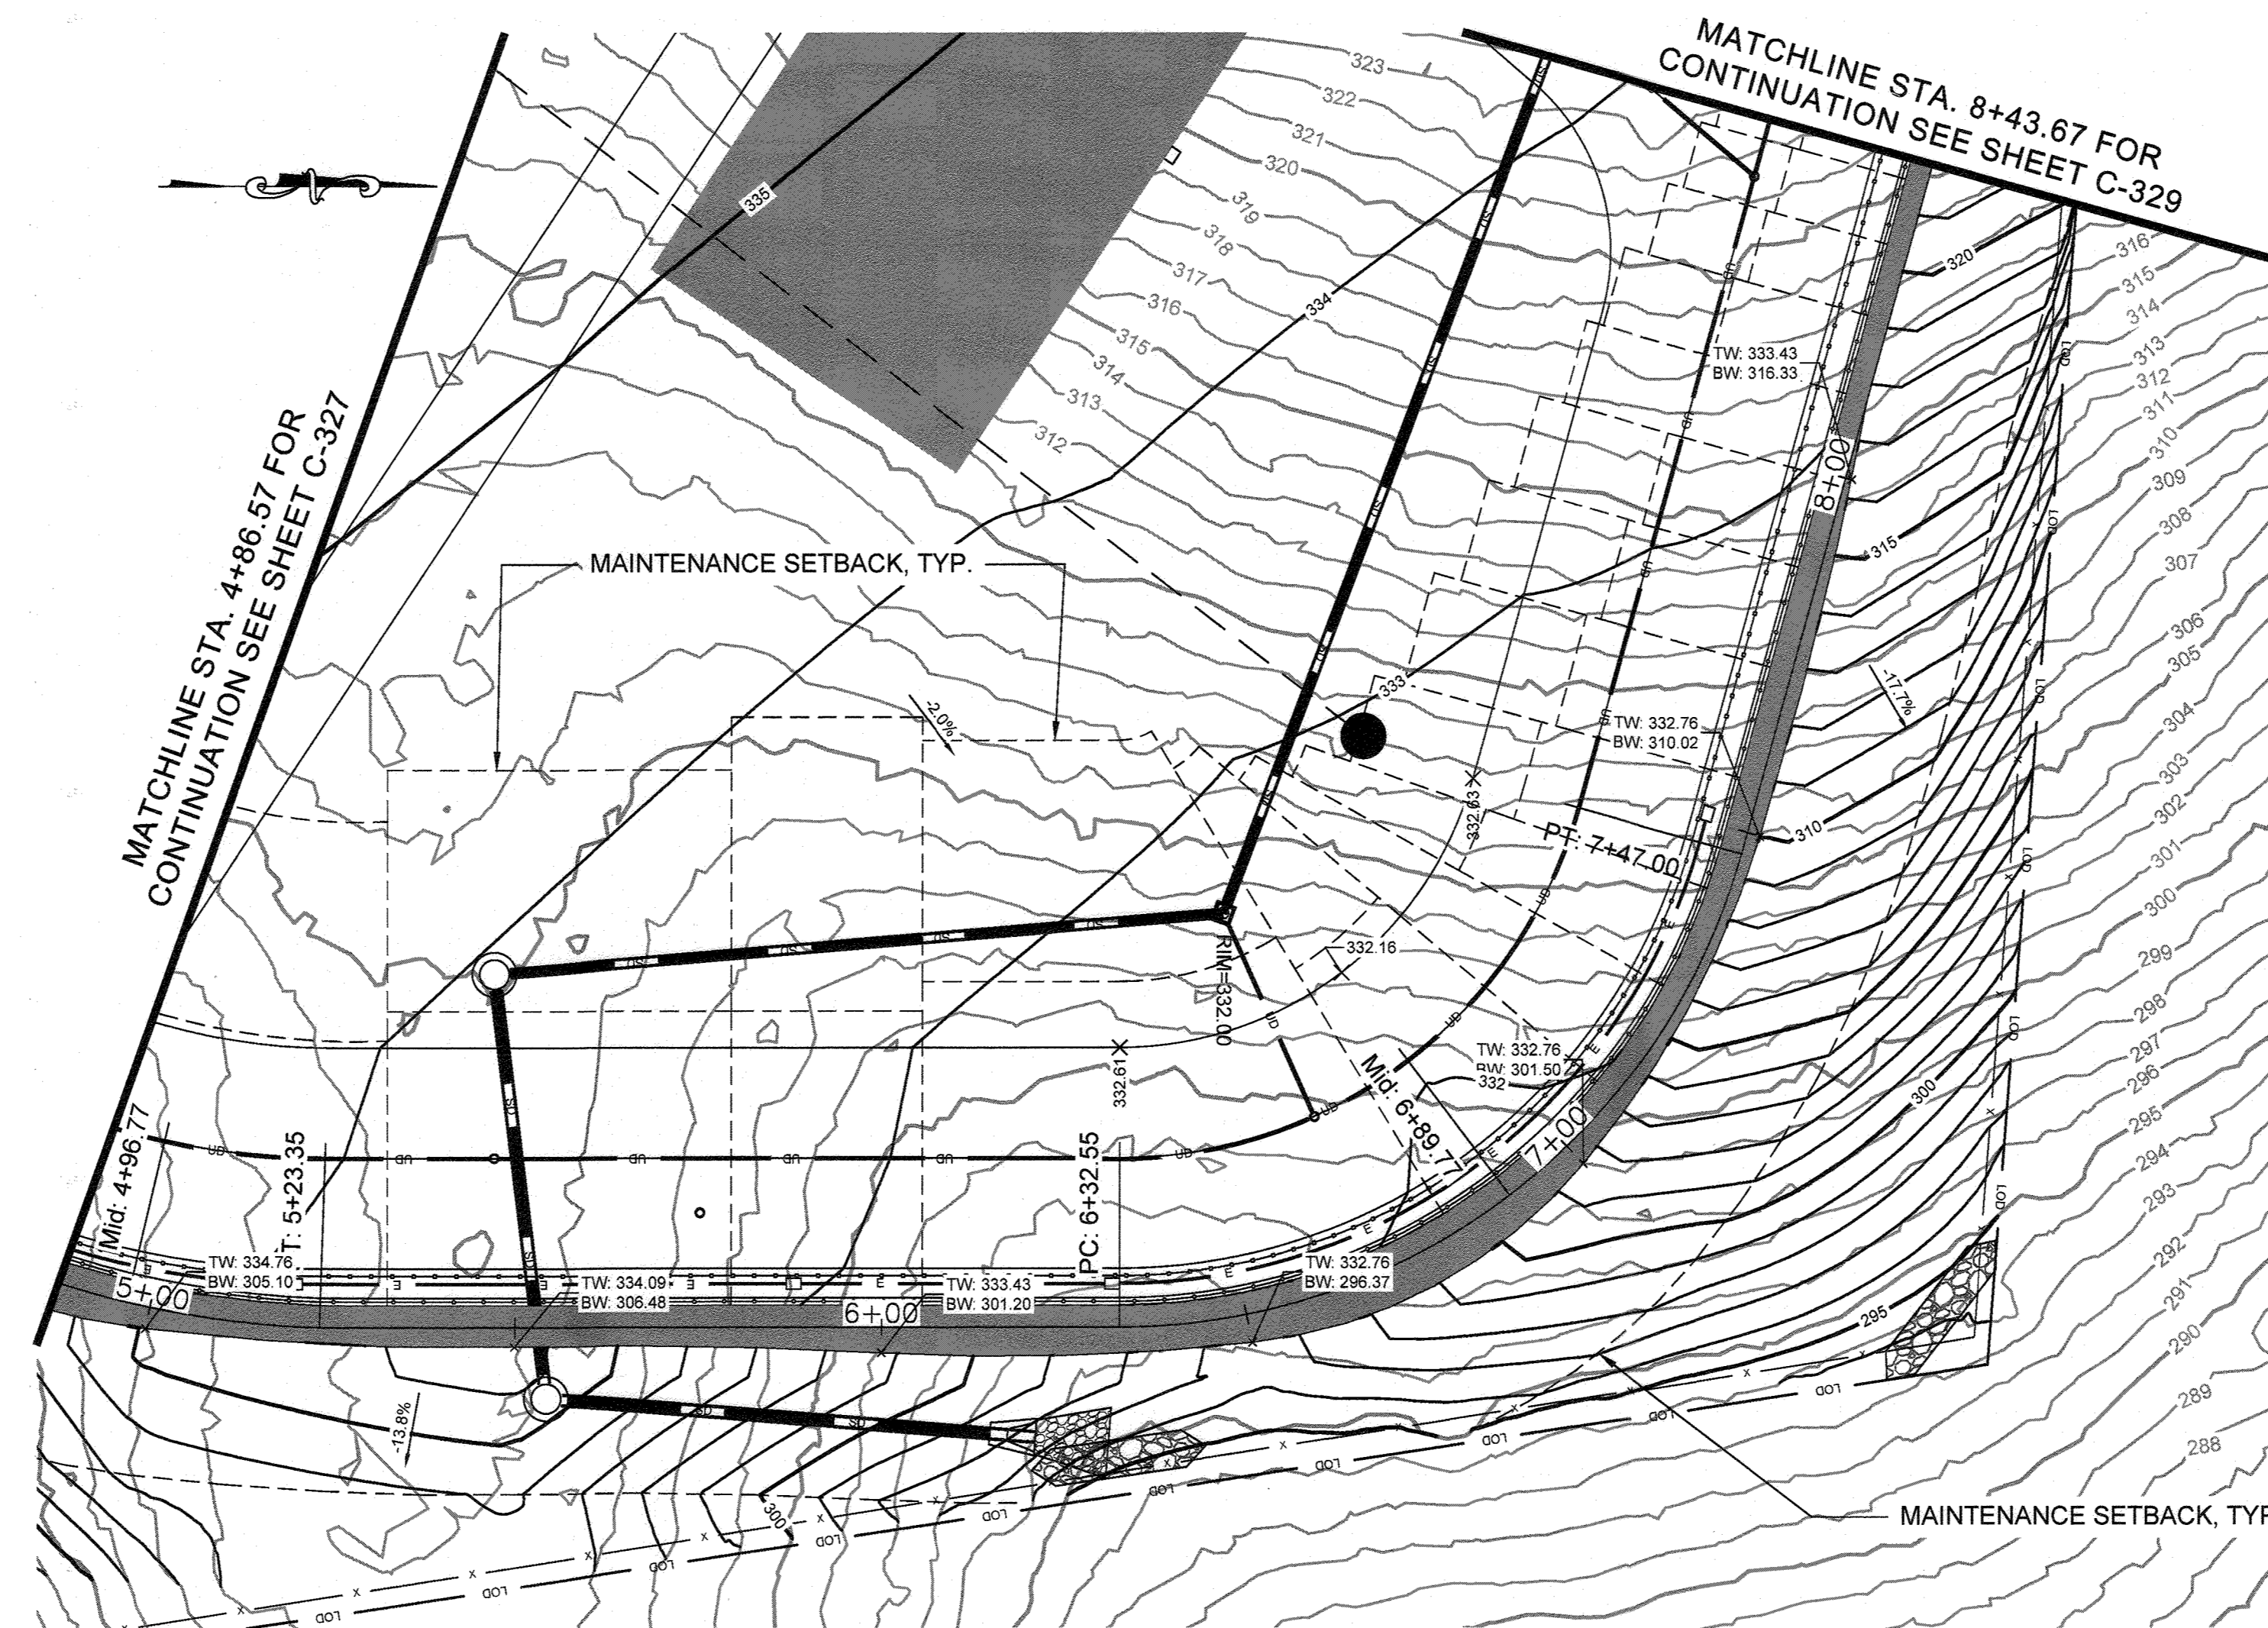


OTA-3 RETAINING WALL PLAN VIEW

SCALE: 1" = 20'

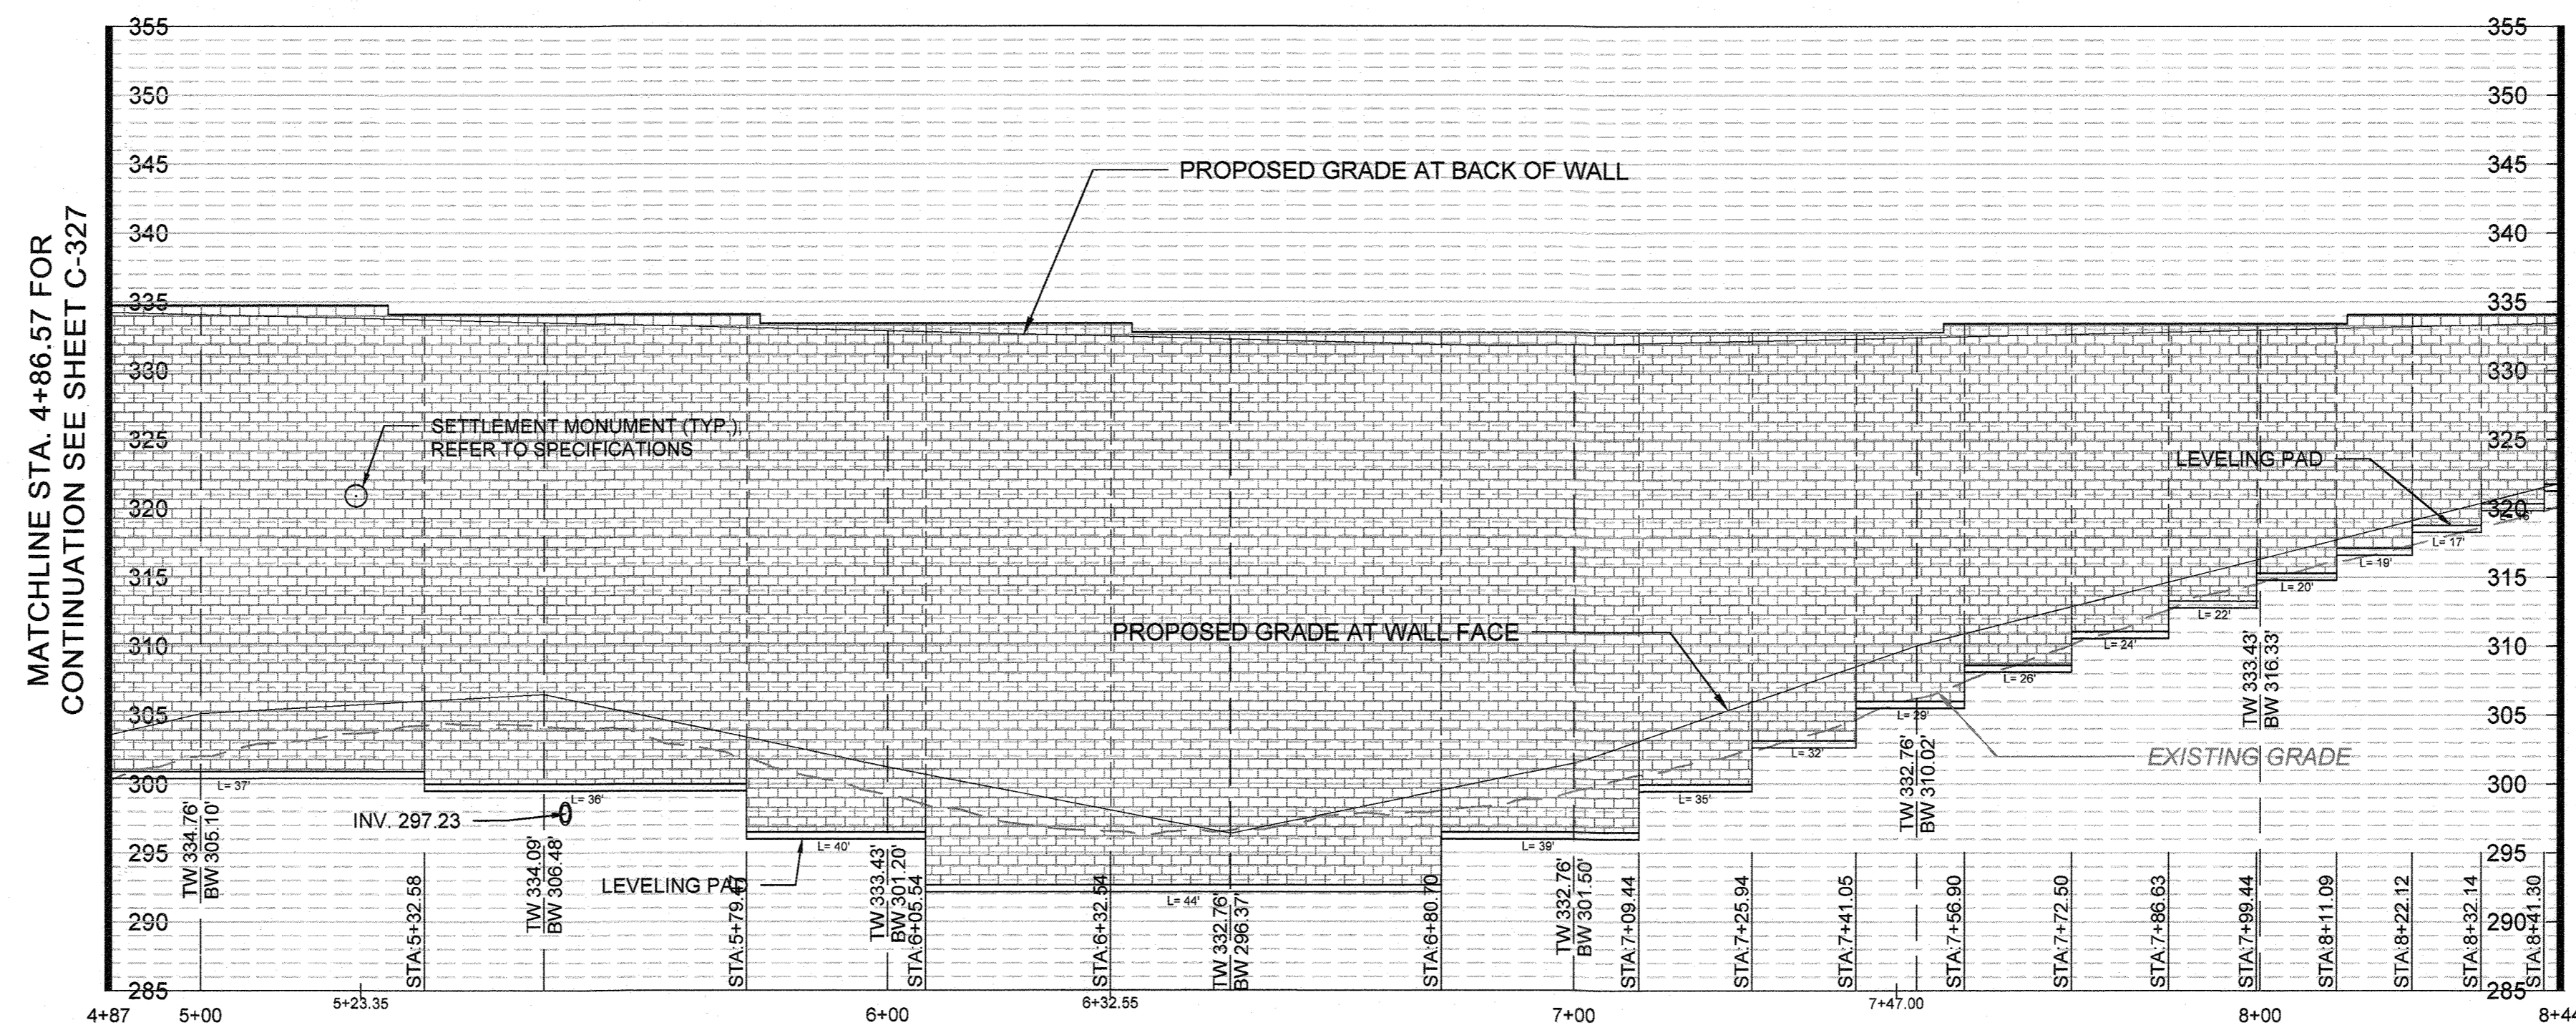

OTA-3 RETAINING WALL PROFILE

SCALE: HORIZ. 1" = 20'
VERT. 1" = 10'

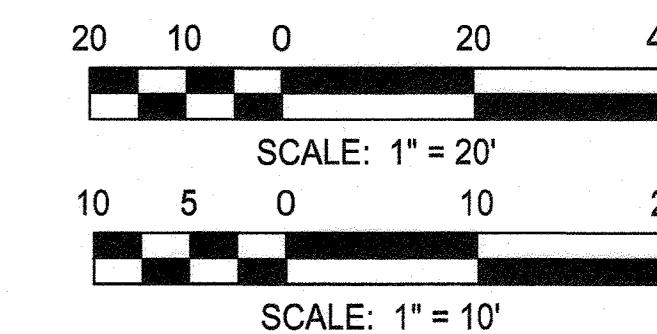

- NOTE:
- FOR WALL SECTIONS, SEE SHEET C-331.
 - LENGTHS FOR GEO-SYNTHETIC REINFORCEMENT (L) GIVEN ARE MINIMUMS. SEE TYPICAL SECTION FOR DETAILS.


PURPOSE STATEMENT (11/1/23): DESIGN OF OUTDOOR TESTING AREA 3, INCLUDING THE SOURCE OF BORROW MATERIAL, REFERRED TO AS THE EAST AND WEST BORROW AREAS.

APPROVED: DEPARTMENT OF PLANNING AND ZONING
 Chief, Development Engineering Division
 Chief, Division of Land Development
 Director

Date: 12-5-23
 Date: 2/22/24
 Date:



PROFESSIONAL CERTIFICATION: I HEREBY CERTIFY THAT THESE DOCUMENTS WERE PREPARED OR APPROVED BY ME AND THAT I AM A DULY LICENSED PROFESSIONAL ENGINEER UNDER THE LAWS OF THE STATE OF MARYLAND. LICENSE NO. 49432, EXPIRATION DATE: MAY 31, 2024.

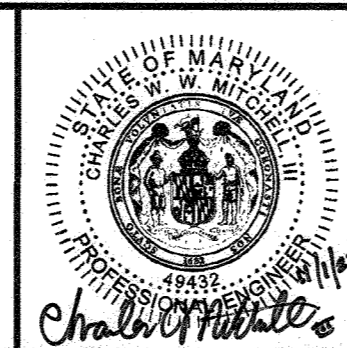


| | | | | | |
|-------------|-----------|------|-----|---|---------|
| DESIGN BY: | SHK | RK&K | 4 | New Sheet - OTA-3 and Borrow Area Modifications | 11/1/23 |
| DRAWN BY: | JMS/DTP | | | | |
| CHECKED BY: | CWWM | | | | |
| DATE: | 11/1/2023 | BY | NO. | REVISION | DATE |

OWNER/DEVELOPER
**JOHNS HOPKINS
 APPLIED PHYSICS LABORATORY**
 11100 JOHNS HOPKINS ROAD
 LAUREL, MARYLAND 20723

RETAINING WALL ELEVATION - OTA 3
 (PHASE 2)
 JOHNS HOPKINS UNIVERSITY - APPLIED PHYSICS LABORATORY
OUTDOOR TESTING AREAS
 11100 JOHNS HOPKINS ROAD
 TAX MAP: 41 PARCEL: 123 SRID: 16 ZONED: PEC
 ELECTION DISTRICT 5 - HOWARD COUNTY, MARYLAND
 SHEET 38 OF 73

RK&K PROJECT NUMBER: 21047.013
 SCALE: As Shown


I:\ad.rkk.com\fa\Cloud\Projects\2021\21047_ARL2021MSA\Projects\Task 13 - OTA 3\CADD\Plans\C-327 - C-329 Retaining Wall Elevations - OTA 3 (Phase 2).dwg Oct 31, 2023 1:24pm jscitlz

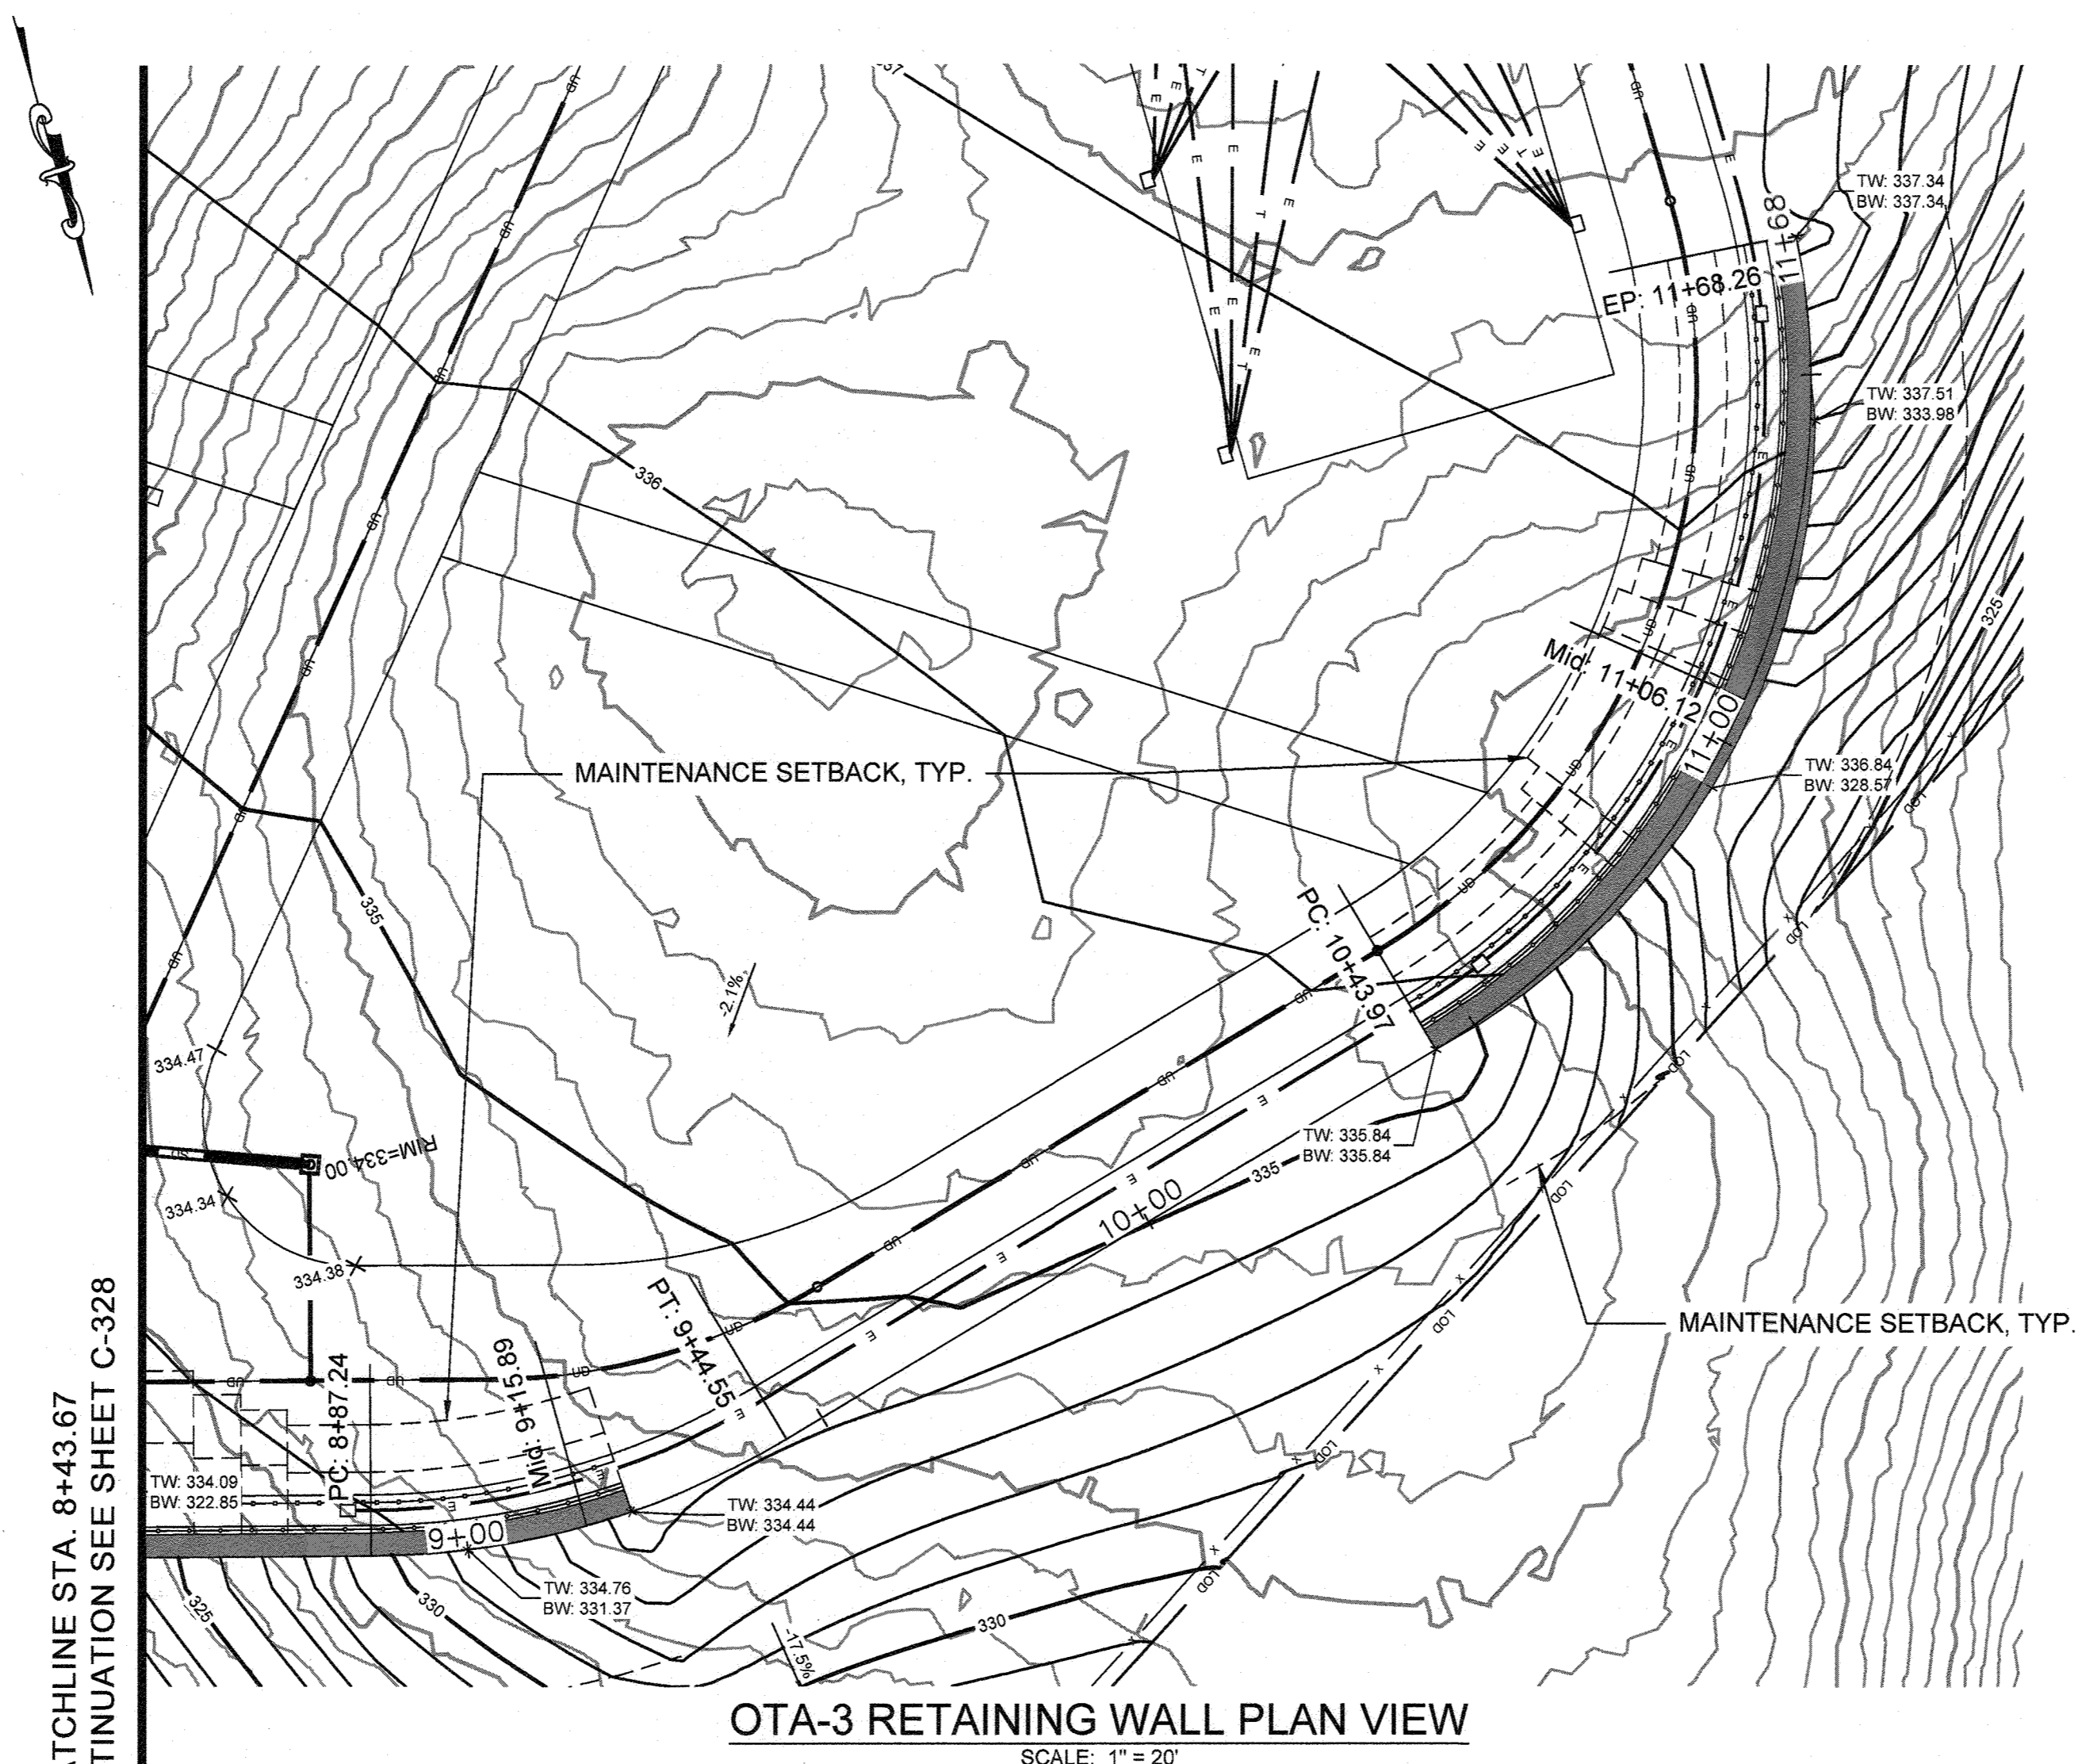

MATCHLINE STA. 8+43.67
 FOR CONTINUATION SEE SHEET C-328


OTA-3 RETAINING WALL PLAN VIEW

SCALE: 1" = 20'

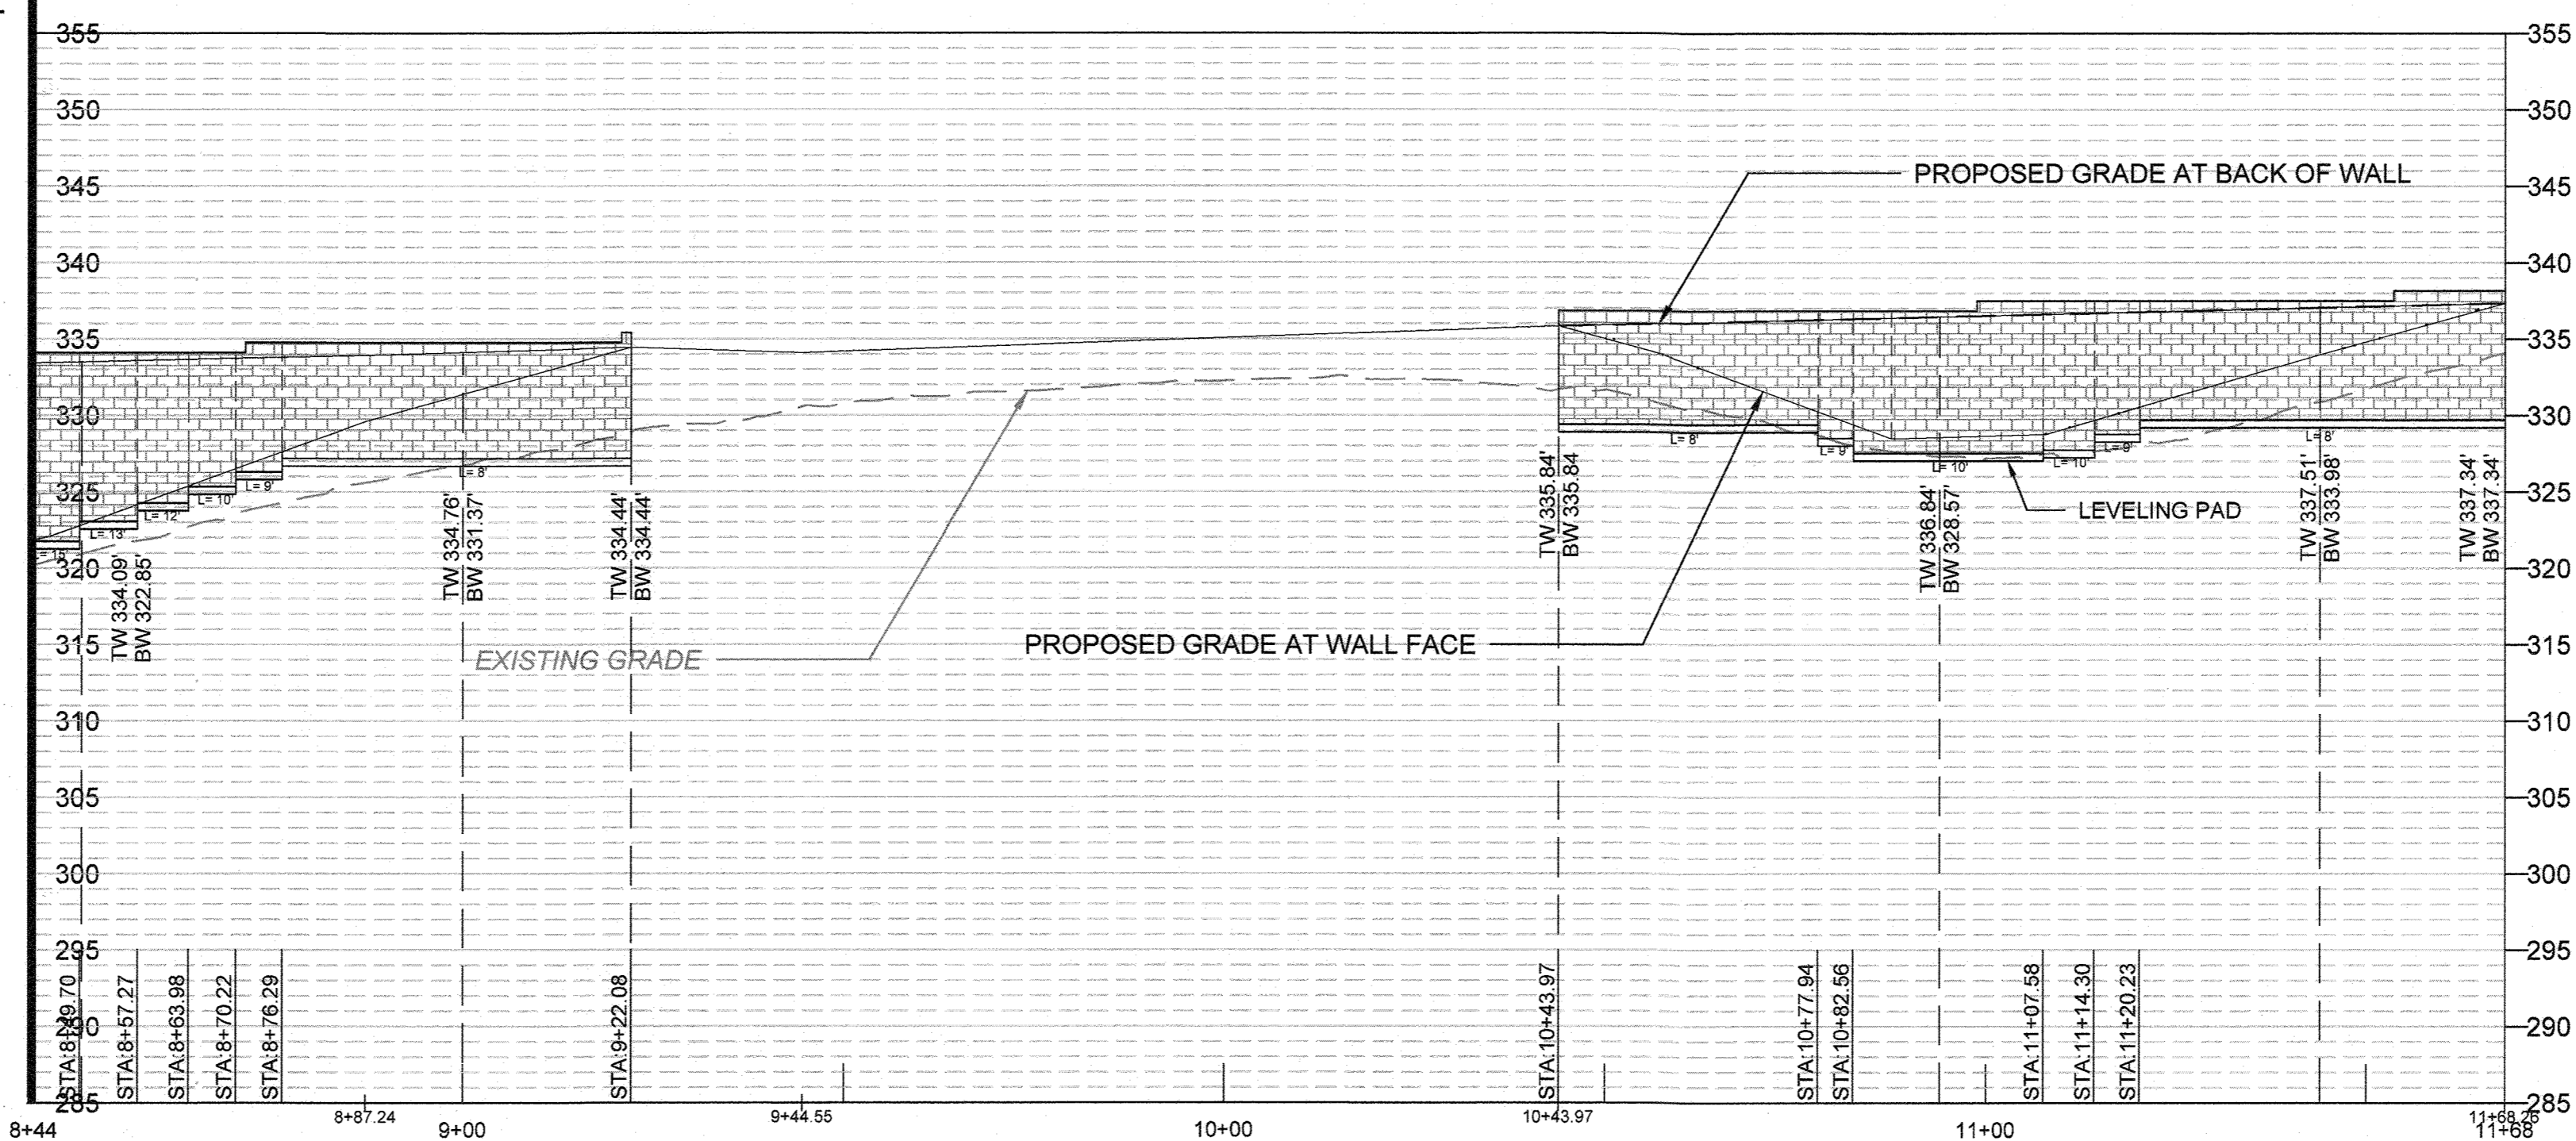

OTA-3 RETAINING WALL PROFILE

SCALE: HORIZ. 1" = 20'
VERT. 1" = 10'

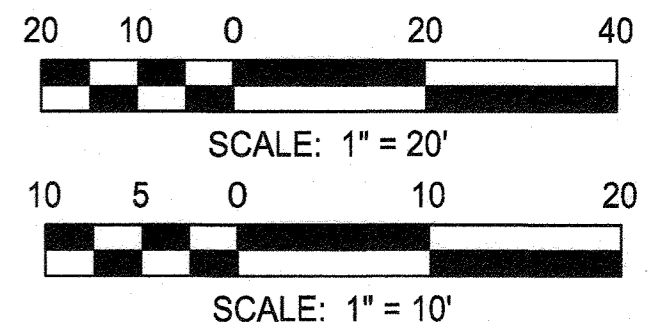


- NOTE:**
- FOR WALL SECTIONS, SEE SHEET C-331.
 - LENGTHS FOR GEO-SYNTHETIC REINFORCEMENT (L) GIVEN ARE MINIMUMS. SEE TYPICAL SECTION FOR DETAILS.

PURPOSE STATEMENT (11/1/23): DESIGN OF OUTDOOR TESTING AREA 3, INCLUDING THE SOURCE OF BORROW MATERIAL, REFERRED TO AS THE EAST AND WEST BORROW AREAS.

APPROVED: DEPARTMENT OF PLANNING AND ZONING
 Chief, Development Engineering Division
 Chief, Division of Land Development
 Director

RK&K
 RUMMEL, KLEPPER & KAHL, LLP
 ENGINEERS/ARCHITECTS/PLANNERS/SCIENTISTS
 RESPONSIVE PEOPLE • CREATIVE SOLUTIONS
 700 East Pratt Street, Suite 500
 Baltimore, MD 21202
 Ph: 410.728.2200 Cell: 410.728.2200
 www.rkk.com


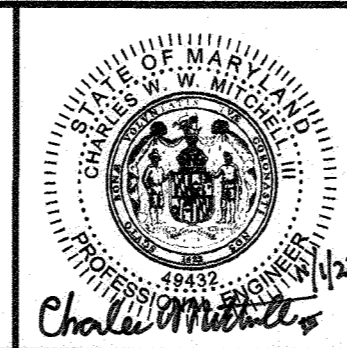


| | | | | |
|----------------------|------|-----|---|---------|
| DESIGN BY: SHK | RK&K | 4 | New Sheet - OTA-3 and Borrow Area Modifications | 11/1/23 |
| DRAWN BY: JMS/DTP | | | | |
| CHECKED BY: CWW/M | | | | |
| DATE: 11/1/2023 | BY | NO. | REVISION | DATE |

OWNER/DEVELOPER
**JOHNS HOPKINS
 APPLIED PHYSICS LABORATORY**
 11100 JOHNS HOPKINS ROAD
 LAUREL, MARYLAND 20723

RETAINING WALL ELEVATION - OTA 3
 (PHASE 2)
 JOHNS HOPKINS UNIVERSITY - APPLIED PHYSICS LABORATORY
OUTDOOR TESTING AREAS
 11100 JOHNS HOPKINS ROAD
 TAX MAP: 41 PARCEL 123 SRD: 16 ZONED: PEC
 ELECTION DISTRICT 5 - HOWARD COUNTY, MARYLAND
 SHEET 39 OF 73

C-329
 RK&K PROJECT NUMBER
 21047.013
 SCALE:
 As Shown

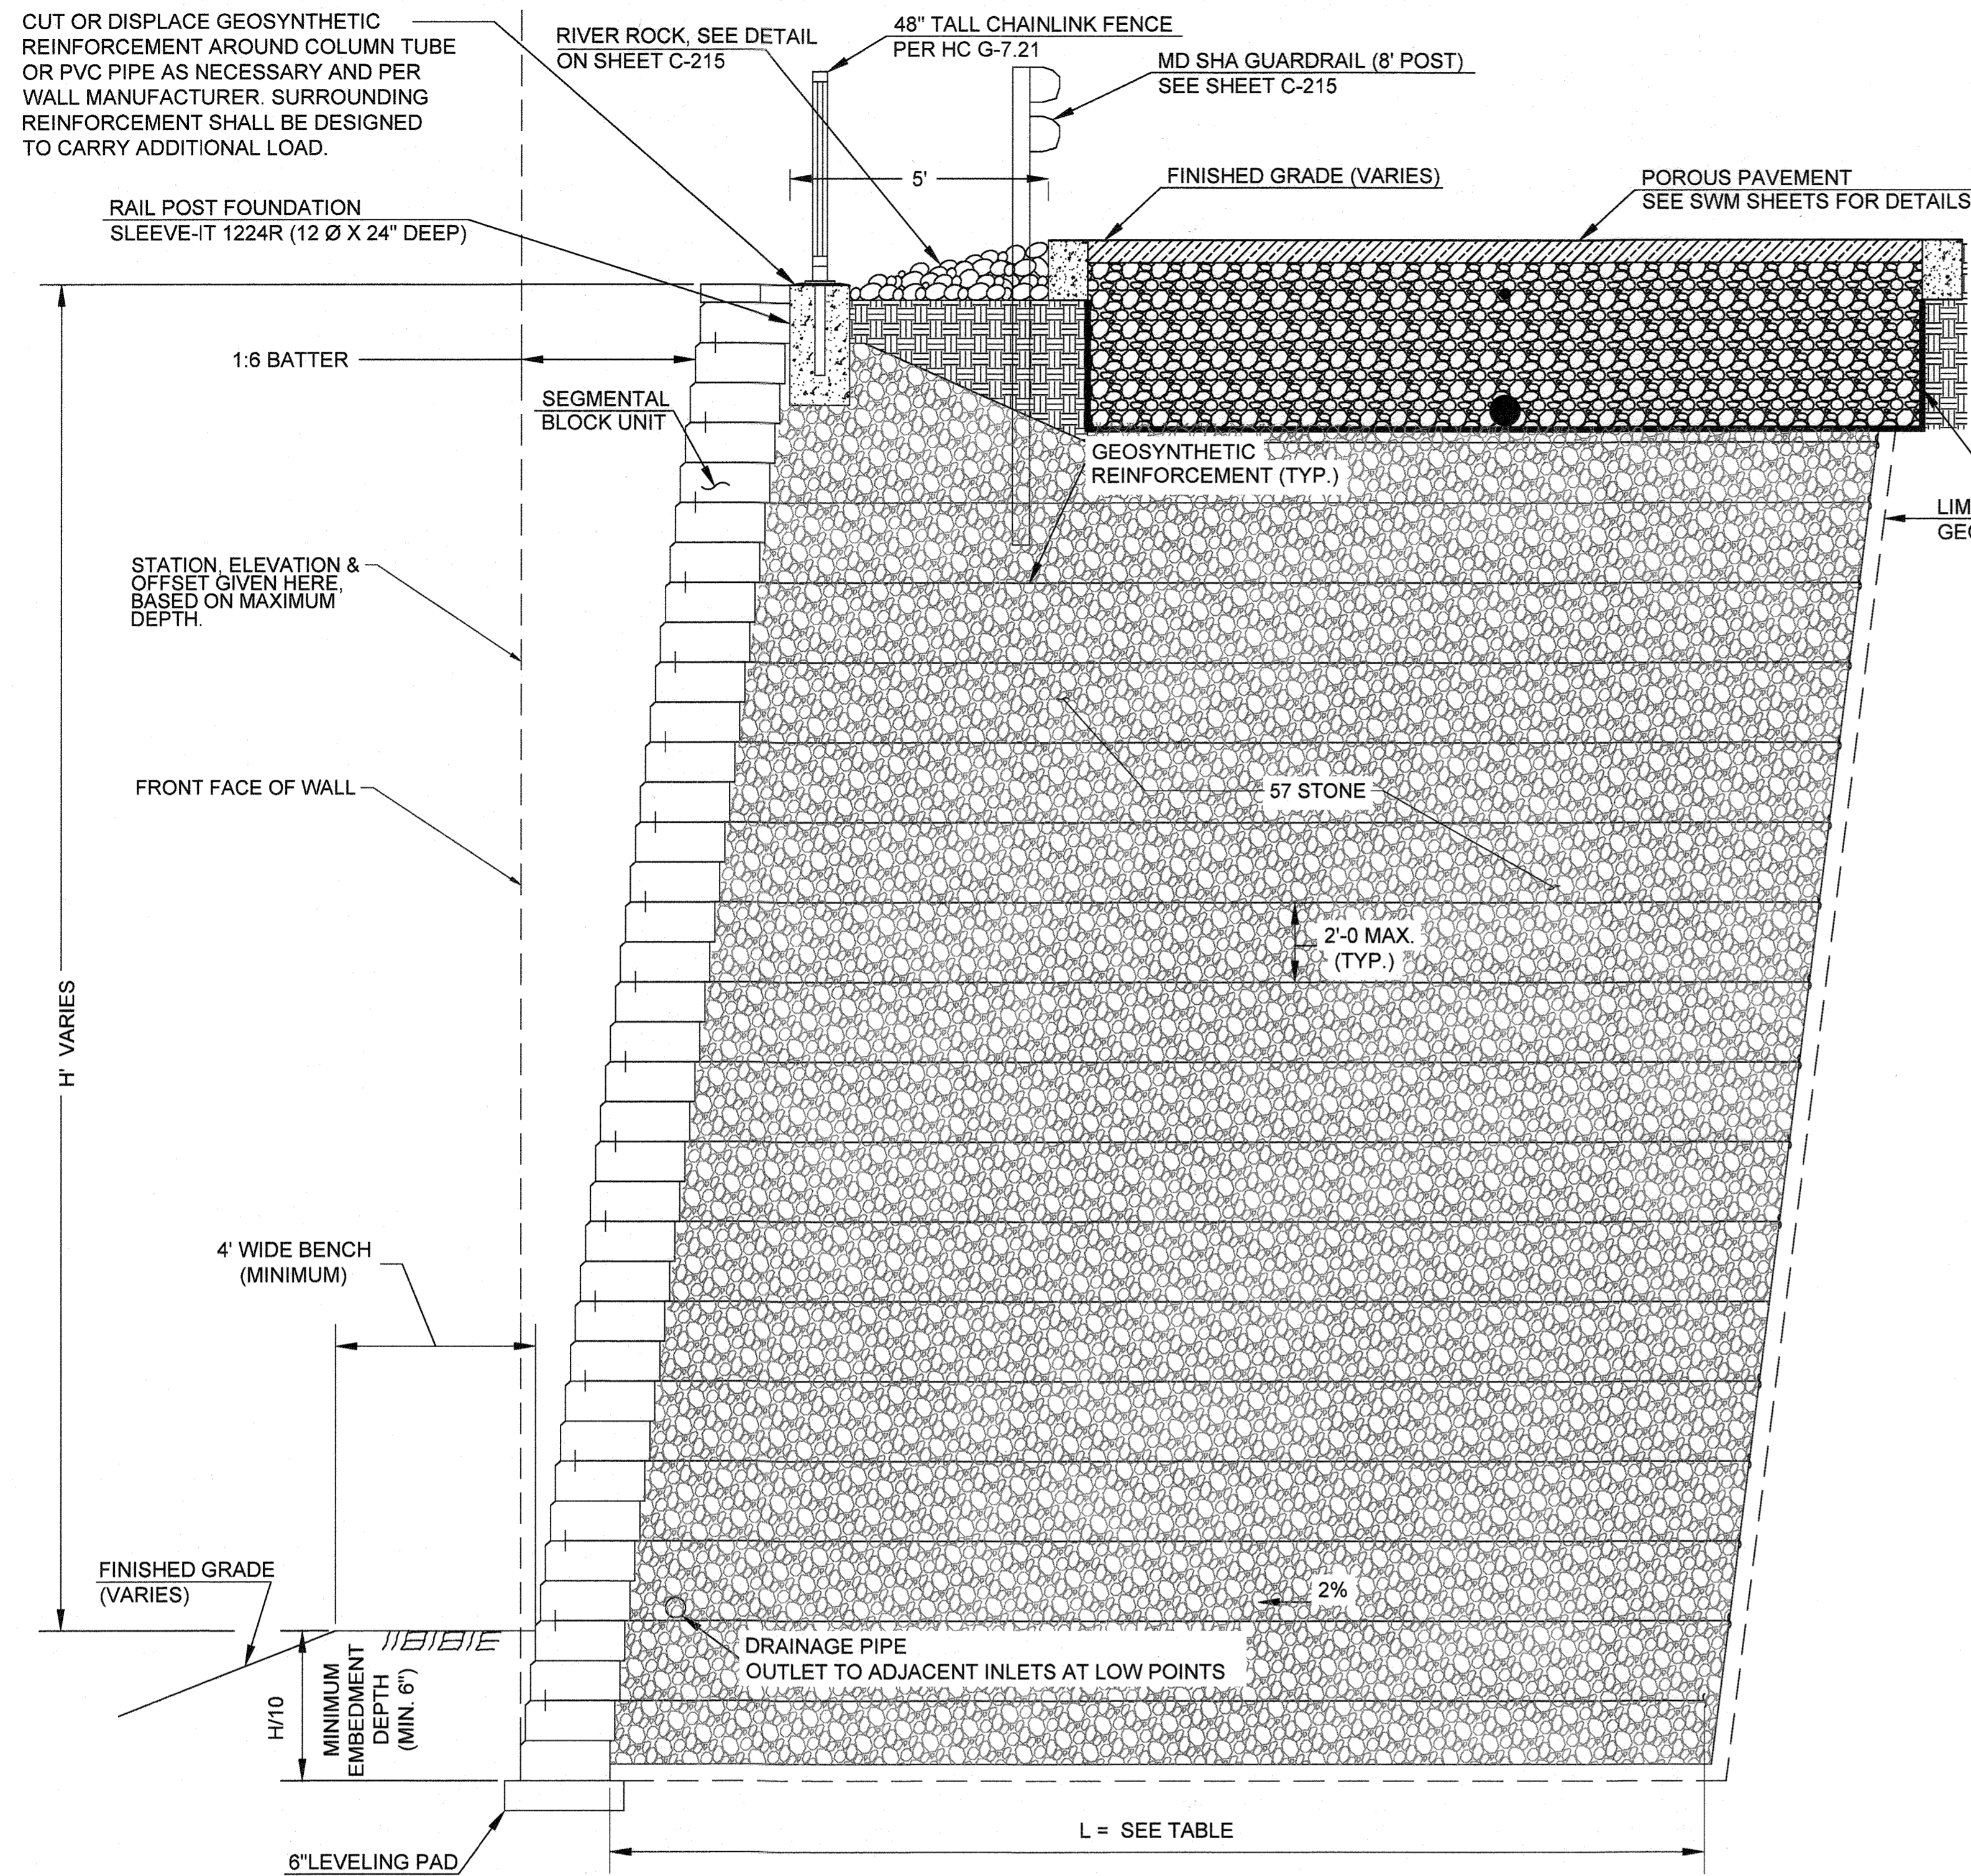

TYPICAL SECTION FOR SEGMENTAL BLOCK RETAINING WALL


SCALE: 1/2" = 1'-0"

| RETAINING WALL DESIGN PARAMETERS | | | |
|----------------------------------|---------------------|-------------------------------------|--|
| MATERIAL | Description | DESIGN UNIT WEIGHT - γ (pcf) | DRAINED ANGLE OF FRICTION - ϕ (deg) |
| Foundation Soil | Natural Soil | 125 | 30 |
| Retained Soil | Fill, Common Borrow | 125 | 30 |
| Reinforced Soil | No. 57 Stone | 105 | 38 |

| RETAINING WALL REINFORCEMENT MINIMUM LENGTHS (L) | | |
|--|--------------------|------------------------------------|
| OTA | Description | Minimum Reinforcement Strap Length |
| 3 | Entire Wall Length | 1.2H' |

H' = The full height of the wall excluding embedment (ft)

▲ PURPOSE STATEMENT (11/1/23): DESIGN OF OUTDOOR TESTING AREA 3, INCLUDING THE SOURCE OF BORROW MATERIAL, REFERRED TO AS THE EAST AND WEST BORROW AREAS.


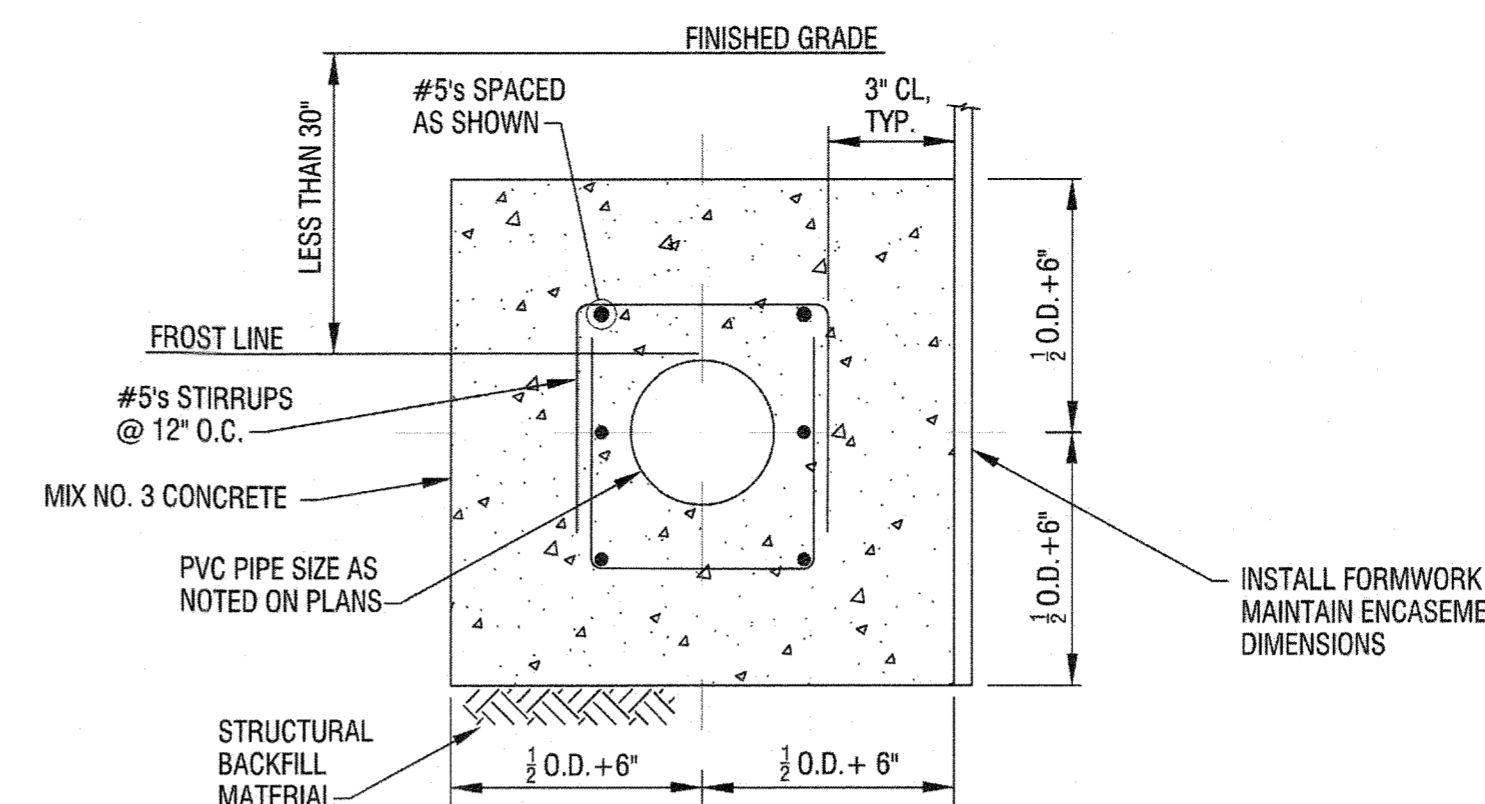


CONCRETE ENCASED PIPE

SCALE: NTS

NOTES:

- THE LOWEST GEOSYNTHETIC REINFORCEMENT SHALL NOT BE MORE THAN 12" FROM BOTTOM OF WALL.
- FOR FENCE DETAILS SEE SHEET C-215.
- WALL MANUFACTURER SHALL DESIGN SIZE, LENGTH AND QUANTITY OF GEOSYNTHETIC REINFORCEMENT. PROVIDED INFORMATION IS MINIMUM REQUIRED.
- WALL MANUFACTURER SHALL DESIGN DRAINAGE SYSTEM. DRAINAGE INFORMATION SHOWN FOR CLARITY.
- THE CONTRACTOR OR WALL MANUFACTURER SHALL SUBMIT GLOBAL STABILITY CALCULATIONS ALONG WITH THE SHOP DRAWINGS FOR REVIEW.
- UTILITIES WILL BE LOCATED WITHIN THE GEOSYNTHETIC REINFORCEMENT - SEE UTILITY DRAWINGS FOR DETAILS. UTILITIES WILL CROSS UNDERNEATH, BUT NOT THROUGH, THE WALL.
- RETAINING WALLS SHALL ONLY BE CONSTRUCTED UNDER OBSERVATION OF A REGISTERED PROFESSIONAL ENGINEER IN THE STATE OF MARYLAND AND A (NICET, WACEL OR EQUIVALENT) CERTIFIED SOILS TECHNICIAN.
- THE REQUIRED BEARING RESISTANCE OF THE WALL SUBGRADE SHALL BE VERIFIED IN THE FIELD BY A CERTIFIED SOILS TECHNICIAN. TESTING DOCUMENTATION SHALL BE PROVIDED TO THE HOWARD COUNTY INSPECTOR PRIOR TO THE START OF CONSTRUCTION. THE REQUIRED TEST PROCEDURE SHALL BE THE DYNAMIC CONE PENETROMETER TEST ASTM STP-399. THE WALL SUBGRADE SHALL BE PROOFROLLED WITH A 35-TON PNEUMATIC-TIRED ROLLER OR DUMP TRUCK IN ACCORDANCE WITH THE PROJECT SPECIFICATIONS.
- THE SUITABILITY OF FILL MATERIAL SHALL BE CONFIRMED BY THE ONSITE SOILS TECHNICIAN. THE FILL LIFTS SHALL BE PLACED, COMPACTED AND REPORTED AS PER THE PROJECT SPECIFICATIONS.
- WALL SHALL BE DESIGNED USING A MINIMUM LIVE LOAD OF 250-PSF AT THE TOP OF THE WALL.
- SLABS LOCATED WITHIN A DISTANCE OF ONE WALL HEIGHT MEASURED FROM THE BACK OF THE REINFORCED SOIL ZONE AWAY FROM THE WALL FACE SHALL NOT BE CONSTRUCTED FOR AT LEAST 30-DAYS AFTER THE COMPLETION OF THE WALLS.
- WHERE SLABS ARE PARTIALLY SUPPORTED DIRECTLY OVER THE REINFORCEMENT ZONE AND PARTIALLY OVER THE RETAINED ZONE, THE PORTION OF THE SLAB SUPPORTED OVER THE RETAINED ZONE SHALL BE DIRECTLY SUPPORTED BY A 3-FT THICK LAYER OF CR-6, AND CONSTRUCTION JOINTS SHALL BE USED TO CONTROL CRACKING.
- SLOPE GEOSYNTHETIC REINFORCEMENT DOWN PER MANUFACTURER SPECIFICATIONS, IF NECESSARY, TO AVOID OBSTRUCTIONS. NO KINKS IN THE REINFORCEMENT WILL BE PERMITTED.
- PRIOR TO PLACING TOP ROW(S) OF REINFORCING THE CONTRACTOR MUST LOCATE ALL PROPOSED GUARD RAIL POSTS AND COLUMN TUBE OR PVC PIPE TO BE INSTALLED DURING WALL CONSTRUCTION (POST-WALL CONSTRUCTION POST FOUNDATION WILL REQUIRE HAND EXCAVATION AS TO NOT DAMAGE REINFORCEMENT).
- CLEARING AND GRUBBING SHALL INCLUDE THE REMOVAL OF TREE ROOTS TO A DEPTH OF AT LEAST 3-FT.
- THE DIMENSIONS OF THE UNDERCUTTING SHALL EXTEND A MINIMUM OF 9-INCHES LATERALLY BEYOND THE FOOTING OR REINFORCED PERIMETER FOR EACH 12-INCHES OF NEW COMPACTED FILL BELOW THE FOOTING OR PERIMETER. THE END OF THE UNDERCUT SHALL TRANSITION WITH A 4(H):1(V) SLOPE. THE UNDERCUT MATERIAL SHALL BE REPLACED WITH COMPACTED CR-6 OR OTHER MATERIAL APPROVED BY THE ENGINEER. THE ACTUAL LIMIT OF UNDERCUTTING SHALL BE DETERMINED IN THE FIELD AT THE TIME OF CONSTRUCTION BY AN ENGINEERING TECHNICIAN ACTING UNDER THE GUIDANCE OF A GEOTECHNICAL ENGINEER LICENSED IN THE STATE OF MARYLAND.
- FOR WALL STATIONS 3+00 TO 5+00
 - AFTER CLEARING AND GRUBBING AND UNDERCUTTING, IF SOFT SOILS ARE ENCOUNTERED, THE SOFT SOILS SHALL BE UNDERCUT AND REPLACED WITH A GEOSYNTHETIC-REINFORCED WORKING PLATFORM CONSISTING OF #2 OR SIMILAR SIZED STONE WRAPPED IN SEPARATION FABRIC. THE WORKING PLATFORM SHALL EXTEND AT LEAST 5-FT BEYOND THE REINFORCED ZONE ON ALL SIDES. THE UPPER PORTION OF THE WORKING PLATFORM MAY BE CHOKED WITH CR-6 OR OTHER MATERIAL APPROVED BY THE ENGINEER. THE WORKING PLATFORM SHALL BE DESIGNED BY A PROFESSIONAL ENGINEER REGISTERED IN THE STATE OF MARYLAND AND SUBMITTED TO THE ENGINEER FOR REVIEW PRIOR TO CONSTRUCTION.
 - REMAINING FILL UP TO THE LEVELING PAD AND REINFORCED ZONE SHALL CONSIST OF COMPACTED CR-6 OR OTHER MATERIAL APPROVED BY THE ENGINEER.
 - THE WALL SHALL BE BUILT UP PARTIALLY THEN QUARANTINED AND MONITORED FOR MOVEMENTS FOR A PERIOD OF 4-WEEKS BEFORE CONTINUING PLACING FILL. QUARANTINE PERIODS SHALL BE OBSERVED AT TOTAL FILL HEIGHTS OF 20-FT AND 35-FT. MONITORING SHALL BE AS REQUIRED IN THE SPECIFICATIONS OR AS DIRECTED BY THE ENGINEER.
 - CONTRACTOR SHALL DOCUMENT A DAILY INSPECTION OF THE FACING AND NOTE ANY OBSERVED MOVEMENT. DOCUMENTATION OF INSPECTION SHALL BE PROVIDED TO THE ENGINEER WEEKLY, OR SAME DAY IF MOVEMENT IS NOTED.
 - WORK MAY CONTINUE ON OTHER PARTS OF THE WALL DURING THE QUARANTINE PERIOD(S).
- RETAINING WALL MANUFACTURER / INSTALLER TO COORDINATE DEPTH AND LOCATION OF THE SWM POROUS PAVEMENT WITH THE LOCATION OF THE GEO-SYNTHETIC REINFORCEMENT. SEE SHEETS C-207 TO C-214 FOR EXACT DEPTH OF SWM FACILITIES.

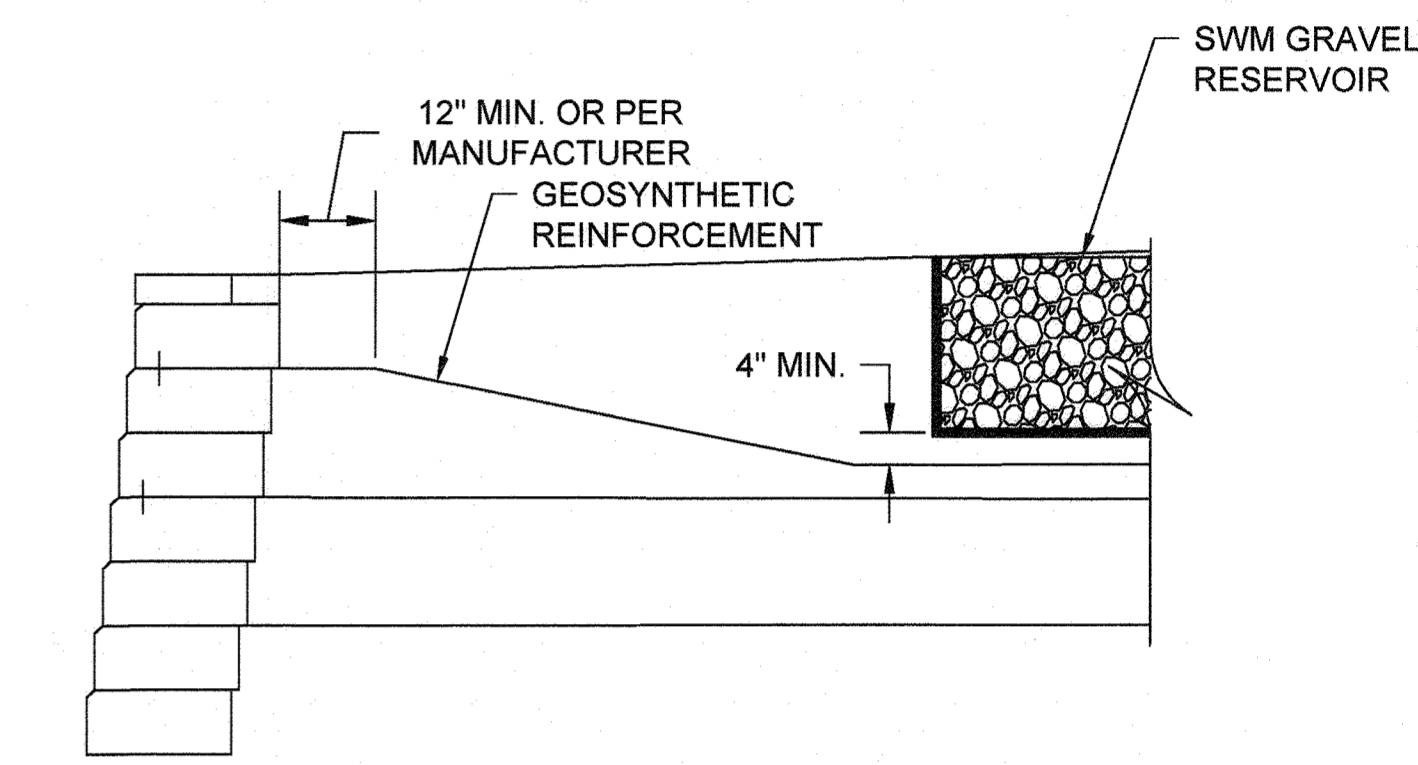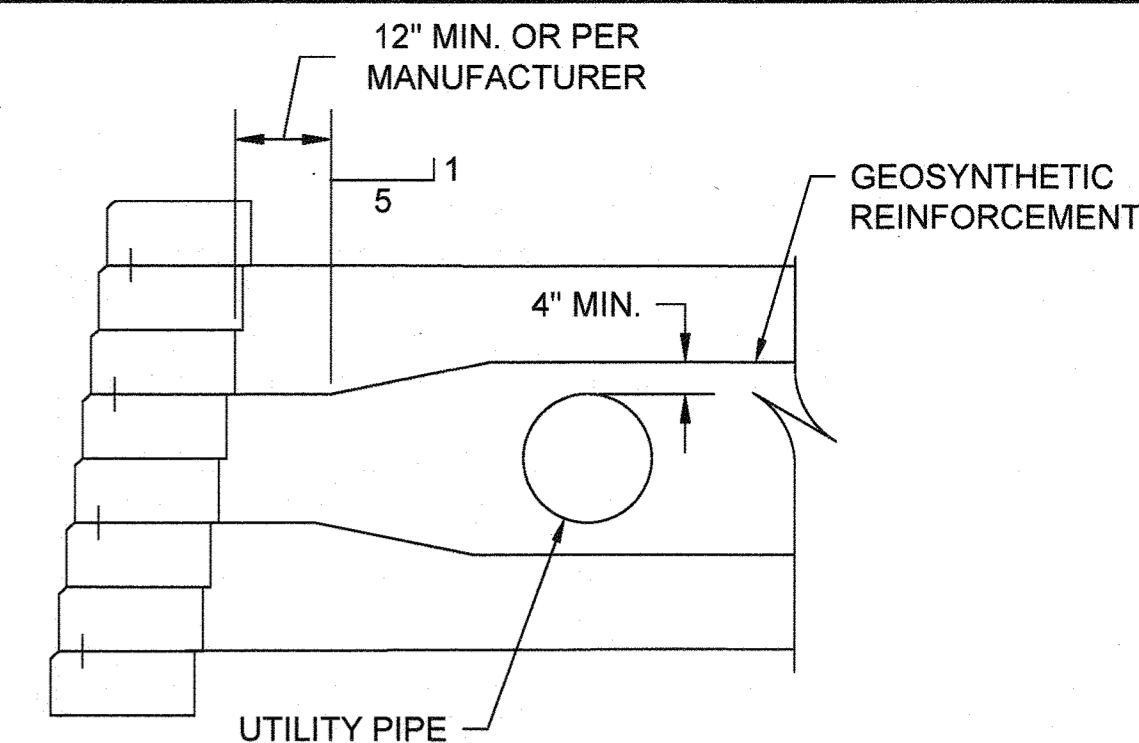

GEOSYNTHETIC REINFORCEMENT SPLAY DETAIL

SCALE: 1/2" = 1'-0"

| RETAINING WALL SUBGRADE UNDERCUTTING | | | |
|--------------------------------------|--------------------|-----------------------------------|---|
| OTA | WALL STATION RANGE | ESTIMATED UNDERCUTTING DEPTH (FT) | REASON FOR UNDERCUTTING |
| 3 | 3+00 TO 5+50 | 2 | WET, LOOSE SOIL ENCOUNTERED IN BORING RW3-5 |

SEE NOTE 15 FOR ADDITIONAL UNDERCUTTING NOTES.

GENERAL NOTES:

- SPECIFICATIONS: SEE PROVIDED SPECIFICATIONS.
- NATIONAL CONCRETE MASONRY ASSOCIATION DESIGN MANUAL FOR SEGMENTAL RETAINING WALLS, 3RD EDITION 5TH PRINTING
- CONCRETE: ALL CONCRETE SHALL BE MIX No.3 (3500 PSI).
- WALL SYSTEM: CONTRACTOR HAS THE OPTION TO SELECT A PROPRIETARY WALL. ONCE SELECTED, THIS TYPE OF WALL MUST BE USED THROUGHOUT THE PROJECT. THE CONTRACTOR CAN ADJUST THE STEPS IN THE LEVELING PAD TO ACCOMMODATE THE WALL TYPE SELECTED.
- SERVICE LIFE: ALL RETAINING WALL COMPONENTS SHALL BE DESIGNED FOR A MINIMUM SERVICE LIFE OF 75 YEARS.
- BACK FILL: ALL BACKFILL MATERIAL WITHIN THE REINFORCING ZONE FOR THE SEGMENTAL WALL SHALL BE AS PER THE PROVIDED SPECIFICATIONS.
- TEMPORARY SUPPORT OF EXCAVATION: THE CONTRACTOR SHALL DETERMINE THE NEED FOR ANY TEMPORARY SUPPORT OF EXCAVATION FOR EXCAVATION OF THE RETAINING WALLS, THE LOCATION AND LIMITS OF THE SUPPORT OF EXCAVATION AND THE TYPE USED IS THE SOLE RESPONSIBILITY OF THE CONTRACTOR. THE CONTRACTOR SHALL ENSURE THAT THE TEMPORARY SUPPORT OF EXCAVATION EXTENDS TO THE TOP OF THE PROPOSED GRADE. ALL SIGNED AND SEALED (BY A MARYLAND PE) CALCULATIONS SHALL BE SUBMITTED WITH SHOP DRAWINGS. IF REQUIRED, TEMPORARY SUPPORT OF EXCAVATION SHALL BE INCIDENTAL TO THE LUMP SUM RETAINING WALL ITEM.
- UTILITY SEQUENCING: UTILITIES WITHIN A DISTANCE OF ONE WALL HEIGHT MEASURED FROM THE BACK OF THE REINFORCED ZONE AWAY FROM THE WALL FACE AND 5' IN FRONT OF THE WALL FACE SHALL BE CONSTRUCTED IN CONJUNCTION WITH THE RETAINING WALL AND CAPPED OUTSIDE OF THIS ZONE FOR AT LEAST 30 DAYS PRIOR TO CONNECTION TO ANY MANHOLE OR STRUCTURE.

APPROVED: DEPARTMENT OF PLANNING AND ZONING

Chief, Development Engineering Division

Chief, Division of Land Development

Director

Date: 12-5-23

Date: 12/21

Date: 12/22/24

RK&K

RUMMEL, KLEPPER & KAHL, LLP


700 East Pratt Street, Suite 500

Baltimore, MD 21202

PH: 410.726.2900

WWW.RK&K.COM

PROFESSIONAL CERTIFICATION, I HEREBY CERTIFY THAT THESE DOCUMENTS WERE PREPARED OR APPROVED BY ME AND THAT I AM A DULY LICENSED PROFESSIONAL ENGINEER UNDER THE LAWS OF THE STATE OF MARYLAND, LICENSE NO. 48432, EXPIRATION DATE: MAY 31, 2024.

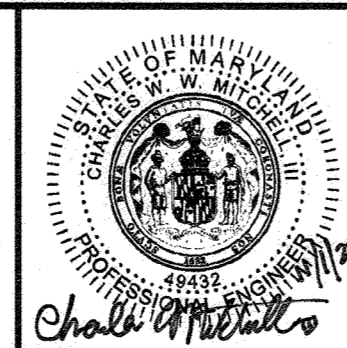

| | | | |
|-------------|-----------|-----------|-----------|
| DESIGN BY: | SHK | DATE: | 11/1/2023 |
| DRAWN BY: | JMS/DTP | BY: | NO. |
| CHECKED BY: | CWWM | REVISION: | DATE: |
| DATE: | 11/1/2023 | REVISION: | DATE: |

OWNER/DEVELOPER

JOHNS HOPKINS

APPLIED PHYSICS LABORATORY

11100 JOHNS HOPKINS ROAD

LAUREL, MARYLAND 20723

SEGMENTAL BLOCK RETAINING WALL

SECTION - OTA 3 (PHASE 2)

JOHNS HOPKINS UNIVERSITY - APPLIED PHYSICS LABORATORY

OUTDOOR TESTING AREAS

11100 JOHNS HOPKINS ROAD

TAX MAP: 411 PARCEL: 123 GRID: 16 ZONED: PEC

ELECTION DISTRICT 5 - HOWARD COUNTY, MARYLAND

SHEET 41 OF 73

SCALE: As Shown

C-331

RK&K PROJECT NUMBER 21047.013

SCALE: As Shown



NOTES

1. THE TOPOGRAPHIC INFORMATION SHOWN HEREON, WAS OBTAINED FROM AN AERIAL SURVEY FLOWN BY AXIS GEOSPATIAL ON APRIL 6, 2014 AND PROVIDED TO RK&K IN AUGUST OF 2017. THE UTILITY INFORMATION WAS PROVIDED ELECTRONICALLY TO RK&K BY JHU APL IN AUGUST OF 2017. TOPOGRAPHIC AND UTILITY INFORMATION MAY NOT REFLECT CURRENT CONDITIONS. IT IS THE CONTRACTOR'S RESPONSIBILITY TO FIELD VERIFY ACTUAL SITE CONDITIONS PRIOR TO THE START OF ANY WORK. THERE IS NO WARRANTY OR GUARANTEE ON THE COMPLETENESS OR CORRECTNESS OF THE EXISTING CONDITION INFORMATION. ANY DISCREPANCY FOUND SHALL BE BROUGHT TO THE IMMEDIATE ATTENTION OF THE ENGINEER PRIOR TO THE START OF ANY WORK.
2. BEARINGS, COORDINATES AND ELEVATIONS SHOWN ON THIS PLAN ARE SHOWN IN MARYLAND STATE PLANE. ALL VERTICAL CONTROLS ARE BASED ON NAVD 88.
3. FOR GENERAL NOTES, SEE THE COVER SHEET.

SWM NOTES-OTA 3

1. THIS PROJECT IS CONSIDERED "NEW DEVELOPMENT" FOR STORMWATER MANAGEMENT PURPOSES.
2. ON-SITE SWM FACILITIES ARE PROVIDED TO MEET 100% OF SWM REQUIREMENTS. THESE ARE COMPRISED OF POROUS PAVEMENT, NON-ROOF DISCONNECT, REINFORCED TURF (GRAVELPAVE), AND ONE MICRO-BIORETENTION FACILITY.
3. **POROUS PAVEMENT:** PERVIOUS PAVEMENT AREAS ARE LOCATED AS THE PROPOSED ROADWAY AND THE CONCRETE PAD. PERVIOUS PAVEMENT ARE DESIGNED TO INCLUDE TEN (10) FOOT SETBACK FROM PROPOSED BUILDINGS AND CAPTURE 48,988 OF IMPERVIOUS AREA.
4. **MICRO-BIORETENTION:** ONE MICRO-BIORETENTION FACILITY IS ADJACENT TO THE PROPOSED ROADWAY AND WILL PROVIDE TREATMENT FOR THE PORTION OF THE PROPOSED ROADWAY THAT IS IMPERVIOUS ASPHALT OF 12,467 SF. THE RUNOFF FROM THE ROADWAY WILL BE CONVEYED TO THE MICRO-BIORETENTIONS VIA CONCRETE FLUME. SEE C505 FOR DETAILS.
5. **REINFORCED TURF (GRAVELPAVE):** A DRIVEWAY CONSISTING OF 4,340 SF OF REINFORCED TURF (GRAVELPAVE) RUNS PERPENDICULAR (EAST TO WEST) TO THE PROPOSED ROADWAY. THE RUNOFF FROM THE GRAVELPAVE WILL DRAIN TO THE NORTHEAST CORNER OF THE SITE.
6. **NON-ROOFTOP DISCONNECT:** THE 4,000 SF IMPERVIOUS CONCRETE AREA IS DIRECTED ONTO AN ADJACENT VEGETATED AREA OF EQUAL SQUARE FEET WHERE THE RUNOFF FLOWS OVER THE DISCONNECTION AREA, FILTERS THROUGH THE VEGETATION, AND SOAKS INTO THE GROUND.
7. FOR SWM COMPUTATIONS AND ADDITIONAL INFORMATION SEE THE SWM REPORT.
8. ALL SWM FACILITIES WILL BE MAINTAINED BY JOHNS HOPKINS APPLIED PHYSICS LABORATORY.

STORMWATER NOTES

KEY SW-1

1. PROPOSED MICRO-BIORETENTION FACILITY
2. PROPOSED NON-ROOFTOP DISCONNECT AT MAX. 2%.
3. PROPOSED POROUS PAVEMENT.
4. 6" UNDERDRAIN.
5. PROPOSED BUILDING GUTTER AND DOWNSPOUT.
6. 6" PERFORATED PIPE THROUGH STONE RESEVOIR.
7. PROPOSED REINFORCED TURF/GRAVELPAVE

REFER TO SHEET C-505 FOR STORMWATER MANAGEMENT DETAILS

SWM LEGEND


- PERVIOUS PAVEMENT
- TREATED IMPERVIOUS COVER PAVEMENT
- MICRO-BIORETENTION FACILITY, TYP.
- NON-ROOFTOP DISCONNECT
- DRAINAGE AREA BOUNDARY
- REINFORCED TURF/GRAVELPAVE (PERVIOUS)
- RETAINING WALL
- PERVIOUS CONCRETE PAVEMENT

SWM ESDv COMPLIANCE SUMMARY-OTA 3

| FACILITY | ESDv REQUIRED (CF) | ESDv PROVIDED (CF) | IMPERVIOUS AREA REQUIRING TREATMENT (ART) (SF) | IMPERVIOUS AREA TREATED (IAT) (SF) | TARGET Pe (IN) | Pe ACHIEVED (IN) |
|------------------------|--------------------|--------------------|--|------------------------------------|----------------|------------------|
| POROUS PAVEMENT | 4,198 | 10,454 | 52,717 | 48,988 | 2.5 | 2.5 |
| REINFORCED TURF | 143 | | | 4,340 | | |
| NON-ROOFTOP DISCONNECT | 784 | 784 | 4,000 | 4000 | 1.0 | 1.0 |
| MICRO-BIORETENTION | 2566 | 2076* | 12,467 | 12,467 | 2.6 | 2.6 |
| TOTAL | 7,691 | 13,314 | 69,184 | 69,795 | 1.2 | 2.3 |

*TOTAL STORAGE VOLUME IN MICRO-BIORETENTION FACILITY IS 2,805 CF WHEN INCLUDING THE 729 CF OF THE STONE RESERVOIR LAYER.

4 PURPOSE STATEMENT (11/1/23): DESIGN OF OUTDOOR TESTING AREA 3, INCLUDING THE SOURCE OF BORROW MATERIAL REFERRED TO AS THE EAST AND WEST BORROW AREAS.

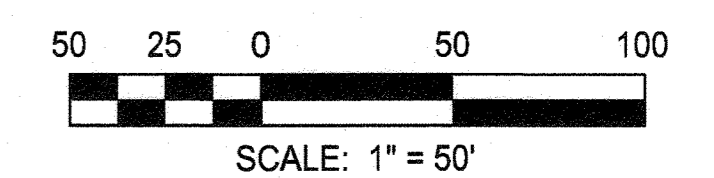

APPROVED: DEPARTMENT OF PLANNING AND ZONING
 Chief, Development Engineering Division
 Date: 12.5.23
 Chief, Division of Land Development
 Date: 2/22/24

RK&K
 RUMMEL, KLEPPER & KAHN, LLP
 ENGINEERS, ARCHITECTS, PLANNERS, SCIENTISTS
 RESPONSIVE PEOPLE • CREATIVE SOLUTIONS
 700 East Pratt Street, Suite 500
 Baltimore, MD 21202
 Ph: 410.728.2900 | Central Mail TH0989891
 www.rkk.com

DESIGN BY: SHK
 DRAWN BY: JMS/DTP
 CHECKED BY: CWWW
 DATE: 11/1/2023

| BY | NO. | REVISION | DATE |
|----|-----|----------|------|
| | | | |

OWNER/DEVELOPER
JOHNS HOPKINS APPLIED PHYSICS LABORATORY
 11100 JOHNS HOPKINS ROAD
 LAUREL, MARYLAND 20723

STORMWATER MANAGEMENT PLAN - OTA 3 (PHASE 2)
 JOHNS HOPKINS UNIVERSITY - APPLIED PHYSICS LABORATORY
OUTDOOR TESTING AREAS
 11100 JOHNS HOPKINS ROAD
 TAX MAP: 41 PARCEL: 123 GRID: 16 ZONED: PEC
 ELECTION DISTRICT: 5 - HOWARD COUNTY, MARYLAND
 SHEET 43 OF 73

C-503
 RK&K PROJECT NUMBER 21047.013
 SCALE: As Shown

BIORETENTION: OPERATION AND MAINTENANCE

- ANNUAL MAINTENANCE OF PLANT MATERIAL, MULCH LAYER AND SOIL LAYER IS REQUIRED. MAINTENANCE OF MULCH AND SOIL IS LIMITED TO CORRECTING AREAS OF EROSION OR WASH OUT. ANY MULCH REPLACEMENT SHALL BE DONE IN THE SPRING. PLANT MATERIAL SHALL BE CHECKED FOR DISEASE AND INSECT INFESTATION AND MAINTENANCE WILL ADDRESS DEAD MATERIAL AND PRUNING. ACCEPTABLE REPLACEMENT PLANT MATERIAL IS LIMITED TO THE FOLLOWING: 2000 MARYLAND STORMWATER DESIGN MANUAL VOLUME II, TABLE A.4.1 AND 2.
- SCHEDULE OF PLANT INSPECTION WILL BE TWICE A YEAR IN SPRING AND FALL. THIS INSPECTION WILL INCLUDE REMOVAL OF DEAD AND DISEASED VEGETATION CONSIDERED BEYOND TREATMENT, TREATMENT OF ALL DISEASED TREES AND SHRUBS AND REPLACEMENT OF ALL DEFICIENT STAKES AND WIRES.
- MULCH SHALL BE INSPECTED EACH SPRING. REMOVE PREVIOUS MULCH LAYER BEFORE APPLYING NEW LAYER ONCE EVERY 2 TO 3 YEARS.
- SOIL EROSION TO BE ADDRESSED ON AN AS NEEDED BASIS, WITH A MINIMUM OF ONCE PER MONTH AND AFTER HEAVY STORM EVENTS.

IN-SITU INFILTRATION TEST

At completion of construction, for each microbio-retention facility, the contractor shall perform an in-situ infiltration test on the installed microbio-retention soils using MDE spec detailed in "Appendix D.1 Testing Requirements for Infiltration, Bio-retention and Sand Filter Subsoils" in the "Maryland Stormwater Design Manual", and supplements, for infiltration test. The microbio-retention facility will not be accepted by JHU/APL until the contractor has documented via the infiltration tests that the completed facility achieves a minimum infiltration rate of 0.5 in/hr, including during the 2-year warranty period. The test shall be performed 8 inches below the surface of the micro-bio-retention facility.

CONSTRUCTION OF MICROBIORETENTION AREAS

Construct stormwater filtration facilities only after all contributing drainage areas are permanently stabilized and vegetation including turfgrass and turfgrass sod are established according to contract documents. Do not stockpile materials nor store equipment in these areas. Any areas compacted during construction require tilling 24" below proposed bottom of facility. See paragraph 3.

Use methods of excavation that minimize the compaction of the underlying soil. Use excavators and backhoes operating on the adjacent ground. If the bottom width of the excavated area is greater than 15 ft, wide-track or marsh-track equipment, or light equipment with turf-type tires may be used to excavate, grade, and place fill materials. Do not use equipment with narrow tracks or narrow tires, rubber tires with large lugs, or high-pressure tires.

Till the excavation pit bottom to a minimum depth of 24" to alleviate compaction from excavation activities by using a primary tilling operation such as a chisel plow, ripper, or subsoiler. Substitute methods must be approved by the engineer. Remove any standing water from the excavation pit prior to tilling. Only till soil that is friable. Do not till soil while in a muddy or frozen condition.

When backfilling the facility, place soil in lifts 12" to 18". Do not use heavy equipment within the basin. Heavy equipment can be used around the perimeter of the basin to supply soils and sand. Grade facility materials with light equipment such as a compact loader or a dozer/loader with marsh tracks.

| AS-BUILT DATA FOR MICRO-BIORETENTION-1 | | |
|--|------------------------------------|-----------------------------------|
| *TO BE COMPLETED BY THE CONTRACTOR'S CERTIFYING ENGINEER | | |
| FACILITY NAME: MICRO-BIORETENTION FACILITY 1 - MB-1 | | |
| FEATURE | DESIGN | *AS-BUILT |
| OVERFLOW INLET ELEVATION | -931 FT-- | 339 FT. |
| SURFACE AREA | 1,200 SF-- | 1,822 SF. |
| FILTER BED DIMENSIONS (L X W X D) | 48' x 34' x 2' | 65' x 35' x 2' |
| FILTER BED SURFACE ELEVATION | -930 FT-- | 338 FT. |
| OUTLET PIPE SIZE / INVERT | 12 IN. / 322.87 FT. | 334.42 FT. |
| ELEVATION OF BERM | -932 FT-- | 341 FT. |
| UNDERDRAIN PIPE SIZE / INVERT | 6 IN. / 325.67 FT. | 334.67 FT. |
| THICKNESS OF FILTER MEDIA | 2 FT. | |
| WEIR WALL ELEVATION ABOVE BED | N/A | |
| PLANTINGS | SEE LANDSCAPING DWGS | |
| GEOTEXTILE | PE TYPE 1 NON-WOVEN, SIDES ONLY | |
| COMPOSITION OF FILTER MEDIA | SEE TABLE, C-504 | |
| OBSERVATION WELL WITH DEPTH TO FILTER BOTTOM INDICATED ON CAP | 4.83 FT. | |
| OVERFLOW INLET STRUCTURE LOCATION: MD STATE PLANE COORDINATES NAD 83 | N: 54,8492.9144 E: 134,2381.6687 | N: 548,624.4341 E: 1,342,324.2380 |

| AS-BUILT DATA FOR MICRO-BIORETENTION-2 | | |
|--|------------------------------------|-----------|
| *TO BE COMPLETED BY THE CONTRACTOR'S CERTIFYING ENGINEER | | |
| FACILITY NAME: MICRO-BIORETENTION FACILITY 2 - MB-2 | | |
| FEATURE | DESIGN | *AS-BUILT |
| OVERFLOW INLET ELEVATION | 332 FT. | |
| SURFACE AREA | 1,065 SF. | |
| FILTER BED DIMENSIONS (L X W X D) | 45' x 29' x 2' | |
| FILTER BED SURFACE ELEVATION | 331 FT. | |
| OUTLET PIPE SIZE / INVERT | 12 IN. / 325 FT. | |
| ELEVATION OF BERM | 333.25 FT. | |
| UNDERDRAIN PIPE SIZE / INVERT | 6 IN. / 326.67 FT. | |
| THICKNESS OF FILTER MEDIA | 2 FT. | |
| WEIR WALL ELEVATION ABOVE BED | N/A | |
| PLANTINGS | SEE LANDSCAPING DWGS | |
| GEOTEXTILE | PE TYPE 1 NON-WOVEN, SIDES ONLY | |
| COMPOSITION OF FILTER MEDIA | SEE TABLE, C-504 | |
| OBSERVATION WELL WITH DEPTH TO FILTER BOTTOM INDICATED ON CAP | 4.83 FT. | |
| OVERFLOW INLET STRUCTURE LOCATION: MD STATE PLANE COORDINATES NAD 83 | N: 54,8572.0475 E: 134,2310.5750 | |

MAINTENANCE CRITERIA FOR POROUS PAVEMENT:

- PAVEMENT SURFACES SHOULD BE SWEEPED AND VACUUMED TO REDUCE SEDIMENT ACCUMULATION AND ENSURE CONTINUED SURFACE POROSITY. SWEEPING SHOULD BE PERFORMED AT LEAST TWICE ANNUALLY WITH A COMMERCIAL CLEANING UNIT. WASHING OR COMPRESSED AIR UNITS SHOULD NOT BE USED TO PERFORM SURFACE CLEANING.
- DRAINAGE PIPES, INLETS, STONE EDGE DRAINS AND OTHER STRUCTURES WITHIN OR DRAINING TO THE SUBBASE SHOULD BE CLEANED OUT AT REGULAR INTERVALS.
- DEICERS SHOULD BE USED IN MODERATION. DEICERS SHOULD BE NON-TOXIC AND BE APPLIED EITHER AS CALCIUM MAGNESIUM ACETATE OR AS PRETREATED SALT. SNOW PLOWING SHOULD BE DONE CAREFULLY WITH BLADES SET ONE-INCH ABOVE THE SURFACE. PLOWED SNOW PILES AND SNOWMELT SHOULD NOT BE DIRECTED TO PERMEABLE PAVEMENT.

| AS-BUILT DATA FOR PERVIOUS PAVEMENT - OTA-1 | | |
|--|--------------------------------|-----------|
| *TO BE COMPLETED BY THE CONTRACTOR'S CERTIFYING ENGINEER | | |
| FACILITY NAME: PP OTA-1 | | |
| FEATURE | DESIGN | *AS-BUILT |
| SURFACE AREA | 29,030 SQ. FT. | |
| POROUS PAVEMENT DEPTH/ ELEV. | 2 IN. / SEE GRADING PLAN | |
| BASE LAYER DEPTH | 2.5 IN. | |
| CHOKER LAYER DEPTH | 4 IN. | |
| RESERVOIR LAYER DEPTH | 13 IN. | |
| UNDERDRAIN PIPE SIZE / INVERT | 6 IN. / 354.10 FT. | |
| OBSERVATION WELL STRUCTURE LOCATION: MD STATE PLANE COORDINATES NAD 83 | SEE SCHEDULE TABLE SHEET C-216 | |

| AS-BUILT DATA FOR PERVIOUS PAVEMENT - OTA-2 | | |
|--|--------------------------------|-----------|
| *TO BE COMPLETED BY THE CONTRACTOR'S CERTIFYING ENGINEER | | |
| FACILITY NAME: PP OTA-2 | | |
| FEATURE | DESIGN | *AS-BUILT |
| SURFACE AREA | 13,725 SQ. FT. | |
| PERVIOUS PAVEMENT DEPTH/ ELEV. | 2 IN. / SEE GRADING PLAN | |
| BASE LAYER DEPTH | 2.5 IN. | |
| CHOKER LAYER DEPTH | 4 IN. | |
| RESERVOIR LAYER DEPTH | 13 IN. | |
| UNDERDRAIN PIPE SIZE / INVERT | 6 IN. / 311.66 FT. | |
| CLEANOUT STRUCTURE LOCATION: MD STATE PLANE COORDINATES NAD 83 | SEE SCHEDULE TABLE SHEET C-216 | |

| AS-BUILT DATA FOR PERVIOUS PAVEMENT - OTA-3 | | |
|--|--------------------------------|----------------|
| *TO BE COMPLETED BY THE CONTRACTOR'S CERTIFYING ENGINEER | | |
| FACILITY NAME: PP OTA-3 | | |
| FEATURE | DESIGN | *AS-BUILT |
| SURFACE AREA | 44,700 SQ. FT-- | 52,603 SQ. FT. |
| PERVIOUS PAVEMENT DEPTH/ ELEV. | 2 IN. / SEE GRADING PLAN | |
| BASE LAYER DEPTH | 2.5 IN. | |
| CHOKER LAYER DEPTH | 4 IN. | |
| RESERVOIR LAYER DEPTH | 13 IN. | |
| UNDERDRAIN PIPE SIZE / INVERT | 6 IN. / 323.66 FT-- | 329.23 FT. |
| CLEANOUT STRUCTURE LOCATION: MD STATE PLANE COORDINATES NAD 83 | SEE SCHEDULE TABLE SHEET C-216 | |

CONTRACTOR AS-BUILT NOTE

AS-BUILT PLANS AND CERTIFICATION ARE REQUIRED FOR ALL STORMWATER MANAGEMENT FACILITY ON THESE PLANS. THESE MUST BE PREPARED AND SEALED BY A REGISTERED PROFESSIONAL ENGINEER OR SURVEYOR, OBTAINED BY THE CONTRACTOR, HOWARD COUNTY OR THE OWNER'S ENGINEER WILL NOT PREPARE THE AS-BUILT PLANS OR CERTIFICATION. THE STORMWATER MANAGEMENT PERMIT BOND WILL NOT BE RELEASED UNTIL THE AS-BUILT PLANS AND CERTIFICATION ARE APPROVED BY HOWARD COUNTY.

IN ORDER TO PREPARE THE REQUIRED AS-BUILT PLANS AND CERTIFICATION, THIS STORMWATER MANAGEMENT FACILITY MUST BE INSPECTED BY THE CONTRACTOR'S ENGINEER AT SPECIFIC STAGES DURING CONSTRUCTION AND AS REQUIRED BY THE CURRENT HOWARD COUNTY STORMWATER MANAGEMENT POLICIES AND PROCEDURES. THE CONTRACTOR SHALL NOTIFY THE CONTRACTOR'S ENGINEER AT LEAST FIVE (5) WORKING DAYS PRIOR TO STARTING ANY WORK SHOWN ON THESE PLANS.

INSPECTION NOTES:

REGULAR INSPECTIONS SHALL BE MADE DURING THE FOLLOWING STAGES OF CONSTRUCTION:

- DURING EXCAVATION TO SUBGRADE
- PLACEMENT AND BACKFILL OF UNDERDRAIN SYSTEMS.
- DURING PLACEMENT OF FILTER MEDIA.
- DURING CONSTRUCTION OF APPURTENANT CONVEYANCE.
- UPON COMPLETION OF FINAL GRADING AND ESTABLISHMENT OF PERMANENT STABILIZATION.

MAINTENANCE CRITERIA FOR DISCONNECT:

- MAINTENANCE OF AREAS RECEIVING DISCONNECTED RUNOFF IS GENERALLY NO DIFFERENT THAN THAT REQUIRED FOR OTHER LAWN OR LANDSCAPED AREAS. THE AREAS RECEIVING RUNOFF SHOULD BE PROTECTED FROM FUTURE COMPACTION OR DEVELOPMENT OF IMPERVIOUS AREA. IN COMMERCIAL AREAS, FOOT TRAFFIC SHOULD BE DISCOURAGED AS WELL.

SEQUENCE OF CONSTRUCTION FOR STORMWATER MANAGEMENT

- CONSTRUCTION OF STORMWATER MANAGEMENT FACILITIES SHALL BE COORDINATED WITH EROSION AND SEDIMENT CONTROL SEQUENCE OF CONSTRUCTION.
- THE CONTRACTOR SHALL NOTIFY AS-BUILT CERTIFYING ENGINEER PRIOR TO BEGINNING CONSTRUCTION OF STORMWATER MANAGEMENT FACILITIES. CERTIFYING ENGINEER SHALL SUBMIT STORMWATER MANAGEMENT AS-BUILT PLANS WITHIN 30 DAYS OF COMPLETION. AS-BUILT CERTIFYING ENGINEER SHALL BE PROVIDED BY THE CONTRACTOR.
- PERFORM PRE-CONSTRUCTION INFILTRATION TESTING. THE CONTRACTOR CONFIRM INFILTRATION RATES AT A DEPTH OF 3" BELOW THE PROPOSED BOTTOM ELEVATION OF THE FILTER MEDIA. EXCEPT AS APPENDED BY THIS NOTE, CONTRACTOR SHALL PERFORM THE TESTING USING MDE SPEC DETAILED IN "APPENDIX D.1 TESTING REQUIREMENTS FOR INFILTRATION, BIURETENTION AND SAND FILTER SUBSOILS" IN THE "MARYLAND STORMWATER DESIGN MANUAL". CONTRACTOR SHALL SEND THE RESULTS TO THE ENGINEER FOR APPROVAL 1 WEEK PRIOR TO COMMENCING CONSTRUCTION ON THE SWM FACILITIES. THE MICROBIURETENTION FACILITY WILL NOT BE AUTHORIZED FOR CONSTRUCTION UNTIL THE CONTRACTOR HAS DOCUMENTED VIA THE INFILTRATION TESTS THAT THE COMPLETED FACILITY ACHIEVES A MINIMUM INFILTRATION RATE OF 0.5 IN/HR.
- WITH ENGINEER'S APPROVAL CONSTRUCT THE MICRO-BIORETENTION FACILITIES.
- THE CONTRACTOR SHALL FOLLOW THE INSPECTION SCHEDULE, THIS SHEET.
- PERFORM POST CONSTRUCTION INFILTRATION TEST. AT COMPLETION OF CONSTRUCTION, FOR EACH MICROBIURETENTION FACILITY, THE CONTRACTOR SHALL PERFORM AN IN-SITU INFILTRATION TEST ON THE INSTALLED MICROBIURETENTION SOILS USING MDE SPEC DETAILED IN "APPENDIX D.1 TESTING REQUIREMENTS FOR INFILTRATION, BIURETENTION AND SAND FLTER SUBSOILS" IN THE "MARYLAND STORMWATER DESIGN MANUAL", AND SUPPLEMENTS, FOR INFILTRATION TEST. THE MICROBIURETENTION FACILITY WILL NOT BE ACCEPTED UNTIL THE CONTRACTOR HAS DOCUMENTED VIA THE INFILTRATION TESTS THAT THE COMPLETED FACILITY ACHIEVES A MINIMUM INFILTRATION RATE OF 0.5 IN/HR, INCLUDING DURING THE 2-YEAR WARRANTY PERIOD.
- PREPARE AND SUBMIT STORMWATER MANAGEMENT AS-BUILTS CERTIFIED BY CONTRACTOR'S MD LICENSED PROFESSIONAL ENGINEER.

TABLE B.4.1 MATERIALS SPECIFICATIONS

| | SPECIFICATIONS | NOTES |
|---|--|--|
| PLANTINGS | SEE SWMLANDSCAPE PLANS | N/A |
| BIORETENTION SOIL MIX | SAND 50% FINE AGGREGATE, MSHA 901 MULCH 20% DOUBLE SHREDDED HARDWOOD, AGED 6 MONTHS MIN. BASE SOIL 30% - SEE BELOW PH OF 5.7 - 7.1 | 2.0-0.50 MM 2" MAX. SEE BELOW |
| BASE SOIL | SAND 50 - 85% SILT 5 - 45% CLAY 5 - 10% ORGANIC MATTER 1.0-10% BY WEIGHT PH OF 5.7 - 6.9 | 2.0-0.50 MM 0.050-0.002 MM LESS THAN 0.002 MM N/A |
| MULCH | SHREDDED HARDWOOD | AGED 6 MONTHS, MINIMUM; NO PINE OR WOOD CHIPS |
| PEA GRAVEL DIAPHRAGM | PEA GRAVEL: ASTM-D-448 | NO. 8 OR NO. 9 (1/8" TO 3/8") |
| GEOTEXTILE | CLASS 'C' - APPARENT OPENING SIZE (ASTM-D-4571), GRAB TENSILE STRENGTH (ASTM-D-4832), PUNCTURE RESISTANCE (ASTM-D-4833) | N/A |
| GRAVEL (UNDERDRAINS AND INFILTRATION BERMS) | AASHTO M-43 | NO. 57 OR NO. 6 AGGREGATE (3/8" TO 3/4") |
| UNDERDRAIN PIPING | F 758, TYPE PS 28 OR AASHTO M-278 | 4" TO 6" RIGID SCHEDULE 40 PVC |
| POURED IN PLACE CONCRETE (IF REQUIRED) | MSHA MIX NO. 3; Fc=3500 PSI @ 28 DAYS, NORMAL WEIGHT, AIR-ENTRAINED; REINFORCING TO MEET ASTM-615-60 | N/A |
| RIGID PLASTIC PANELING (VINYL SHEET PILE) | MATERIAL: SECTION DEPTH: MINIMUM THICKNESS: PROFILE: TENSILE STRENGTH: FLEXURAL STRENGTH: MODULUS OF ELASTICITY: NOTCHED IZOD IMPACT: HEAT DEFLECTION TEMPERATURE: | RIGID VINYL, UV STABILIZED, EXTERIOR GRADE MINIMUM 2" MAXIMUM 8" 24" 0.30" FLAT OR Z-PROFILE ASTM-D638 6,000 lbs/in ASTM-D790 211,000 psi ASTM-D790 380,000 psi ASTM-D256 13.75 lbs/in ASTM-D648 150 degrees F |
| IMPERMEABLE LINER | ASTM-D-4833 (THICKNESS) ASTM-D-412 (TENSILE STRENGTH 1,100 lb. ELONGATION 200%) ASTM-D-624 (TEAR RESISTANCE - 150 lb./in) ASTM-D-471 (WATER ABSORPTION: +8 to -2% mass) | 30 MIL THICKNESS |

▲ PURPOSE STATEMENT (11/1/23): DESIGN OF OUTDOOR TESTING AREA 3, INCLUDING THE SOURCE OF BORROW MATERIAL REFERRED TO AS THE EAST AND WEST BORROW AREAS.


▲ PURPOSE STATEMENT (4/7/22): ADDITION OF TWO 6'x40' CONCRETE PADS

\\ad.rkk.com\fs\Cloud\Projects\2021\21047_APL2021MSA\Projects\Task_13 - OTA_3\CADD\Plans\C-504_SWM_Notes.dwg Oct. 31, 2023 1:23pm jslatz

APPROVED: DEPARTMENT OF PLANNING AND ZONING
 Chief, Development Engineering Division
 Date: 12-9-23
 Chief, Division of Land Development
 Date: 2/22/24
 Director
 Date: 2/22/24



PROFESSIONAL CERTIFICATION: I HEREBY CERTIFY THAT THESE DOCUMENTS WERE PREPARED OR APPROVED BY ME, AND THAT I AM A DULY LICENSED PROFESSIONAL ENGINEER UNDER THE LAWS OF THE STATE OF MARYLAND. LICENSE NO. 4643, EXPIRATION DATE: MAY 31, 2026.

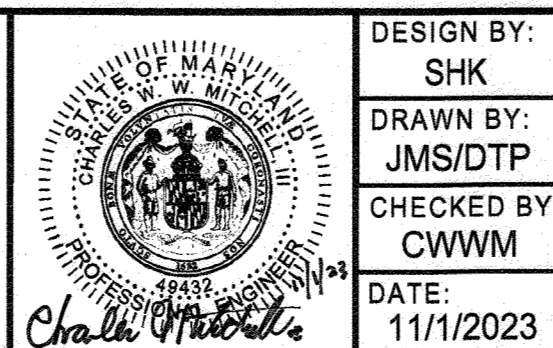


| | | | | |
|-------------------|------|-----|---|---------|
| DESIGN BY: SHK | RK&K | 3 | Addition of Two 6"x40' Concrete Pads | 4/7/22 |
| DRAWN BY: JMS/DTP | RK&K | 4 | Replacement Sheet - OTA-3 and Borrow Area Modifications | 11/1/23 |
| CHECKED BY: CWWW | | | | |
| DATE: 11/1/2023 | BY | NO. | REVISION | DATE |


OWNER/DEVELOPER
JOHNS HOPKINS APPLIED PHYSICS LABORATORY
 11100 JOHNS HOPKINS ROAD
 LAUREL, MARYLAND 20723

SWM NOTES
 JOHNS HOPKINS UNIVERSITY - APPLIED PHYSICS LABORATORY
OUTDOOR TESTING AREAS
 11100 JOHNS HOPKINS ROAD
 TAX MAP: 41 PARCEL: 123 GRID: 16 ZONED: PEC
 ELECTION DISTRICT 5 - HOWARD COUNTY, MARYLAND
 SHEET 44 OF 73


C-504
 RK&K PROJECT NUMBER 21047.013
 SCALE: As Shown

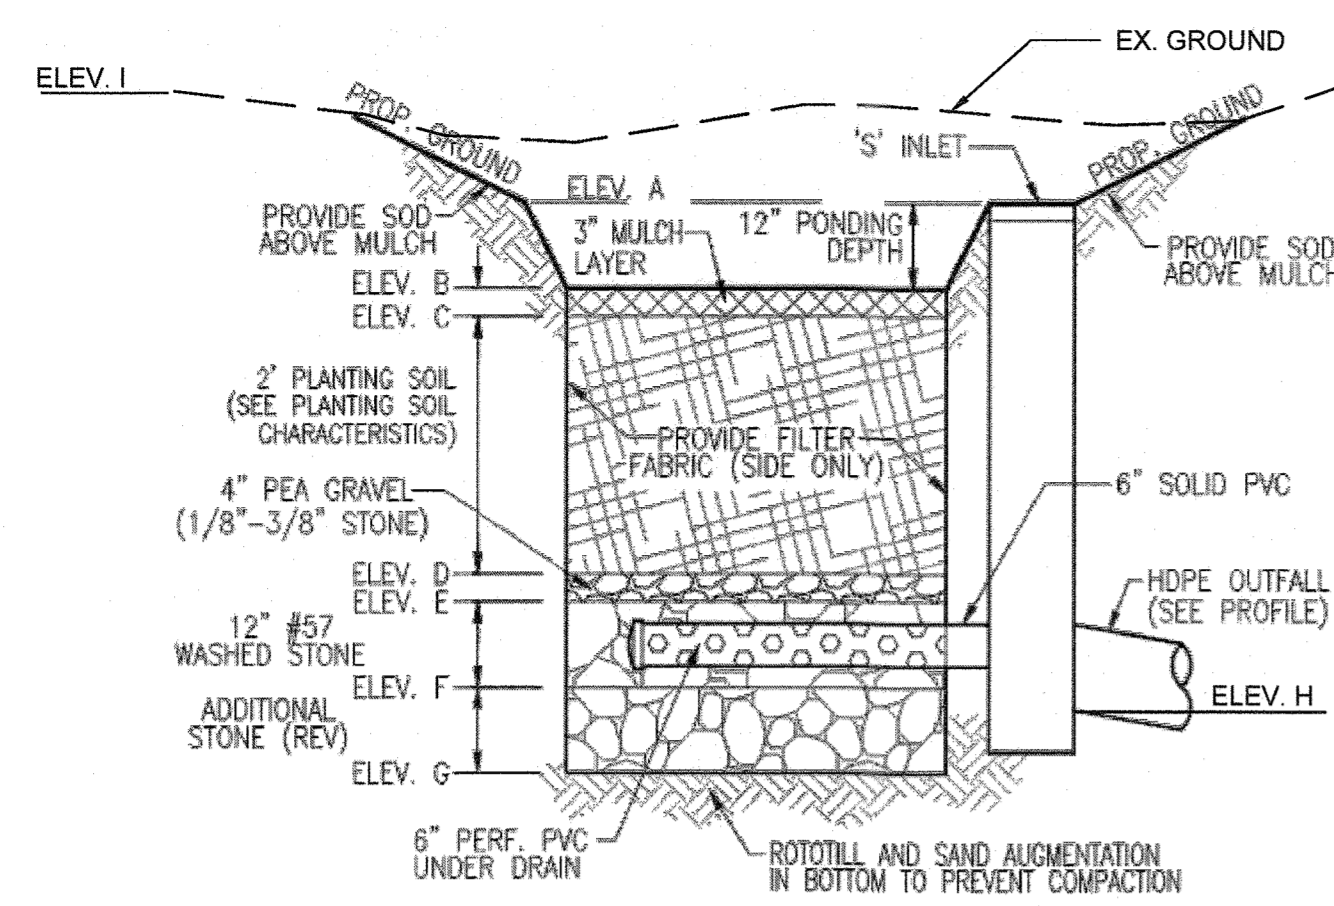


MICRO-BIORETENTION (UNDERDRAIN)
NOT TO SCALE

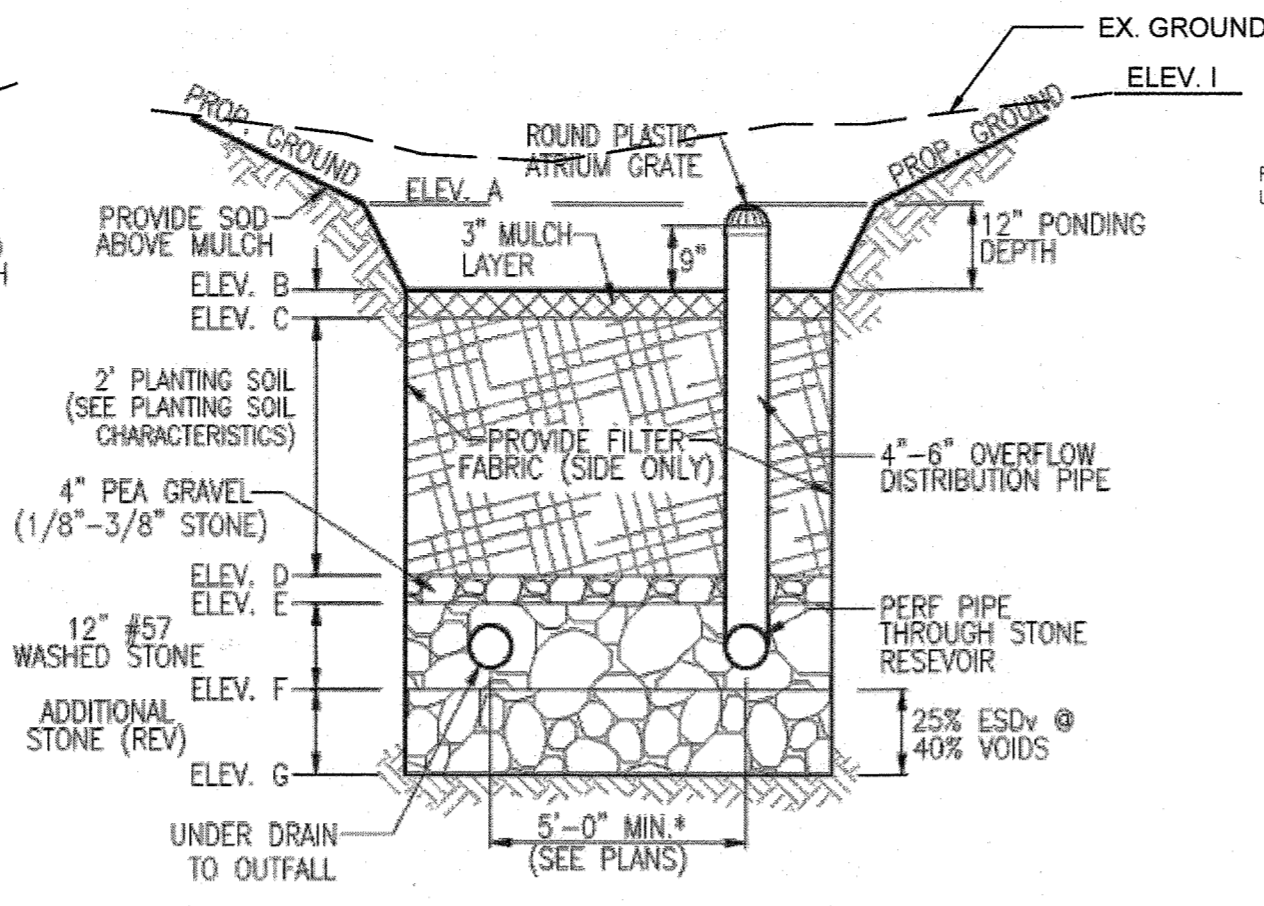

MICRO-BIORETENTION (OVERFLOW)
NOT TO SCALE

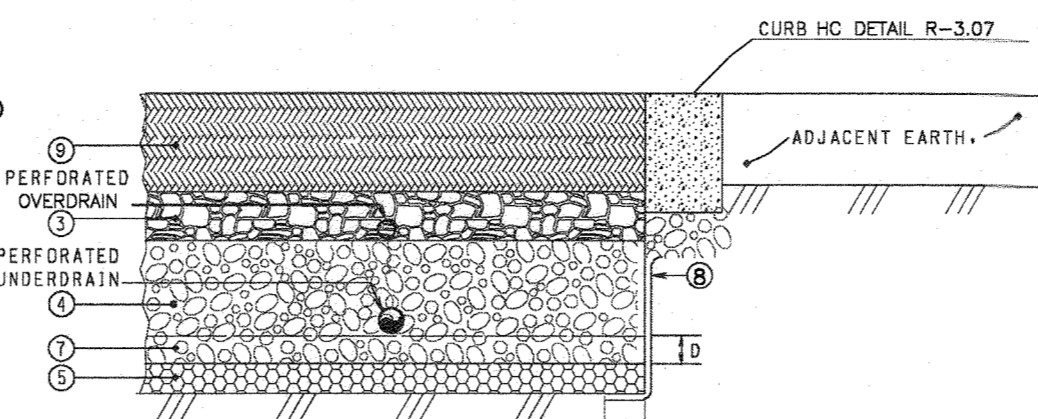

POROUS CONCRETE PAD
NOT TO SCALE

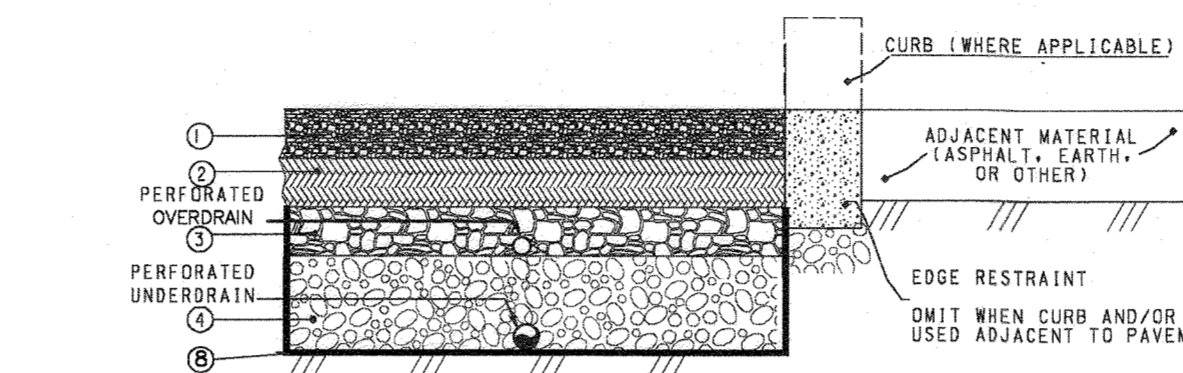

POROUS PAVEMENT DETAIL TYP. (FILL CONDITIONS)
N.T.S.


| MATERIAL SPECIFICATIONS | | | |
|-------------------------|---------------|------|--|
| Material | Specification | Size | Notes |
| Underdrain | AASHTO M-278 | 6" | SCH 40 pipe - with 3/8" perforations @ 6" on center. 4 holes per row. Perforated pipe shall be wrapped with 1/4 inch galvanized hardware cloth. |
| Overdrain | AASHTO M-278 | 2" | Schedule 40 pipe - with 3/8" perforations @ 6" on center. 4 holes per row. Perforated pipe shall be wrapped with 1/4 inch galvanized hardware cloth. |

KEY NOTES

- 2" POROUS ASPHALT SURFACE COURSE - HMA 12.5 MM
- 2.5" POROUS ASPHALT BASE COURSE - HMA 25 MM
- 4" CHOKER LAYER, AASHTO # 57 OR APPROVED EQUIVALENT
- 13" RESERVOIR LAYER, AASHTO # 57 OR APPROVED EQUIVALENT
- 4" FILTER LAYER, AASHTO # 8 OR APPROVED EQUIVALENT
- GEOTEXTILE CLASS 2, LOCATED ON SIDES OF PRACTICES ONLY
- INFILTRATION SUMP, FOR STANDARD DESIGN, D = 0.25'
- UNCOMPACTED SUBGRADE FOR AREAS DESIGNED FOR INFILTRATION PRACTICES. FOR SOFT SOIL, INSTALL GEOGRID PER GEOTECHNICAL ENGINEER RECOMMENDATIONS.
- IMPERVIOUS LINER IN FILL CONDITIONS.
- 4" POROUS CONCRETE

NOTES:

- POROUS PAVEMENT SURFACES (ASPHALT OR CONCRETE) SHALL HAVE A PERMEABILITY OF EIGHT INCHES PER HOUR OR GREATER TO CONVEY WATER INTO THE SUBBASE RAPIDLY.
- INSTALL CLEANOUT AT THE UPSLOPE END OF EACH RUN OF PIPE AND MIDWAY BETWEEN UPSLOPE AND DOWNSLOPE ENDS OF PIPE AT A MINIMUM.
- CONTRACTOR SHALL VARY THE ELEVATION OF THE UNDERDRAIN AS NEEDED WITHIN THE RESERVOIR LAYER TO ENSURE POSITIVE DRAINAGE TO THE DOWNSLOPE END OF THE PIPE AT THE TIE IN LOCATION.

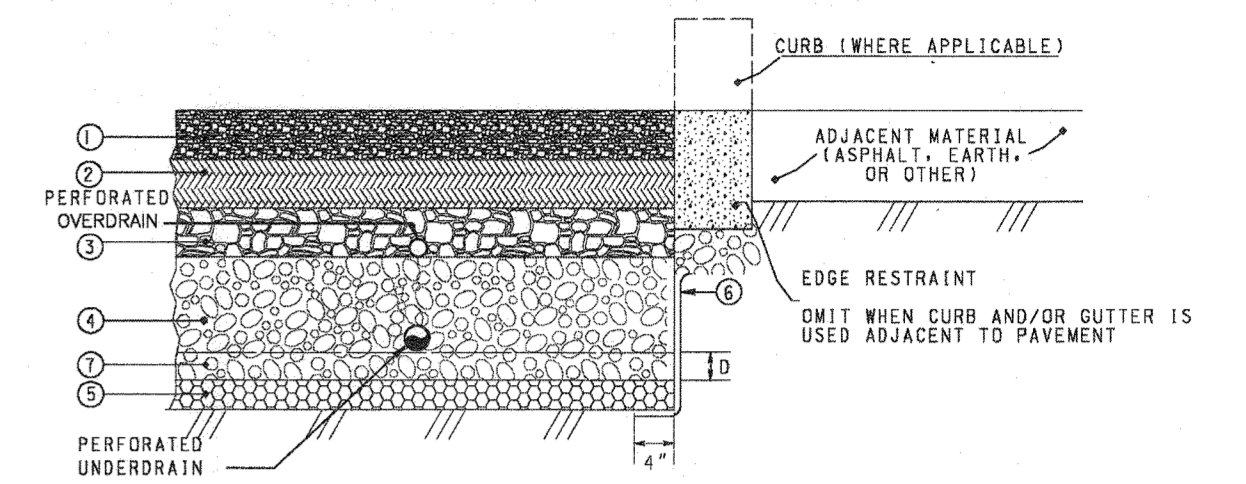


POROUS PAVEMENT DETAIL TYP. (CUT CONDITIONS)
N.T.S.


| MICROBIORETENTION DATA | | | | | | | | | | |
|------------------------|-------------------|------------------------------|--|---|---|-------------------------------|--|----------------------------------|--|-------------------|
| FACILITY | PONDING (ELEV. A) | TOP OF MULCH LAYER (ELEV. B) | TOP OF BIORETENTION SOIL (BSM) (ELEV. C) | BOTTOM OF BSM / TOP OF CHOKER LAYER (ELEV. D) | BOTTOM OF CHOKER LAYER / TOP OF RESERVOIR LAYER (ELEV. E) | 12" #57 STONE ELEV. (ELEV. F) | BOTTOM OF MICRO-BIORETENTION ON FACILITY (ELEV. G) | OUTLET PIPE INV. ELEV. (ELEV. H) | EXISTING GRADE (ELEV. I) | GROUNDWATER ELEV. |
| MB-1 | 394 339 | 396 338 | 329.75 337.75 | 327.75 335.75 | 327.42 335.42 | 326.42 334.42 | 325.42 333.42 | 325 334.67 | MIN. 329.14 334.5 MAX. 336.67 341.4 | NONE |
| MB-2 | 332 | 334.00 | 330.75 | 328.75 | 328.42 | 327.42 | 326.42 | 322.87 | MIN. 335.50 MAX. 339.20 | NONE |

MICRO-BIORETENTION NOTES

- BIORETENTION MATERIALS AND CONSTRUCTION SHALL MEET HOWARD COUNTY CONSTRUCTION SPECIFICATION FOR SHALLOW FACILITY.
- TREES AND PLANTS SHALL BE INSTALLED IN ACCORDANCE WITH LANDSCAPE PLANS. ALL PLANTINGS SHALL BE IN ACCORDANCE WITH THE HOWARD COUNTY LANDSCAPE MANUAL.
- THE UNDERDRAIN SHALL BE 6-INCH DIAMETER SCHEDULE 40 OR STRONGER PERFORATED PVC PIPE AT 0.00% SLOPE. PERFORATIONS MUST BE 3/8 INCH IN DIAMETER AND MUST BE LOCATED 8 INCHES ON CENTER, EVERY 90 DEGREES AROUND THE PIPE.
- WRAP THE PERFORATED MBR UNDERDRAIN PIPE WITH 1/4" MESH (4x4) OR SMALLER GALVANIZED HARDWARE CLOTH.
- PROVIDE 5' MINIMUM SPACING BETWEEN UNDER DRAIN AND PERFORATED PIPE THROUGH STONE RESERVOIR OR SPACE PIPE EQUALLY ACROSS BOTTOM FOR SMALL MICRO-BIORETENTIONS.
- BOTTOM OF FACILITY SHALL BE AT LEAST 2' ABOVE SEASONAL HIGH WATER TABLE AND BEDROCK AS DETERMINED BY GEOTECHNICAL INVESTIGATION.
- THE GRAVEL LAYER/STONE RESERVOIR LAYER SURROUNDING THE UNDERDRAIN PIPE(S) MUST MEET AASHTO M-43. AND MUST PROVIDE A MINIMUM OF 6 INCHES COVER OVER THE PIPE(S), AND MINIMUM 3 INCHES UNDER THE PIPE.
- NO GEOTEXTILE OR FILTER FABRIC IS ALLOWED TO BE PLACED HORIZONTALLY ANYWHERE WITHIN THE FILTER MEDIA.
- SEE TABLE B 4.1 MATERIALS SPECIFICATIONS FOR MICRO-BIORETENTION ON SHEET C-504

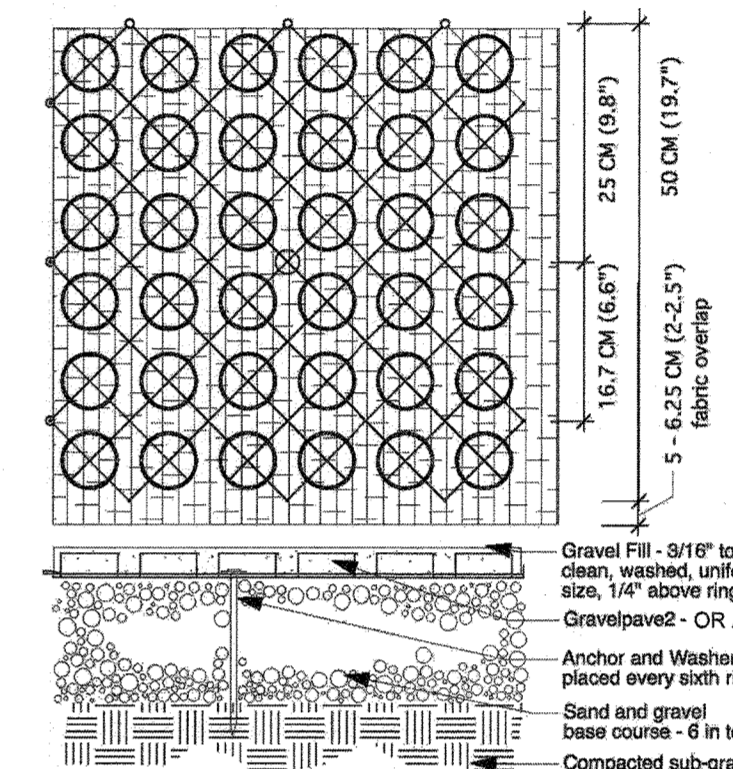


RE-INFORCED TURF / GRAVELPAVE DETAIL
N.T.S.

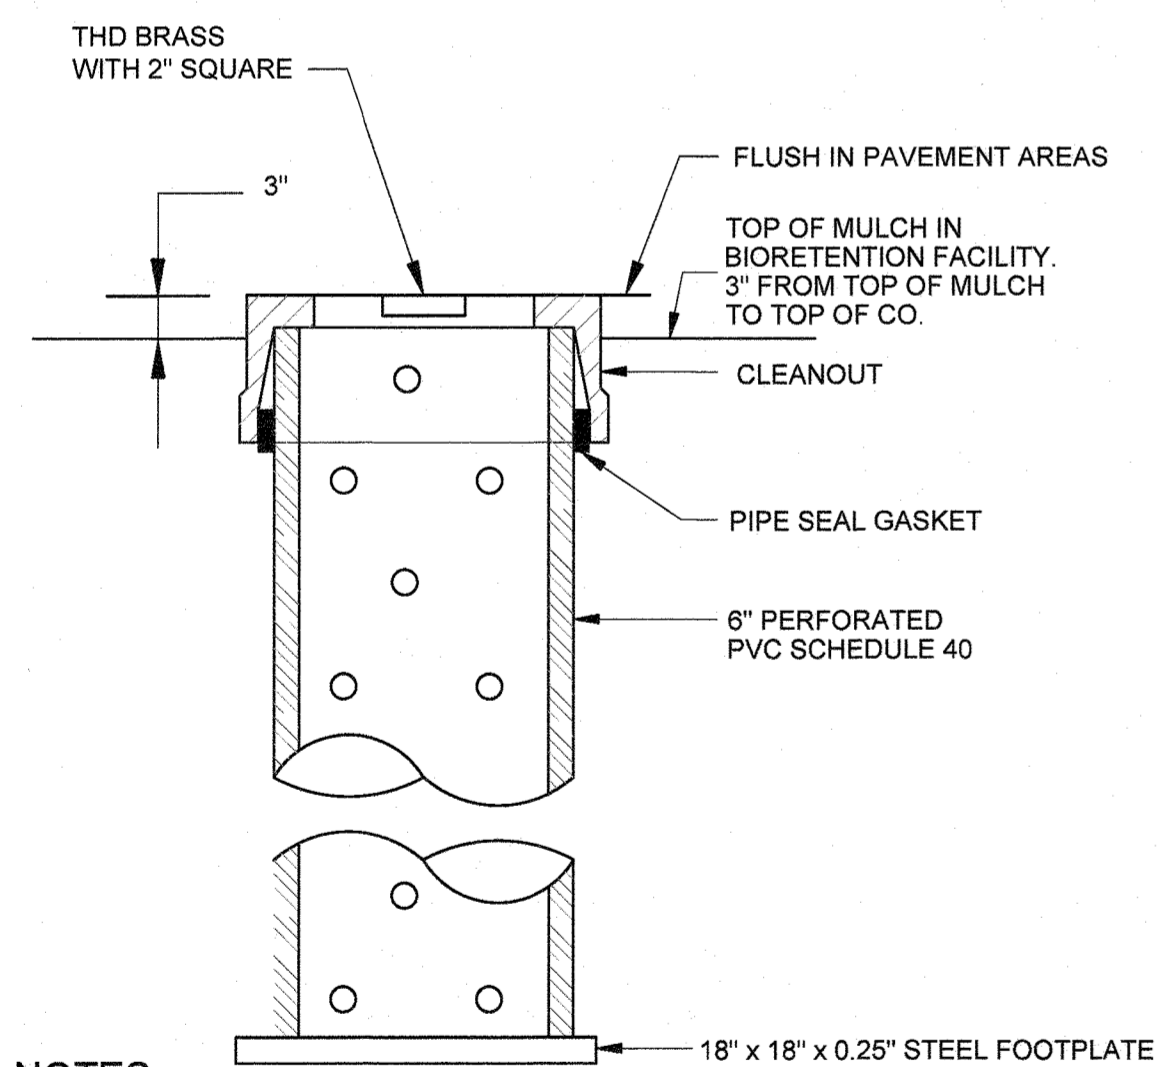

DETAIL - OBSERVATION WELL
SCALE: N.T.S.


- NOTES:**
- OBSERVATION WELLS (6" PVC SCH. 40 PIPE) SHALL BE PLACED IN THE FACILITY AT THE LOCATIONS INDICATED ON THE PLAN SHEETS.
 - THE WELL IS TO BE CAPPED USING A THREADED PVC FITTING AND SEWER CAP WITH A 2 INCH SQUARE LUG. THE DEPTH OF THE FACILITY IS TO BE MARKED ON THE CAP.
 - THE BOTTOM OF THE BIORETENTION FACILITY SHALL BE GRADED FLAT.
 - ENTIRE BARREL OF OBSERVATION WELL IS TO BE WRAPPED IN GEOTEXTILE.

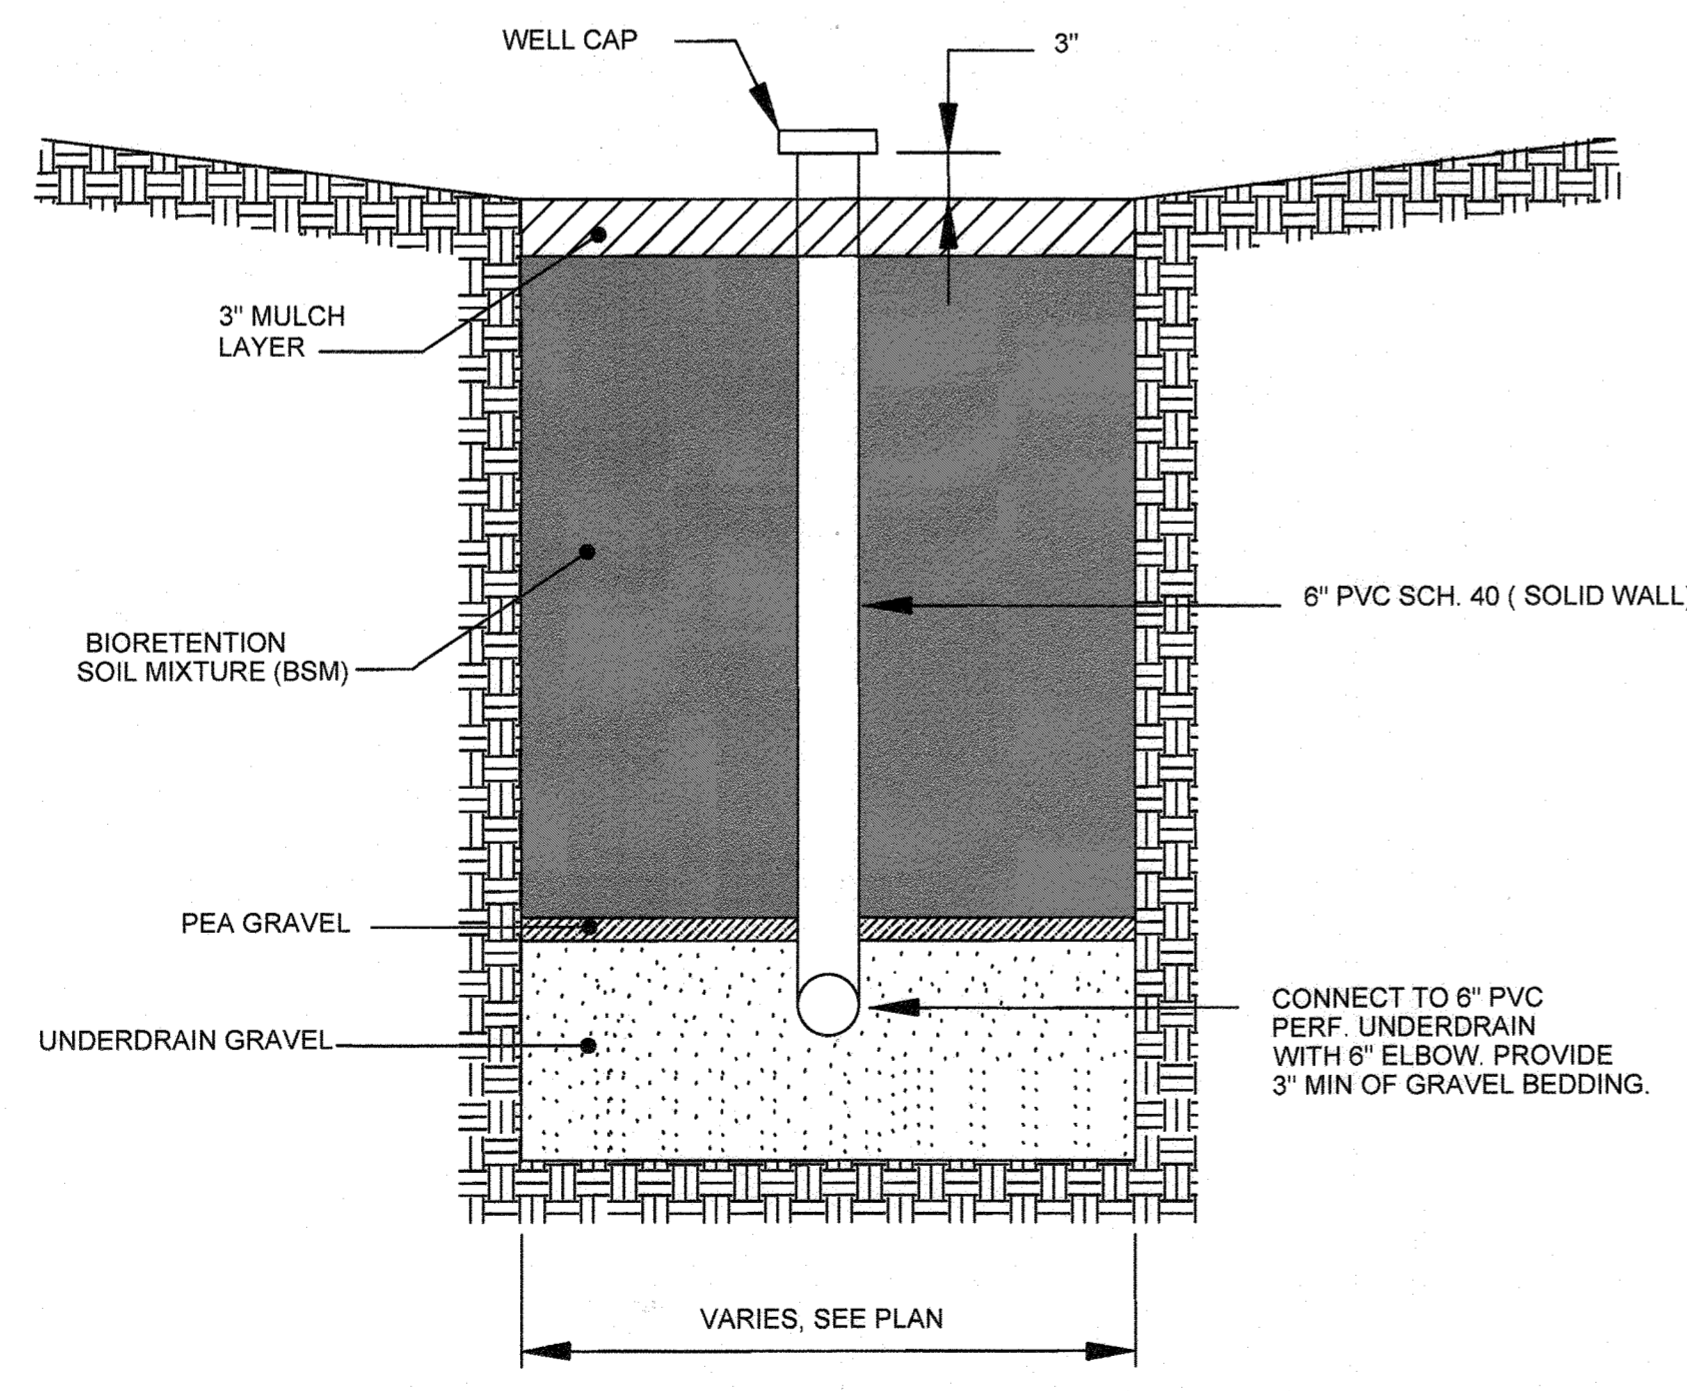

MICROBIORETENTION CLEANOUT DETAIL
N.T.S.


NOTES:

- FOR CONFIGURATION AND DIMENSION OF POROUS ASPHALT LAYER SEE DETAILS ON THIS SHEET.

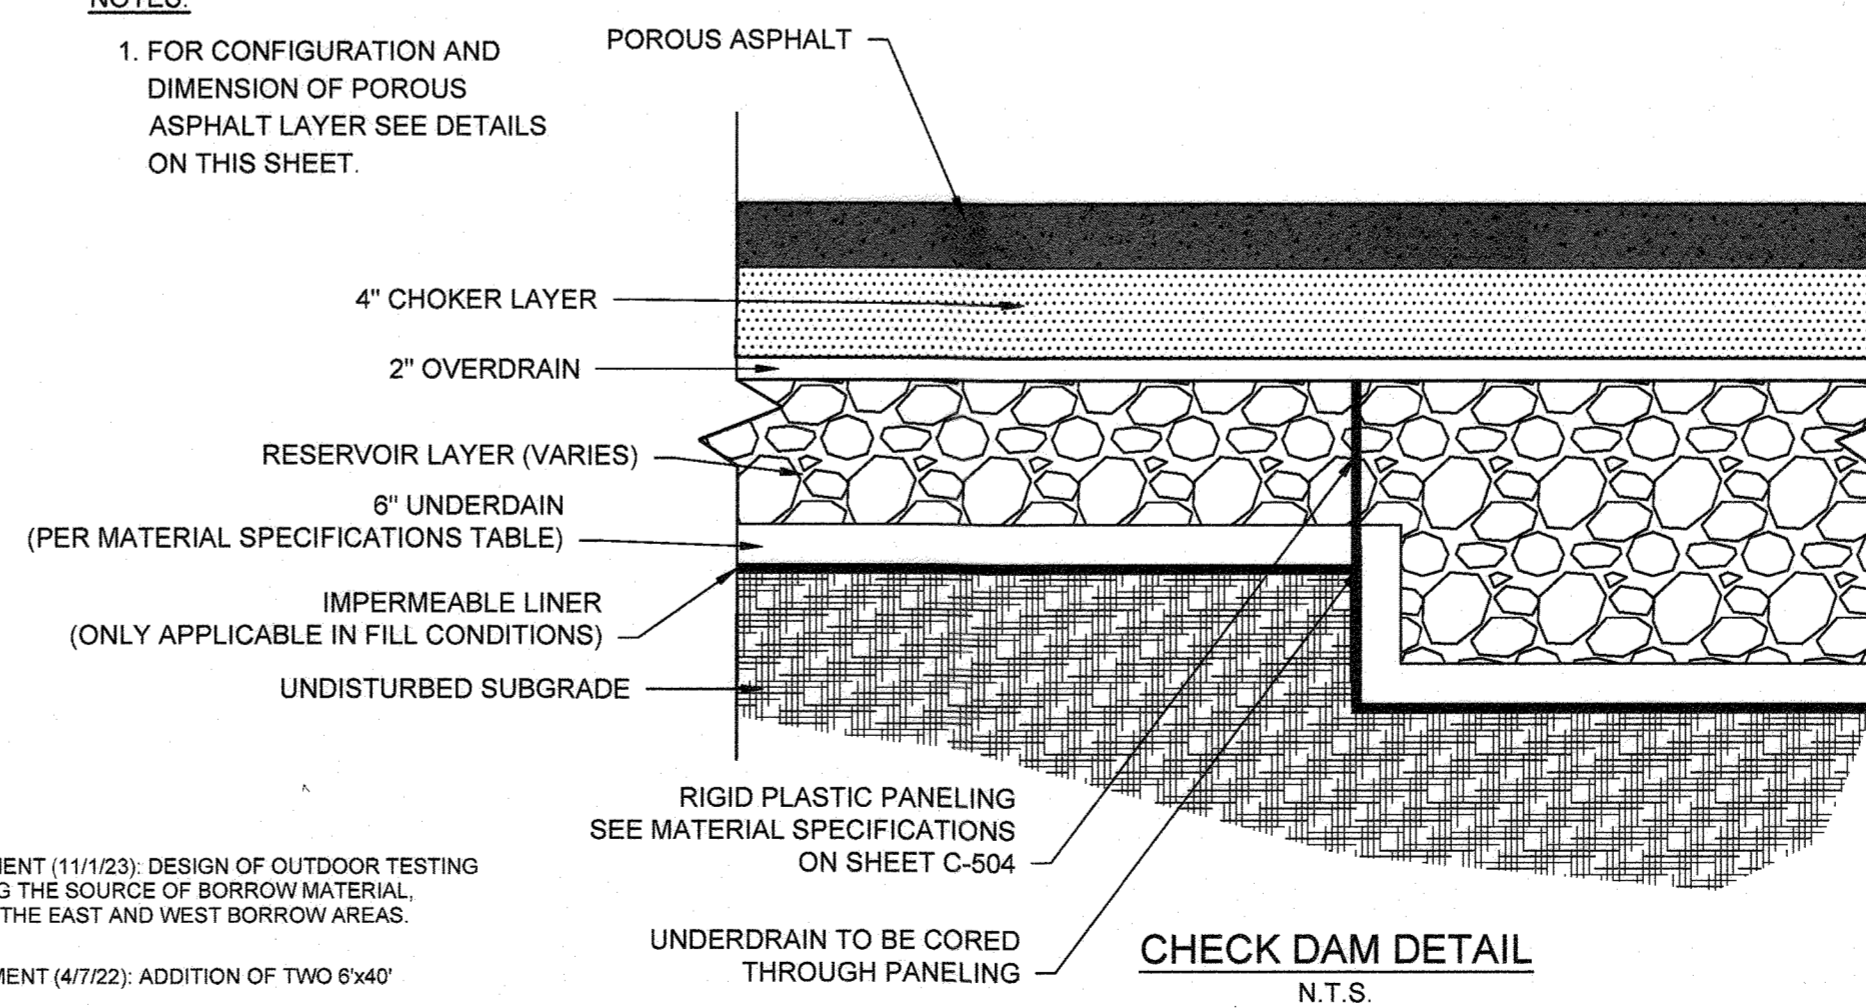


CHECK DAM DETAIL
N.T.S.

- PURPOSE STATEMENT (11/1/23): DESIGN OF OUTDOOR TESTING AREA 3, INCLUDING THE SOURCE OF BORROW MATERIAL, REFERRED TO AS THE EAST AND WEST BORROW AREAS.
- PURPOSE STATEMENT (4/7/22): ADDITION OF TWO 6'x40' CONCRETE PADS

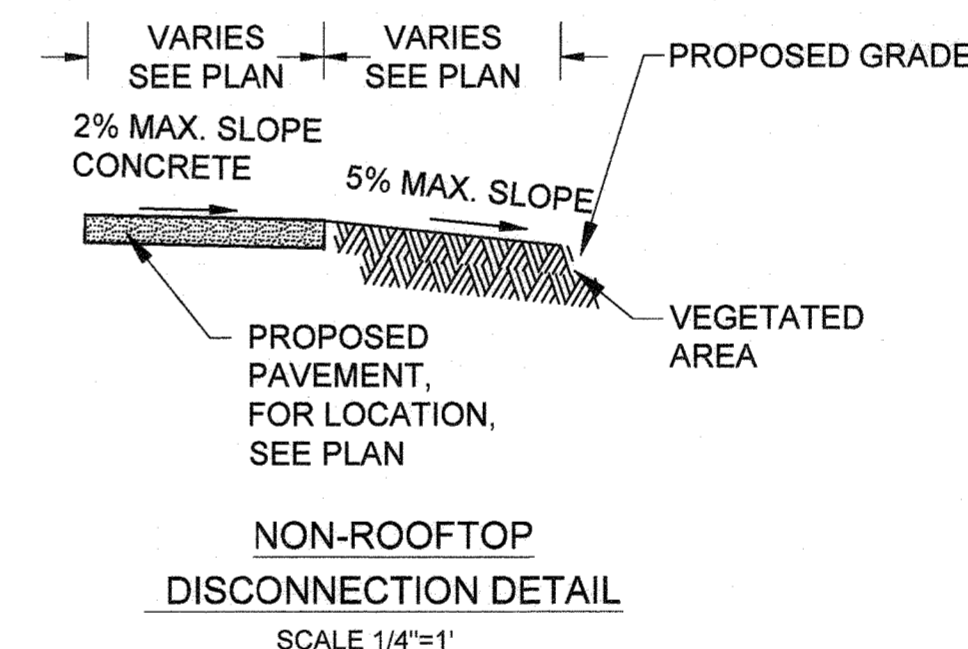

NON-ROOFTOP DISCONNECTION DETAIL
SCALE 1/4"=1'

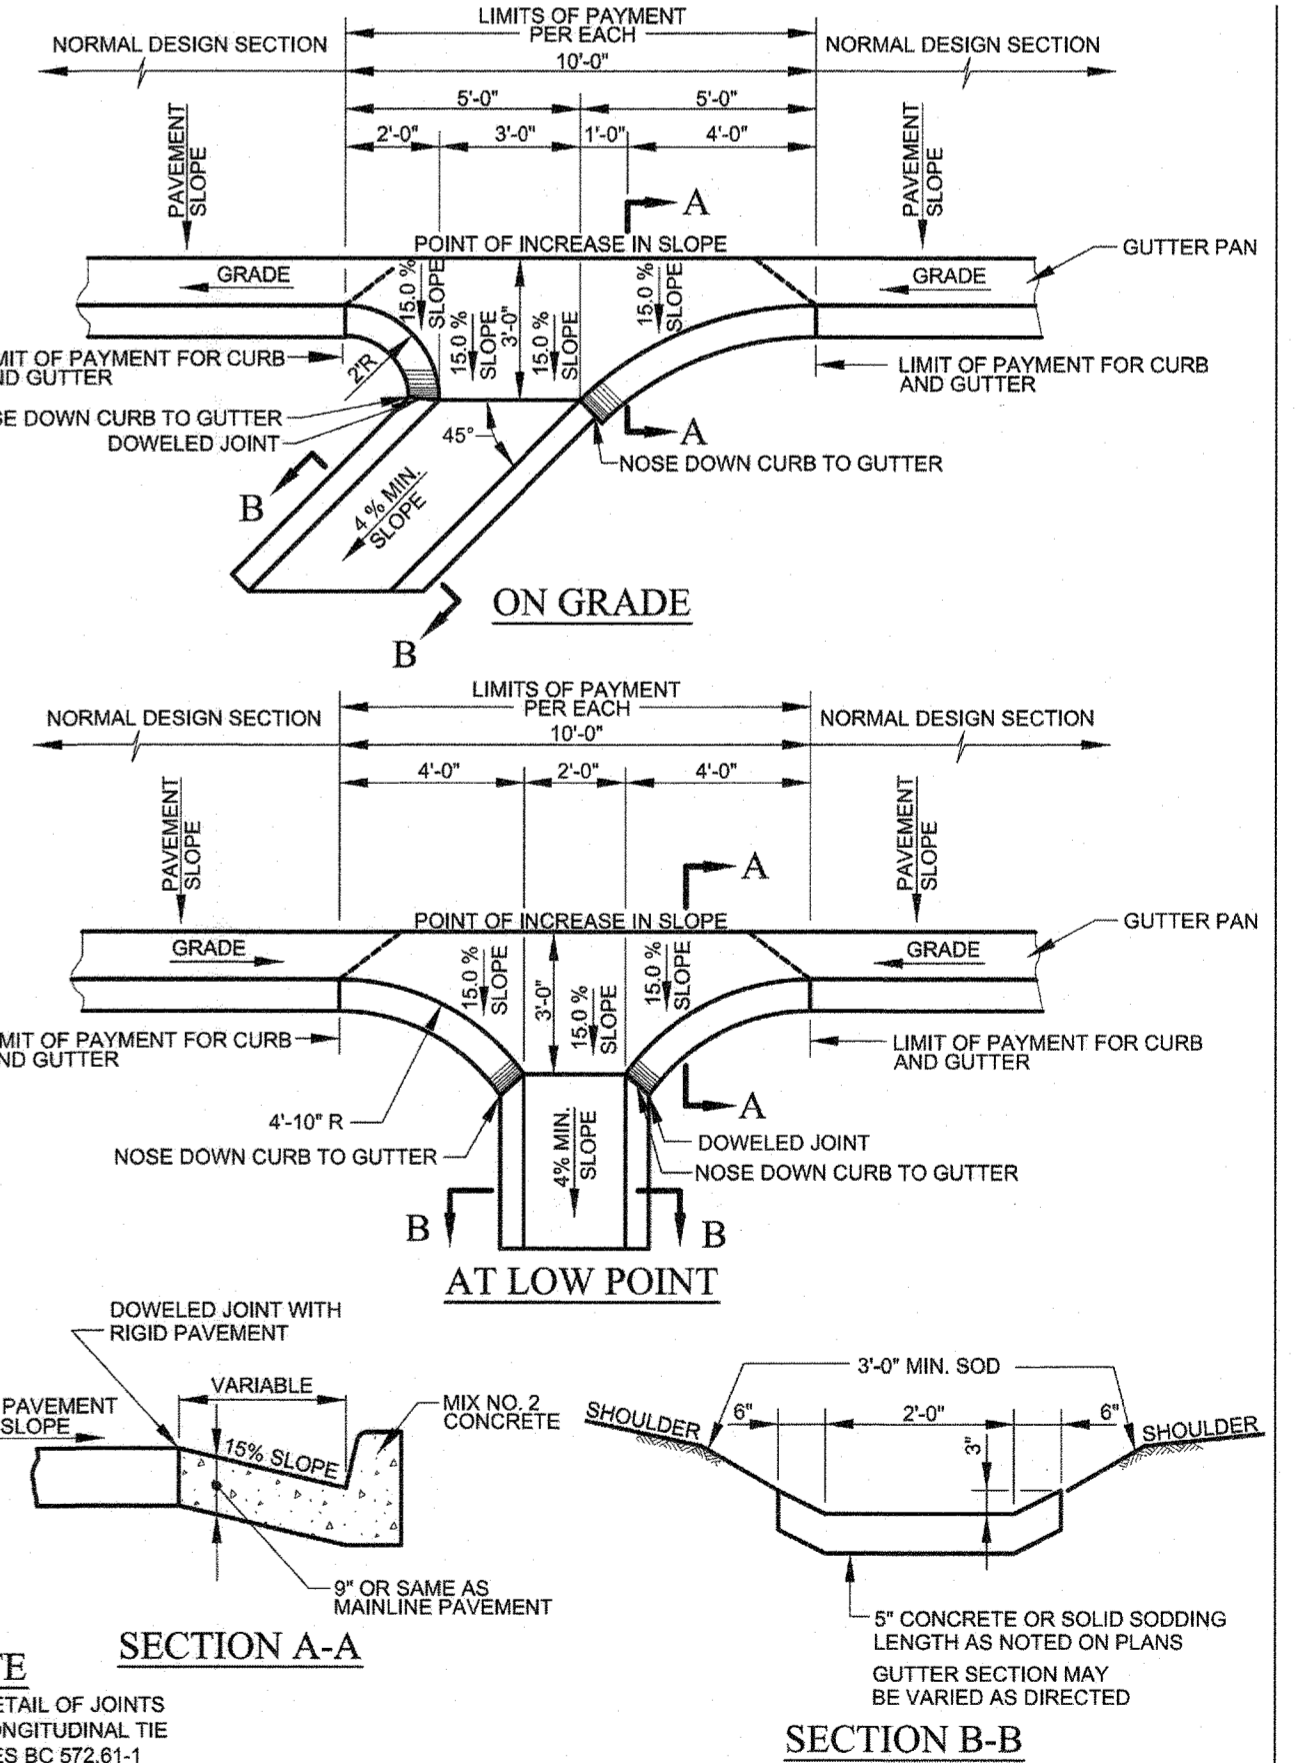

CURB CUT DETAIL
NOT TO SCALE

APPROVED: DEPARTMENT OF PLANNING AND ZONING
 Chief, Development Engineering Division
 Date: 12-5-23
 Chief, Division of Land Development
 Date: 2/22/24

RK&K
 RUMMEL, KLEPPER & KAHL, LLP
 ENGINEERS/CONSTRUCTION MANAGERS/PLANNERS/SCIENTISTS
 700 East Pratt Street, Suite 500
 Baltimore, MD 21202
 Ph: 410.728.2900
 www.rk&k.com

DESIGN BY: SHK
 DRAWN BY: JMS/DTP
 CHECKED BY: CWWW
 DATE: 11/1/2023


| NO. | REVISION | DATE |
|-----|---|---------|
| 3 | Addition of Two 6'x40' Concrete Pads | 4/7/22 |
| 4 | Replacement Sheet - OTA-3 and Borrow Area Modifications | 11/1/23 |

OWNER/DEVELOPER
JOHNS HOPKINS APPLIED PHYSICS LABORATORY
 11100 JOHNS HOPKINS ROAD
 LAUREL, MARYLAND 20723

SWM DETAILS
 JOHNS HOPKINS UNIVERSITY - APPLIED PHYSICS LABORATORY
OUTDOOR TESTING AREAS
 11100 JOHNS HOPKINS ROAD
 PARCEL: 123 GRID: 16 ZONED: PEG
 ELECTION DISTRICT 5 HOWARD COUNTY, MARYLAND
 SHEET 45 OF 73

C-505
 RK&K PROJECT NUMBER 21047.013
 SCALE: As Shown

\\ad.rk.com\fs\Cloud\Projects\2021\21047_APL2021MSA\Projects\Task_13 - OTA 3\CADD\Plans\C-506 SWM Landscaping Plan - OTA 3 (Phase 2).dwg Oct 31, 2023 1:27pm jgaltz

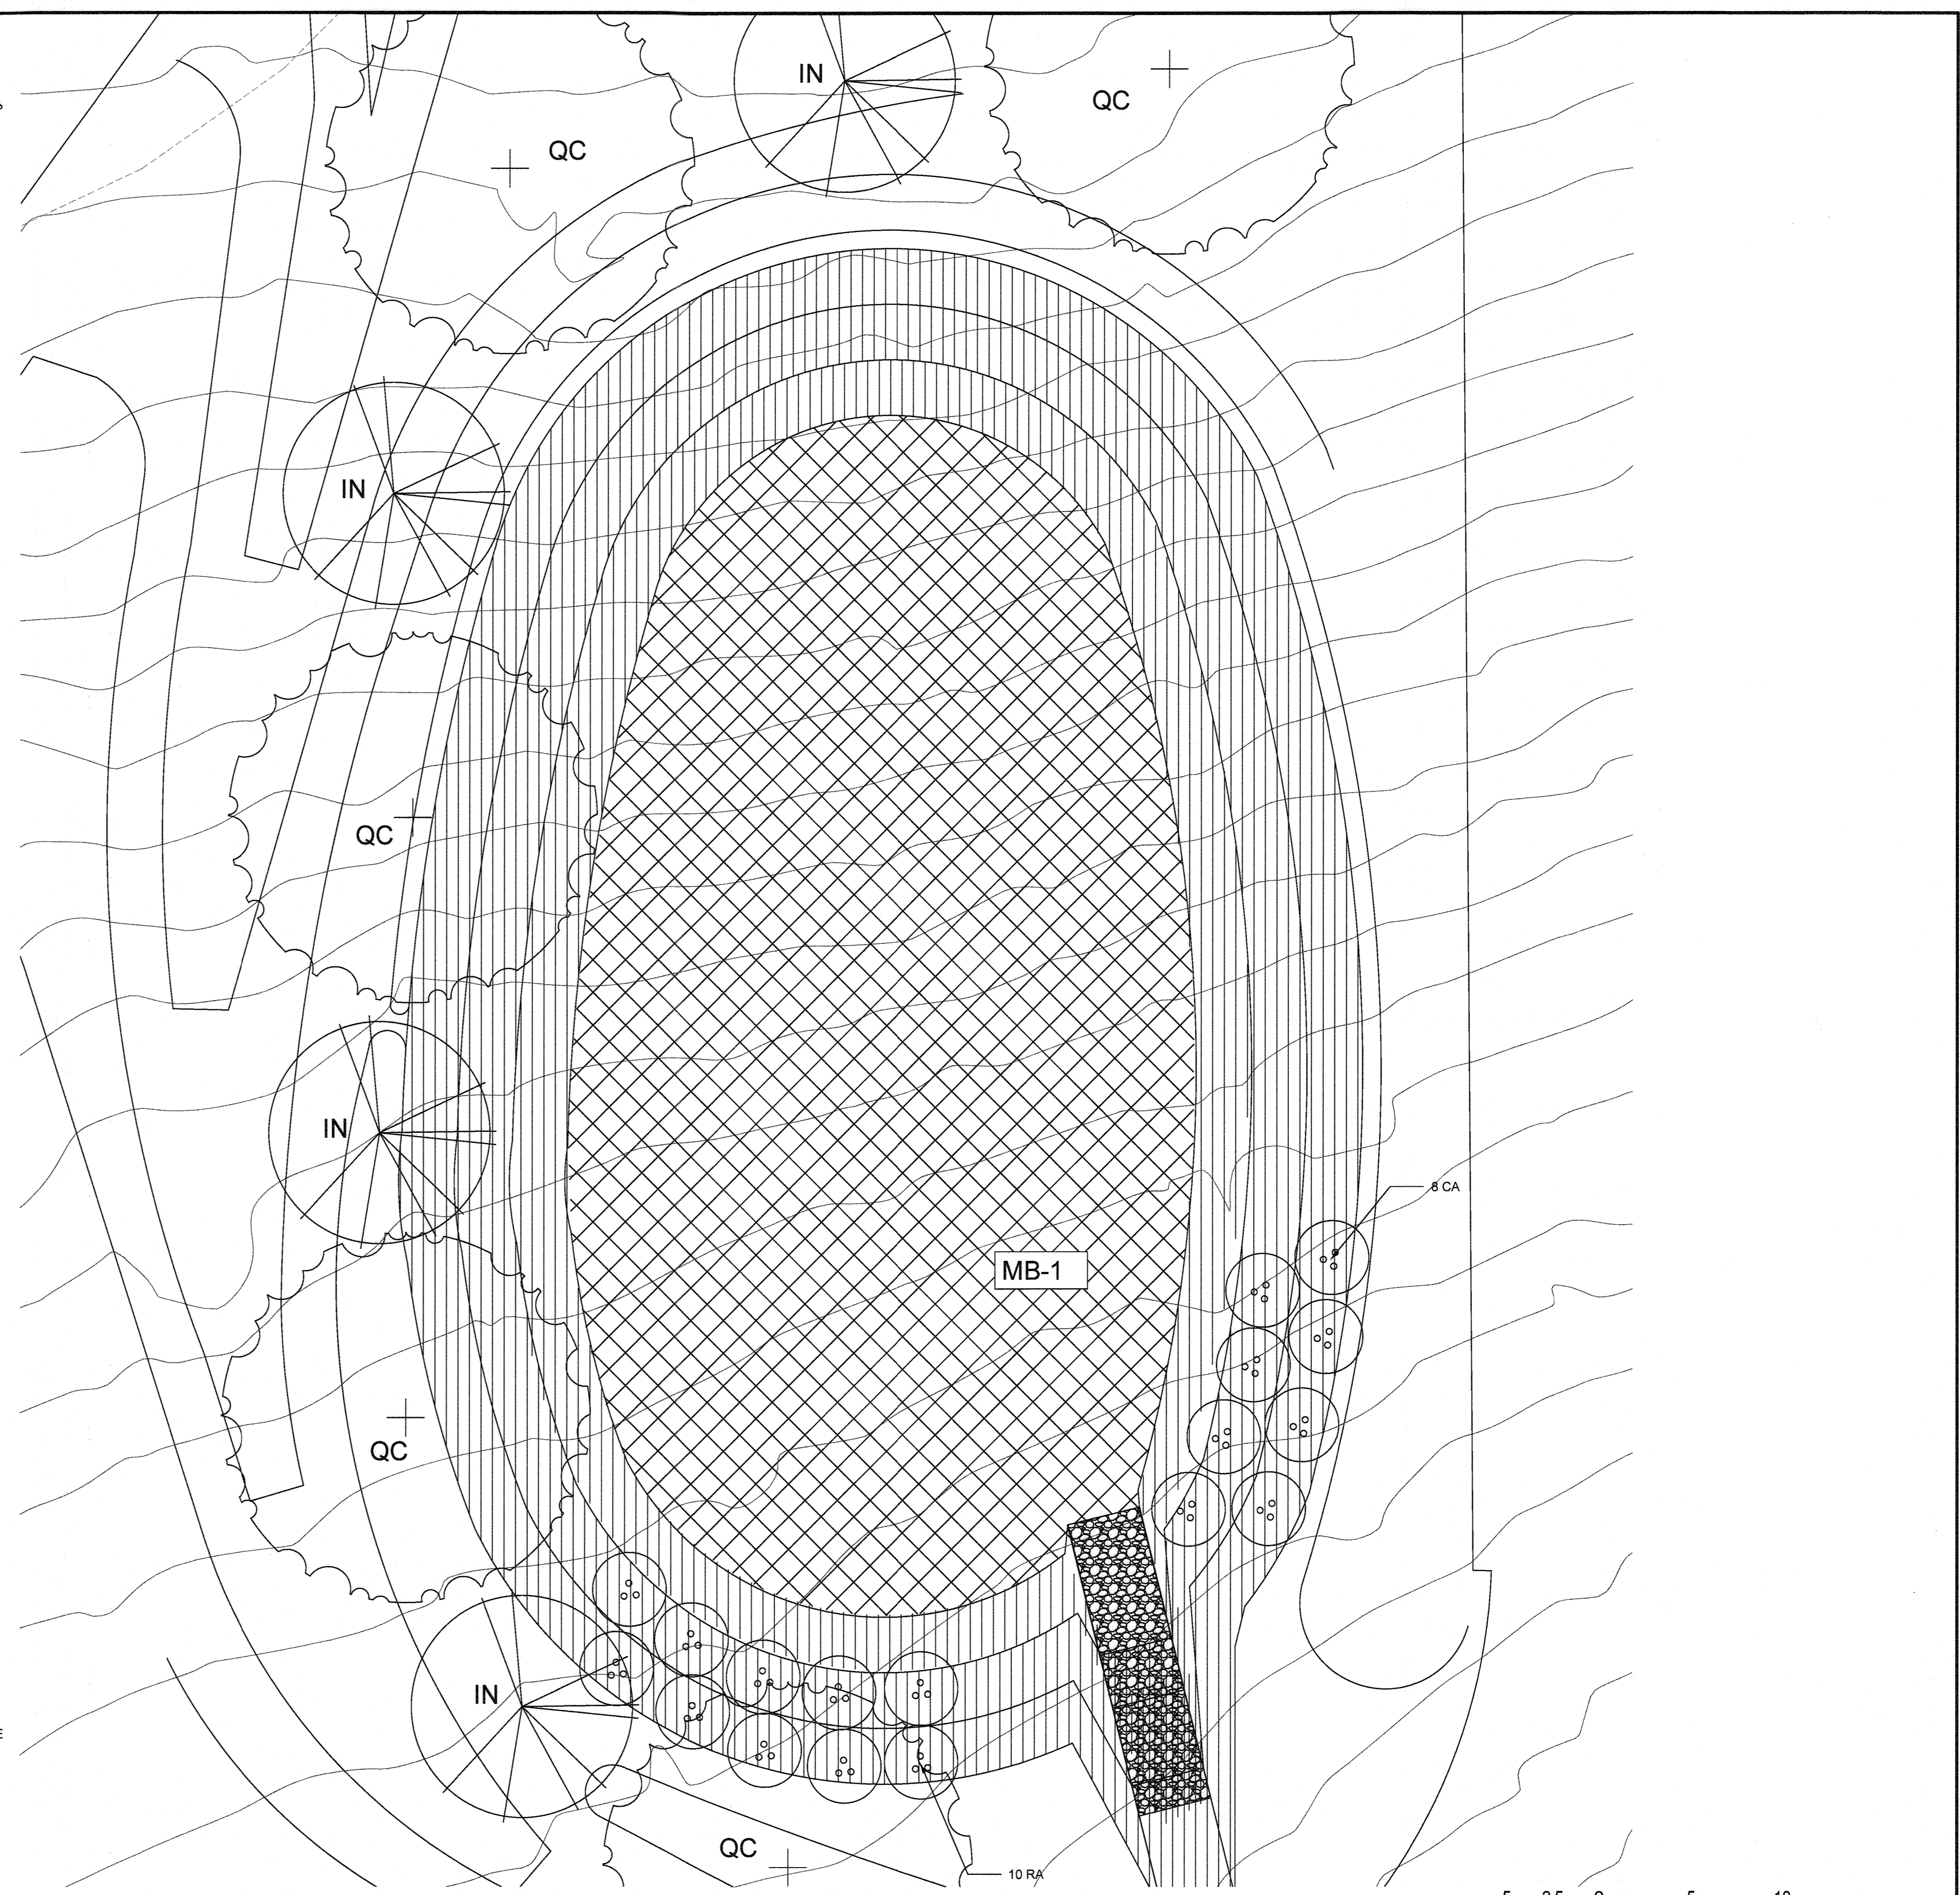


| PLANTING LIST | | | | | |
|------------------------|--------|---|----------|------------------------|----------------------------------|
| | SYMBOL | BOTANICAL/ COMMON NAME | QUANTITY | SIZE & ROOT SPACING | REMARKS |
| TREES | QC | <i>Quercus coccinea</i> Scarlet Oak | 5 | 2.5 CAL. B&B | WELL-BRANCHED, STRAIGHT TRUNK |
| | IN | <i>Juncus effusus</i> SOFT RUSH | 4 | 6'-8" Ht. B&B | WELL-BRANCHED, STRAIGHT TRUNK |
| GRASSES/ HERBACEOUS | DES | <i>Deschampsia cespitosa</i> TUFTED HAIRGRASS | 595 | #1 CONT. 18" O.C. | |
| | JUN | <i>Juncus effusus</i> SOFT RUSH | 595 | #1 CONT. 18" O.C. | |
| LOW SHRUB | BOU | <i>Bouteloua curtipendula</i> SIDE OATS GRAMA | 273 | #1 CONT. 24" O.C. | |
| | CA | <i>Clethra alnifolia</i> 'Sixteen Candles' SUMMERSWEET | 8 | #3 CONT. 24" Spd. | FULL, WELL-BRANCHED |
| | RA | <i>Rhus aromatica</i> 'Gro Low' BWARF FRAGRABY SUMAC | 10 | #3 CONT. 4' O.C. | FULL, WELL-BRANCHED |

NOTE:
 FOR STRUCTURE TYPE, DIMENSIONS AND ELEVATIONS SEE STRUCTURE SCHEDULE TABLE ON SHEET C-215.
 FOR MICRO-BIORETENTION DIMENSIONS AND DETAILS SEE SHEET C-505.
 FOR MATERIAL, SPECIFICATIONS AND MAINTENANCE SEE SHEET C-504.

4 PURPOSE STATEMENT (11/1/23): DESIGN OF OUTDOOR TESTING AREA 3, INCLUDING THE SOURCE OF BORROW MATERIAL, REFERRED TO AS THE EAST AND WEST BORROW AREAS.

OTA 3 LANDSCAPING PLAN MICRO- BIORETENTION

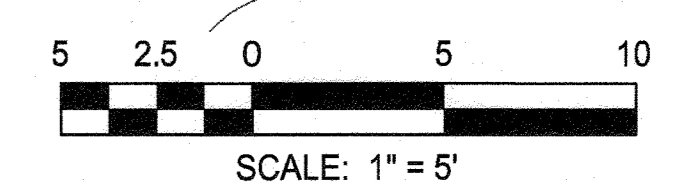

APPROVED: DEPARTMENT OF PLANNING AND ZONING
 Chief, Development Engineering Division
 Date: 12-5-23
 Date: 2/22/24
 Date: 2/23/24



PROFESSIONAL CERTIFICATION: I HEREBY CERTIFY THAT THESE DOCUMENTS WERE PREPARED OR APPROVED BY ME, AND THAT I AM A DULY LICENSED PROFESSIONAL ENGINEER UNDER THE LAWS OF THE STATE OF MARYLAND, LICENSE NO. 4843, EXPIRATION DATE: MAY 31, 2024.



| | | | | | |
|-------------|-----------|------|-----|---|---------|
| DESIGN BY: | SHK | RK&K | 4 | New Sheet - OTA-3 and Borrow Area Modifications | 11/1/23 |
| DRAWN BY: | JMS/DTP | | | | |
| CHECKED BY: | CWWM | | | | |
| DATE: | 11/1/2023 | BY | NO. | REVISION | DATE |

OWNER/DEVELOPER
**JOHNS HOPKINS
 APPLIED PHYSICS LABORATORY**
 11100 JOHNS HOPKINS ROAD
 LAUREL, MARYLAND 20723

SWM LANDSCAPING PLAN - OTA 3 (PHASE 2)
 JOHNS HOPKINS UNIVERSITY - APPLIED PHYSICS LABORATORY
OUTDOOR TESTING AREAS
 11100 JOHNS HOPKINS ROAD
 TAX MAP-41 PARCEL: 123 GRID: 16 ZONED: PEG
 ELECTION DISTRICT 5 - HOWARD COUNTY, MARYLAND
 SHEET 46 OF 73

C-506
 RK&K PROJECT NUMBER
 21047.013
 SCALE:
 As Shown



GENERAL NOTES

1. TOPOGRAPHIC AND SURFACE INFORMATION SHOWN WAS OBTAINED FROM FIELD SURVEY BY RK&K, COMPLETED DECEMBER 23, 2021. UTILITY INFORMATION SHOWN WAS PROVIDED BY AII/DATA ON FEBRUARY 4, 2022.
2. IT IS THE CONTRACTOR'S RESPONSIBILITY TO FIELD VERIFY ACTUAL SITE CONDITIONS PRIOR TO THE START OF ANY WORK. THERE IS NO WARRANTY OR GUARANTEE ON THE COMPLETENESS OR CORRECTNESS OF THE EXISTING CONDITION INFORMATION. ANY DISCREPANCY FOUND SHALL BE BROUGHT TO THE IMMEDIATE ATTENTION OF THE ARCHITECT/ENGINEER PRIOR TO THE START OF ANY WORK.
3. BEARINGS AND HORIZONTAL COORDINATES SHOWN ON THIS PLAN ARE BASED UPON MARYLAND STATE PLANE COORDINATE SYSTEM NAD83. VERTICAL ELEVATIONS SHOWN ARE BASED UPON VERTICAL DATUM NAVD83.
4. THE LOCATION OF EXISTING UNDERGROUND UTILITIES IS SHOWN IN AN APPROXIMATE WAY ONLY, BASED UPON FIELD OBSERVATIONS AND RECORD DOCUMENTS. THEY HAVE NOT BEEN COMPARED TO OR VERIFIED WITH FIELD TEST PITS. THE CONTRACTOR SHALL BE RESPONSIBLE TO VERIFY TO HIS OWN SATISFACTION THE EXACT LOCATION, SIZE AND TYPE OF ALL EXISTING UNDERGROUND UTILITIES BEFORE COMMENCING ANY WORK. THE CONTRACTOR MUST NOTIFY THE UTILITY COMPANIES INVOLVED PRIOR TO THE START OF THE WORK. CONTRACTOR AGREES TO BE FULLY RESPONSIBLE FOR THE COST OF ANY AND ALL DAMAGES WHICH OCCUR AS A RESULT OF A FAILURE TO EXACTLY LOCATE AND PRESERVE ANY AND ALL EXISTING UTILITIES TO REMAIN.
5. THE CONTRACTOR SHALL BE RESPONSIBLE FOR NOTIFYING "MISS UTILITY" AT 1-800-257-7777 FIVE DAYS PRIOR TO THE START OF ANY EXCAVATION WORK.
6. THE CONTRACTOR SHALL VERIFY ALL EXISTING UTILITY INVERTS AND CLEARANCES FROM NEW WORK PRIOR TO START OF ANY WORK.
7. THE CONTRACTOR SHALL STAKE OUT THE LOCATION OF ALL NEW CONSTRUCTION AND VERIFY ALL JURISDICTIONAL SETBACKS AND BUFFERS PRIOR TO START OF ANY WORK.
8. EXISTING UTILITIES WHICH ARE NOT TO BE REMOVED OR ABANDONED SHALL REMAIN OPERATIONAL AT ALL TIMES. APPROPRIATE EXISTING UTILITIES SHALL REMAIN IN SERVICE UNTIL REPLACEMENT/RELOCATED UTILITIES ARE OPERATIONAL.
9. CONTRACTOR SHALL PROVIDE POSITIVE DRAINAGE AWAY FROM ALL EXISTING AND PROPOSED BUILDING ENTRANCES DURING ALL PHASES OF CONSTRUCTION, UNLESS OTHERWISE NOTED IN THESE DOCUMENTS. CONTRACTOR SHALL NOTIFY ENGINEER / OWNER IF EXISTING OR PROPOSED CONDITIONS RESTRICT ABILITY TO ACHIEVE POSITIVE DRAINAGE FROM BUILDINGS PRIOR TO THE START OF CONSTRUCTION.
10. SEE SHEET C-003 FOR FULL EXISTING AND PROPOSED FEATURES LEGEND.


SWM NOTE - BORROW AREA

STORMWATER MANAGEMENT APPROACH FOR THE BORROW AREAS IS REMOVAL OF EXISTING IMPERVIOUS AREA AND COMPLETING LINEAR UTILITY WORK TRENCHING. THERE ARE NO PERMANENT STORMWATER MANAGEMENT STRUCTURES TO BE INSTALLED IN THE BORROW AREA SITES. FOR SWM COMPUTATIONS AND ADDITIONAL INFORMATION SEE THE SWM REPORT.

THERE ARE NO PROPOSED STORMWATER MANAGEMENT FACILITIES TO CONSTRUCT FOR THE EAST BORROW AREA SITE. PLAN PROVIDED FOR AGENCY REVIEW ONLY.

| EAST BORROW AREA SWM COMPUTATIONS | |
|-----------------------------------|------------|
| SITE AREA | 263,170 SF |
| EXISTING IMPERVIOUS AREA | 79,300 SF |
| PROPOSED IMPERVIOUS AREA | 0 SF |
| NET CHANGE IN IMPERVIOUS | -79,300 SF |
| UTILITY TRENCHING | 33,420 SF |

4 PURPOSE STATEMENT (11/1/23): DESIGN OF OUTDOOR TESTING AREA 3, INCLUDING THE SOURCE OF BORROW MATERIAL, REFERRED TO AS THE EAST AND WEST BORROW AREAS.

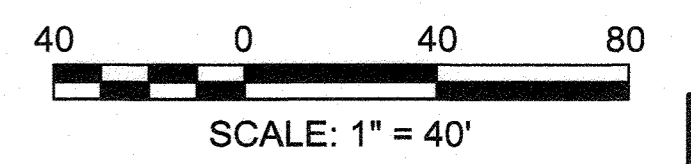


APPROVED: DEPARTMENT OF PLANNING AND ZONING
 Chief, Development Engineering Division
 Chief, Division of Land Development
 Director

Date: 12-5-23
 Date: 2/22/24
 Date: 2/22/24

RK&K
 RUMMEL, KLEPPER & KAHL, LLP
 ENGINEERS, ARCHITECTS, PLANNERS, SCIENTISTS
 RESPONSIVE PEOPLE. CREATIVE SOLUTIONS.
 700 East Pratt Street, Suite 500
 Baltimore, MD 21202
 Ph: 410.726.2900
 www.rk&k.com

PROFESSIONAL CERTIFICATION. I HEREBY CERTIFY THAT THESE DOCUMENTS WERE PREPARED OR APPROVED BY ME, AND THAT I AM A DULY LICENSED PROFESSIONAL ENGINEER UNDER THE LAWS OF THE STATE OF MARYLAND, LICENSE NO. 4842, EXPIRATION DATE: MAY 31, 2024.

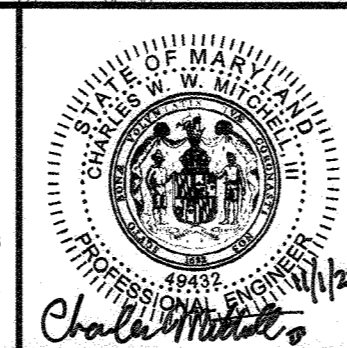

| | | | |
|-------------|---------|----------|-----------|
| DESIGN BY: | SHK | DATE: | 11/1/2023 |
| DRAWN BY: | JMS/DTP | | |
| CHECKED BY: | CWMM | | |
| BY | NO. | REVISION | DATE |
| | | | |

OWNER/DEVELOPER
**JOHNS HOPKINS
 APPLIED PHYSICS LABORATORY**
 11100 JOHNS HOPKINS ROAD
 LAUREL, MARYLAND 20723

**STORMWATER MANAGEMENT PLAN -
 EAST BORROW AREA (PHASE 2)**
 JOHNS HOPKINS UNIVERSITY - APPLIED PHYSICS LABORATORY
OUTDOOR TESTING AREAS

11100 JOHNS HOPKINS ROAD
 TAX MAP: 41 PARCEL: 123 GRID: 16 ZONED: PEC
 ELECTION DISTRICT 5 - HOWARD COUNTY, MARYLAND
 SHEET 47 OF 73

RK&K PROJECT NUMBER: 21047.013
 SCALE: As Shown



GENERAL NOTES

1. TOPOGRAPHIC AND SURFACE INFORMATION SHOWN WAS OBTAINED FROM FIELD SURVEY BY RK&K COMPLETED DECEMBER 23, 2021. UTILITY INFORMATION SHOWN WAS PROVIDED BY AIDATA ON FEBRUARY 4, 2022.
2. IT IS THE CONTRACTOR'S RESPONSIBILITY TO FIELD VERIFY ACTUAL SITE CONDITIONS PRIOR TO THE START OF ANY WORK. THERE IS NO WARRANTY OR GUARANTEE ON THE COMPLETENESS OR CORRECTNESS OF THE EXISTING CONDITION INFORMATION. ANY DISCREPANCY FOUND SHALL BE BROUGHT TO THE IMMEDIATE ATTENTION OF THE ARCHITECT/ENGINEER PRIOR TO THE START OF ANY WORK.
3. BEARINGS AND HORIZONTAL COORDINATES SHOWN ON THIS PLAN ARE BASED UPON MARYLAND STATE PLANE COORDINATE SYSTEM NAD83. VERTICAL ELEVATIONS SHOWN ARE BASED UPON VERTICAL DATUM NAVD83.
4. THE LOCATION OF EXISTING UNDERGROUND UTILITIES IS SHOWN IN AN APPROXIMATE WAY ONLY. BASED UPON FIELD OBSERVATIONS AND RECORD DOCUMENTS. THEY HAVE NOT BEEN COMPARED TO OR VERIFIED WITH FIELD TEST PITS. THE CONTRACTOR SHALL BE RESPONSIBLE TO VERIFY TO HIS OWN SATISFACTION THE EXACT LOCATION, SIZE AND TYPE OF ALL EXISTING UNDERGROUND UTILITIES BEFORE COMMENCING ANY WORK. THE CONTRACTOR MUST NOTIFY THE UTILITY COMPANIES INVOLVED PRIOR TO THE START OF THE WORK. CONTRACTOR AGREES TO BE FULLY RESPONSIBLE FOR THE COST OF ANY AND ALL DAMAGES WHICH OCCUR AS A RESULT OF A FAILURE TO EXACTLY LOCATE AND PRESERVE ANY AND ALL EXISTING UTILITIES TO REMAIN.
5. THE CONTRACTOR SHALL BE RESPONSIBLE FOR NOTIFYING "MISS UTILITY" AT 1-800-257-7777 FIVE DAYS PRIOR TO THE START OF ANY EXCAVATION WORK.
6. THE CONTRACTOR SHALL VERIFY ALL EXISTING UTILITY INVERTS AND CLEARANCES FROM NEW WORK PRIOR TO START OF ANY WORK.
7. THE CONTRACTOR SHALL STAKE OUT THE LOCATION OF ALL NEW CONSTRUCTION AND VERIFY ALL JURISDICTIONAL SETBACKS AND BUFFERS PRIOR TO START OF ANY WORK.
8. EXISTING UTILITIES WHICH ARE NOT TO BE REMOVED OR ABANDONED SHALL REMAIN OPERATIONAL AT ALL TIMES. APPROPRIATE EXISTING UTILITIES SHALL REMAIN IN SERVICE UNTIL REPLACEMENT/RELOCATED UTILITIES ARE OPERATIONAL.
9. CONTRACTOR SHALL PROVIDE POSITIVE DRAINAGE AWAY FROM ALL EXISTING AND PROPOSED BUILDING ENTRANCES DURING ALL PHASES OF CONSTRUCTION. UNLESS OTHERWISE NOTED IN THESE DOCUMENTS, CONTRACTOR SHALL NOTIFY ENGINEER / OWNER IF EXISTING OR PROPOSED CONDITIONS RESTRICT ABILITY TO ACHIEVE POSITIVE DRAINAGE FROM BUILDINGS PRIOR TO THE START OF CONSTRUCTION.
10. SEE SHEET C-003 FOR FULL EXISTING AND PROPOSED FEATURES LEGEND.


SWM NOTE - BORROW AREA

STORMWATER MANAGEMENT APPROACH FOR THE BORROW AREAS IS REMOVAL OF EXISTING IMPERVIOUS AREA AND COMPLETING LINEAR UTILITY WORK TRENCHING. THERE ARE NO PERMANENT STORMWATER MANAGEMENT STRUCTURES TO BE INSTALLED IN THE BORROW AREA SITES. FOR SWM COMPUTATIONS AND ADDITIONAL INFORMATION SEE THE SWM REPORT.

THERE ARE NO PROPOSED STORMWATER MANAGEMENT FACILITIES TO CONSTRUCT FOR THE EAST BORROW AREA SITE. PLAN PROVIDED FOR AGENCY REVIEW ONLY.

| WEST BORROW AREA SWM COMPUTATIONS | |
|-----------------------------------|------------|
| SITE AREA | 116,760 SF |
| EXISTING IMPERVIOUS AREA | 4,200 SF |
| PROPOSED IMPERVIOUS AREA | 0 SF |
| NET CHANGE IN IMPERVIOUS | -4,200 SF |


▲ PURPOSE STATEMENT (11/1/23): DESIGN OF OUTDOOR TESTING AREA 3, INCLUDING THE SOURCE OF BORROW MATERIAL, REFERRED TO AS THE EAST AND WEST BORROW AREAS.

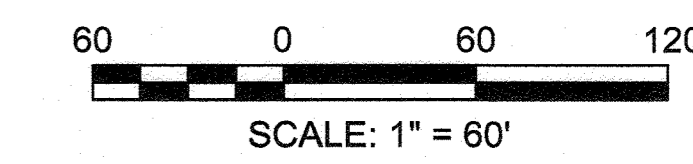

APPROVED: DEPARTMENT OF PLANNING AND ZONING
 Chief, Development Engineering Division
 Date: 12-5-23
 Chief, Division of Land Development
 Date: 2/22/24
 Director
 Date: 2/22/24



PROFESSIONAL CERTIFICATION: I HEREBY CERTIFY THAT THESE DOCUMENTS WERE PREPARED OR APPROVED BY ME, AND THAT I AM A DULY LICENSED PROFESSIONAL ENGINEER UNDER THE LAWS OF THE STATE OF MARYLAND, LICENSE NO. 4942, EXPIRATION DATE: MAY 31, 2024.

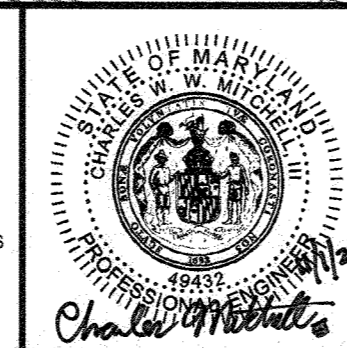


| | | |
|-------------|-----------|-----------|
| DESIGN BY: | SHK | 11/1/2023 |
| DRAWN BY: | JMS/DTP | |
| CHECKED BY: | CWMM | |
| DATE: | 11/1/2023 | |
| BY | NO. | REVISION |
| | | DATE |

OWNER/DEVELOPER
 JOHNS HOPKINS
 APPLIED PHYSICS LABORATORY
 11100 JOHNS HOPKINS ROAD
 LAUREL, MARYLAND 20723

STORMWATER MANAGEMENT PLAN - WEST BORROW AREA (PHASE 2)
 JOHNS HOPKINS UNIVERSITY - APPLIED PHYSICS LABORATORY
OUTDOOR TESTING AREAS
 11100 JOHNS HOPKINS ROAD
 TAX MAP: 41 PARCEL: 123 GRID: 16 ZONED: PEC
 ELECTION DISTRICT 3 - HOWARD COUNTY, MARYLAND
 SHEET 48 OF 73

C-582
 RK&K PROJECT NUMBER 21047.013
 SCALE: As Shown

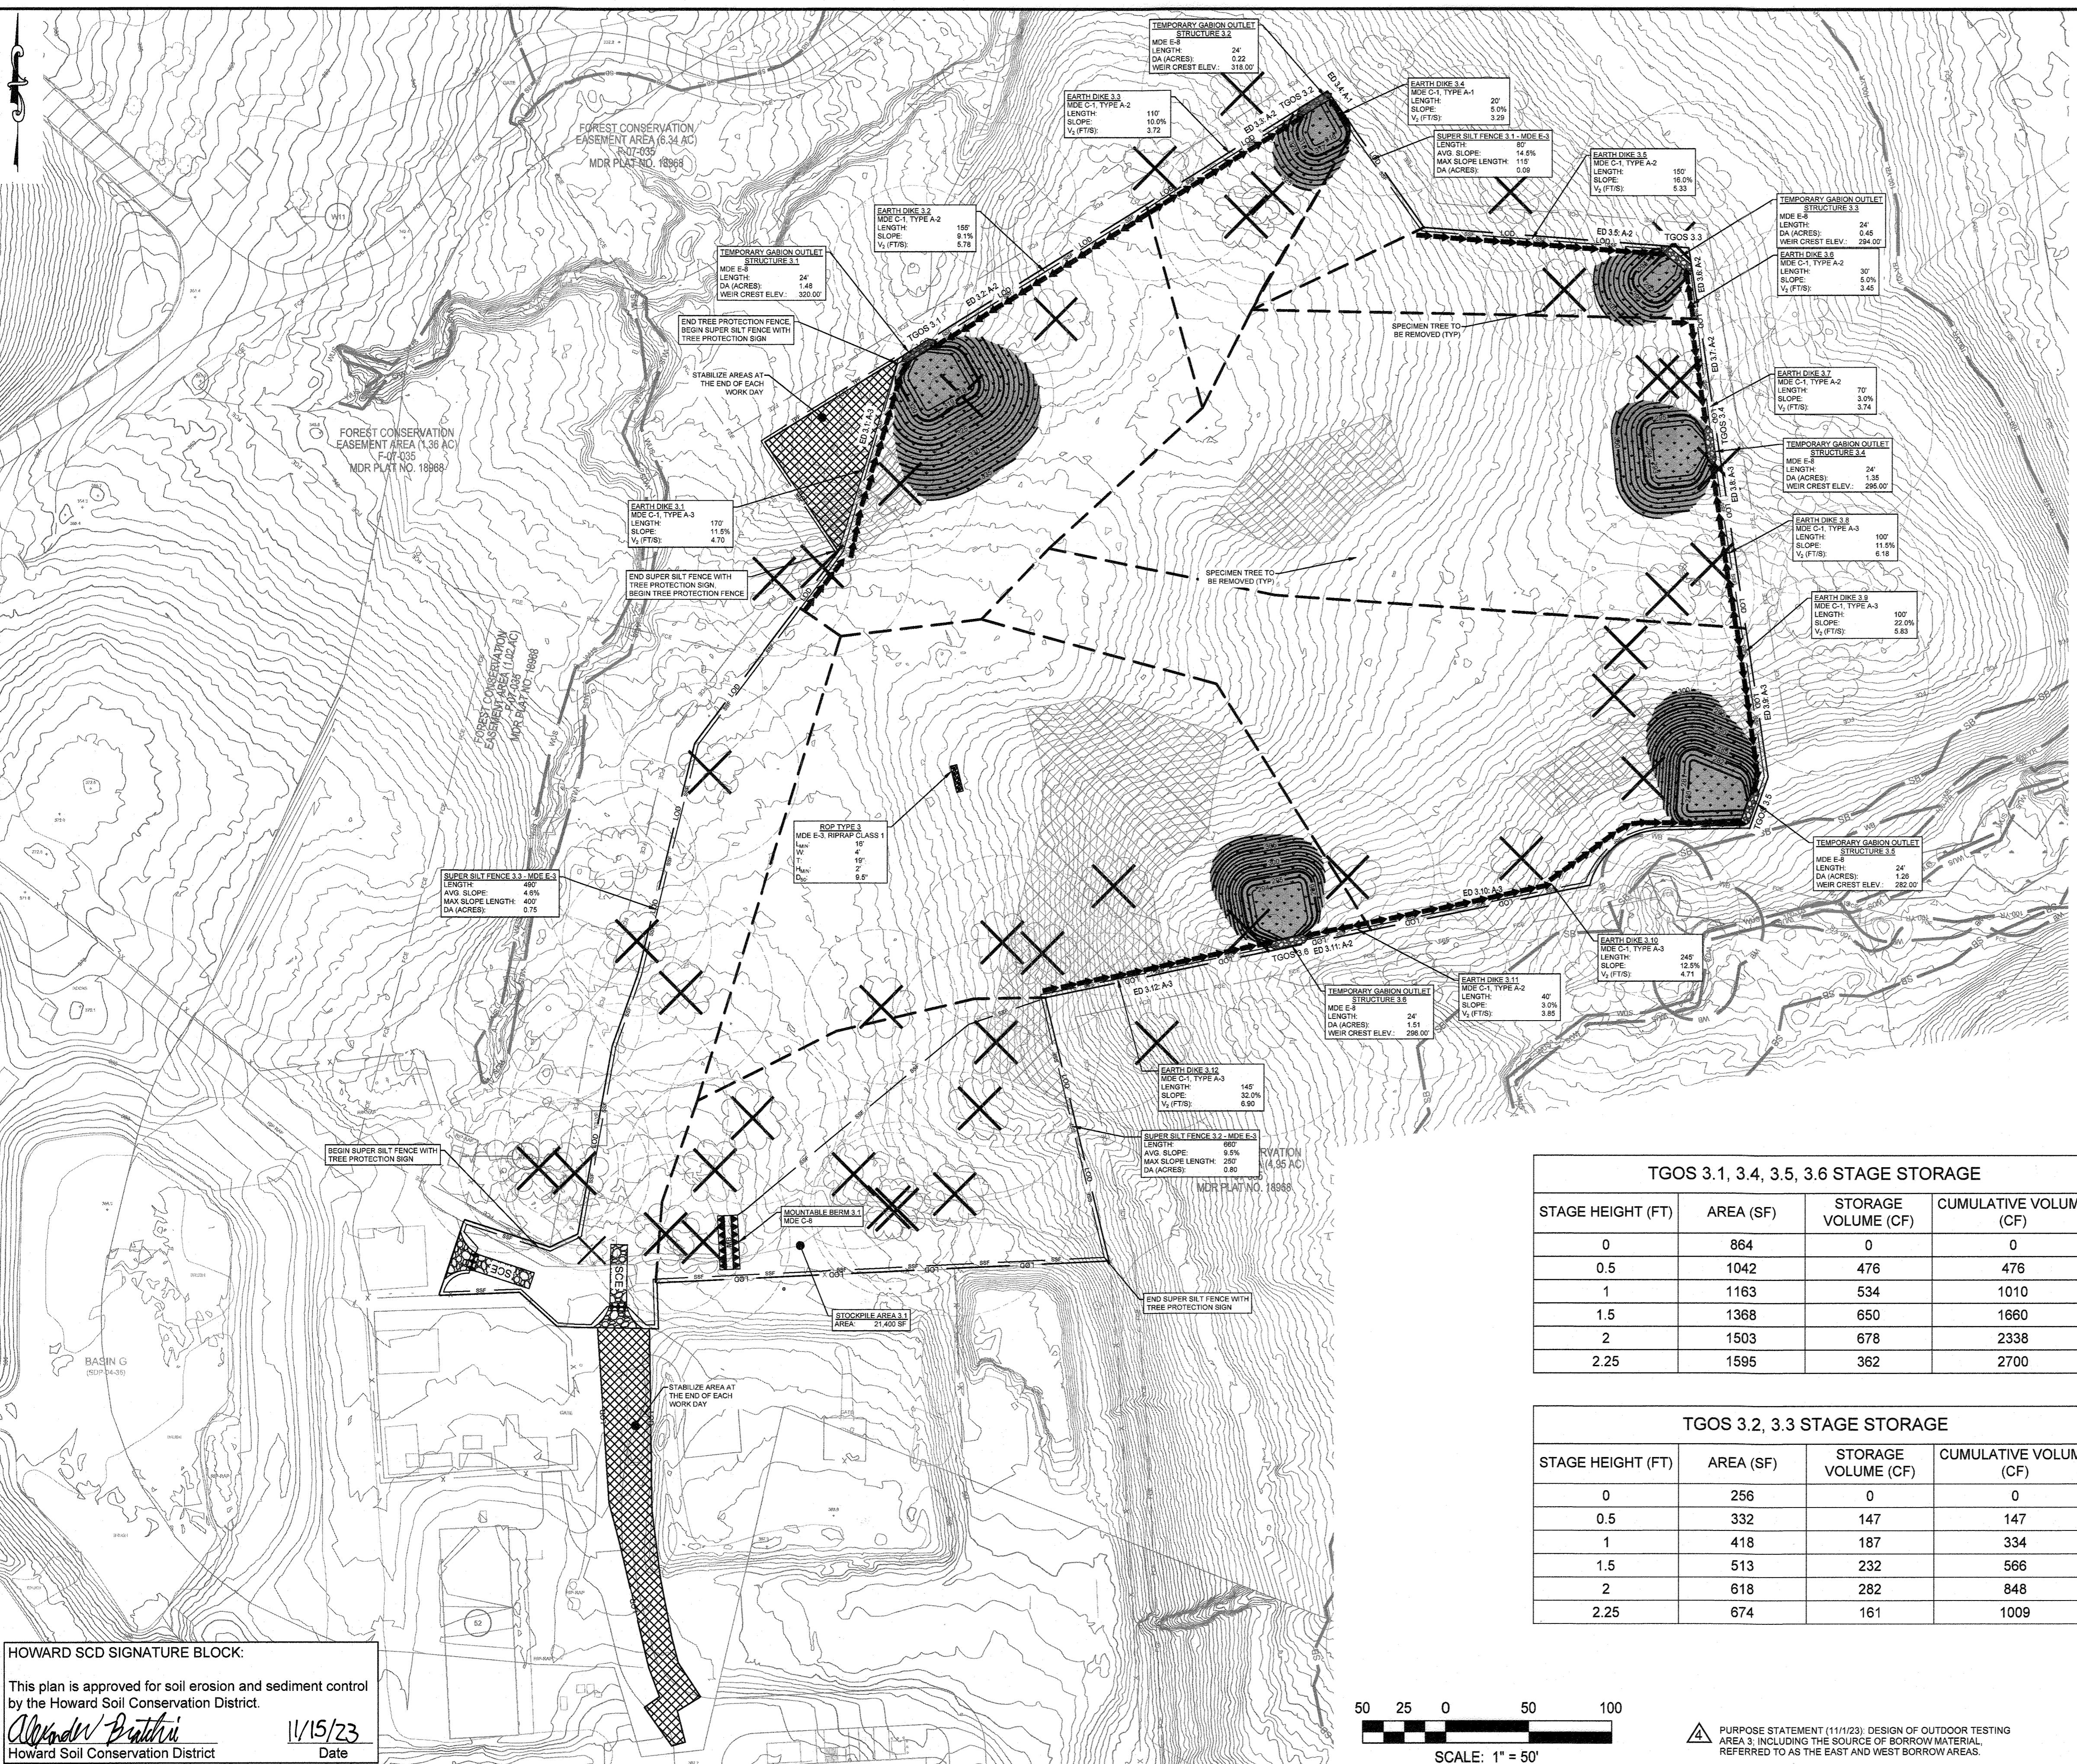

NOTES

1. THE TOPOGRAPHIC INFORMATION SHOWN HEREON, WAS OBTAINED FROM AN AERIAL SURVEY FLOWN BY AXIS GEOSPATIAL ON APRIL 6, 2014 AND PROVIDED TO RK&K IN AUGUST OF 2017. THE UTILITY INFORMATION WAS PROVIDED ELECTRONICALLY TO RK&K BY JHU APL IN AUGUST OF 2017. TOPOGRAPHIC AND UTILITY INFORMATION MAY NOT REFLECT CURRENT CONDITIONS. IT IS THE CONTRACTOR'S RESPONSIBILITY TO FIELD VERIFY ACTUAL SITE CONDITIONS PRIOR TO THE START OF ANY WORK. THERE IS NO WARRANTY OR GUARANTEE ON THE COMPLETENESS OR CORRECTNESS OF THE EXISTING CONDITION INFORMATION. ANY DISCREPANCY FOUND SHALL BE BROUGHT TO THE IMMEDIATE ATTENTION OF THE ENGINEER PRIOR TO THE START OF ANY WORK.
2. BEARINGS, COORDINATES AND ELEVATIONS SHOWN ON THIS PLAN ARE SHOWN IN MARYLAND STATE PLANE. ALL VERTICAL CONTROLS ARE BASED ON NAVD 88.
3. FOR GENERAL NOTES, SEE THE COVER SHEET.
4. FOR ADDITIONAL EROSION AND SEDIMENT CONTROL NOTES, SEE SHEET C-609.

LEGEND

- LOD — LOD — LIMIT OF DISTURBANCE / PROPOSED TREELINE
- TP — TP — TREE PROTECTION FENCE
- - - - - DRAINAGE AREA
- STABILIZED CONSTRUCTION ENTRANCE, W/ WASH RACK
- SF — SF — SUPER SILT FENCE
- DF — DF — DIVERSION FENCE
- SAME DAY STABILIZATION
- STEEP SLOPES (>20%), LESS THAN 20,000 CONTINUOUS SF
- DIVERSION DIKE
- TEMPORARY GABION OUTLET STRUCTURE
- TEMPORARY INTERIM GRADING FOR STAGE STORAGE
- MOUNTABLE BERM
- SPECIMEN TREE TO BE REMOVED*
- TEMPORARY SOIL STABILIZATION MATTING SLOPE APPLICATION (DETAIL B-4-6-B)

*ONLY SPECIMEN TREES WITHIN 50' OF THE LIMITS OF DISTURBANCE HAVE BEEN SURVEYED TO ENSURE THAT ALL SPECIMEN TREES WITHIN THE FOREST CONSERVATION EASEMENT ARE PRESERVED. SPECIMEN TREE REMOVAL HAS BEEN IDENTIFIED FOR SURVEYED TREES. ALL OTHER TREES WITHIN THE LIMIT OF DISTURBANCE SHALL BE REMOVED AS REQUIRED, INCLUDING SPECIMEN TREES.

SEQUENCE OF CONSTRUCTION: PHASE 2A


1. CLEAR AS NECESSARY FOR INSTALLATION OF THE SEDIMENT CONTROL DEVICES AND MEASURES AS SHOWN ON THE PLAN OR AS DIRECTED BY THE SEDIMENT CONTROL INSPECTOR. 5 DAYS
2. INSTALL STABILIZED CONSTRUCTION ENTRANCES. EXISTING PAVEMENT MUST BE REMOVED PRIOR TO PLACEMENT OF SCE. 2 DAYS
3. INSTALL PHASE 2A EROSION AND SEDIMENT CONTROL MEASURES AS SHOWN ON PLAN VIEW: EARTH DIKES ED-1.1 THRU ED-1.12, SUPER SILT FENCE SSF-3.1 THRU SSF-3.3, STOCKPILE AREA 3.1, MOUNTABLE BERM 3.1, AND TEMPORARY GABION OUTLET STRUCTURE TGOS-3.1 THRU TGOS-3.6. 5 DAYS
4. ONCE ALL PHASE 2A AREAS ARE PERMANENTLY STABILIZED AND WITH APPROVAL OF THE SEDIMENT CONTROL INSPECTOR, PROCEED TO PHASE 2B (SHEET C-606). 2 DAYS

TGOS 3.1, 3.4, 3.5, 3.6 STAGE STORAGE

| STAGE HEIGHT (FT) | AREA (SF) | STORAGE VOLUME (CF) | CUMULATIVE VOLUME (CF) |
|-------------------|-----------|---------------------|------------------------|
| 0 | 864 | 0 | 0 |
| 0.5 | 1042 | 476 | 476 |
| 1 | 1163 | 534 | 1010 |
| 1.5 | 1368 | 650 | 1660 |
| 2 | 1503 | 678 | 2338 |
| 2.25 | 1595 | 362 | 2700 |

TGOS 3.2, 3.3 STAGE STORAGE

| STAGE HEIGHT (FT) | AREA (SF) | STORAGE VOLUME (CF) | CUMULATIVE VOLUME (CF) |
|-------------------|-----------|---------------------|------------------------|
| 0 | 256 | 0 | 0 |
| 0.5 | 332 | 147 | 147 |
| 1 | 418 | 187 | 334 |
| 1.5 | 513 | 232 | 566 |
| 2 | 618 | 282 | 848 |
| 2.25 | 674 | 161 | 1009 |

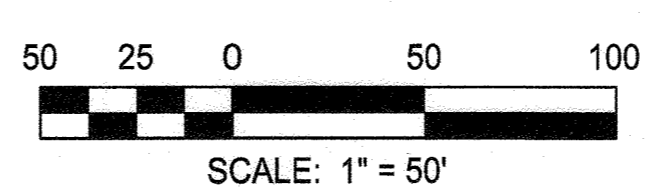

▲ PURPOSE STATEMENT (11/1/23): DESIGN OF OUTDOOR TESTING AREA 3, INCLUDING THE SOURCE OF BORROW MATERIAL, REFERRED TO AS THE EAST AND WEST BORROW AREAS.

HOWARD SCD SIGNATURE BLOCK:
 This plan is approved for soil erosion and sediment control by the Howard Soil Conservation District.

 Alexander Pruthi
 Howard Soil Conservation District
 11/15/23
 Date

APPROVED: DEPARTMENT OF PLANNING AND ZONING
 Chief, Development Engineering Division
 Chief, Division of Land Development
 Director
 12.5.23
 Date
 2/28/24
 Date
 2/28/24
 Date

RK&K
 RUMMEL, KLEPPER & KAHL, LLP
 ENGINEERS/CONSTRUCTION MANAGERS/PLANNERS/SCIENTISTS
 RESPONSIVE PEOPLE • CREATIVE SOLUTIONS
 700 East Pratt Street, Suite 500
 Baltimore, MD 21202
 Ph: 410.726.2900 Fax: 410.726.2901
 www.rk&k.com

PROFESSIONAL CERTIFICATION. I HEREBY CERTIFY THAT THESE DOCUMENTS WERE PREPARED OR APPROVED BY ME, AND THAT I AM A DULY LICENSED PROFESSIONAL ENGINEER UNDER THE LAWS OF THE STATE OF MARYLAND. LICENSE NO. 49432, EXPIRATION DATE: MAY 31, 2024.




| | | | | | |
|----------------------|--------------------|----|-----|----------|------|
| DESIGN BY: SHK | DATE: 11/1/2023 | BY | NO. | REVISION | DATE |
| DRAWN BY: JMS/DTP | | | | | |
| CHECKED BY: CWWMM | | | | | |
| DATE: 11/1/2023 | | | | | |

OWNER/DEVELOPER
JOHNS HOPKINS APPLIED PHYSICS LABORATORY
 11100 JOHNS HOPKINS ROAD
 LAUREL, MARYLAND 20723

EROSION SEDIMENT CONTROL PLAN - OTA 3
 (ESC PHASE 2A)
 JOHNS HOPKINS UNIVERSITY - APPLIED PHYSICS LABORATORY
OUTDOOR TESTING AREAS
 11100 JOHNS HOPKINS ROAD
 TAX MAP: 41 PARCEL: 123 GRID: 16 ZONED: PEC
 ELECTION DISTRICT 5 - HOWARD COUNTY, MARYLAND
 SHEET 51 OF 73

C-605
 RK&K PROJECT NUMBER
 21047.013
 SCALE:
 As Shown
 SDP-18-060

DETAIL D-3-1 RIPRAP INFLOW PROTECTION

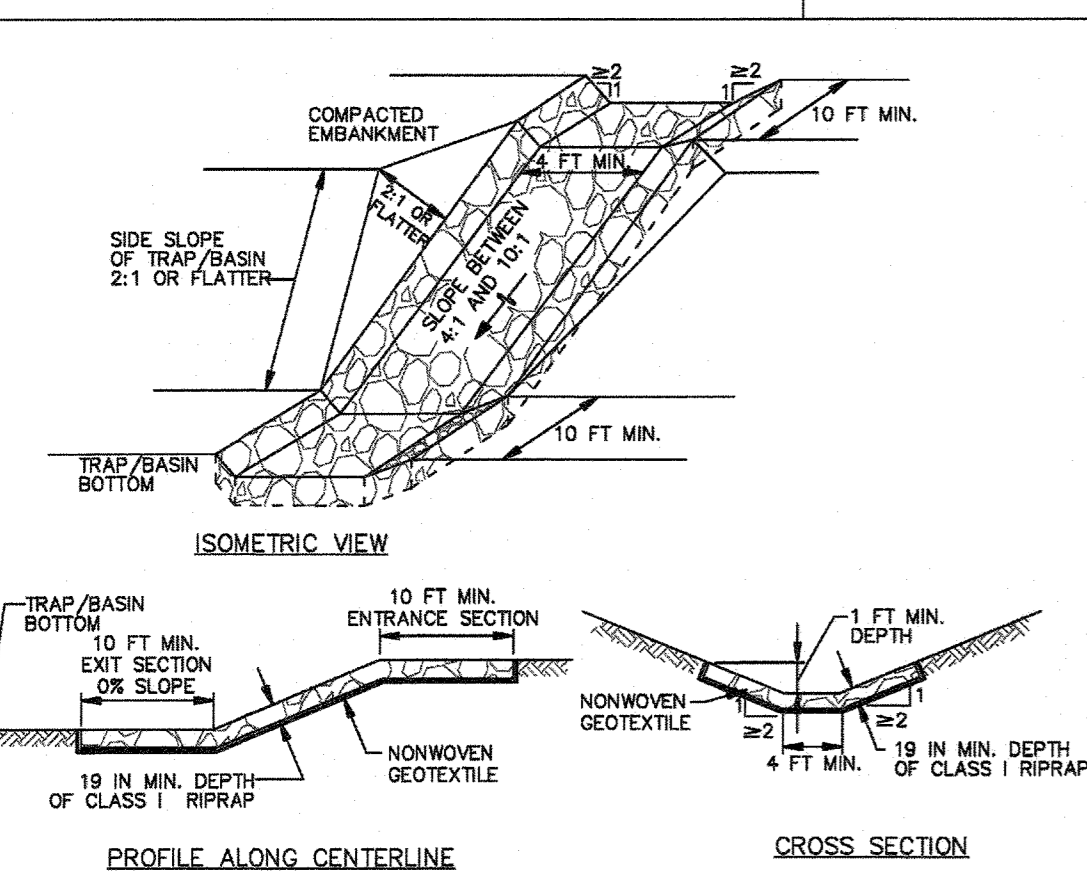

- CONSTRUCTION SPECIFICATIONS**
1. PROVIDE NONWOVEN GEOTEXTILE, AS SPECIFIED IN SECTION H-1 MATERIALS, UNDER THE BOTTOM AND ALONG SIDES OF ALL RIPRAP.
 2. CONSTRUCT INFLOW CHANNEL WITH CLASS 1 RIPRAP OR EQUIVALENT RECYCLED CONCRETE LINING TO A MINIMUM DEPTH OF 19 INCHES (2' x D₅₀) AND A 1 FOOT DEEP FLOW CHANNEL. INFLOW RIPRAP PROTECTION CHANNEL MUST HAVE A TRAPEZOIDAL CROSS SECTION WITH 2:1 OR FLATTER SIDE SLOPES AND A 4 FOOT MINIMUM BOTTOM WIDTH.
 3. INSTALL ENTRANCE AND EXIT SECTIONS AS SHOWN ON THE PROFILE.
 4. BLEND RIPRAP INTO EXISTING GROUND.
 5. MAINTAIN LINE, GRADE, AND CROSS SECTION. REMOVE ACCUMULATED SEDIMENT AND DEBRIS. KEEP POINTS OF INFLOW AND OUTFLOW FREE OF EROSION.

MARYLAND STANDARDS AND SPECIFICATIONS FOR SOIL EROSION AND SEDIMENT CONTROL
 U.S. DEPARTMENT OF AGRICULTURE NATURAL RESOURCES CONSERVATION SERVICE 2011 MARYLAND DEPARTMENT OF ENVIRONMENT WATER MANAGEMENT ADMINISTRATION


NOTES

1. THE TOPOGRAPHIC INFORMATION SHOWN HEREON, WAS OBTAINED FROM AN AERIAL SURVEY FLOWN BY AXIS GEOSPATIAL ON APRIL 6, 2014 AND PROVIDED TO RK&K IN AUGUST OF 2017. THE UTILITY INFORMATION WAS PROVIDED ELECTRONICALLY TO RK&K BY JHU APL IN AUGUST OF 2017. TOPOGRAPHIC AND UTILITY INFORMATION MAY NOT REFLECT CURRENT CONDITIONS. IT IS THE CONTRACTOR'S RESPONSIBILITY TO FIELD VERIFY ACTUAL SITE CONDITIONS PRIOR TO THE START OF ANY WORK. THERE IS NO WARRANTY OR GUARANTEE ON THE COMPLETENESS OR CORRECTNESS OF THE EXISTING CONDITION INFORMATION. ANY DISCREPANCY FOUND SHALL BE BROUGHT TO THE IMMEDIATE ATTENTION OF THE ENGINEER PRIOR TO THE START OF ANY WORK.
2. BEARINGS, COORDINATES AND ELEVATIONS SHOWN ON THIS PLAN ARE SHOWN IN MARYLAND STATE PLANE. ALL VERTICAL CONTROLS ARE BASED ON NAVD 88.
3. FOR GENERAL NOTES, SEE THE COVER SHEET.
4. FOR ADDITIONAL EROSION AND SEDIMENT CONTROL NOTES, SEE SHEET C-609.

SEQUENCE OF CONSTRUCTION: PHASE 2B

1. COMPLETE SEQUENCE OF CONSTRUCTION - PHASE 2A (SHEET C-605). 14 DAYS
2. LEAVE IN PLACE THE REMAINING PHASE 2A EROSION AND SEDIMENT CONTROL DEVICES SUCH AS CONSTRUCTION ENTRANCES, STABILIZED CONSTRUCTION ENTRANCE, SUPER SILT AND DIVERSION FENCES, EARTH DIKES, AND TEMPORARY GABION OUTFLET STRUCTURE. INSTALL PROPOSED PERMANENT SECURITY FENCING. 3 DAYS
3. CONSTRUCT PROPOSED RETAINING WALL, AND ALL ASSOCIATED SITE GRADING. 30 DAYS
4. FOR MASS GRADING, EXCESS CUT FROM THE BORROW AREAS TO BE INSTALLED AS FILL FOR THIS SITE. 10 DAYS
5. IN HATCHED AREAS, INSTALL SHOWN UTILITY SERVICES, AND STABILIZE AREAS AT THE END OF EACH WORK DAY. 30 DAYS
6. INSTALL ADDITIONAL PHASE 2 EROSION AND SEDIMENT CONTROL MEASURES: SIP-3.1 AND GABION INLET PROTECTION GIP-3.1 AND GIP-3.2. 2 DAYS
7. INSTALL PROPOSED ROAD AND OTHER SITE FEATURES. 7 DAYS
8. ONCE ALL PHASE 2B AREAS ARE PERMANENTLY STABILIZED AND WITH APPROVAL OF THE SEDIMENT CONTROL INSPECTOR, REMOVE ALL SEDIMENT CONTROLS. PROVIDE PERMANENT STABILIZATION TO THOSE AREAS DISTURBED BY THIS OPERATION. 2 DAYS


LEGEND

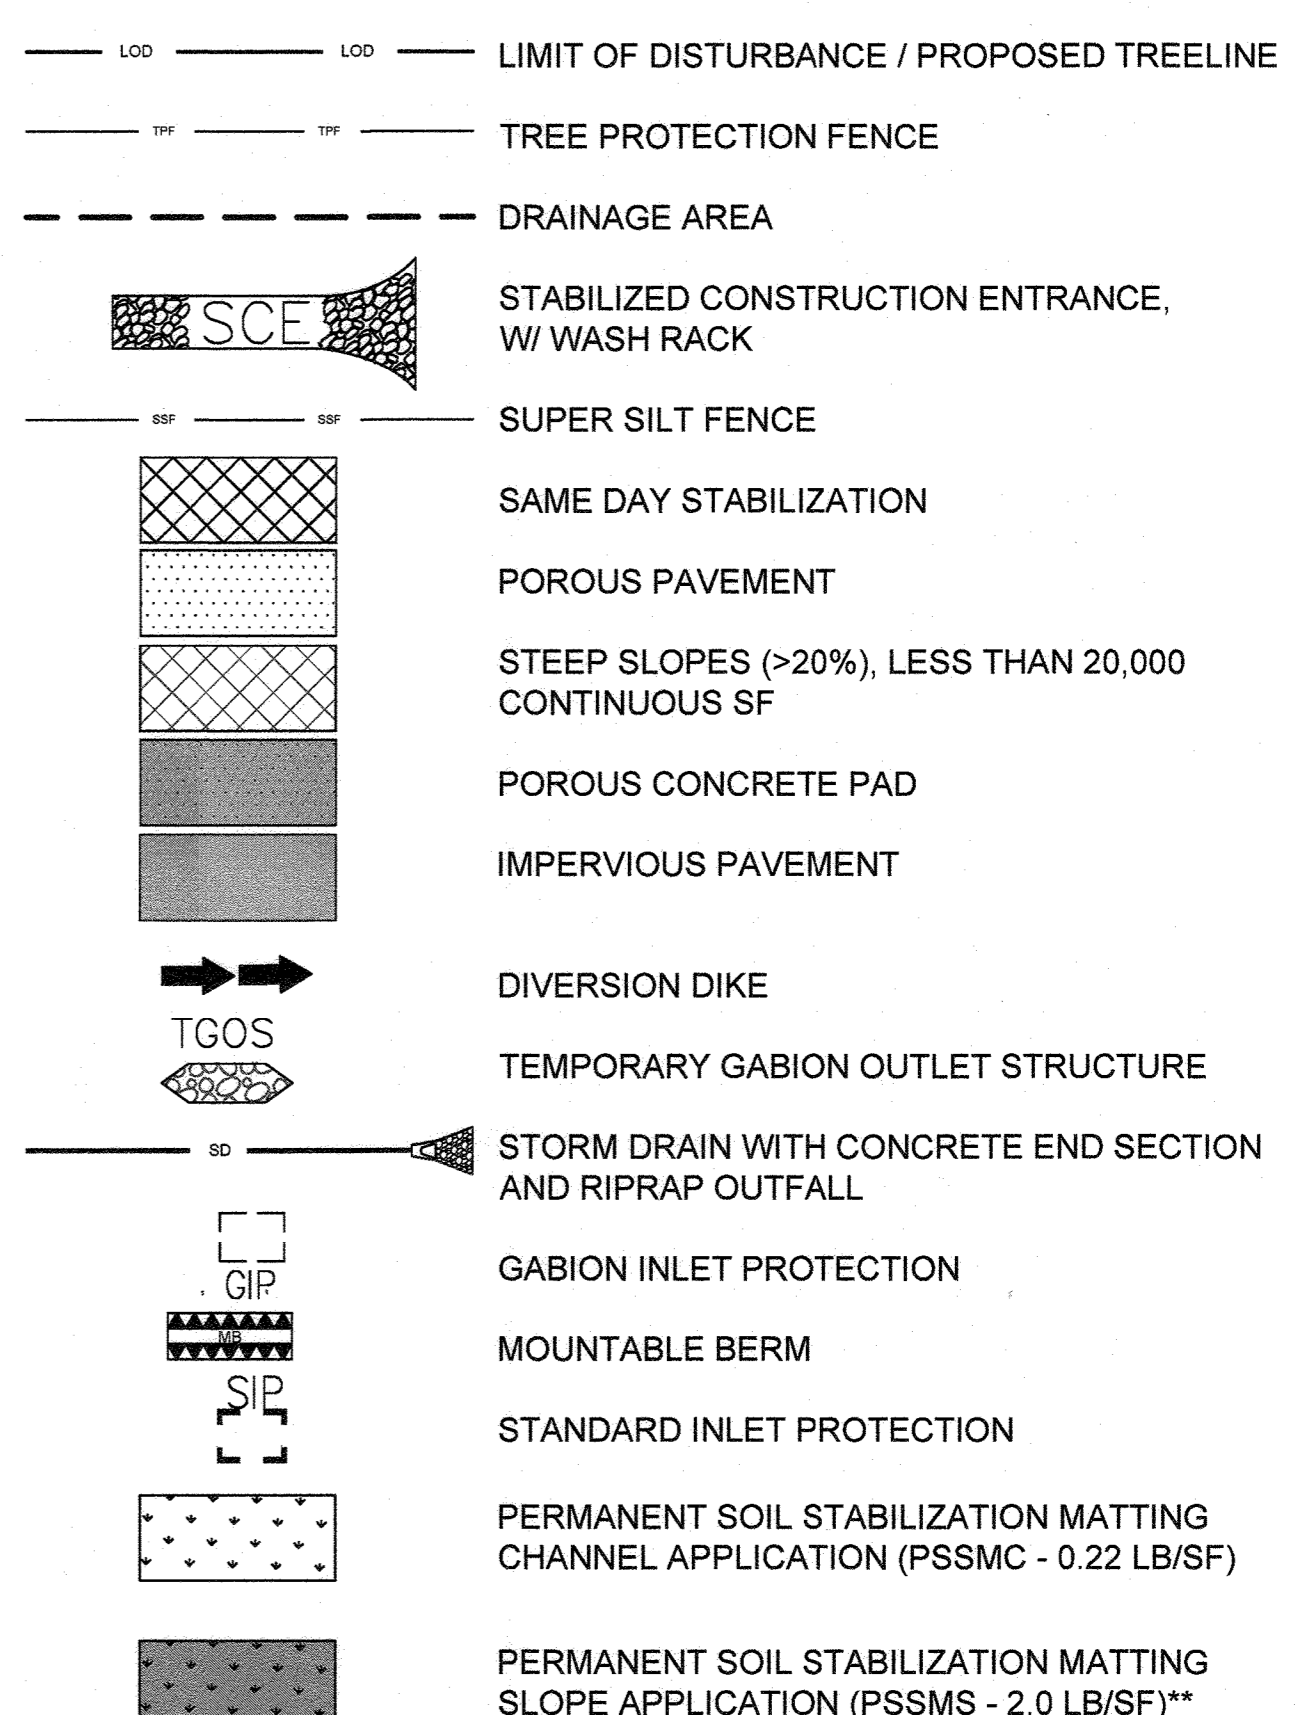

*ONLY SPECIMEN TREES WITHIN 50' OF THE LIMITS OF DISTURBANCE HAVE BEEN SURVEYED TO ENSURE THAT ALL SPECIMEN TREES WITHIN THE FOREST CONSERVATION EASEMENT ARE PRESERVED. SPECIMEN TREE REMOVAL HAS BEEN IDENTIFIED FOR SURVEYED TREES. ALL OTHER TREES WITHIN THE LIMIT OF DISTURBANCE SHALL BE REMOVED AS REQUIRED, INCLUDING SPECIMEN TREES.
 **SINCE THE STEEPEST SLOPE IS 2:1 WITH A SLOPE LENGTH LESS THAN 30 FT, TEMPORARY MATTING WITH DESIGN SHEAR STRESS ≥ 2.0 LB/SF IS REQUIRED PER TABLE B.7 OF 2011 MD STANDARDS AND SPECIFICATIONS FOR SOIL EROSION & SEDIMENT CONTROL

C:\Users\DPILAC-1\AppData\Local\Temp\AcPublish_25928\C-606 Erosion Sediment Control Plan - OTA-3 (ESC Phase 2B).dwg Nov 01, 2023 10:56am dpilactowski

APL 1092

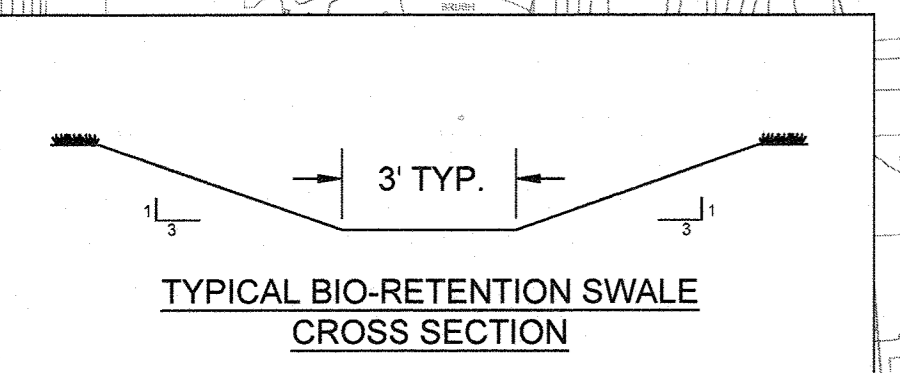


HOWARD SCD SIGNATURE BLOCK:
 This plan is approved for soil erosion and sediment control by the Howard Soil Conservation District.
 Alexander Butcher, 11/15/23, Date
 Howard Soil Conservation District

APPROVED, DEPARTMENT OF PLANNING AND ZONING
 Chief, Development Engineering Division, 12-5-23, Date
 Chief, Division of Land Development, 2/2/24, Date
 Director, 2/2/24, Date

RK&K
 RUMMEL, KLEPPER & KAHL, LLP
 ENGINEERS/CONSTRUCTORS/PLANNERS/SCIENTISTS
 RESPONSIVE PEOPLE • CREATIVE SOLUTIONS
 700 East Pratt Street, Suite 500
 Baltimore, MD 21202
 Ph: 410.726.2900 Fax: 410.726.2901
 www.rk-k.com

PROFESSIONAL CERTIFICATION. I HEREBY CERTIFY THAT THESE DOCUMENTS WERE PREPARED OR APPROVED BY ME AND THAT I AM A DULY LICENSED PROFESSIONAL ENGINEER UNDER THE LAWS OF THE STATE OF MARYLAND. LICENSE NO. 49432, EXPIRATION DATE: MAY 31, 2024.

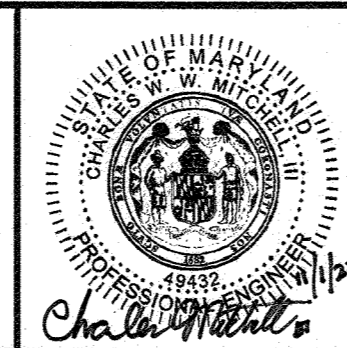


| | | |
|-------------|-----------|--|
| DESIGN BY: | SHK | New Sheet - OTA-3 and Borrow Area Modifications 11/1/23 |
| DRAWN BY: | JMS/DTP | |
| CHECKED BY: | CWMM | |
| DATE: | 11/1/2023 | |
| BY NO. | | |
| REVISION | | DATE |

OWNER/DEVELOPER
 JOHNS HOPKINS APPLIED PHYSICS LABORATORY
 11100 JOHNS HOPKINS ROAD
 LAUREL, MARYLAND 20723

EROSION SEDIMENT CONTROL PLAN - OTA 3 (ESC PHASE 2B)
 JOHNS HOPKINS UNIVERSITY - APPLIED PHYSICS LABORATORY
OUTDOOR TESTING AREAS
 11100 JOHNS HOPKINS ROAD
 TAX MAP: 41 PARCEL: 12 GRID: 16 ZONED: PEC
 ELECTION DISTRICT 5 - HOWARD COUNTY, MARYLAND
 SHEET 52 OF 73


C-606
 RK&K PROJECT NUMBER 21047.013
 SCALE: As Shown
 SDP-18-060

DETAIL B-4-C PERMANENT SOIL STABILIZATION MATTING CHANNEL APPLICATION

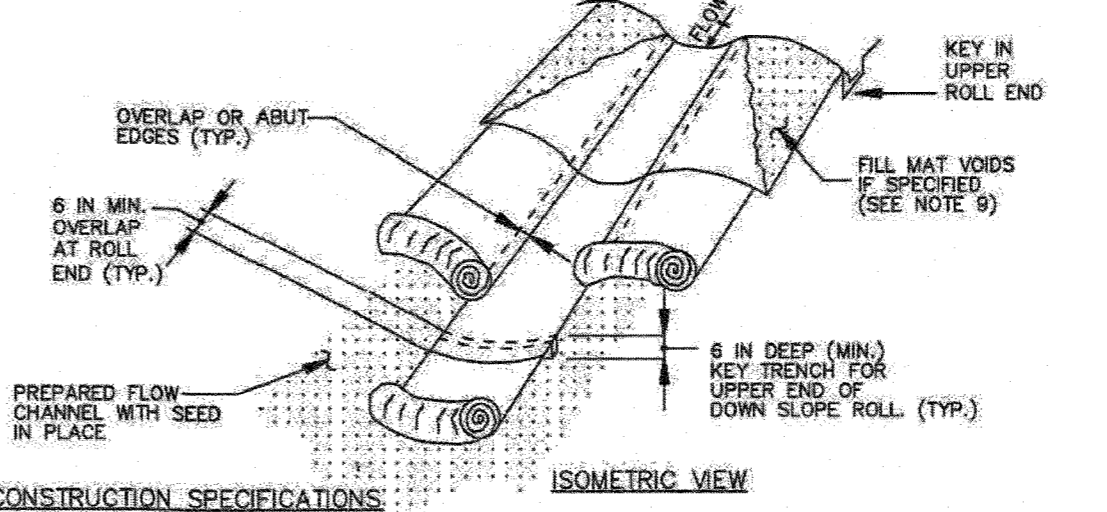

- CONSTRUCTION SPECIFICATIONS:**
1. USE MATTING THAT HAS A DESIGN VALUE FOR SHEAR STRESS EQUAL TO OR HIGHER THAN THE SHEAR STRESS DESIGNATED ON APPROVED PLANS.
 2. USE PERMANENT SOIL STABILIZATION MATTING MADE OF OPEN WEAVE SYNTHETIC, NON-DEGRADABLE FIBERS OR ELEMENTS OF UNIFORM THICKNESS AND DISTRIBUTION THROUGHOUT. CHEMICALS USED IN THE MAT MUST BE NON-LEACHING AND NON-TOXIC TO VEGETATION AND SOIL GERMINATION AND NON-HAZARDOUS TO THE SKIN. IF PRESENT, NETTING MUST BE EXTRUDED PLASTIC WITH A MAXIMUM MESH OPENING OF 2/32 INCHES AND SUFFICIENTLY BONDED OR SEWN ON 2 INCH CENTERS ALONG LONGITUDINAL AXIS OF THE MATERIAL TO PREVENT SEPARATION OF THE NET FROM THE PARENT MATERIAL.
 3. SECURE MATTING USING STEEL STAPLES OR WOOD STAKES. STAPLES MUST BE "U" OR "T" SHAPED STEEL WIRE HAVING A MINIMUM GAUGE OF NO. 11 AND NO. 8 RESPECTIVELY. "U" SHAPED STAPLES MUST AVERAGE 1 TO 1 1/2 INCHES WIDE AND BE A MINIMUM OF 6 INCHES LONG. "T" SHAPED STAPLES MUST HAVE A MINIMUM 8 INCH MAIN LEG, A MINIMUM 1 INCH SECONDARY LEG, AND MINIMUM 4 INCH HEAD. WOOD STAKES MUST BE ROUGH-SAWN HARDWOOD, 12 TO 24 INCHES IN LENGTH, 1 1/2 INCH IN CROSS SECTION, AND WEDGE SHAPED AT THE BOTTOM.
 4. PERFORM FINAL GRADING, TOPSOIL APPLICATION, SEEDING PREPARATION, AND PERMANENT SEEDING IN ACCORDANCE WITH SPECIFICATIONS. PLACE MATTING WITHIN 48 HOURS OF COMPLETING SEEDING OPERATIONS, UNLESS END OF WORKDAY STABILIZATION IS SPECIFIED ON THE APPROVED EROSION AND SEDIMENT CONTROL PLAN.
 5. UNROLL MATTING IN DIRECTION OF WATER FLOW, CENTERING THE FIRST ROLL ON THE CHANNEL CENTER LINE. WORK FROM CENTER OF CHANNEL OUTWARD WHEN PLACING ROLLS. LAY MATTING SMOOTHLY AND FIRMLY UPON THE SEEDING SURFACE. AVOID STRETCHING THE MATTING.
 6. OVERLAP OR ADJUT EDGES OF MATTING ROLLS PER MANUFACTURER RECOMMENDATIONS. OVERLAP ROLL ENDS BY 6 INCHES (MINIMUM), WITH THE UPSTREAM MAT OVERLAPPING ON TOP OF THE NEXT DOWNSTREAM MAT.
 7. KEY IN THE TOP OF SLOPE END OF MAT 6 INCHES (MINIMUM) BY DIGGING A TRENCH, PLACING THE MATTING ROLL END IN THE TRENCH, STAPLING THE MAT IN PLACE, REPLACING THE EXCAVATED MATERIAL, AND TAMPING TO SECURE THE MAT END IN THE KEY.
 8. STAPLE/STAKE MAT IN A STAGGERED PATTERN ON 4 FOOT (MAXIMUM) CENTERS THROUGHOUT AND 2 FOOT (MAXIMUM) CENTERS ALONG SEAMS, JOINTS, AND ROLL ENDS.
 9. IF SPECIFIED BY THE DESIGNER OR MANUFACTURER AND DEPENDING ON THE TYPE OF MAT BEING INSTALLED, ONCE THE MATTING IS KEYED AND STAPLED IN PLACE, FILL THE MAT VOIDS WITH TOP SOIL OR GRANULAR MATERIAL AND LIGHTLY COMPACT OR ROLL TO MAXIMIZE SOIL/MAT CONTACT WITHOUT CRUSHING MAT.
 10. ESTABLISH AND MAINTAIN VEGETATION SO THAT REQUIREMENTS FOR ADEQUATE VEGETATIVE ESTABLISHMENT ARE CONTINUOUSLY MET IN ACCORDANCE WITH SECTION B-4 VEGETATIVE STABILIZATION.

MARYLAND STANDARDS AND SPECIFICATIONS FOR SOIL EROSION AND SEDIMENT CONTROL
 U.S. DEPARTMENT OF AGRICULTURE NATURAL RESOURCES CONSERVATION SERVICE 2011 MARYLAND DEPARTMENT OF ENVIRONMENT WATER MANAGEMENT ADMINISTRATION
 B.4(C)

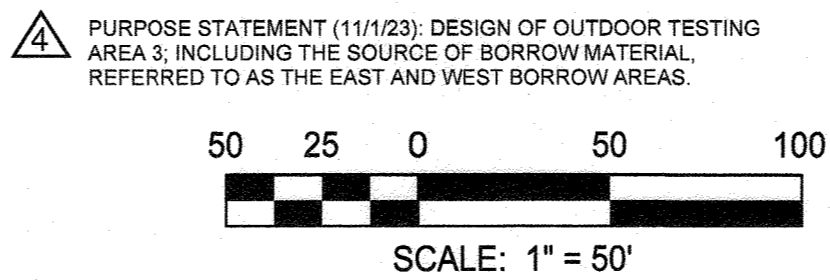

PURPOSE STATEMENT (11/1/23): DESIGN OF OUTDOOR TESTING AREA 3, INCLUDING THE SOURCE OF BORROW MATERIAL REFERRED TO AS THE EAST AND WEST BORROW AREAS.

GENERAL NOTES

- TOPOGRAPHIC AND SURFACE INFORMATION SHOWN WAS OBTAINED FROM FIELD SURVEY BY RK&K COMPLETED DECEMBER 23, 2021. UTILITY INFORMATION SHOWN WAS PROVIDED BY AHDATA ON FEBRUARY 4, 2022.
- IT IS THE CONTRACTOR'S RESPONSIBILITY TO FIELD VERIFY ACTUAL SITE CONDITIONS PRIOR TO THE START OF ANY WORK. THERE IS NO WARRANTY OR GUARANTEE ON THE COMPLETENESS OR CORRECTNESS OF THE EXISTING CONDITION INFORMATION. ANY DISCREPANCY FOUND SHALL BE BROUGHT TO THE IMMEDIATE ATTENTION OF THE ARCHITECT/ENGINEER PRIOR TO THE START OF ANY WORK.
- BEARINGS AND HORIZONTAL COORDINATES SHOWN ON THIS PLAN ARE BASED UPON MARYLAND STATE PLANE COORDINATE SYSTEM NAD83. VERTICAL ELEVATIONS SHOWN ARE BASED UPON VERTICAL DATUM NAVD83.
- THE LOCATION OF EXISTING UNDERGROUND UTILITIES IS SHOWN IN AN APPROXIMATE WAY ONLY. BASED UPON FIELD OBSERVATIONS AND RECORD DOCUMENTS. THEY HAVE NOT BEEN COMPARED TO OR VERIFIED WITH FIELD TEST PITS. THE CONTRACTOR SHALL BE RESPONSIBLE TO VERIFY TO HIS OWN SATISFACTION THE EXACT LOCATION, SIZE AND TYPE OF ALL EXISTING UNDERGROUND UTILITIES BEFORE COMMENCING ANY WORK. THE CONTRACTOR MUST NOTIFY THE UTILITY COMPANIES INVOLVED PRIOR TO THE START OF THE WORK. CONTRACTOR AGREES TO BE FULLY RESPONSIBLE FOR THE COST OF ANY AND ALL DAMAGES WHICH OCCUR AS A RESULT OF A FAILURE TO EXACTLY LOCATE AND PRESERVE ANY AND ALL EXISTING UTILITIES TO REMAIN.
- THE CONTRACTOR SHALL BE RESPONSIBLE FOR NOTIFYING "MISS UTILITY" AT 1-800-257-7777 FIVE DAYS PRIOR TO THE START OF ANY EXCAVATION WORK.
- THE CONTRACTOR SHALL VERIFY ALL EXISTING UTILITY INVERTS AND CLEARANCES FROM NEW WORK PRIOR TO START OF ANY WORK.
- THE CONTRACTOR SHALL STAKE OUT THE LOCATION OF ALL NEW CONSTRUCTION AND VERIFY ALL JURISDICTIONAL SETBACKS AND BUFFERS PRIOR TO START OF ANY WORK.
- EXISTING UTILITIES WHICH ARE NOT TO BE REMOVED OR ABANDONED SHALL REMAIN OPERATIONAL AT ALL TIMES. APPROPRIATE EXISTING UTILITIES SHALL REMAIN IN SERVICE UNTIL REPLACEMENT/RELOCATED UTILITIES ARE OPERATIONAL.
- CONTRACTOR SHALL PROVIDE POSITIVE DRAINAGE AWAY FROM ALL EXISTING AND PROPOSED BUILDING ENTRANCES DURING ALL PHASES OF CONSTRUCTION. UNLESS OTHERWISE NOTED IN THESE DOCUMENTS, CONTRACTOR SHALL NOTIFY ENGINEER / OWNER IF EXISTING OR PROPOSED CONDITIONS RESTRICT ABILITY TO ACHIEVE POSITIVE DRAINAGE FROM BUILDINGS PRIOR TO THE START OF CONSTRUCTION.
- SEE SHEET C-003 FOR FULL EXISTING AND PROPOSED FEATURES LEGEND

| SITE SOILS SUMMARY TABLE | | | | | |
|------------------------------|------|-------|-----|--------|----------|
| NAME | UNIT | Slope | HSG | HYDRIC | K FACTOR |
| Urban land-Urthornts complex | UdD | 8-25% | D | No | Unrated |
| Manor loam | MaB | 3-8% | B | No | 0.24 |
| Manor loam | MaC | 8-15% | B | No | 0.28 |
| Glennville silt loam | GmB | 3-8% | C/D | No | 0.37 |

SEQUENCE OF CONSTRUCTION: PHASE 2A


- CLEAR AS NECESSARY FOR INSTALLATION OF THE SEDIMENT CONTROL DEVICES AND MEASURES AS SHOWN ON THE PLAN OR AS DIRECTED BY THE SEDIMENT CONTROL INSPECTOR. 5 DAYS
- INSTALL STABILIZED CONSTRUCTION ENTRANCES. EXISTING PAVEMENT MUST BE REMOVED PRIOR TO PLACEMENT OF SCE. 2 DAYS
- INSTALL PHASE 2A EROSION AND SEDIMENT CONTROL MEASURES AS SHOWN ON PLAN VIEW: EARTH DIKES 1 THRU 2, SILT FENCE 1 THRU 3, SUPER SILT FENCE 1 THRU 9, SILT FENCE ON PAVEMENT 1 THRU 2, DIVERSION FENCE 1 THRU 2, AT-GRADE INLET PROTECTION 1 THRU 2, STANDARD INLET PROTECTION 1 THRU 3, COMBINATION INLET PROTECTION 1 THRU 5 AND STABILIZED CONSTRUCTION ENTRANCES 1 THRU 7. 5 DAYS
- BEGIN GRADING FOR SEDIMENT TRAPS (ST 1 AND 2) AFTER CLEARING AND GRUBBING TO THE EXTENT OF THESE PRACTICES ONLY. INSTALL BAFFLE BOARDS AND ANTI-VORTEX RISER STRUCTURE CONNECTING TO EXISTING STORM DRAIN. 10 DAYS
- ONCE ALL PHASE 2A AREAS ARE PERMANENTLY STABILIZED AND WITH APPROVAL OF THE SEDIMENT CONTROL INSPECTOR, PROCEED TO PHASE 2B (SHEET C-686 THRU 690). 2 DAYS

EROSION AND SEDIMENT CONTROL LEGEND


| | | |
|--|------|----------------------------------|
| | LOD | LIMIT OF DISTURBANCE |
| | SSF | SUPER SILT FENCE |
| | SFOP | SILT FENCE ON PAVEMENT |
| | DF | DIVERSION FENCE |
| | SCE | STABILIZED CONSTRUCTION ENTRANCE |
| | CIP | CURB INLET PROTECTION |
| | COIP | COMBINATION INLET PROTECTION |
| | AGIP | AT-GRADE INLET PROTECTION |
| | | SAME DAY STABILIZATION |
| | | TEMPORARY CONSTRUCTION FENCE |
| | | DRAINAGE AREA |
| | | EXISTING STEEP SLOPES (>15%) |
| | | PIPE TO BE REMOVED |
| | | PROPERTY LINE |

HOWARD SCD SIGNATURE BLOCK:
 This plan is approved for soil erosion and sediment control by the Howard Soil Conservation District.
Alexander B. Borch 11/15/23
 Howard Soil Conservation District Date

- COMBINATION INLET PROTECTION 1
MDE E-9-6
DRAINAGE AREA: 0.03 AC
- SUPER SILT FENCE 1
MDE E-3
LENGTH: 120 FT
AVG. SLOPE: 4.8%
AVG. SLOPE LENGTH: 8 FT
- AT-GRADE INLET PROTECTION 1
MDE E-9-2
DRAINAGE AREA: 0.16 AC.
- STABILIZED CONSTRUCTION ENTRANCE 1 & WASH RACK
MDE B-1
- MAINTAIN 7.5' CLEARANCE ACCESS AROUND FIRE HYDRANT AT ALL TIMES DURING CONSTRUCTION
- SAME DAY STABILIZATION = 0.70 AC
- STANDARD INLET PROTECTION 2
TYPE A
MDE E-9-1
DRAINAGE AREA: 0.08 AC.
- COMBINATION INLET PROTECTION 2
MDE E-9-6
DRAINAGE AREA: 0.15 AC
- COMBINATION INLET PROTECTION 3
MDE E-9-6
DRAINAGE AREA: 0.01 AC
- STANDARD INLET PROTECTION 6
TYPE B
MDE E-9-1
DRAINAGE AREA: 0.50 AC
- 6'x6' ANTI-SEEP CONCRETE COLLAR ON 24" PIPE OUTFALL
- 33" DIA. CONCRETE RISER WITH TRASH RACK
- HORIZONTAL DRAWDOWN DEVICE
- SEDIMENT TRAP
MDE G-1-1
DRAINAGE AREA: 3.09 AC
- BAFFLE BOARD, TYP. FLOW LENGTH: 137'
- COMBINATION INLET PROTECTION 4
MDE E-9-6
DRAINAGE AREA: 0.10 AC
- TEMPORARY SWALE 1 (TYPE A-2) MDE C-2
LENGTH: 27 FT
SLOPE: 10%
DRAINAGE AREA: 0.02 AC
- SUPER SILT FENCE 3
MDE E-3
LENGTH: 576 FT
AVG. SLOPE: 1.8%
AVG. SLOPE LENGTH: 56 FT

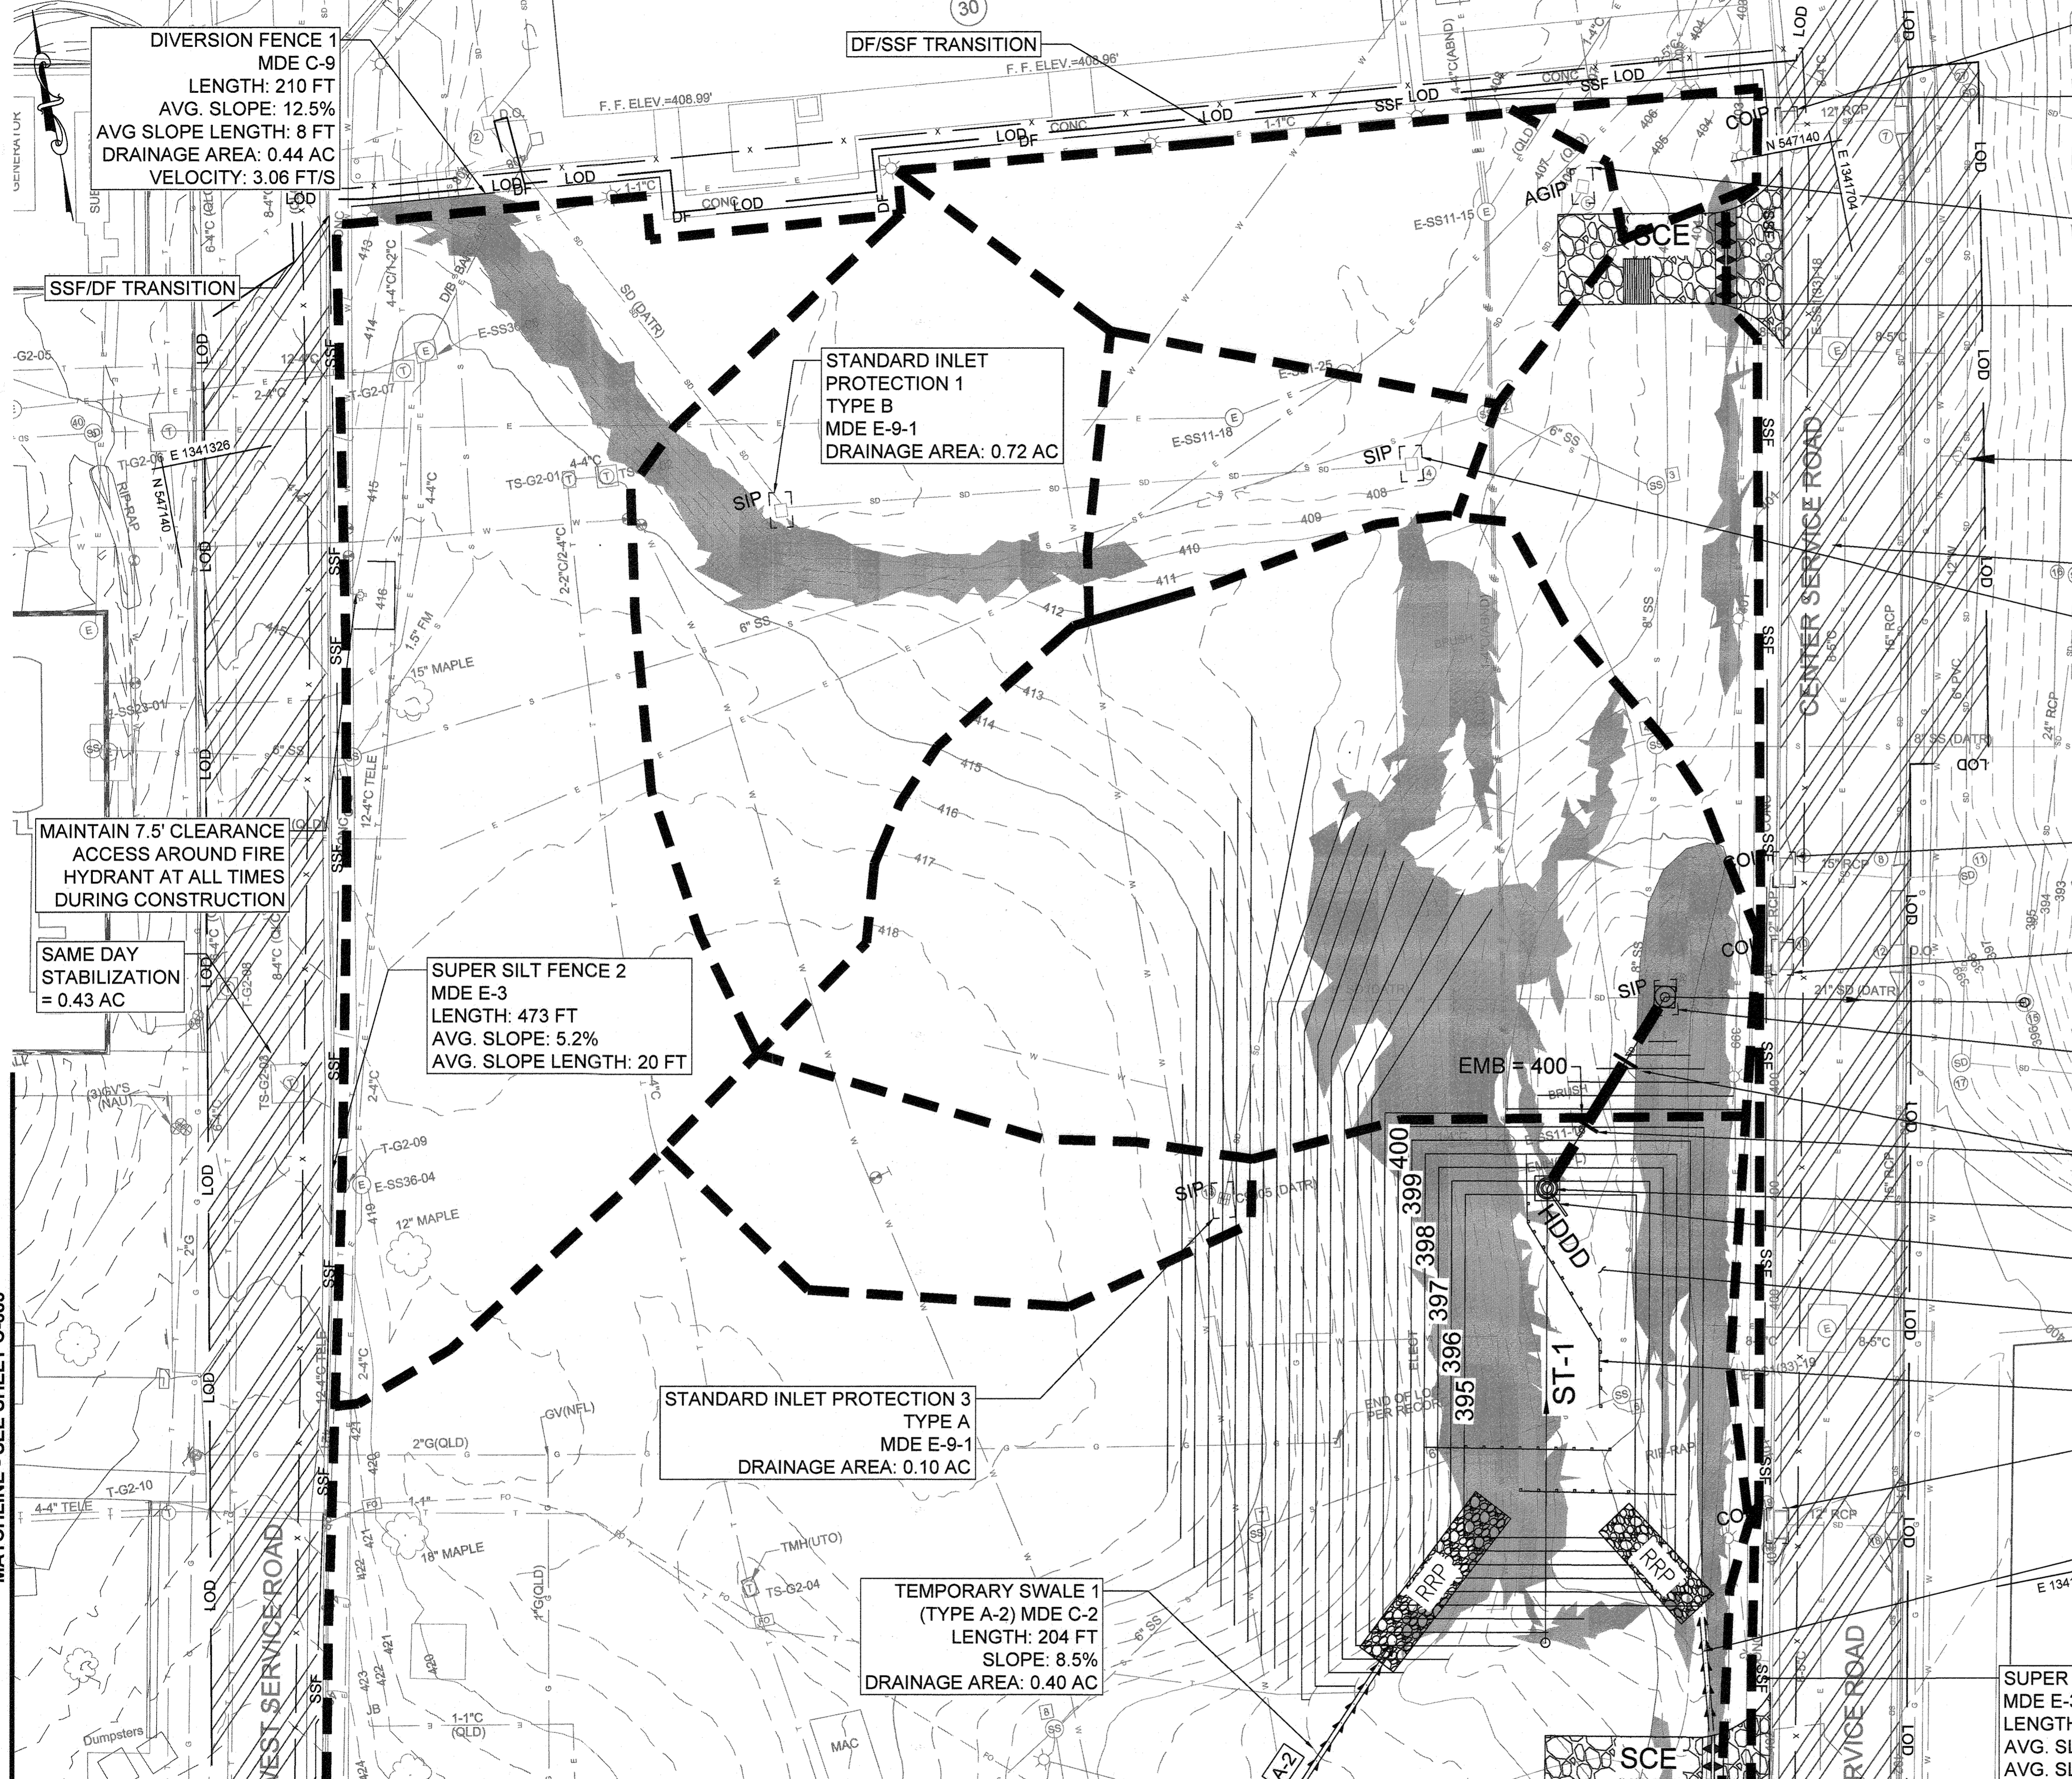

PURPOSE STATEMENT (11/123): DESIGN OF OUTDOOR TESTING AREA 3, INCLUDING THE SOURCE OF BORROW MATERIAL REFERRED TO AS THE EAST AND WEST BORROW AREAS.

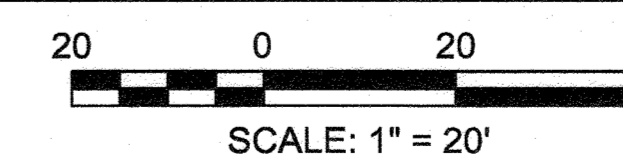

C:\Users\DPILAC\1\AppData\Local\Temp\AcPublish_16752\C-681 - C-686 Erosion Sediment Control Plan - East Borrow Area (Phase 2A).dwg Oct 31, 2023 3:31pm dplachowski

APPROVED: DEPARTMENT OF PLANNING AND ZONING
[Signature] 12-5-23
 Chief, Development Engineering Division Date
[Signature] 2/22/24
 Chief, Division of Land Development Date
[Signature] 2/22/24
 Director Date

RK&K
 RUMMEL, KLEMPNER & KAHL, LLP
 ENGINEERS, ARCHITECTS, PLANNERS, ENVIRONMENTAL SCIENTISTS
 RESPONSIVE PEOPLE • CREATIVE SOLUTIONS
 700 East Pratt Street, Suite 500
 Baltimore, MD 21202
 Ph: 410.728.2500 Contact: Matt Thomason
 www.rkk.com


DESIGN BY: SHK
 DRAWN BY: JMS/DTP
 CHECKED BY: CWWW
 DATE: 11/1/2023

| BY | NO. | REVISION | DATE |
|----|-----|---|---------|
| | | New Sheet - OTA-3 and Borrow Area Modifications | 11/1/23 |

OWNER/DEVELOPER
JOHNS HOPKINS APPLIED PHYSICS LABORATORY
 11100 JOHNS HOPKINS ROAD
 LAUREL, MARYLAND 20723

EROSION SEDIMENT CONTROL PLAN - EAST BORROW AREA (ESC PHASE 2A)
 JOHNS HOPKINS UNIVERSITY - APPLIED PHYSICS LABORATORY
OUTDOOR TESTING AREAS
 11100 JOHNS HOPKINS ROAD
 TAX MAP: 41 PARCEL: 123 GRID: 16 ZONED: PEC
 ELECTION DISTRICT 5 - HOWARD COUNTY, MARYLAND
 SHEET 56 OF 73

RK&K PROJECT NUMBER: 21047.013
 SCALE: As Shown
 SDP-18-060

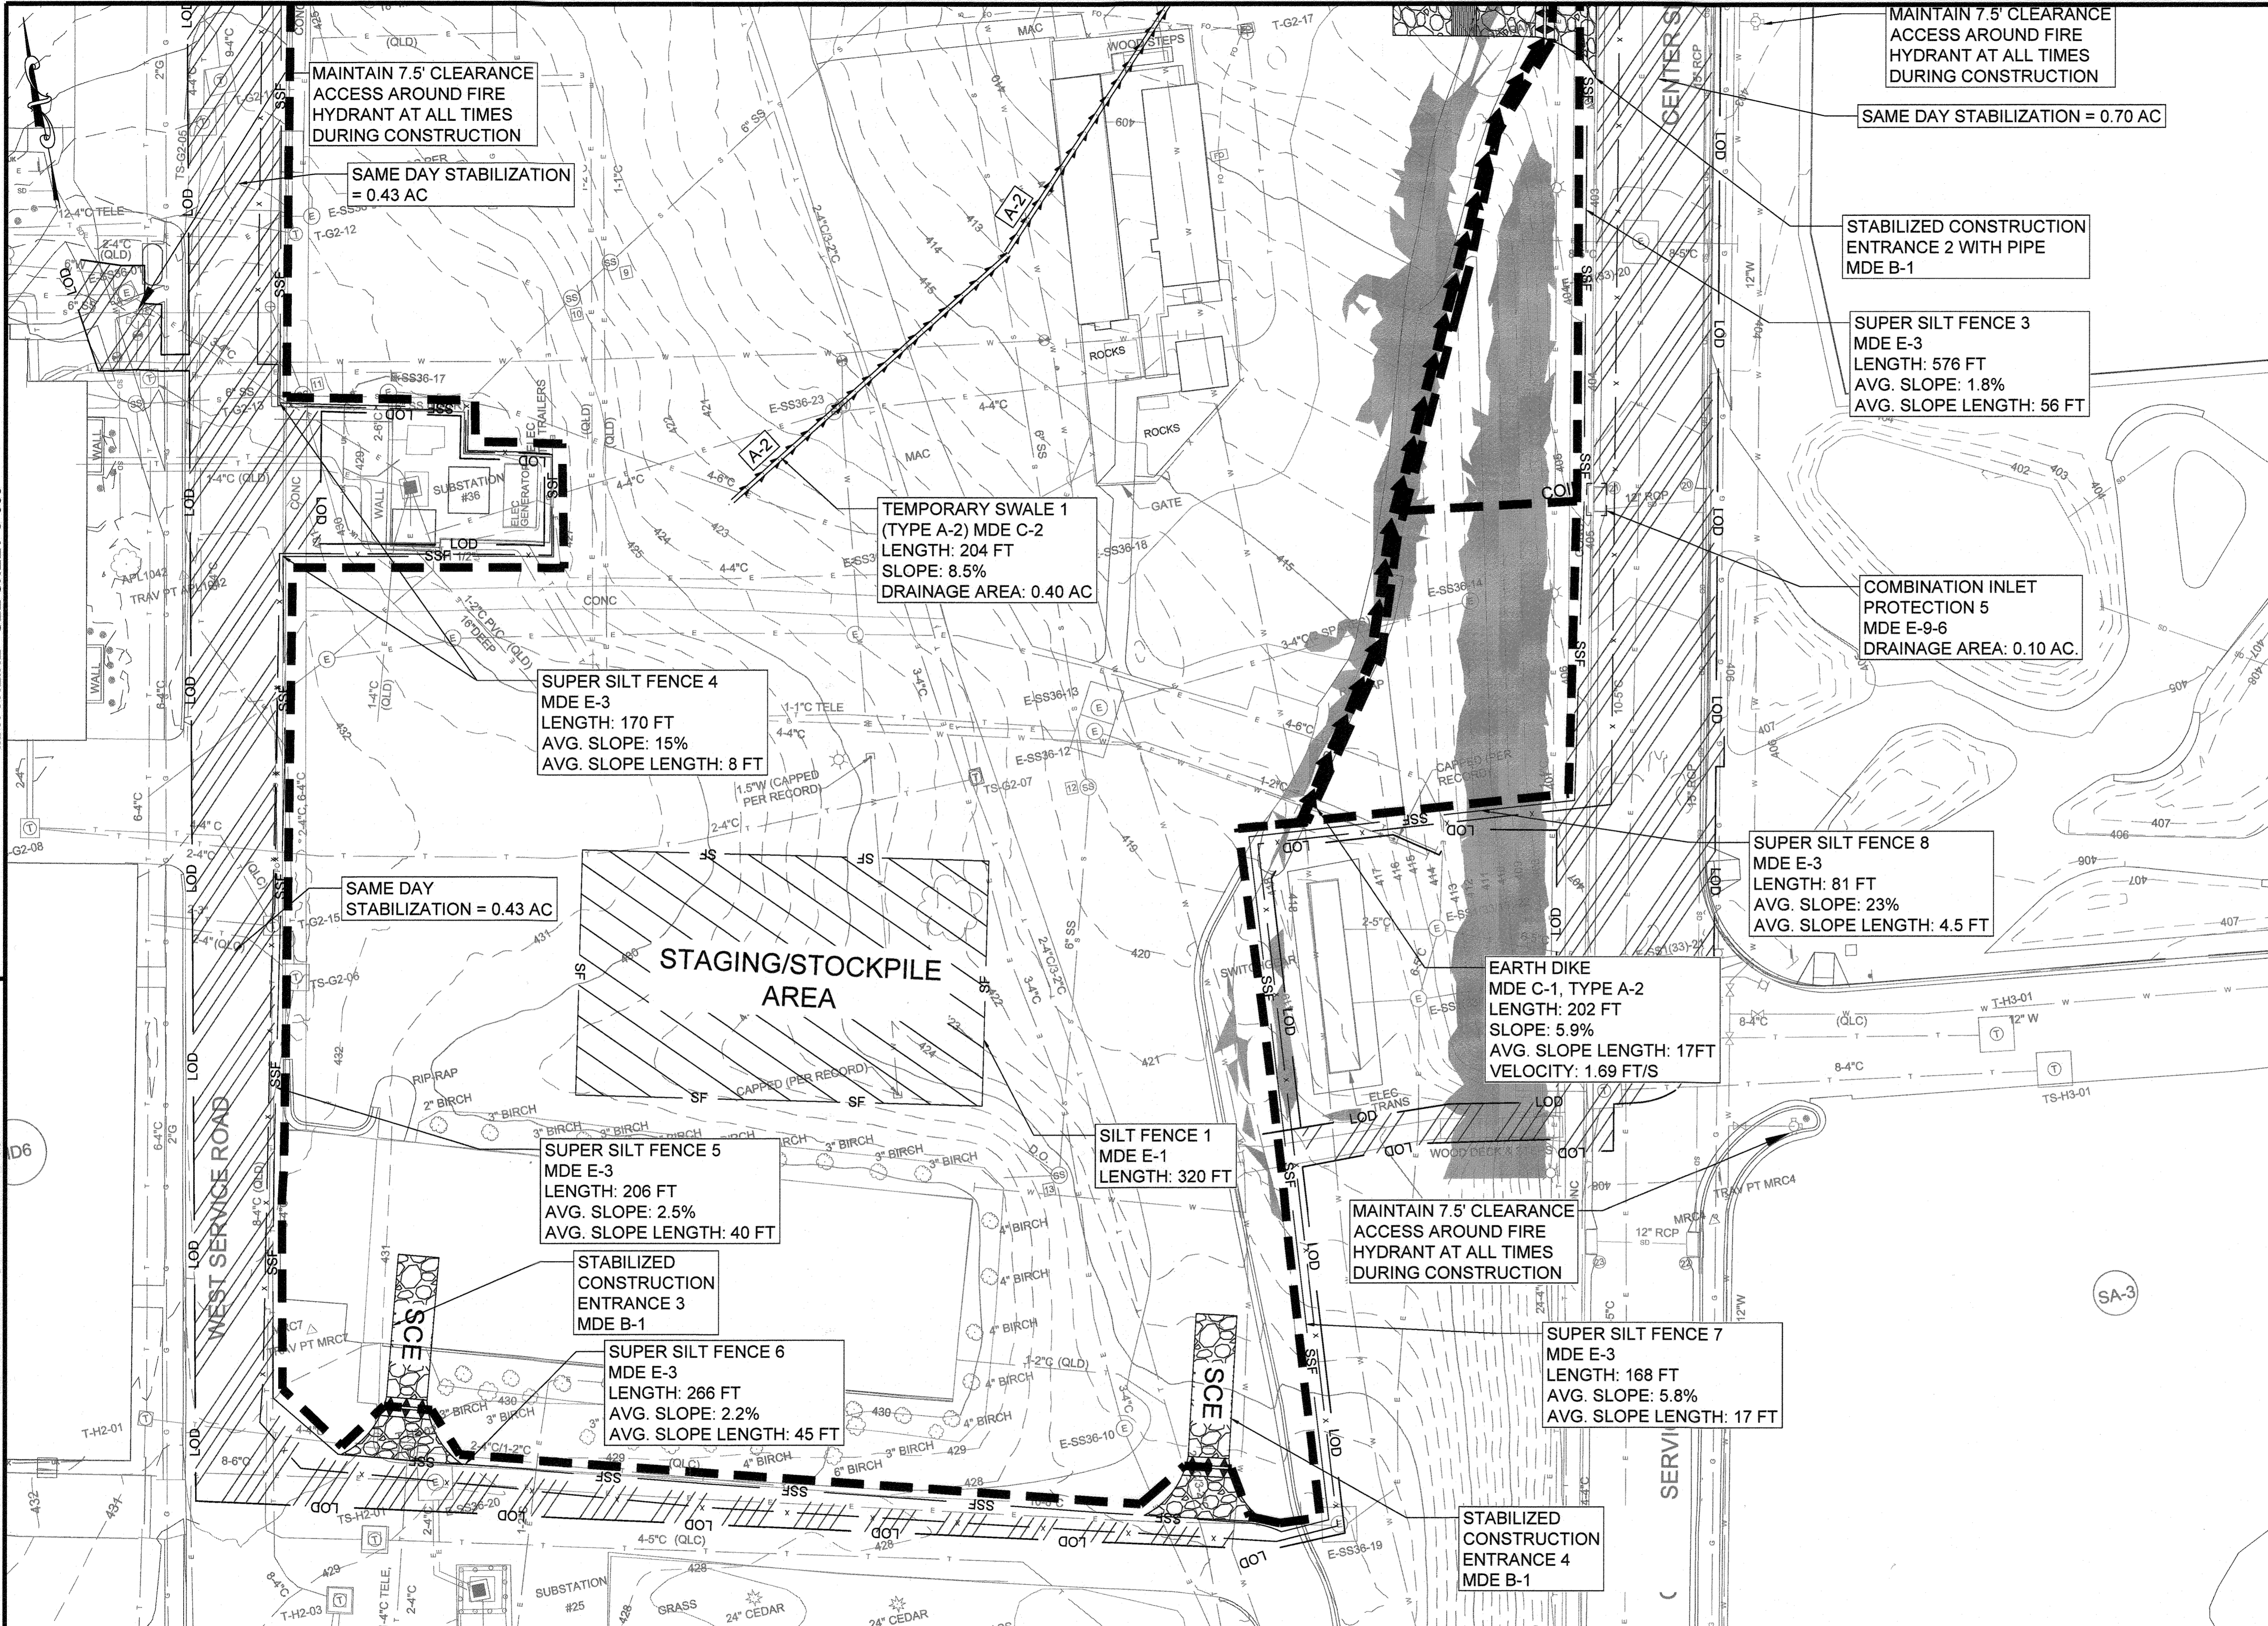

GENERAL NOTES

- TOPOGRAPHIC AND SURFACE INFORMATION SHOWN WAS OBTAINED FROM FIELD SURVEY BY RK&K, COMPLETED DECEMBER 23, 2021. UTILITY INFORMATION SHOWN WAS PROVIDED BY AII/DATA ON FEBRUARY 4, 2022.
- IT IS THE CONTRACTOR'S RESPONSIBILITY TO FIELD VERIFY ACTUAL SITE CONDITIONS PRIOR TO THE START OF ANY WORK. THERE IS NO WARRANTY OR GUARANTEE ON THE COMPLETENESS OR CORRECTNESS OF THE EXISTING CONDITION INFORMATION. ANY DISCREPANCY FOUND SHALL BE BROUGHT TO THE IMMEDIATE ATTENTION OF THE ARCHITECT/ENGINEER PRIOR TO THE START OF ANY WORK.
- BEARINGS AND HORIZONTAL COORDINATES SHOWN ON THIS PLAN ARE BASED UPON MARYLAND STATE PLANE COORDINATE SYSTEM NAD83. VERTICAL ELEVATIONS SHOWN ARE BASED UPON VERTICAL DATUM NAVD83.
- THE LOCATION OF EXISTING UNDERGROUND UTILITIES IS SHOWN IN AN APPROXIMATE WAY ONLY, BASED UPON FIELD OBSERVATIONS AND RECORD DOCUMENTS. THEY HAVE NOT BEEN COMPARED TO OR VERIFIED WITH FIELD TEST PITS. THE CONTRACTOR SHALL BE RESPONSIBLE TO VERIFY TO HIS OWN SATISFACTION THE EXACT LOCATION, SIZE AND TYPE OF ALL EXISTING UNDERGROUND UTILITIES BEFORE COMMENCING ANY WORK. THE CONTRACTOR MUST NOTIFY THE UTILITY COMPANIES INVOLVED PRIOR TO THE START OF THE WORK. CONTRACTOR AGREES TO BE FULLY RESPONSIBLE FOR THE COST OF ANY AND ALL DAMAGES WHICH OCCUR AS A RESULT OF A FAILURE TO EXACTLY LOCATE AND PRESERVE ANY AND ALL EXISTING UTILITIES TO REMAIN.
- THE CONTRACTOR SHALL BE RESPONSIBLE FOR NOTIFYING "MISS UTILITY" AT 1-800-257-7777 FIVE DAYS PRIOR TO THE START OF ANY EXCAVATION WORK.
- THE CONTRACTOR SHALL VERIFY ALL EXISTING UTILITY INVERTS AND CLEARANCES FROM NEW WORK PRIOR TO START OF ANY WORK.
- THE CONTRACTOR SHALL STAKE OUT THE LOCATION OF ALL NEW CONSTRUCTION AND VERIFY ALL JURISDICTIONAL SETBACKS AND BUFFERS PRIOR TO START OF ANY WORK.
- EXISTING UTILITIES WHICH ARE NOT TO BE REMOVED OR ABANDONED SHALL REMAIN OPERATIONAL AT ALL TIMES. APPROPRIATE EXISTING UTILITIES SHALL REMAIN IN SERVICE UNTIL REPLACEMENT/RELOCATED UTILITIES ARE OPERATIONAL.
- CONTRACTOR SHALL PROVIDE POSITIVE DRAINAGE AWAY FROM ALL EXISTING AND PROPOSED BUILDING ENTRANCES DURING ALL PHASES OF CONSTRUCTION, UNLESS OTHERWISE NOTED IN THESE DOCUMENTS. CONTRACTOR SHALL NOTIFY ENGINEER/OWNER IF EXISTING OR PROPOSED CONDITIONS RESTRICT ABILITY TO ACHIEVE POSITIVE DRAINAGE FROM BUILDINGS PRIOR TO THE START OF CONSTRUCTION.
- SEE SHEET C-003 FOR FULL EXISTING AND PROPOSED FEATURES LEGEND

| SITE SOILS SUMMARY TABLE | | | | | |
|-------------------------------|------|-------|-----|--------|----------|
| NAME | UNIT | Slope | HSG | HYDRIC | K FACTOR |
| Urban land-Udorthents complex | UdD | 8-25% | D | No | Unrated |
| Manor loam | MaB | 3-8% | B | No | 0.24 |
| Manor loam | MaC | 8-15% | B | No | 0.28 |
| Glenville silt loam | GmB | 3-8% | C/D | No | 0.37 |

EROSION AND SEDIMENT CONTROL LEGEND

- LOD LIMIT OF DISTURBANCE
- SSF SUPER SILT FENCE
- SFOP SILT FENCE ON PAVEMENT
- DF DIVERSION FENCE
- SCE STABILIZED CONSTRUCTION ENTRANCE
- COIP CURB INLET PROTECTION
- COIP COMBINATION INLET PROTECTION
- AGIP AT-GRADE INLET PROTECTION
- SAME DAY STABILIZATION
- TEMPORARY CONSTRUCTION FENCE
- DRAINAGE AREA
- EXISTING STEEP SLOPES (>15%)
- PIPE TO BE REMOVED
- PROPERTY LINE

HOWARD SCD SIGNATURE BLOCK:
 This plan is approved for soil erosion and sediment control by the Howard Soil Conservation District.
Alexander Pratchi 11/15/23
 Howard Soil Conservation District Date

PURPOSE STATEMENT (11/1/23): DESIGN OF OUTDOOR TESTING AREA 3, INCLUDING THE SOURCE OF BORROW MATERIAL, REFERRED TO AS THE EAST AND WEST BORROW AREAS.
 SCALE: 1" = 20'

APPROVED: DEPARTMENT OF PLANNING AND ZONING
 Chief, Development Engineering Division 12.5.23
 Date
 Chief, Division of Land Development 1/15/24
 Date
 Director 2/22/24
 Date

RK&K
 RUMMEL, KLEPPER & KAHN, LLP
 ENGINEERING, ARCHITECTURE, PLANNING AND DESIGN
 700 East Pratt Street, Suite 500
 Baltimore, MD 21202
 PH: 410.728.2900
 www.rk&k.com

PROFESSIONAL CERTIFICATION: I HEREBY CERTIFY THAT THESE DOCUMENTS WERE PREPARED OR APPROVED BY ME, AND THAT I AM A DULY LICENSED PROFESSIONAL ENGINEER UNDER THE LAWS OF THE STATE OF MARYLAND, LICENSE NO. 46432, EXPIRATION DATE: MAY 31, 2026.

| | | | | |
|-------------------|------|-----|---|---------|
| DESIGN BY: SHK | RK&K | 4 | New Sheet - OTA-3 and Borrow Area Modifications | 11/1/23 |
| DRAWN BY: JMS/DTP | | | | |
| CHECKED BY: CWWW | | | | |
| DATE: 11/1/2023 | BY | NO. | REVISION | DATE |

OWNER/DEVELOPER
JOHNS HOPKINS APPLIED PHYSICS LABORATORY
 11100 JOHNS HOPKINS ROAD
 LAUREL, MARYLAND 20723

EROSION SEDIMENT CONTROL PLAN - EAST BORROW AREA (ESC PHASE 2A)
 JOHNS HOPKINS UNIVERSITY - APPLIED PHYSICS LABORATORY
OUTDOOR TESTING AREAS
 11100 JOHNS HOPKINS ROAD
 TAX MAP: 41 PARCEL: 123 GRID: 18 ZONED: PEG
 ELECTION DISTRICT 5 - HOWARD COUNTY, MARYLAND
 SHEET 57 OF 73

RK&K PROJECT NUMBER 21047.013
 SCALE: As Shown
 SDP-18-060

GENERAL NOTES

1. TOPOGRAPHIC AND SURFACE INFORMATION SHOWN WAS OBTAINED FROM FIELD SURVEY BY RK&K, COMPLETED DECEMBER 23, 2021. UTILITY INFORMATION SHOWN WAS PROVIDED BY AII/DATA ON FEBRUARY 4, 2022.
2. IT IS THE CONTRACTOR'S RESPONSIBILITY TO FIELD VERIFY ACTUAL SITE CONDITIONS PRIOR TO THE START OF ANY WORK. THERE IS NO WARRANTY OR GUARANTEE ON THE COMPLETENESS OR CORRECTNESS OF THE EXISTING CONDITION INFORMATION. ANY DISCREPANCY FOUND SHALL BE BROUGHT TO THE IMMEDIATE ATTENTION OF THE ARCHITECT/ENGINEER PRIOR TO THE START OF ANY WORK.
3. BEARINGS AND HORIZONTAL COORDINATES SHOWN ON THIS PLAN ARE BASED UPON MARYLAND STATE PLANE COORDINATE SYSTEM NAD83. VERTICAL ELEVATIONS SHOWN ARE BASED UPON VERTICAL DATUM NAVD88.
4. THE LOCATION OF EXISTING UNDERGROUND UTILITIES IS SHOWN IN AN APPROXIMATE WAY ONLY. BASED UPON FIELD OBSERVATIONS AND RECORD DOCUMENTS. THEY HAVE NOT BEEN COMPARED TO OR VERIFIED WITH FIELD TEST PITS. THE CONTRACTOR SHALL BE RESPONSIBLE TO VERIFY TO HIS OWN SATISFACTION THE EXACT LOCATION, SIZE AND TYPE OF ALL EXISTING UNDERGROUND UTILITIES BEFORE COMMENCING ANY WORK. THE CONTRACTOR MUST NOTIFY THE UTILITY COMPANIES INVOLVED PRIOR TO THE START OF THE WORK. CONTRACTOR AGREES TO BE FULLY RESPONSIBLE FOR THE COST OF ANY AND ALL DAMAGES WHICH OCCUR AS A RESULT OF A FAILURE TO EXACTLY LOCATE AND PRESERVE ANY AND ALL EXISTING UTILITIES TO REMAIN.
5. THE CONTRACTOR SHALL BE RESPONSIBLE FOR NOTIFYING "MISS UTILITY" AT 1-800-257-7777 FIVE DAYS PRIOR TO THE START OF ANY EXCAVATION WORK.
6. THE CONTRACTOR SHALL VERIFY ALL EXISTING UTILITY INVERTS AND CLEARANCES FROM NEW WORK PRIOR TO START OF ANY WORK.
7. THE CONTRACTOR SHALL STAKE OUT THE LOCATION OF ALL NEW CONSTRUCTION AND VERIFY ALL JURISDICTIONAL SETBACKS AND BUFFERS PRIOR TO START OF ANY WORK.
8. EXISTING UTILITIES WHICH ARE NOT TO BE REMOVED OR ABANDONED SHALL REMAIN OPERATIONAL AT ALL TIMES. APPROPRIATE EXISTING UTILITIES SHALL REMAIN IN SERVICE UNTIL REPLACEMENT/RELOCATED UTILITIES ARE OPERATIONAL.
9. CONTRACTOR SHALL PROVIDE POSITIVE DRAINAGE AWAY FROM ALL EXISTING AND PROPOSED BUILDING ENTRANCES DURING ALL PHASES OF CONSTRUCTION, UNLESS OTHERWISE NOTED IN THESE DOCUMENTS. CONTRACTOR SHALL NOTIFY ENGINEER / OWNER IF EXISTING OR PROPOSED CONDITIONS RESTRICT ABILITY TO ACHIEVE POSITIVE DRAINAGE FROM BUILDINGS PRIOR TO THE START OF CONSTRUCTION.
10. SEE SHEET C-003 FOR FULL EXISTING AND PROPOSED FEATURES LEGEND

| SITE SOILS SUMMARY TABLE | | | | | |
|-------------------------------|------|-------|-----|--------|----------|
| NAME | UNIT | Slope | HSG | HYDRIC | K FACTOR |
| Urban land-Udorthents complex | UdD | 8-25% | D | No | Unrated |
| Manor loam | MaB | 3-8% | B | No | 0.24 |
| Manor loam | MaC | 8-15% | B | No | 0.28 |
| Glenville silt loam | GmB | 3-8% | C/D | No | 0.37 |

EROSION AND SEDIMENT CONTROL LEGEND

- LOD ——— LIMIT OF DISTURBANCE
- SSF ——— SUPER SILT FENCE
- SFOP ——— SILT FENCE ON PAVEMENT
- DF ——— DIVERSION FENCE
- SCEN ——— STABILIZED CONSTRUCTION ENTRANCE
- CIP ——— CURB INLET PROTECTION
- COIP ——— COMBINATION INLET PROTECTION
- AGIP ——— AT-GRADE INLET PROTECTION
- SAME DAY STABILIZATION
- x ——— TEMPORARY CONSTRUCTION FENCE
- ——— DRAINAGE AREA
- EXISTING STEEP SLOPES (>15%)
- ——— PIPE TO BE REMOVED
- ——— PROPERTY LINE


HOWARD SCD SIGNATURE BLOCK:
 This plan is approved for soil erosion and sediment control by the Howard Soil Conservation District.

 Howard Soil Conservation District 11/15/23 Date




MATCHLINE - SEE SHEET C-681

PURPOSE STATEMENT (11/1/23): DESIGN OF OUTDOOR TESTING AREA 3, INCLUDING THE SOURCE OF BORROW MATERIAL REFERRED TO AS THE EAST AND WEST BORROW AREAS.

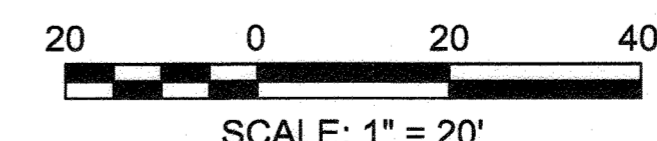

APPROVED: DEPARTMENT OF PLANNING AND ZONING
 Chief, Development Engineering Division 12.5.23
 Chief, Division of Land Development 2/22/24
 Director 2/22/24

RK&K
 RUMMEL, KLEPPER & KAHL, LLP
 ENGINEERS/CONSTRUCTION MANAGERS/PLANNERS/SCIENTISTS
 RESPONDING PROBLEM-CRATIVE SOLUTIONS
 700 East Pratt Street, Suite 500
 Baltimore, MD 21202
 PH: 410.728.2500 Contact: Matt Thomason
 www.rk&k.com

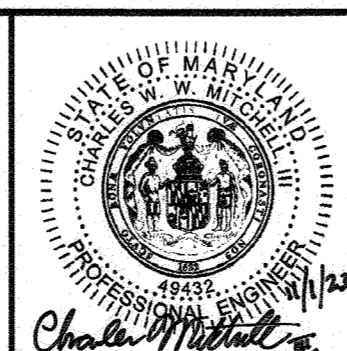

| | | | |
|-------------|-----------|----------|-----------|
| DESIGN BY: | SHK | DATE: | 11/1/2023 |
| DRAWN BY: | JMS/DTP | | |
| CHECKED BY: | CWWW | | |
| DATE: | 11/1/2023 | | |
| BY | NO. | REVISION | DATE |
| | | | |

OWNER/DEVELOPER
JOHNS HOPKINS APPLIED PHYSICS LABORATORY
 11100 JOHNS HOPKINS ROAD
 LAUREL, MARYLAND 20723


EROSION SEDIMENT CONTROL PLAN - EAST BORROW AREA (ESC PHASE 2A)
 JOHNS HOPKINS UNIVERSITY - APPLIED PHYSICS LABORATORY
OUTDOOR TESTING AREAS
 11100 JOHNS HOPKINS ROAD
 TAX MAP: 41 PARCEL: 123 GRID: 16 ZONED: PEG
 ELECTION DISTRICT 5 - HOWARD COUNTY, MARYLAND
 SHEET 58 OF 73
 SDP-18-060

C-683
 RK&K PROJECT NUMBER
 21047.013
 SCALE:
 As Shown

GENERAL NOTES

- TOPOGRAPHIC AND SURFACE INFORMATION SHOWN WAS OBTAINED FROM FIELD SURVEY BY RK&K, COMPLETED DECEMBER 23, 2021. UTILITY INFORMATION SHOWN WAS PROVIDED BY AII/DATA ON FEBRUARY 4, 2022.
- IT IS THE CONTRACTOR'S RESPONSIBILITY TO FIELD VERIFY ACTUAL SITE CONDITIONS PRIOR TO THE START OF ANY WORK. THERE IS NO WARRANTY OR GUARANTEE ON THE COMPLETENESS OR CORRECTNESS OF THE EXISTING CONDITION INFORMATION. ANY DISCREPANCY FOUND SHALL BE BROUGHT TO THE IMMEDIATE ATTENTION OF THE ARCHITECT/ENGINEER PRIOR TO THE START OF ANY WORK.
- BEARINGS AND HORIZONTAL COORDINATES SHOWN ON THIS PLAN ARE BASED UPON MARYLAND STATE PLANE COORDINATE SYSTEM NAD83. VERTICAL ELEVATIONS SHOWN ARE BASED UPON VERTICAL DATUM NAVD83.
- THE LOCATION OF EXISTING UNDERGROUND UTILITIES IS SHOWN IN AN APPROXIMATE WAY ONLY. BASED UPON FIELD OBSERVATIONS AND RECORD DOCUMENTS. THEY HAVE NOT BEEN COMPARED TO OR VERIFIED WITH FIELD TEST PITS. THE CONTRACTOR SHALL BE RESPONSIBLE TO VERIFY TO HIS OWN SATISFACTION THE EXACT LOCATION, SIZE AND TYPE OF ALL EXISTING UNDERGROUND UTILITIES BEFORE COMMENCING ANY WORK. THE CONTRACTOR MUST NOTIFY THE UTILITY COMPANIES INVOLVED PRIOR TO THE START OF THE WORK. CONTRACTOR AGREES TO BE FULLY RESPONSIBLE FOR THE COST OF ANY AND ALL DAMAGES WHICH OCCUR AS A RESULT OF A FAILURE TO EXACTLY LOCATE AND PRESERVE ANY AND ALL EXISTING UTILITIES TO REMAIN.
- THE CONTRACTOR SHALL BE RESPONSIBLE FOR NOTIFYING "MISS UTILITY" AT 1-800-257-7777 FIVE DAYS PRIOR TO THE START OF ANY EXCAVATION WORK.
- THE CONTRACTOR SHALL VERIFY ALL EXISTING UTILITY INVERTS AND CLEARANCES FROM NEW WORK PRIOR TO START OF ANY WORK.
- THE CONTRACTOR SHALL STAKE OUT THE LOCATION OF ALL NEW CONSTRUCTION AND VERIFY ALL JURISDICTIONAL SETBACKS AND BUFFERS PRIOR TO START OF ANY WORK.
- EXISTING UTILITIES WHICH ARE NOT TO BE REMOVED OR ABANDONED SHALL REMAIN OPERATIONAL AT ALL TIMES. APPROPRIATE EXISTING UTILITIES SHALL REMAIN IN SERVICE UNTIL REPLACEMENT/RELOCATED UTILITIES ARE OPERATIONAL.
- CONTRACTOR SHALL PROVIDE POSITIVE DRAINAGE AWAY FROM ALL EXISTING AND PROPOSED BUILDING ENTRANCES DURING ALL PHASES OF CONSTRUCTION, UNLESS OTHERWISE NOTED IN THESE DOCUMENTS. CONTRACTOR SHALL NOTIFY ENGINEER / OWNER IF EXISTING OR PROPOSED CONDITIONS RESTRICT ABILITY TO ACHIEVE POSITIVE DRAINAGE FROM BUILDINGS PRIOR TO THE START OF CONSTRUCTION.
- SEE SHEET C-003 FOR FULL EXISTING AND PROPOSED FEATURES LEGEND

| SITE SOILS SUMMARY TABLE | | | | | |
|-------------------------------|------|-------|-----|--------|----------|
| NAME | UNIT | Slope | HSG | HYDRIC | K FACTOR |
| Urban land-Underliths complex | Udd | 8-25% | D | No | Unrated |
| Manor loam | MaB | 3-8% | B | No | 0.24 |
| Manor loam | MaC | 8-15% | B | No | 0.28 |
| Glennville silt loam | GmB | 3-8% | C/D | No | 0.37 |

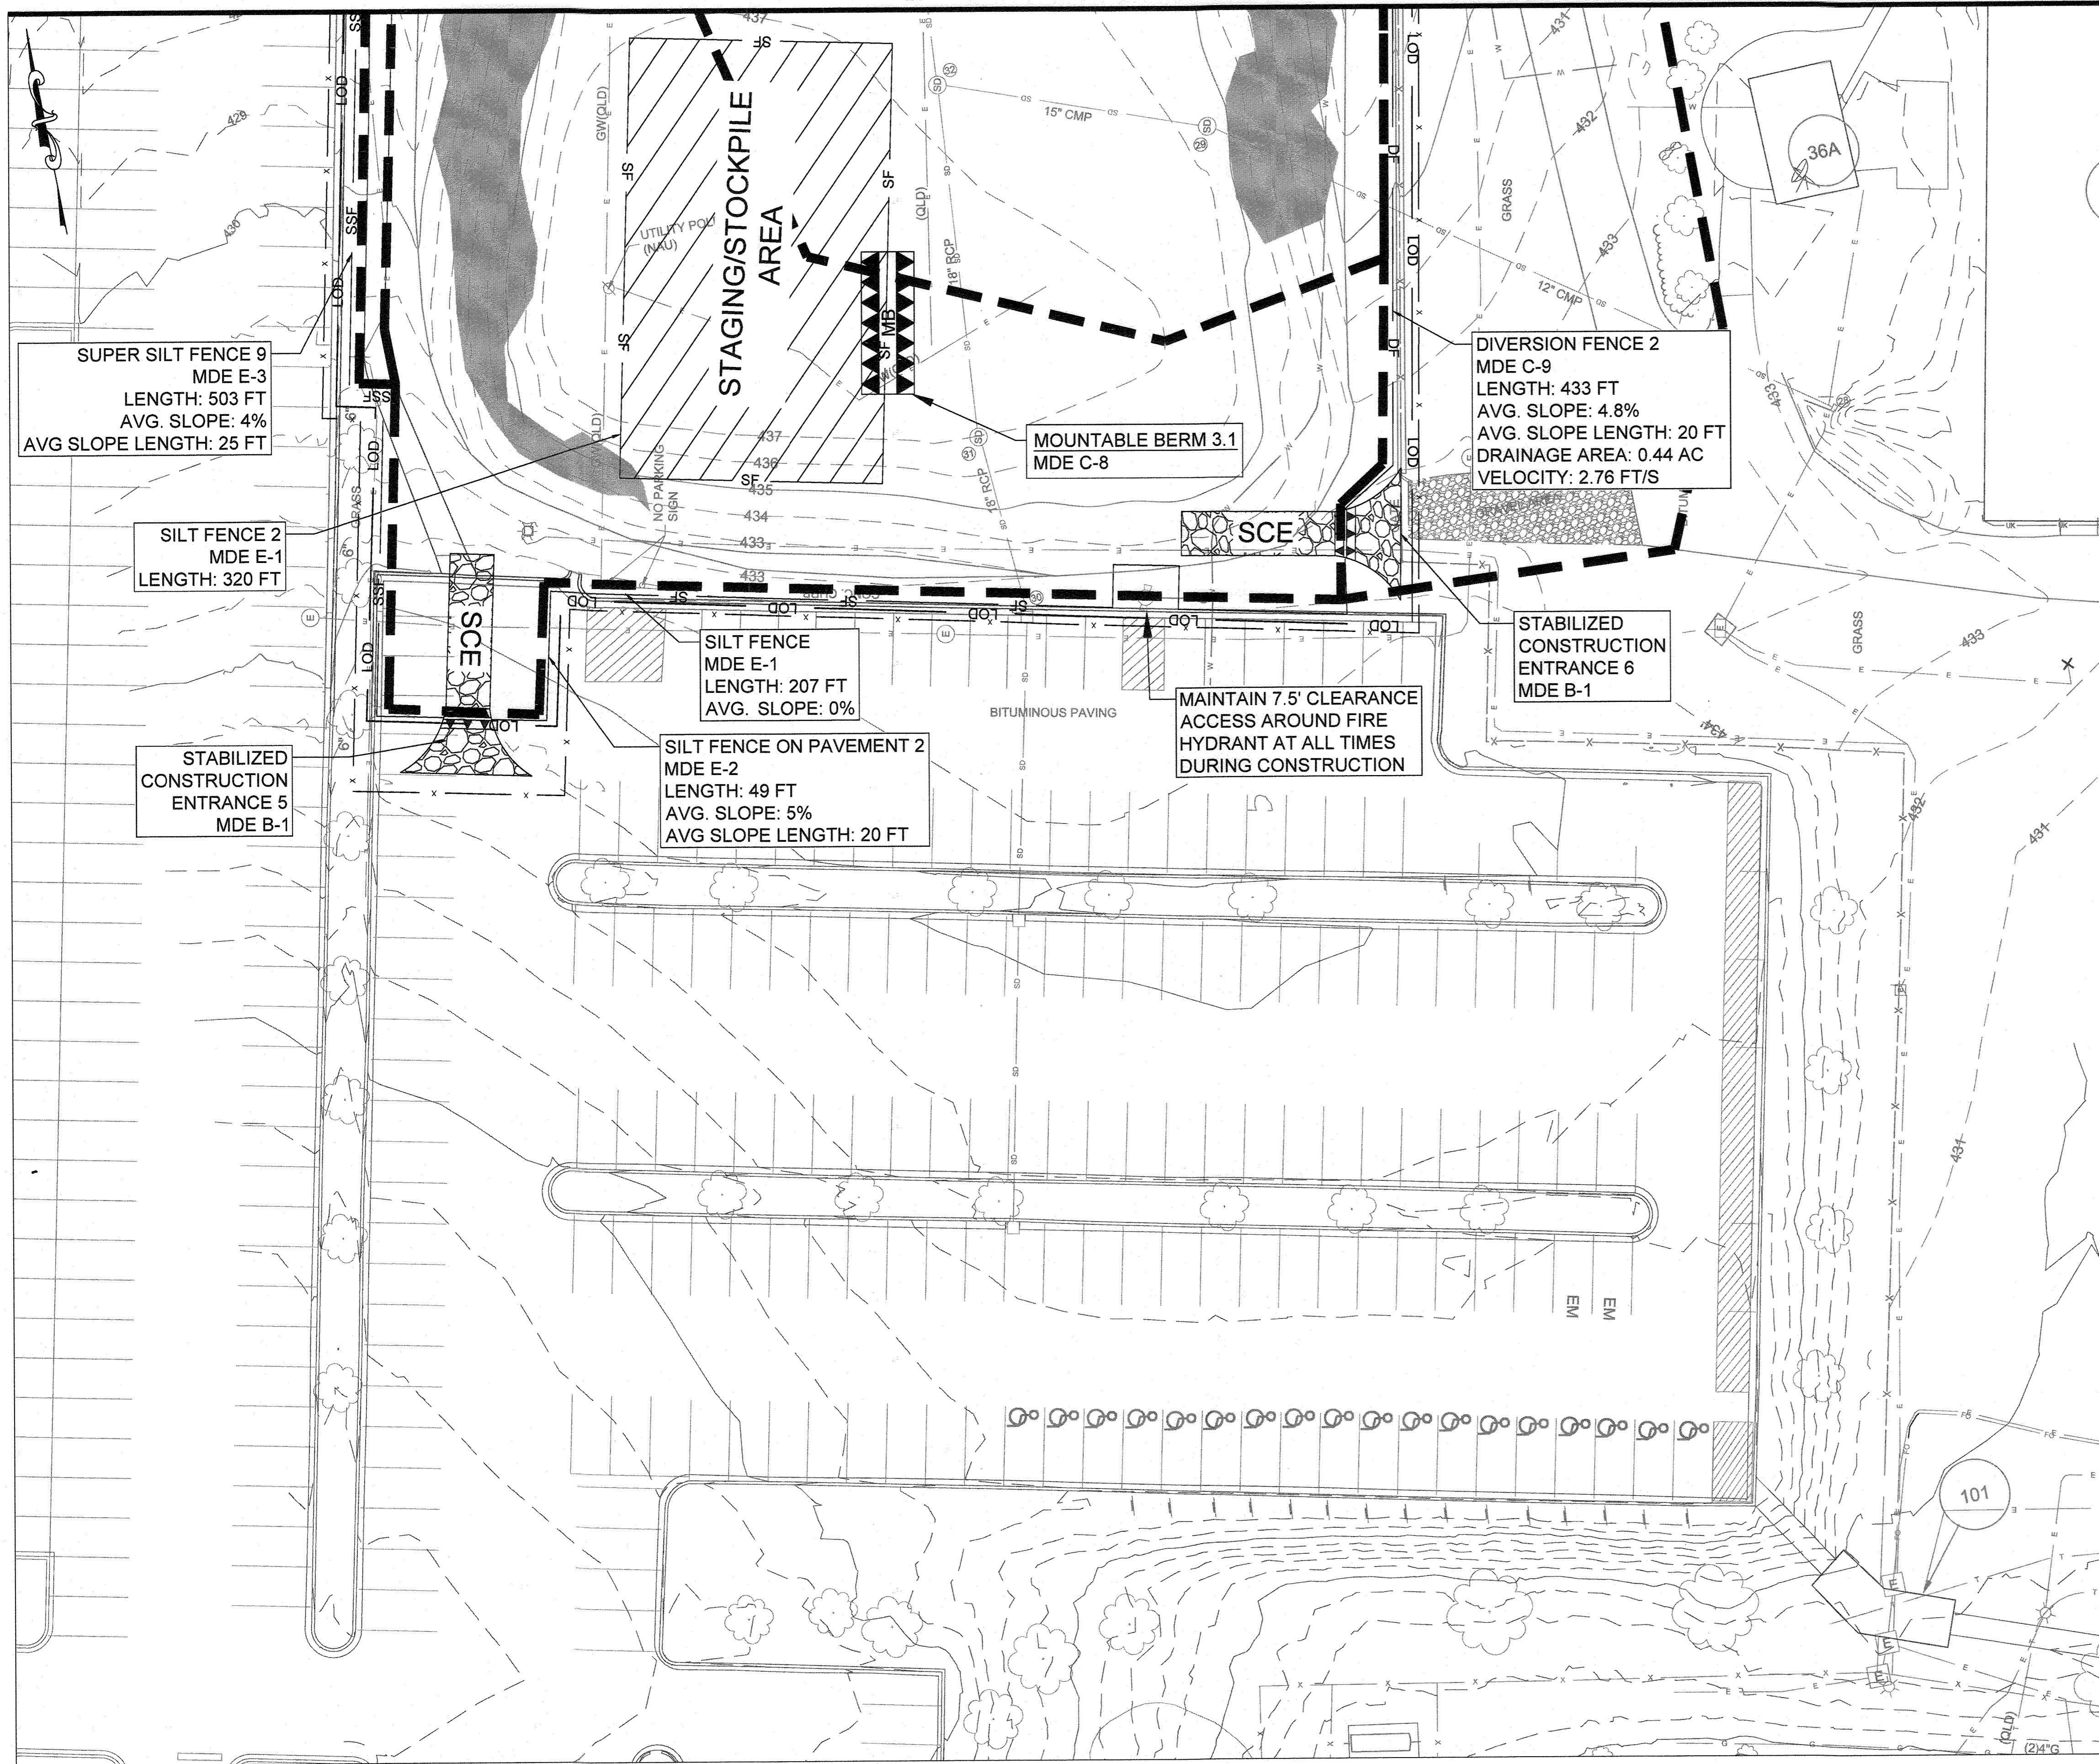

MATCHLINE - SEE SHEET C-682

MATCHLINE - SEE SHEET C-682

EROSION AND SEDIMENT CONTROL LEGEND

- LOD — LIMIT OF DISTURBANCE
- SSF — SUPER SILT FENCE
- SFOP — SILT FENCE ON PAVEMENT
- DF — DIVERSION FENCE
- SCE — STABILIZED CONSTRUCTION ENTRANCE
- CIP — CURB INLET PROTECTION
- COIP — COMBINATION INLET PROTECTION
- AGIP — AT-GRADE INLET PROTECTION
- SAME DAY STABILIZATION
- x — TEMPORARY CONSTRUCTION FENCE
- — DRAINAGE AREA
- EXISTING STEEP SLOPES (>15%)
- — PIPE TO BE REMOVED

HOWARD SCD SIGNATURE BLOCK:
 This plan is approved for soil erosion and sediment control by the Howard Soil Conservation District.

 Alexander Brathis
 Howard Soil Conservation District
 11/15/23
 Date

4 PURPOSE STATEMENT (11/1/23): DESIGN OF OUTDOOR TESTING AREA 3, INCLUDING THE SOURCE OF BORROW MATERIAL, REFERRED TO AS THE EAST AND WEST BORROW AREAS.
 SCALE: 1" = 20'

APPROVED: DEPARTMENT OF PLANNING AND ZONING

 Chief, Development Engineering Division
 Date: 12-5-23

 Chief, Division of Land Development
 Date: 2/22/24
 Director

RK&K
 RUMMEL, KLEPPER & KAHL, LLP
 ENGINEERS/CONSTRUCTION MANAGERS/PLANNERS/SCIENTISTS
 RESPONSIVE. REASONABLE. CREATIVE SOLUTIONS.
 700 East Pratt Street, Suite 500
 Baltimore, MD 21202
 PH: 410.728.2000 Contact: Matt Thomsson
 www.rkk.com

DESIGN BY: SHK
 DRAWN BY: JMS/DTP
 CHECKED BY: CWWW
 DATE: 11/1/2023

| BY | NO. | REVISION | DATE |
|----|-----|---|---------|
| | | New Sheet - OTA-3 and Borrow Area Modifications | 11/1/23 |

OWNER/DEVELOPER
 JOHNS HOPKINS
 APPLIED PHYSICS LABORATORY
 11100 JOHNS HOPKINS ROAD
 LAUREL, MARYLAND 20723

EROSION SEDIMENT CONTROL PLAN - WEST BORROW AREA (ESC PHASE 2A)
 JOHNS HOPKINS UNIVERSITY - APPLIED PHYSICS LABORATORY
OUTDOOR TESTING AREAS
 11100 JOHNS HOPKINS ROAD
 TAX MAP: 41 PARCEL: 123 GRID: 16 ZONED: PEC
 ELECTION DISTRICT 5 - HOWARD COUNTY, MARYLAND
 SHEET 59 OF 73

C-684
 RK&K PROJECT NUMBER
 21047.013
 SCALE:
 As Shown
 SDP-18-060

GENERAL NOTES


- TOPOGRAPHIC AND SURFACE INFORMATION SHOWN WAS OBTAINED FROM FIELD SURVEY BY RK&K, COMPLETED DECEMBER 23, 2021. UTILITY INFORMATION SHOWN WAS PROVIDED BY AHDATA ON FEBRUARY 4, 2022.
- IT IS THE CONTRACTOR'S RESPONSIBILITY TO FIELD VERIFY ACTUAL SITE CONDITIONS PRIOR TO THE START OF ANY WORK. THERE IS NO WARRANTY OR GUARANTEE ON THE COMPLETENESS OR CORRECTNESS OF THE EXISTING CONDITION INFORMATION. ANY DISCREPANCY FOUND SHALL BE BROUGHT TO THE IMMEDIATE ATTENTION OF THE ARCHITECT/ENGINEER PRIOR TO THE START OF ANY WORK.
- BEARINGS AND HORIZONTAL COORDINATES SHOWN ON THIS PLAN ARE BASED UPON MARYLAND STATE PLANE COORDINATE SYSTEM NAD83. VERTICAL ELEVATIONS SHOWN ARE BASED UPON VERTICAL DATUM NAVD83.
- THE LOCATION OF EXISTING UNDERGROUND UTILITIES IS SHOWN IN AN APPROXIMATE WAY ONLY, BASED UPON FIELD OBSERVATIONS AND RECORD DOCUMENTS. THEY HAVE NOT BEEN COMPARED TO OR VERIFIED WITH FIELD TEST PITS. THE CONTRACTOR SHALL BE RESPONSIBLE TO VERIFY TO HIS OWN SATISFACTION THE EXACT LOCATION, SIZE AND TYPE OF ALL EXISTING UNDERGROUND UTILITIES BEFORE COMMENCING ANY WORK. THE CONTRACTOR MUST NOTIFY THE UTILITY COMPANIES INVOLVED PRIOR TO THE START OF THE WORK. CONTRACTOR AGREES TO BE FULLY RESPONSIBLE FOR THE COST OF ANY AND ALL DAMAGES WHICH OCCUR AS A RESULT OF A FAILURE TO EXACTLY LOCATE AND PRESERVE ANY AND ALL EXISTING UTILITIES TO REMAIN.
- THE CONTRACTOR SHALL BE RESPONSIBLE FOR NOTIFYING "MISS UTILITY" AT 1-800-257-7777 FIVE DAYS PRIOR TO THE START OF ANY EXCAVATION WORK.
- THE CONTRACTOR SHALL VERIFY ALL EXISTING UTILITY INVERTS AND CLEARANCES FROM NEW WORK PRIOR TO START OF ANY WORK.
- THE CONTRACTOR SHALL STAKE OUT THE LOCATION OF ALL NEW CONSTRUCTION AND VERIFY ALL JURISDICTIONAL SETBACKS AND BUFFERS PRIOR TO START OF ANY WORK.
- EXISTING UTILITIES WHICH ARE NOT TO BE REMOVED OR ABANDONED SHALL REMAIN OPERATIONAL AT ALL TIMES. APPROPRIATE EXISTING UTILITIES SHALL REMAIN IN SERVICE UNTIL REPLACEMENT/RELOCATED UTILITIES ARE OPERATIONAL.
- CONTRACTOR SHALL PROVIDE POSITIVE DRAINAGE AWAY FROM ALL EXISTING AND PROPOSED BUILDING ENTRANCES DURING ALL PHASES OF CONSTRUCTION UNLESS OTHERWISE NOTED IN THESE DOCUMENTS. CONTRACTOR SHALL NOTIFY ENGINEER / OWNER IF EXISTING OR PROPOSED CONDITIONS RESTRICT ABILITY TO ACHIEVE POSITIVE DRAINAGE FROM BUILDINGS PRIOR TO THE START OF CONSTRUCTION.
- SEE SHEET C-003 FOR FULL EXISTING AND PROPOSED FEATURES LEGEND.

| SITE SOILS SUMMARY TABLE | | | | | |
|-------------------------------|------|-------|-----|--------|----------|
| NAME | UNIT | Slope | HSG | HYDRIC | K FACTOR |
| Urban land-Udorthents complex | UD | 8-25% | D | No | Unrated |
| Manor loam | MaB | 3-8% | B | No | 0.24 |
| Manor loam | MaC | 8-15% | B | No | 0.28 |
| Glenville silt loam | GmB | 3-8% | C/D | No | 0.37 |

EROSION AND SEDIMENT CONTROL LEGEND

- LOD ——— LIMIT OF DISTURBANCE
- SSF ——— SUPER SILT FENCE
- SFOP ——— SILT FENCE ON PAVEMENT
- DF ——— DIVERSION FENCE
- SCE ——— STABILIZED CONSTRUCTION ENTRANCE
- COIP ——— CURB INLET PROTECTION
- COIP ——— COMBINATION INLET PROTECTION
- AGIP ——— AT-GRADE INLET PROTECTION
- SSD ——— SAME DAY STABILIZATION
- x ——— TEMPORARY CONSTRUCTION FENCE
- x ——— DRAINAGE AREA
- (shaded) ——— EXISTING STEEP SLOPES (>15%)
- (dashed) ——— PIPE TO BE REMOVED
- (dotted) ——— PROPERTY LINE

HOWARD SCD SIGNATURE BLOCK:
 This plan is approved for soil erosion and sediment control by the Howard Soil Conservation District.
Howard Soil Conservation District
 Date: 11/15/23

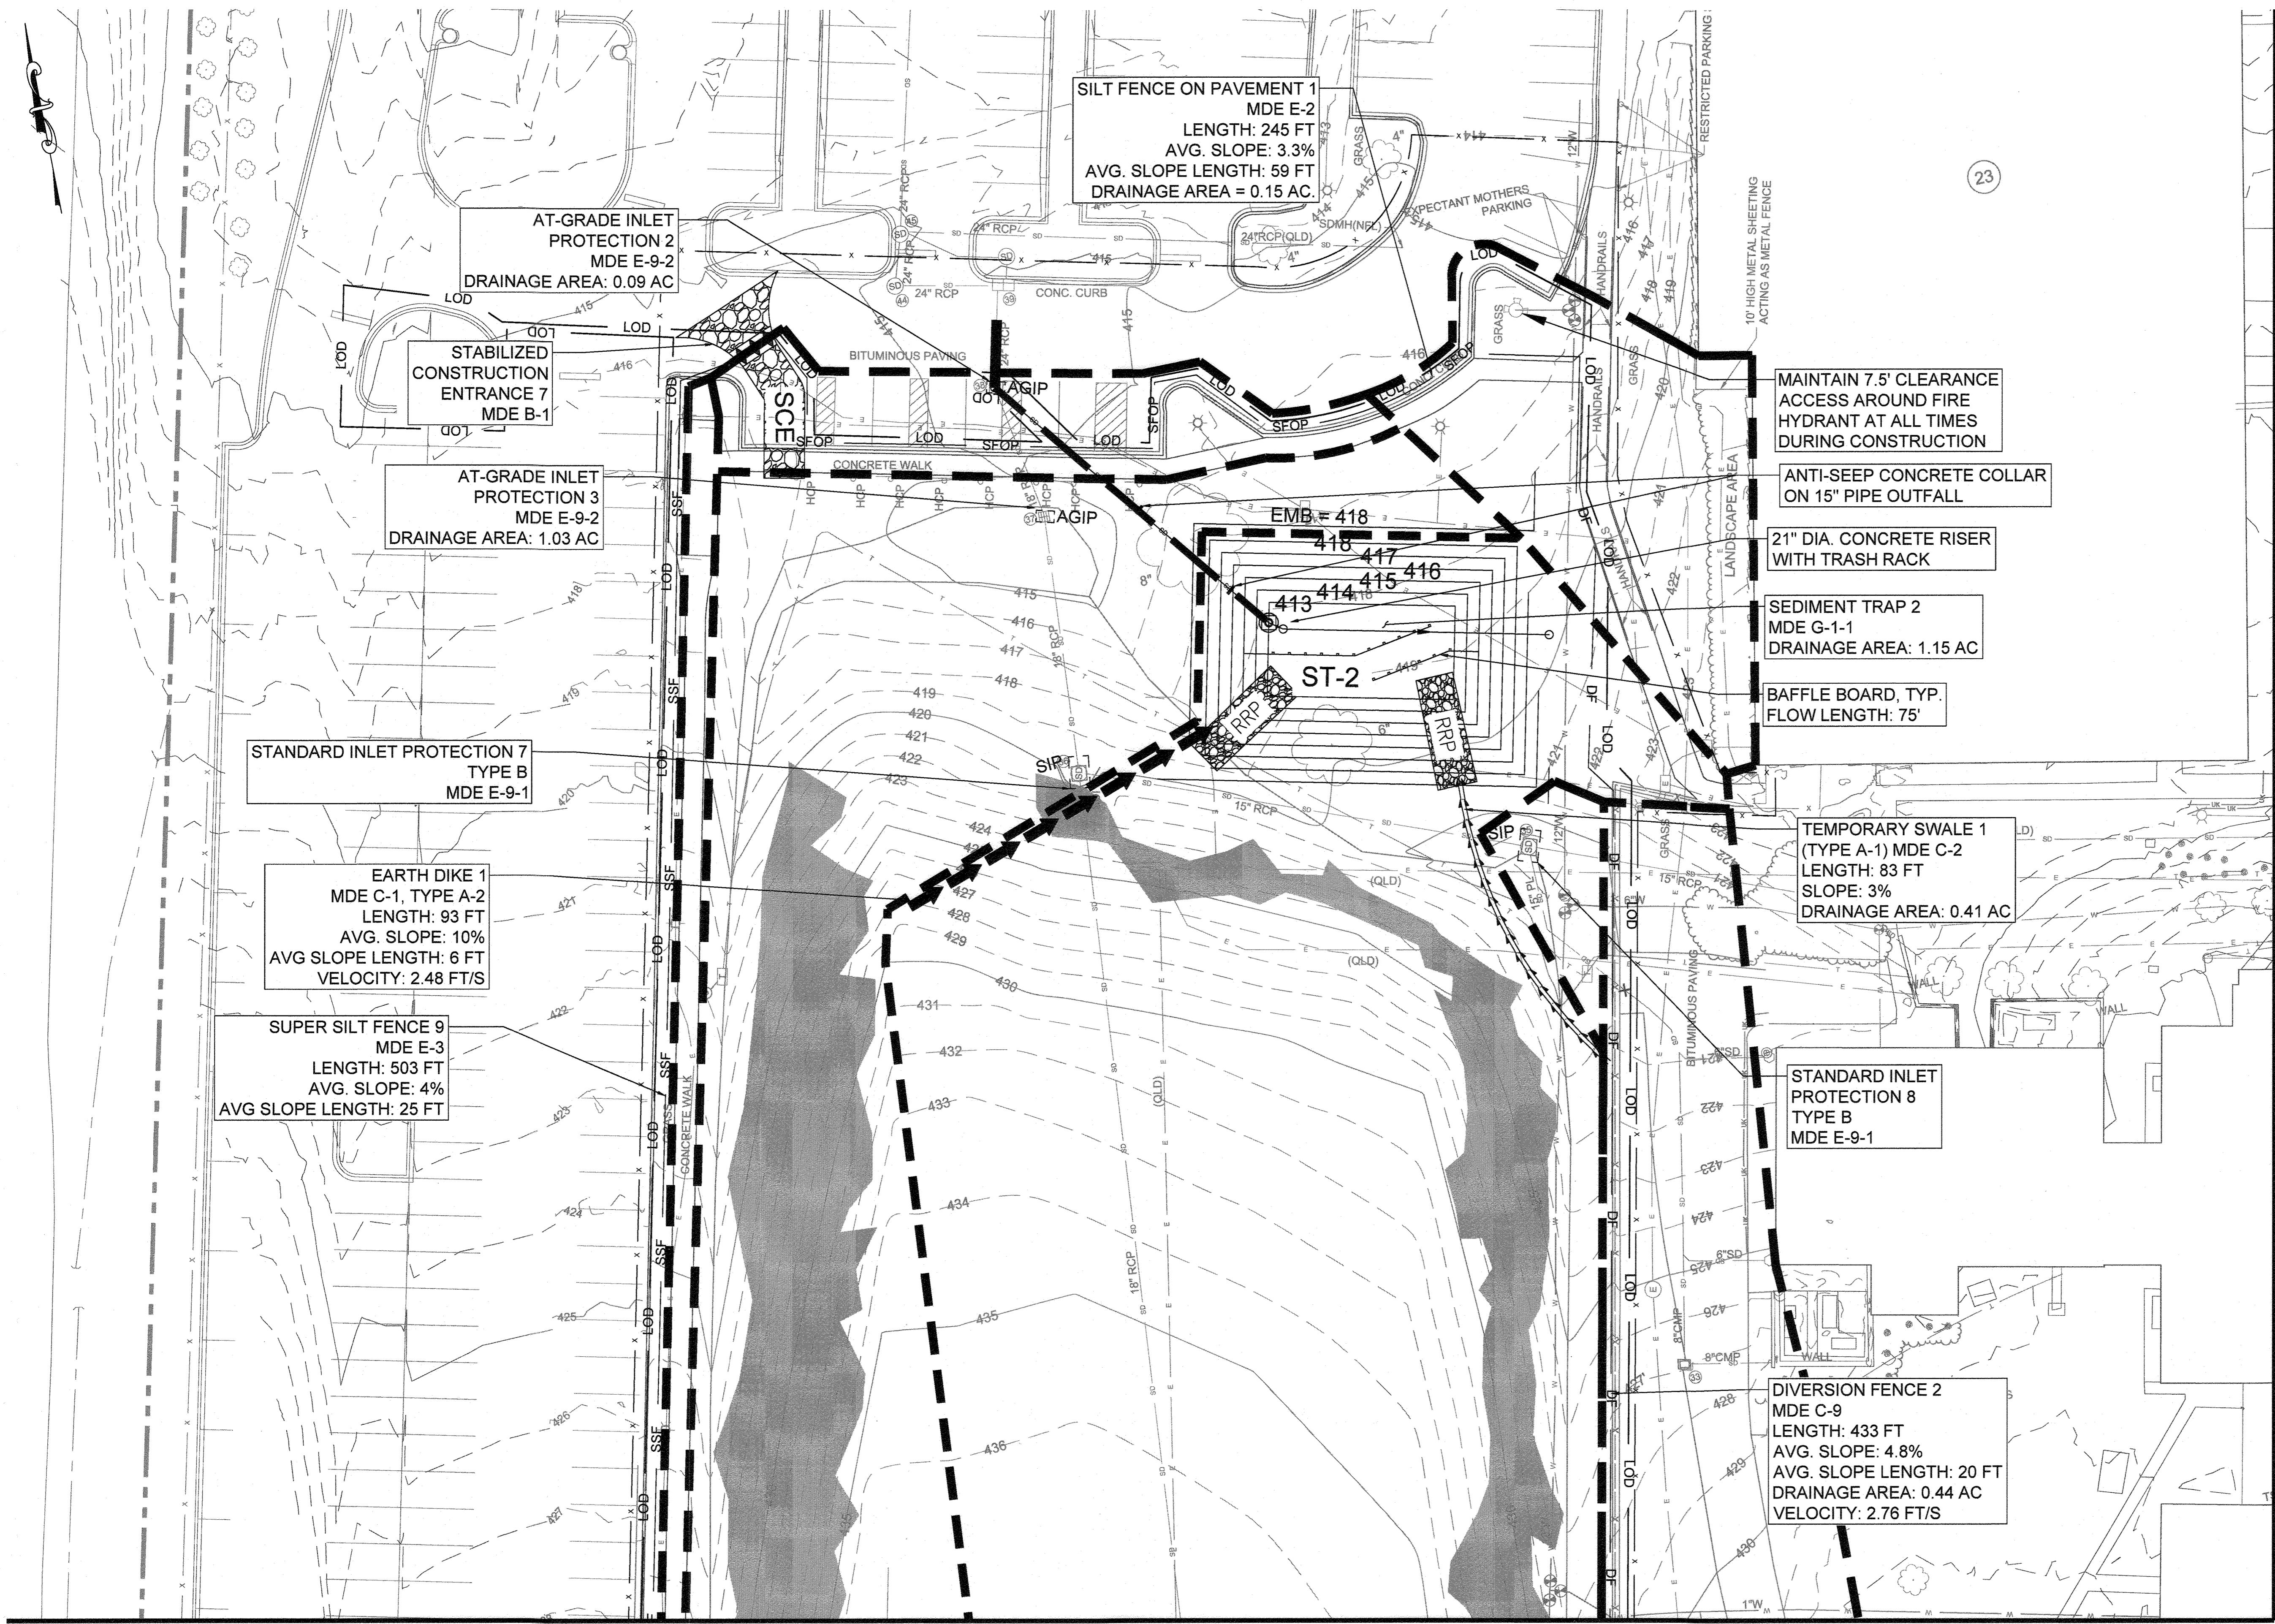

MATCHLINE - SEE SHEET C-684


▲ PURPOSE STATEMENT (11/1/23): DESIGN OF OUTDOOR TESTING AREA 3, INCLUDING THE SOURCE OF BORROW MATERIAL REFERRED TO AS THE EAST AND WEST BORROW AREAS.
 SCALE: 1" = 20'

C:\Users\DPILAC-1\AppData\Local\Temp\AcPublish_16752\C-681 - C-686 Erosion Sediment Control Plan - East Borrow Area (Phase 2A).dwg Oct 31, 2023 3:46pm dpilachowski

APPROVED: DEPARTMENT OF PLANNING AND ZONING
 Chief, Development Engineering Division
 Date: 12-5-23
 Chief, Division of Land Development
 Date: 2/22/24




PROFESSIONAL CERTIFICATION: I HEREBY CERTIFY THAT THESE DOCUMENTS WERE PREPARED OR APPROVED BY ME, AND THAT I AM A DULY LICENSED PROFESSIONAL ENGINEER UNDER THE LAWS OF THE STATE OF MARYLAND, LICENSE NO. 46492, EXPIRATION DATE: MAY 31, 2026.
Chabell M. ...

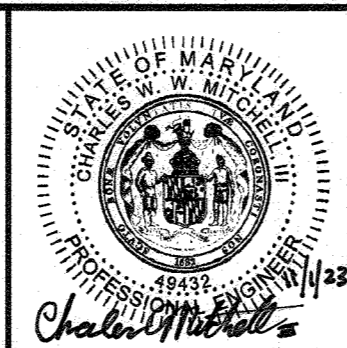

| | |
|-------------------|-----------------|
| DESIGN BY: SHK | DATE: 11/1/2023 |
| DRAWN BY: JMS/DTP | |
| CHECKED BY: CWWW | |
| BY NO. | REVISION |
| | DATE |

OWNER/DEVELOPER
 JOHNS HOPKINS
 APPLIED PHYSICS LABORATORY
 11100 JOHNS HOPKINS ROAD
 LAUREL, MARYLAND 20723

EROSION SEDIMENT CONTROL PLAN - WEST BORROW AREA (ESC PHASE 2A)
 JOHNS HOPKINS UNIVERSITY - APPLIED PHYSICS LABORATORY
OUTDOOR TESTING AREAS
 11100 JOHNS HOPKINS ROAD
 PARCEL: 123 GRID: 16 ZONED: PEG
 ELECTION DISTRICT 5 - HOWARD COUNTY, MARYLAND
 SHEET 60 OF 73
 SCALE: As Shown

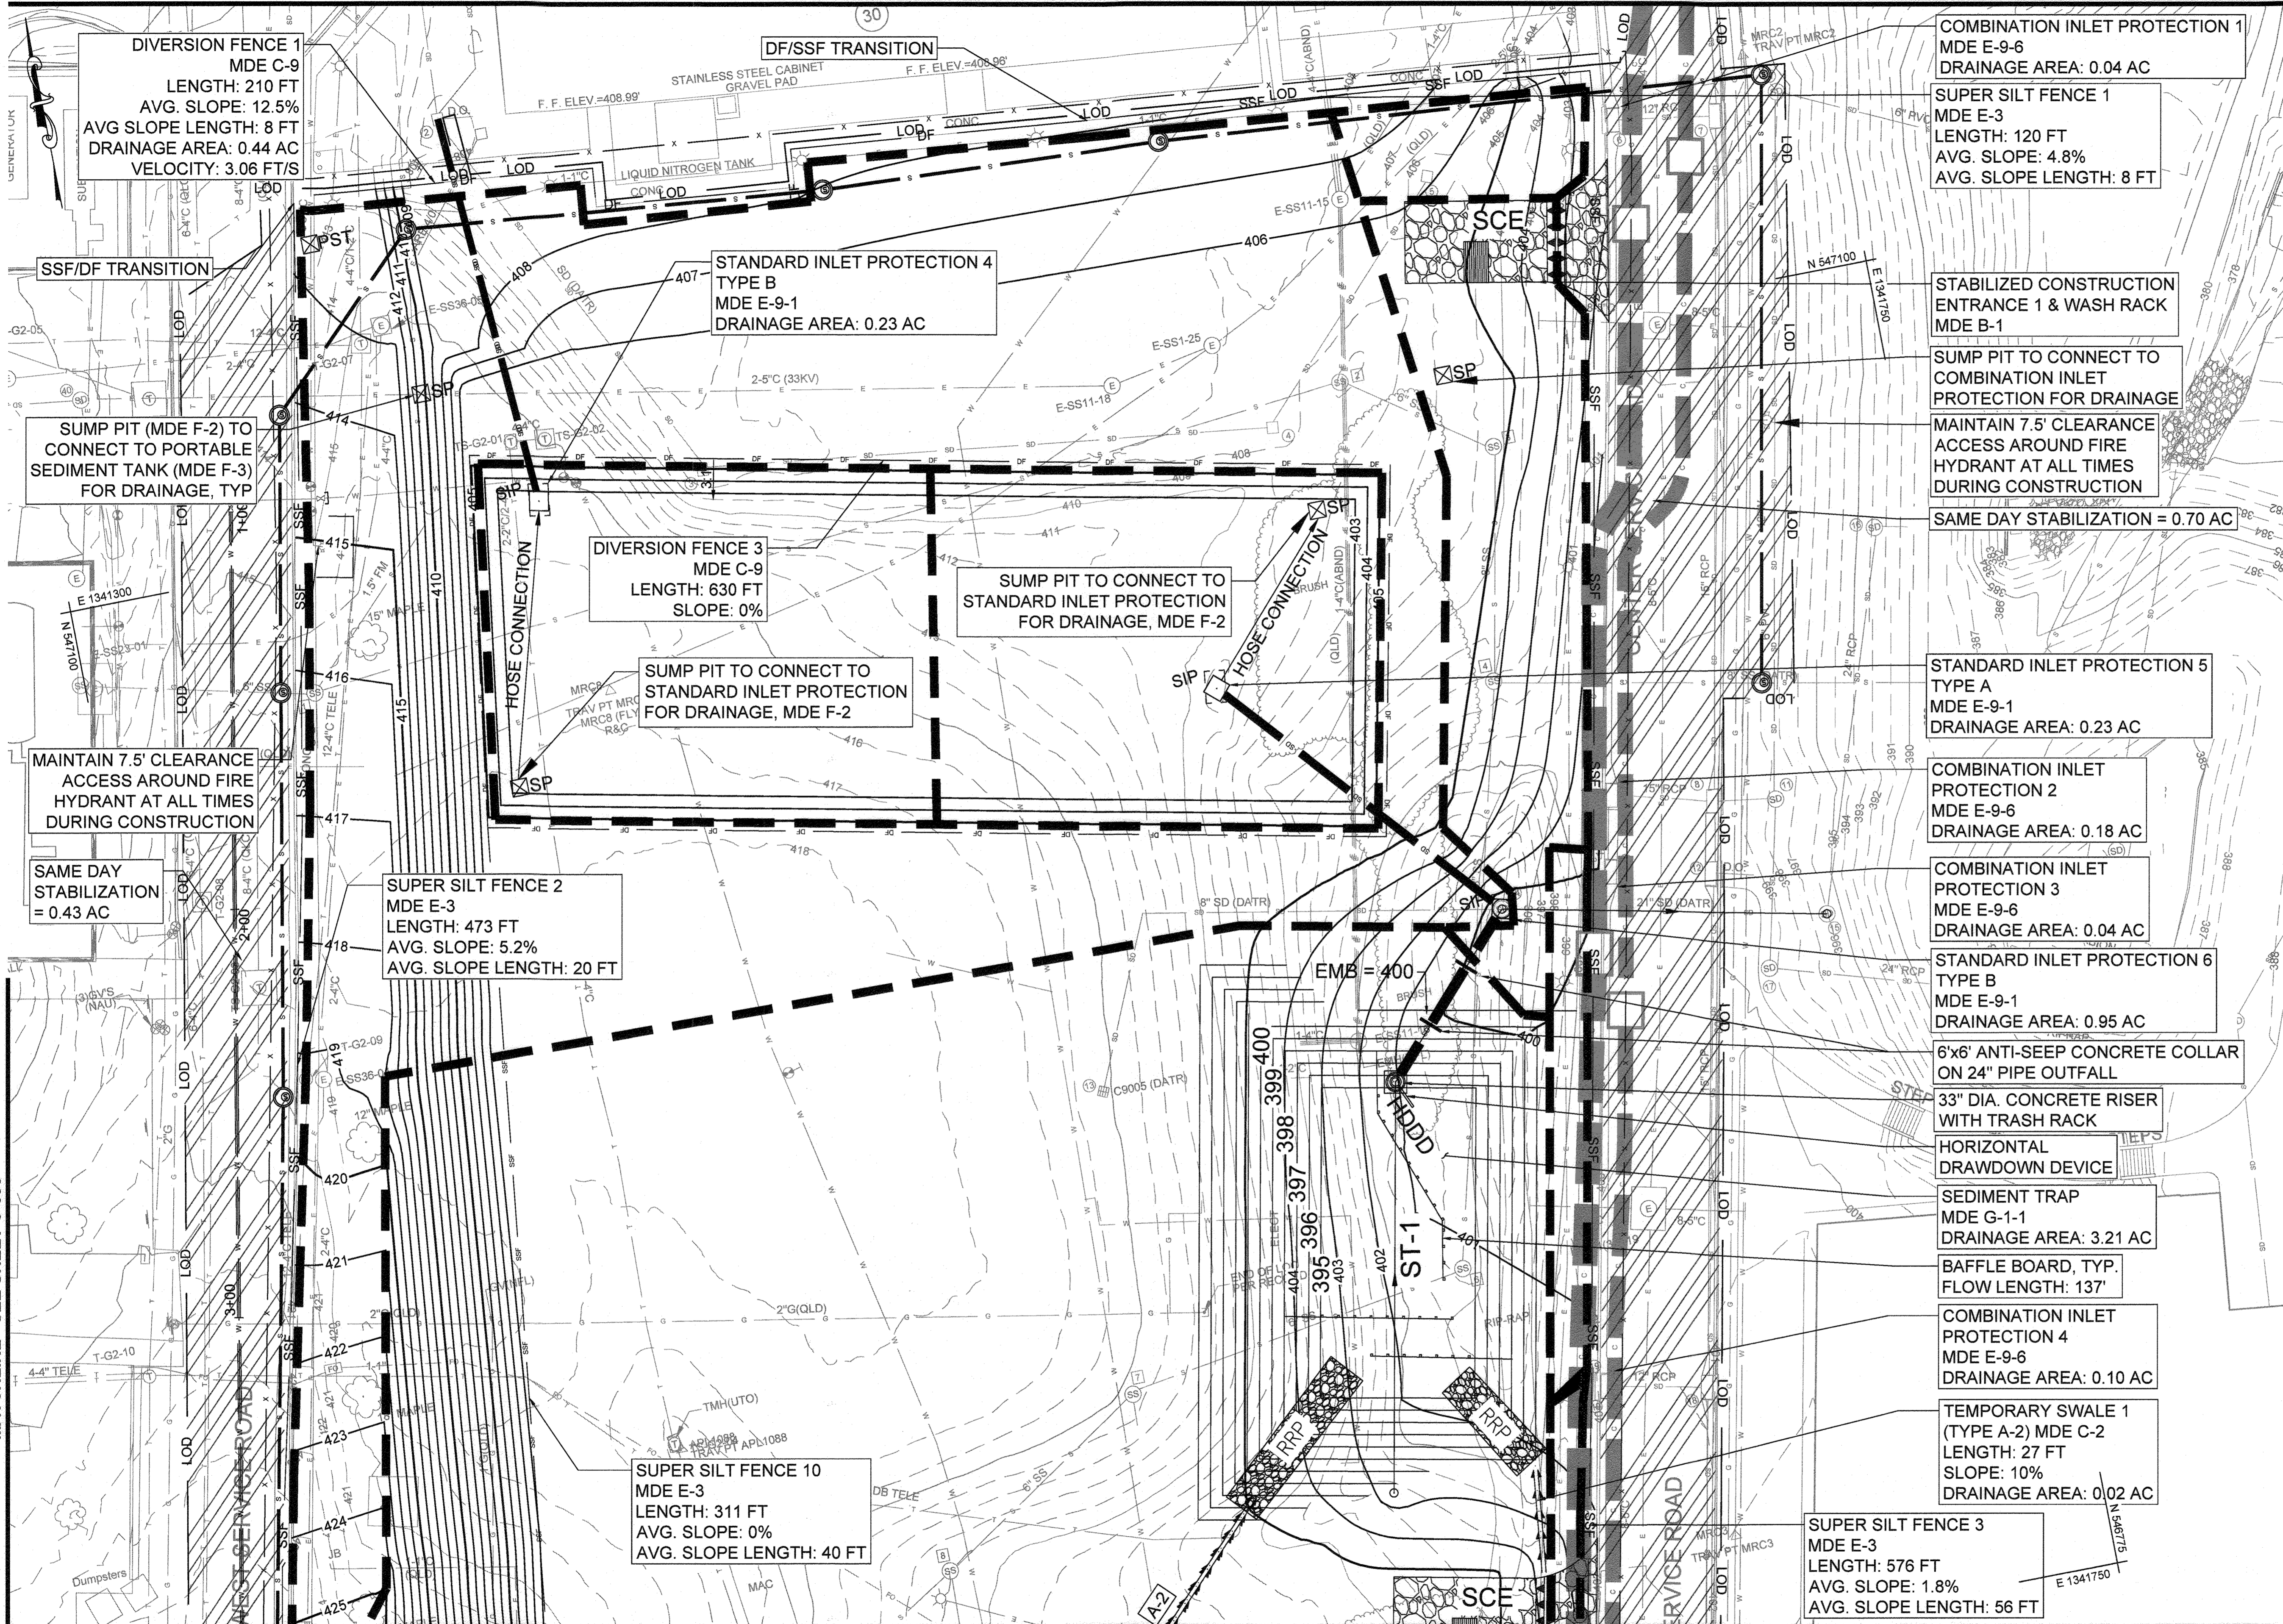

- TOPOGRAPHIC AND SURFACE INFORMATION SHOWN WAS OBTAINED FROM FIELD SURVEY BY RK&K, COMPLETED DECEMBER 23, 2021. UTILITY INFORMATION SHOWN WAS PROVIDED BY AII/DATA ON FEBRUARY 4, 2022.
- IT IS THE CONTRACTOR'S RESPONSIBILITY TO FIELD VERIFY ACTUAL SITE CONDITIONS PRIOR TO THE START OF ANY WORK. THERE IS NO WARRANTY OR GUARANTEE ON THE COMPLETENESS OR CORRECTNESS OF THE EXISTING CONDITION INFORMATION. ANY DISCREPANCY FOUND SHALL BE BROUGHT TO THE IMMEDIATE ATTENTION OF THE ARCHITECT/ENGINEER PRIOR TO THE START OF ANY WORK.
- BEARINGS AND HORIZONTAL COORDINATES SHOWN ON THIS PLAN ARE BASED UPON MARYLAND STATE PLANE COORDINATE SYSTEM NAD83. VERTICAL ELEVATIONS SHOWN ARE BASED UPON VERTICAL DATUM NAVD83.
- THE LOCATION OF EXISTING UNDERGROUND UTILITIES IS SHOWN IN AN APPROXIMATE WAY ONLY. BASED UPON FIELD OBSERVATIONS AND RECORD DOCUMENTS. THEY HAVE NOT BEEN COMPARED TO OR VERIFIED WITH FIELD TEST PITS. THE CONTRACTOR SHALL BE RESPONSIBLE TO VERIFY TO HIS OWN SATISFACTION THE EXACT LOCATION, SIZE AND TYPE OF ALL EXISTING UNDERGROUND UTILITIES BEFORE COMMENCING ANY WORK. THE CONTRACTOR MUST NOTIFY THE UTILITY COMPANIES INVOLVED PRIOR TO THE START OF THE WORK. CONTRACTOR AGREES TO BE FULLY RESPONSIBLE FOR THE COST OF ANY AND ALL DAMAGES WHICH OCCUR AS A RESULT OF A FAILURE TO EXACTLY LOCATE AND PRESERVE ANY AND ALL EXISTING UTILITIES TO REMAIN.
- THE CONTRACTOR SHALL BE RESPONSIBLE FOR NOTIFYING "MISS UTILITY" AT 1-800-257-7777 FIVE DAYS PRIOR TO THE START OF ANY EXCAVATION WORK.
- THE CONTRACTOR SHALL VERIFY ALL EXISTING UTILITY INVERTS AND CLEARANCES FROM NEW WORK PRIOR TO START OF ANY WORK.
- THE CONTRACTOR SHALL STAKE OUT THE LOCATION OF ALL NEW CONSTRUCTION AND VERIFY ALL JURISDICTIONAL SETBACKS AND BUFFERS PRIOR TO START OF ANY WORK.
- EXISTING UTILITIES WHICH ARE NOT TO BE REMOVED OR ABANDONED SHALL REMAIN OPERATIONAL AT ALL TIMES. APPROPRIATE EXISTING UTILITIES SHALL REMAIN IN SERVICE UNTIL REPLACEMENT/RELOCATED UTILITIES ARE OPERATIONAL.
- CONTRACTOR SHALL PROVIDE POSITIVE DRAINAGE AWAY FROM ALL EXISTING AND PROPOSED BUILDING ENTRANCES DURING ALL PHASES OF CONSTRUCTION, UNLESS OTHERWISE NOTED IN THESE DOCUMENTS. CONTRACTOR SHALL NOTIFY ENGINEER/OWNER IF EXISTING OR PROPOSED CONDITIONS RESTRICT ABILITY TO ACHIEVE POSITIVE DRAINAGE FROM BUILDINGS PRIOR TO THE START OF CONSTRUCTION.
- SEE SHEET C-603 FOR FULL EXISTING AND PROPOSED FEATURES LEGEND

SITE SOILS SUMMARY TABLE

| NAME | UNIT | Slope | HSG | HYDRIC | K FACTOR |
|-------------------------------|------|-------|-----|--------|----------|
| Urban land-Udorthents complex | UD | 8-25% | D | No | Unrated |
| Manor loam | MaB | 3-8% | B | No | 0.24 |
| Manor loam | MaC | 8-15% | B | No | 0.28 |
| Glennville silt loam | GmB | 3-8% | C/D | No | 0.37 |

SEQUENCE OF CONSTRUCTION: PHASE 2B

- COMPLETE SEQUENCE OF CONSTRUCTION - PHASE 2A (SHEET C-681), 24 DAYS
- BEGIN DEMOLITION AND/OR RELOCATION OF EXISTING STRUCTURES, PAVING, CURB, AND UTILITY SERVICES. 30 DAYS
- REMOVE PHASE 2A EROSION AND SEDIMENT CONTROL MEASURES UPON COMPLETION OF ASSOCIATED UTILITY REMOVAL: AT-GRADE INLET PROTECTION 1, AND STANDARD INLET PROTECTION 1 THRU 3.

LEAVE IN PLACE THE REMAINING PHASE 2A EROSION AND SEDIMENT CONTROL DEVICES SUCH AS STABILIZED CONSTRUCTION ENTRANCES, SILT FENCE, SUPER SILT FENCE, SILT FENCE ON PAVEMENT AND DIVERSION FENCES, EARTH DIKES, INLET PROTECTIONS, TEMPORARY SWALES AND SEDIMENT TRAPS. 3 DAYS
- INSTALL PROPOSED STORM DRAIN IN BORROW AREA. INSTALL REMAINING UTILITIES IN SURROUNDING SERVICE ROADS USING TRENCHES AND STABILIZE AREAS AT THE END OF EACH WORK DAY. 30 DAYS
- INSTALL PHASE 2B EROSION AND SEDIMENT CONTROL MEASURES AS SHOWN ON PLAN VIEW: STANDARD INLET PROTECTION 4 THRU 6, SUPER SILT FENCE 10 THRU 11, AND SUMP PITS CONNECTED TO PORTABLE SEDIMENT TANKS. 2 DAYS
- BEGIN MASS GRADING AFTER CLEARING AND GRUBBING IN BORROW AREAS WITH TEMPORARY STABILIZATION AS REQUIRED AND NECESSARY. EXTEND TEMPORARY SWALE TO ADJACENT AREA BY SUBSTATION. 60 DAYS
- UPON COMPLETION OF PREVIOUS STEPS, AND WITH APPROVAL OF THE SEDIMENT CONTROL INSPECTOR, PROCEED TO PHASE 2C (SHEET C-691 THRU 695). 2 DAYS

EROSION AND SEDIMENT CONTROL LEGEND

| | |
|--------|----------------------------------|
| — LOD | — LIMIT OF DISTURBANCE |
| — SSF | — SUPER SILT FENCE |
| — SFOP | — SILT FENCE ON PAVEMENT |
| — DF | — DIVERSION FENCE |
| | STABILIZED CONSTRUCTION ENTRANCE |
| | CURB INLET PROTECTION |
| | COMBINATION INLET PROTECTION |
| | AT-GRADE INLET PROTECTION |
| | SAME DAY STABILIZATION |
| | TEMPORARY CONSTRUCTION FENCE |
| | DRAINAGE AREA |
| | EXISTING STEEP SLOPES (>15%) |
| | PIPE TO BE REMOVED |
| | PROPERTY LINE |

HOWARD SCD SIGNATURE BLOCK:
 This plan is approved for soil erosion and sediment control by the Howard Soil Conservation District.
Alexander Baidis 11/15/23
 Howard Soil Conservation District Date



PURPOSE STATEMENT (11/1/23): DESIGN OF OUTDOOR TESTING AREA 3, INCLUDING THE SOURCE OF BORROW MATERIAL REFERRED TO AS THE EAST AND WEST BORROW AREAS.

C:\Users\DPILAC\1\AppData\Local\Temp\AcPublish_16752\C-686 - C-690 Erosion Sediment Control Plan - East Borrow Area (Phase 2B).dwg Oct 31, 2023 3:27pm dplachowski

APPROVED: DEPARTMENT OF PLANNING AND ZONING
 Chief, Development Engineering Division
 Date: 12-5-23
 Chief, Division of Land Development
 Date: 2/22/24

RK&K
 RUMMEL, KLEPPER & KAHL, LLP
 ENGINEERS/CONSTRUCTION MANAGERS/PLANNERS/SCIENTISTS
 RESPONSIVE PEOPLE • CREATIVE SOLUTIONS
 700 East Pratt Street, Suite 500
 Baltimore, MD 21202
 PH: 410.728.2900
 www.rk-k.com

DESIGN BY: SHK
 DRAWN BY: JMS/DTP
 CHECKED BY: CWMM
 DATE: 11/1/2023

| BY | NO. | REVISION | DATE |
|----|-----|---|---------|
| | | New Sheet - OTA-3 and Borrow Area Modifications | 11/1/23 |


OWNER/DEVELOPER
JOHNS HOPKINS APPLIED PHYSICS LABORATORY
 11100 JOHNS HOPKINS ROAD
 LAUREL, MARYLAND 20723

EROSION SEDIMENT CONTROL PLAN - EAST BORROW AREA (ESC PHASE 2B)
 JOHNS HOPKINS UNIVERSITY - APPLIED PHYSICS LABORATORY
OUTDOOR TESTING AREAS
 11100 JOHNS HOPKINS ROAD
 PARCEL: 123 GR1
 ZONED: PEG
 ELECTION DISTRICT 5 - HOWARD COUNTY, MARYLAND
 SHEET 61 OF 73
 SCALE: As Shown
 SDP-18-060

C-686
 RK&K PROJECT NUMBER 21047.013
 SCALE: As Shown

MATCHLINE - SEE SHEET C-690

MATCHLINE - SEE SHEET C-689

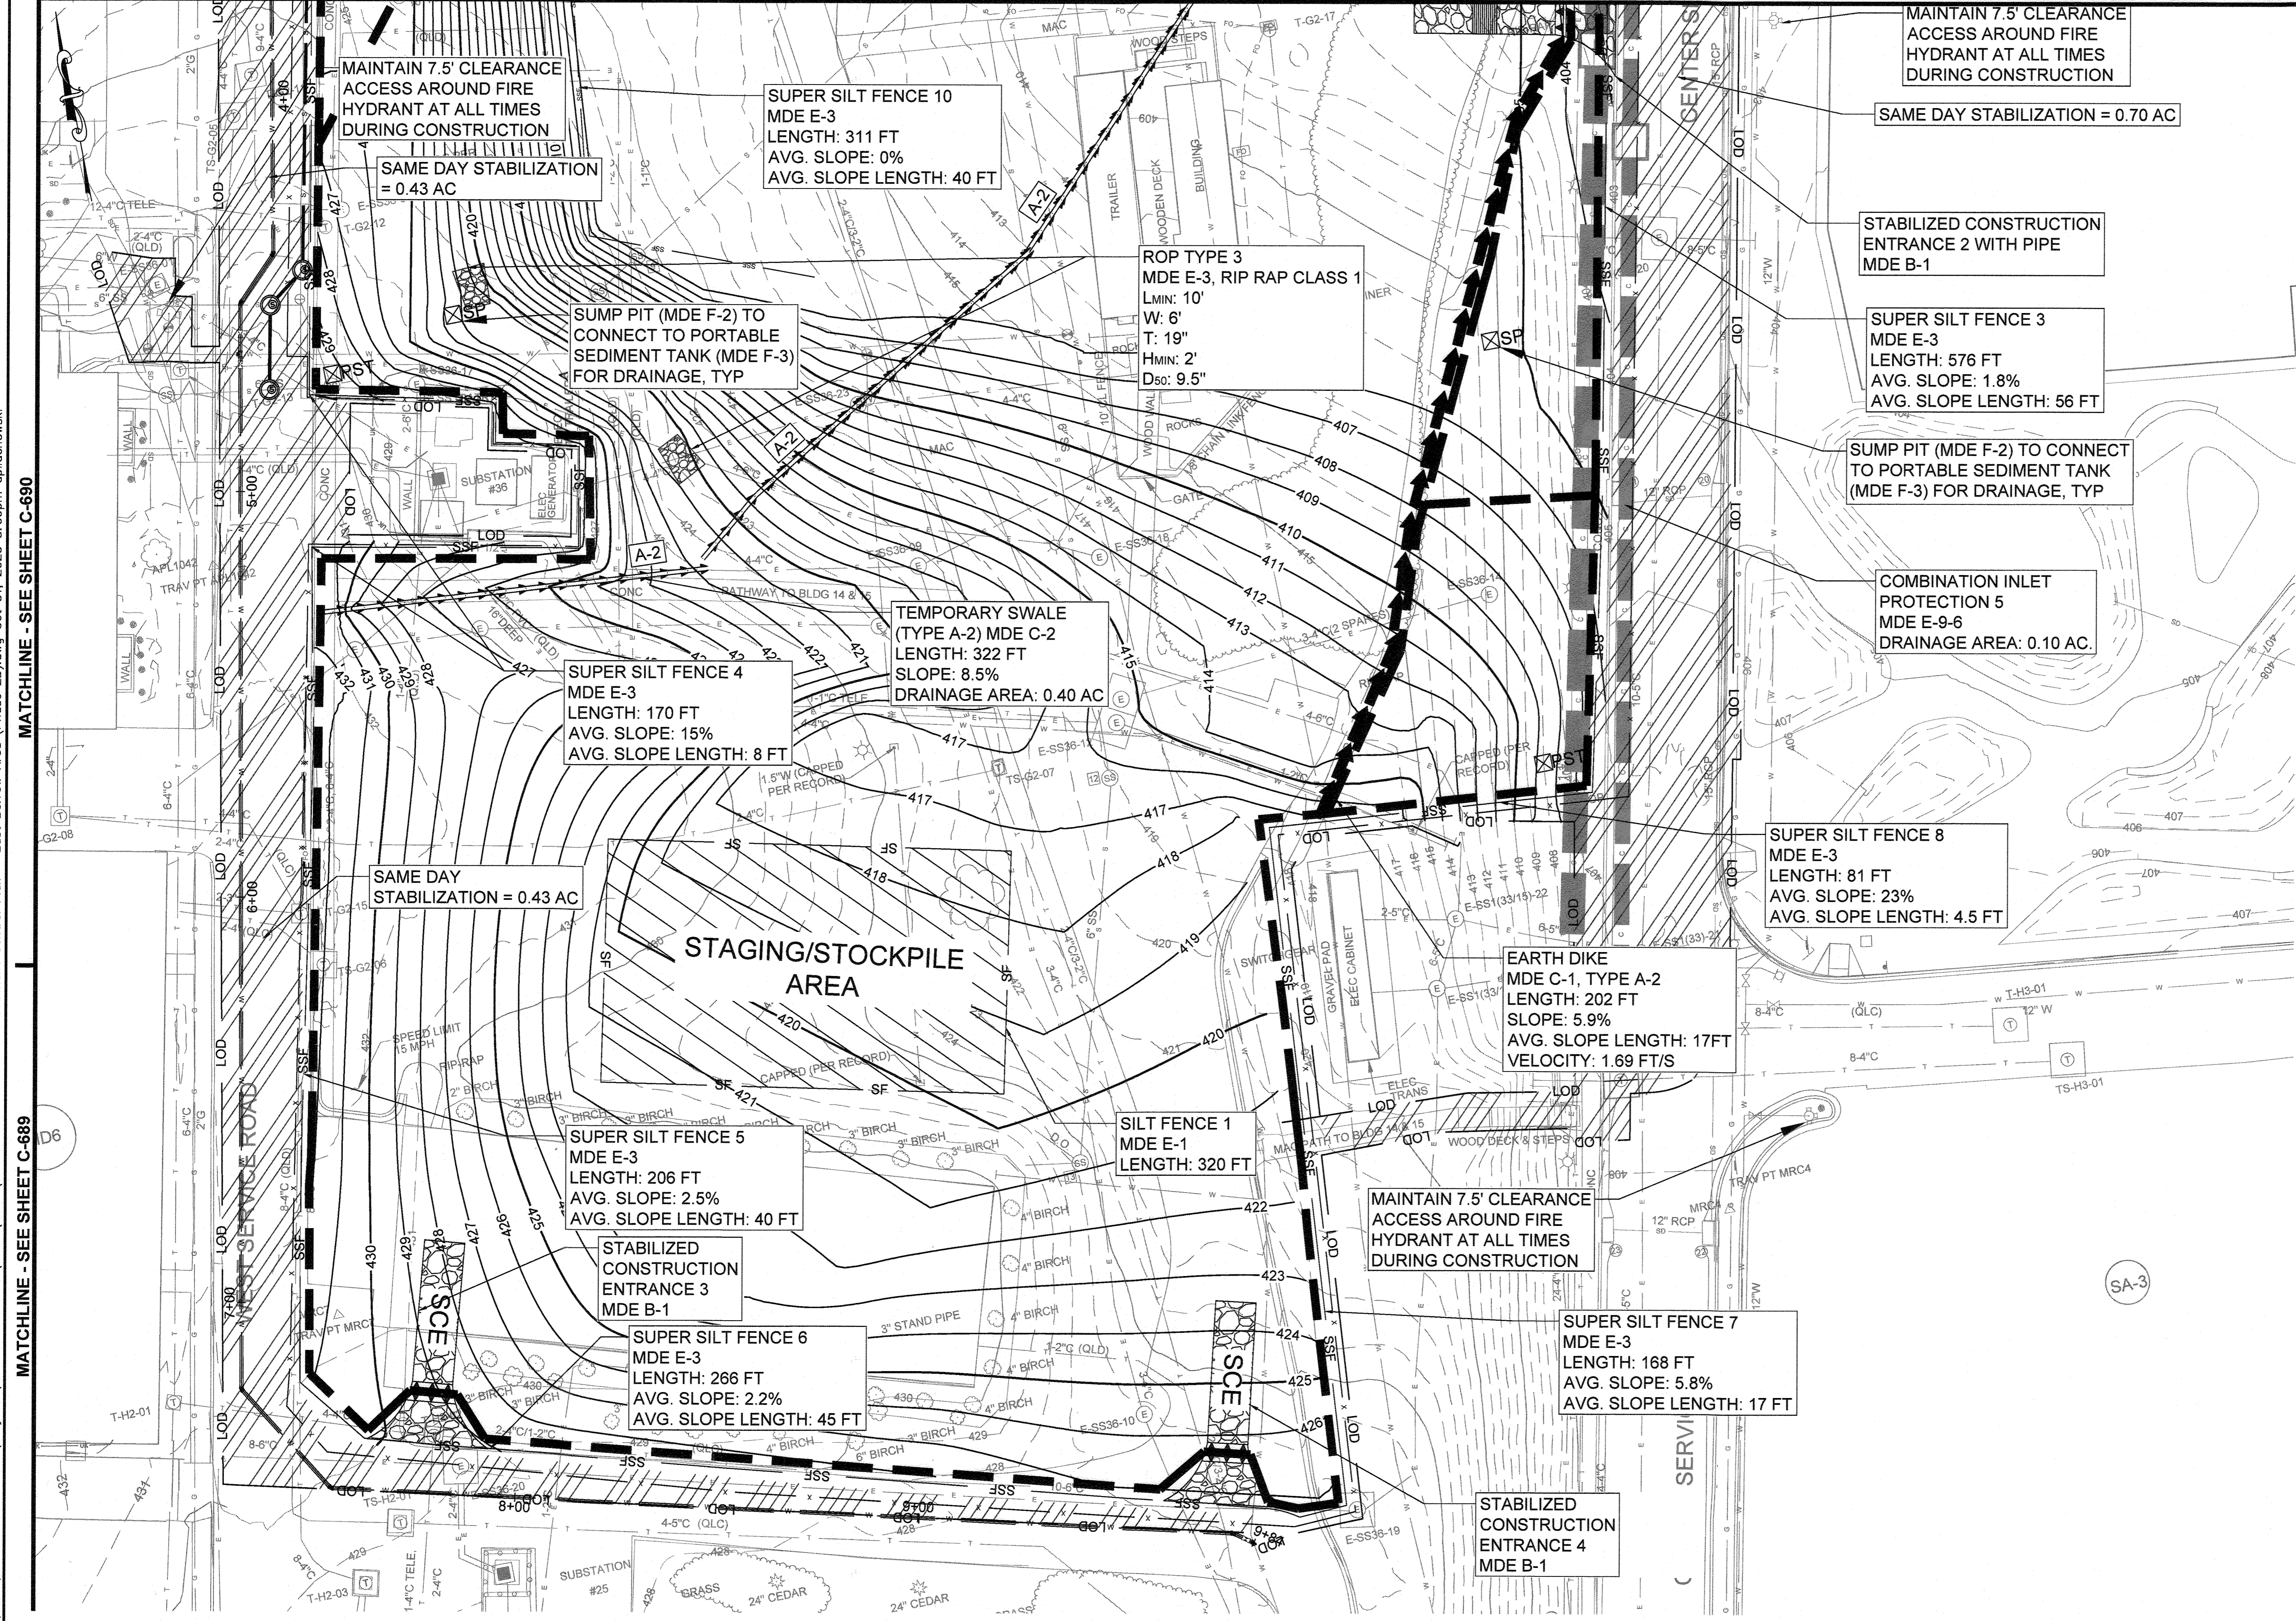


- TOPOGRAPHIC AND SURFACE INFORMATION SHOWN WAS OBTAINED FROM FIELD SURVEY BY RK&K, COMPLETED DECEMBER 23, 2021. UTILITY INFORMATION SHOWN WAS PROVIDED BY AII/DATA ON FEBRUARY 4, 2022.
- IT IS THE CONTRACTOR'S RESPONSIBILITY TO FIELD VERIFY ACTUAL SITE CONDITIONS PRIOR TO THE START OF ANY WORK. THERE IS NO WARRANTY OR GUARANTEE ON THE COMPLETENESS OR CORRECTNESS OF THE EXISTING CONDITION INFORMATION. ANY DISCREPANCY FOUND SHALL BE BROUGHT TO THE IMMEDIATE ATTENTION OF THE ARCHITECT/ENGINEER PRIOR TO THE START OF ANY WORK.
- BEARINGS AND HORIZONTAL COORDINATES SHOWN ON THIS PLAN ARE BASED UPON MARYLAND STATE PLANE COORDINATE SYSTEM NAD83. VERTICAL ELEVATIONS SHOWN ARE BASED UPON VERTICAL DATUM NAVD83.
- THE LOCATION OF EXISTING UNDERGROUND UTILITIES IS SHOWN IN AN APPROXIMATE WAY ONLY, BASED UPON FIELD OBSERVATIONS AND RECORD DOCUMENTS. THEY HAVE NOT BEEN COMPARED TO OR VERIFIED WITH FIELD TEST PITS. THE CONTRACTOR SHALL BE RESPONSIBLE TO VERIFY TO HIS OWN SATISFACTION THE EXACT LOCATION, SIZE AND TYPE OF ALL EXISTING UNDERGROUND UTILITIES BEFORE COMMENCING ANY WORK. THE CONTRACTOR MUST NOTIFY THE UTILITY COMPANIES INVOLVED PRIOR TO THE START OF THE WORK. CONTRACTOR AGREES TO BE FULLY RESPONSIBLE FOR THE COST OF ANY AND ALL DAMAGES WHICH OCCUR AS A RESULT OF A FAILURE TO EXACTLY LOCATE AND PRESERVE ANY AND ALL EXISTING UTILITIES TO REMAIN.
- THE CONTRACTOR SHALL BE RESPONSIBLE FOR NOTIFYING "MISS UTILITY" AT 1-800-257-7777 FIVE DAYS PRIOR TO THE START OF ANY EXCAVATION WORK.
- THE CONTRACTOR SHALL VERIFY ALL EXISTING UTILITY INVERTS AND CLEARANCES FROM NEW WORK PRIOR TO START OF ANY WORK.
- THE CONTRACTOR SHALL STAKE OUT THE LOCATION OF ALL NEW CONSTRUCTION AND VERIFY ALL JURISDICTIONAL SETBACKS AND BUFFERS PRIOR TO START OF ANY WORK.
- EXISTING UTILITIES WHICH ARE NOT TO BE REMOVED OR ABANDONED SHALL REMAIN OPERATIONAL AT ALL TIMES. APPROPRIATE EXISTING UTILITIES SHALL REMAIN IN SERVICE UNTIL REPLACEMENT/RELOCATED UTILITIES ARE OPERATIONAL.
- CONTRACTOR SHALL PROVIDE POSITIVE DRAINAGE AWAY FROM ALL EXISTING AND PROPOSED BUILDING ENTRANCES DURING ALL PHASES OF CONSTRUCTION, UNLESS OTHERWISE NOTED IN THESE DOCUMENTS. CONTRACTOR SHALL NOTIFY ENGINEER / OWNER IF EXISTING OR PROPOSED CONDITIONS RESTRICT ABILITY TO ACHIEVE POSITIVE DRAINAGE FROM BUILDINGS PRIOR TO THE START OF CONSTRUCTION.
- SEE SHEET C-603 FOR FULL EXISTING AND PROPOSED FEATURES LEGEND


| SITE SOILS SUMMARY TABLE | | | | | |
|-------------------------------|------|-------|-----|--------|----------|
| NAME | UNIT | Slope | HSG | HYDRIC | K FACTOR |
| Urban land-Udorthents complex | UdD | 8-25% | D | No | Unrated |
| Manor loam | MaB | 3-8% | B | No | 0.24 |
| Manor loam | MaC | 8-15% | B | No | 0.28 |
| Glenville silt loam | GmB | 3-8% | C/D | No | 0.37 |

EROSION AND SEDIMENT CONTROL LEGEND

- LOD LIMIT OF DISTURBANCE
- SSF SUPER SILT FENCE
- SFOP SILT FENCE ON PAVEMENT
- DF DIVERSION FENCE
- SCEN STABILIZED CONSTRUCTION ENTRANCE
- CIP CURB INLET PROTECTION
- COIP COMBINATION INLET PROTECTION
- AGIP AT-GRADE INLET PROTECTION
- SAME DAY STABILIZATION
- TEMPORARY CONSTRUCTION FENCE
- DRAINAGE AREA
- EXISTING STEEP SLOPES (>15%)
- PIPE TO BE REMOVED
- PROPERTY LINE

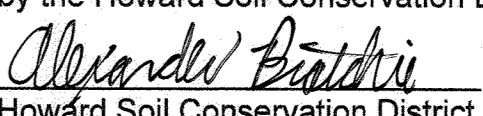HOWARD SCD SIGNATURE BLOCK:
 This plan is approved for soil erosion and sediment control by the Howard Soil Conservation District.

 Date: 11/15/23

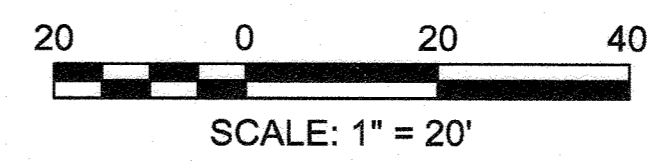
4 PURPOSE STATEMENT (11/1/23) DESIGN OF OUTDOOR TESTING AREA 3, INCLUDING THE SOURCE OF BORROW MATERIAL, REFERRED TO AS THE EAST AND WEST BORROW AREAS.



APPROVED: DEPARTMENT OF PLANNING AND ZONING
 Chief, Development Engineering Division
 Chief, Division of Land Development
 Director

RK&K
 RUSSELL, KLEPPER & KAHL, LLP
 ENGINEERS, ARCHITECTS, PLANNERS, ENVIRONMENTAL SCIENTISTS
 RESPONSIVE PEOPLE • CREATIVE SOLUTIONS
 700 East Pratt Street, Suite 500
 Baltimore, MD 21202
 PH: 410.728.2900 www.rkk.com

PROFESSIONAL CERTIFICATION: I HEREBY CERTIFY THAT THESE DOCUMENTS WERE PREPARED OR APPROVED BY ME, AND THAT I AM A DULY LICENSED PROFESSIONAL ENGINEER UNDER THE LAWS OF THE STATE OF MARYLAND, LICENSE NO. 48432, EXPIRATION DATE: MAY 31, 2024.



| | | | |
|-------------|-----------|-----------|-----------|
| DESIGN BY: | SHK | DATE: | 11/1/2023 |
| DRAWN BY: | JMS/DTP | BY: | NO. |
| CHECKED BY: | CWWM | NO. | |
| DATE: | 11/1/2023 | REVISION: | |
| NO. | | DATE: | |

OWNER/DEVELOPER
JOHNS HOPKINS APPLIED PHYSICS LABORATORY
 11100 JOHNS HOPKINS ROAD
 LAUREL, MARYLAND 20723

EROSION SEDIMENT CONTROL PLAN - EAST BORROW AREA (ESC PHASE 2B)
 JOHNS HOPKINS UNIVERSITY - APPLIED PHYSICS LABORATORY
OUTDOOR TESTING AREAS

11100 JOHNS HOPKINS ROAD
 TAX MAP 41 PARCEL: 123 GRID: 15 ZONED: PEC
 ELECTION DISTRICT 5 - HOWARD COUNTY, MARYLAND
 SHEET 62 OF 73

SCALE: As Shown

C-687
 RK&K PROJECT NUMBER 21047.013
 SCALE: As Shown



GENERAL NOTES

- TOPOGRAPHIC AND SURFACE INFORMATION SHOWN WAS OBTAINED FROM FIELD SURVEY BY RK&K COMPLETED DECEMBER 23, 2021. UTILITY INFORMATION SHOWN WAS PROVIDED BY AII/DATA ON FEBRUARY 4, 2022.
- IT IS THE CONTRACTOR'S RESPONSIBILITY TO FIELD VERIFY ACTUAL SITE CONDITIONS PRIOR TO THE START OF ANY WORK. THERE IS NO WARRANTY OR GUARANTEE ON THE COMPLETENESS OR CORRECTNESS OF THE EXISTING CONDITION INFORMATION. ANY DISCREPANCY FOUND SHALL BE BROUGHT TO THE IMMEDIATE ATTENTION OF THE ARCHITECT/ENGINEER PRIOR TO THE START OF ANY WORK.
- BEARINGS AND HORIZONTAL COORDINATES SHOWN ON THIS PLAN ARE BASED UPON MARYLAND STATE PLANE COORDINATE SYSTEM NAD83. VERTICAL ELEVATIONS SHOWN ARE BASED UPON VERTICAL DATUM NAVD88.
- THE LOCATION OF EXISTING UNDERGROUND UTILITIES IS SHOWN IN AN APPROXIMATE WAY ONLY. BASED UPON FIELD OBSERVATIONS AND RECORD DOCUMENTS. THEY HAVE NOT BEEN COMPARED TO OR VERIFIED WITH FIELD TEST PITS. THE CONTRACTOR SHALL BE RESPONSIBLE TO VERIFY TO HIS OWN SATISFACTION THE EXACT LOCATION, SIZE AND TYPE OF ALL EXISTING UNDERGROUND UTILITIES BEFORE COMMENCING ANY WORK. THE CONTRACTOR MUST NOTIFY THE UTILITY COMPANIES INVOLVED PRIOR TO THE START OF THE WORK. CONTRACTOR AGREES TO BE FULLY RESPONSIBLE FOR THE COST OF ANY AND ALL DAMAGES WHICH OCCUR AS A RESULT OF A FAILURE TO EXACTLY LOCATE AND PRESERVE ANY AND ALL EXISTING UTILITIES TO REMAIN.
- THE CONTRACTOR SHALL BE RESPONSIBLE FOR NOTIFYING "MISS UTILITY" AT 1-800-257-7777 FIVE DAYS PRIOR TO THE START OF ANY EXCAVATION WORK.
- THE CONTRACTOR SHALL VERIFY ALL EXISTING UTILITY INVERTS AND CLEARANCES FROM NEW WORK PRIOR TO START OF ANY WORK.
- THE CONTRACTOR SHALL STAKE OUT THE LOCATION OF ALL NEW CONSTRUCTION AND VERIFY ALL JURISDICTIONAL SETBACKS AND BUFFERS PRIOR TO START OF ANY WORK.
- EXISTING UTILITIES WHICH ARE NOT TO BE REMOVED OR ABANDONED SHALL REMAIN OPERATIONAL AT ALL TIMES. APPROPRIATE EXISTING UTILITIES SHALL REMAIN IN SERVICE UNTIL REPLACEMENT/RELOCATED UTILITIES ARE OPERATIONAL.
- CONTRACTOR SHALL PROVIDE POSITIVE DRAINAGE AWAY FROM ALL EXISTING AND PROPOSED BUILDING ENTRANCES DURING ALL PHASES OF CONSTRUCTION. UNLESS OTHERWISE NOTED IN THESE DOCUMENTS, CONTRACTOR SHALL NOTIFY ENGINEER/OWNER IF EXISTING OR PROPOSED CONDITIONS RESTRICT ABILITY TO ACHIEVE POSITIVE DRAINAGE FROM BUILDINGS PRIOR TO THE START OF CONSTRUCTION.
- SEE SHEET C-003 FOR FULL EXISTING AND PROPOSED FEATURES LEGEND

| SITE SOILS SUMMARY TABLE | | | | | |
|-------------------------------|------|-------|-----|--------|----------|
| NAME | UNIT | Slope | HSG | HYDRIC | K FACTOR |
| Urban land-Udorthents complex | UdD | 8-25% | D | No | Unrated |
| Manor loam | MaB | 3-8% | B | No | 0.24 |
| Manor loam | MaC | 8-15% | B | No | 0.28 |
| Glenville silt loam | GmB | 3-8% | C/D | No | 0.37 |


EROSION AND SEDIMENT CONTROL LEGEND

- LOD LIMIT OF DISTURBANCE
- SSF SUPER SILT FENCE
- SFOP SILT FENCE ON PAVEMENT
- DF DIVERSION FENCE
- SCSCE STABILIZED CONSTRUCTION ENTRANCE
- CIP CURB INLET PROTECTION
- COIP COMBINATION INLET PROTECTION
- JAGIP AT-GRADE INLET PROTECTION
- SAME DAY STABILIZATION
- TEMPORARY CONSTRUCTION FENCE
- DRAINAGE AREA
- EXISTING STEEP SLOPES (>15%)
- PIPE TO BE REMOVED
- PROPERTY LINE

HOWARD SCD SIGNATURE BLOCK:
 This plan is approved for soil erosion and sediment control by the Howard Soil Conservation District.
Howard Patchin 11/15/23
 Howard Soil Conservation District Date

MATCHLINE - SEE SHEET C-686

PURPOSE STATEMENT (11/1/23): DESIGN OF OUTDOOR TESTING AREA 3, INCLUDING THE SOURCE OF BORROW MATERIAL. REFERRED TO AS THE EAST AND WEST BORROW AREAS.

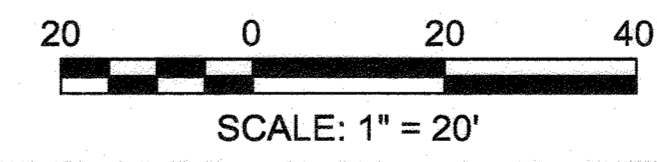

APPROVED: DEPARTMENT OF PLANNING AND ZONING
Chief, Development Engineering Division
 Date: 12-5-23
Chief, Division of Land Development
 Date: 2/22/24




PROFESSIONAL CERTIFICATION: I HEREBY CERTIFY THAT THESE DOCUMENTS WERE PREPARED OR APPROVED BY ME, AND THAT I AM A DULY LICENSED PROFESSIONAL ENGINEER UNDER THE LAWS OF THE STATE OF MARYLAND, LICENSE NO. 48422, EXPIRATION DATE: MAY 31, 2024.
Chad M. ...

| | | | | |
|-------------------|------|-----|---|---------|
| DESIGN BY: SHK | RK&K | 4 | New Sheet - OTA-3 and Borrow Area Modifications | 11/1/23 |
| DRAWN BY: JMS/DTP | | | | |
| CHECKED BY: CWWW | | | | |
| DATE: 11/1/2023 | BY | NO. | REVISION | DATE |

OWNER/DEVELOPER
JOHNS HOPKINS APPLIED PHYSICS LABORATORY
 11100 JOHNS HOPKINS ROAD
 LAUREL, MARYLAND 20723

EROSION SEDIMENT CONTROL PLAN - EAST BORROW AREA (ESC PHASE 2B)
 JOHNS HOPKINS UNIVERSITY - APPLIED PHYSICS LABORATORY
OUTDOOR TESTING AREAS
 11100 JOHNS HOPKINS ROAD
 PARCEL: 123 GRID: 16 ZONED: PEG
 ELECTION DISTRICT 5 - HOWARD COUNTY, MARYLAND
 SHEET 63 OF 73

C-688
 RK&K PROJECT NUMBER 21047.013
 SCALE: As Shown

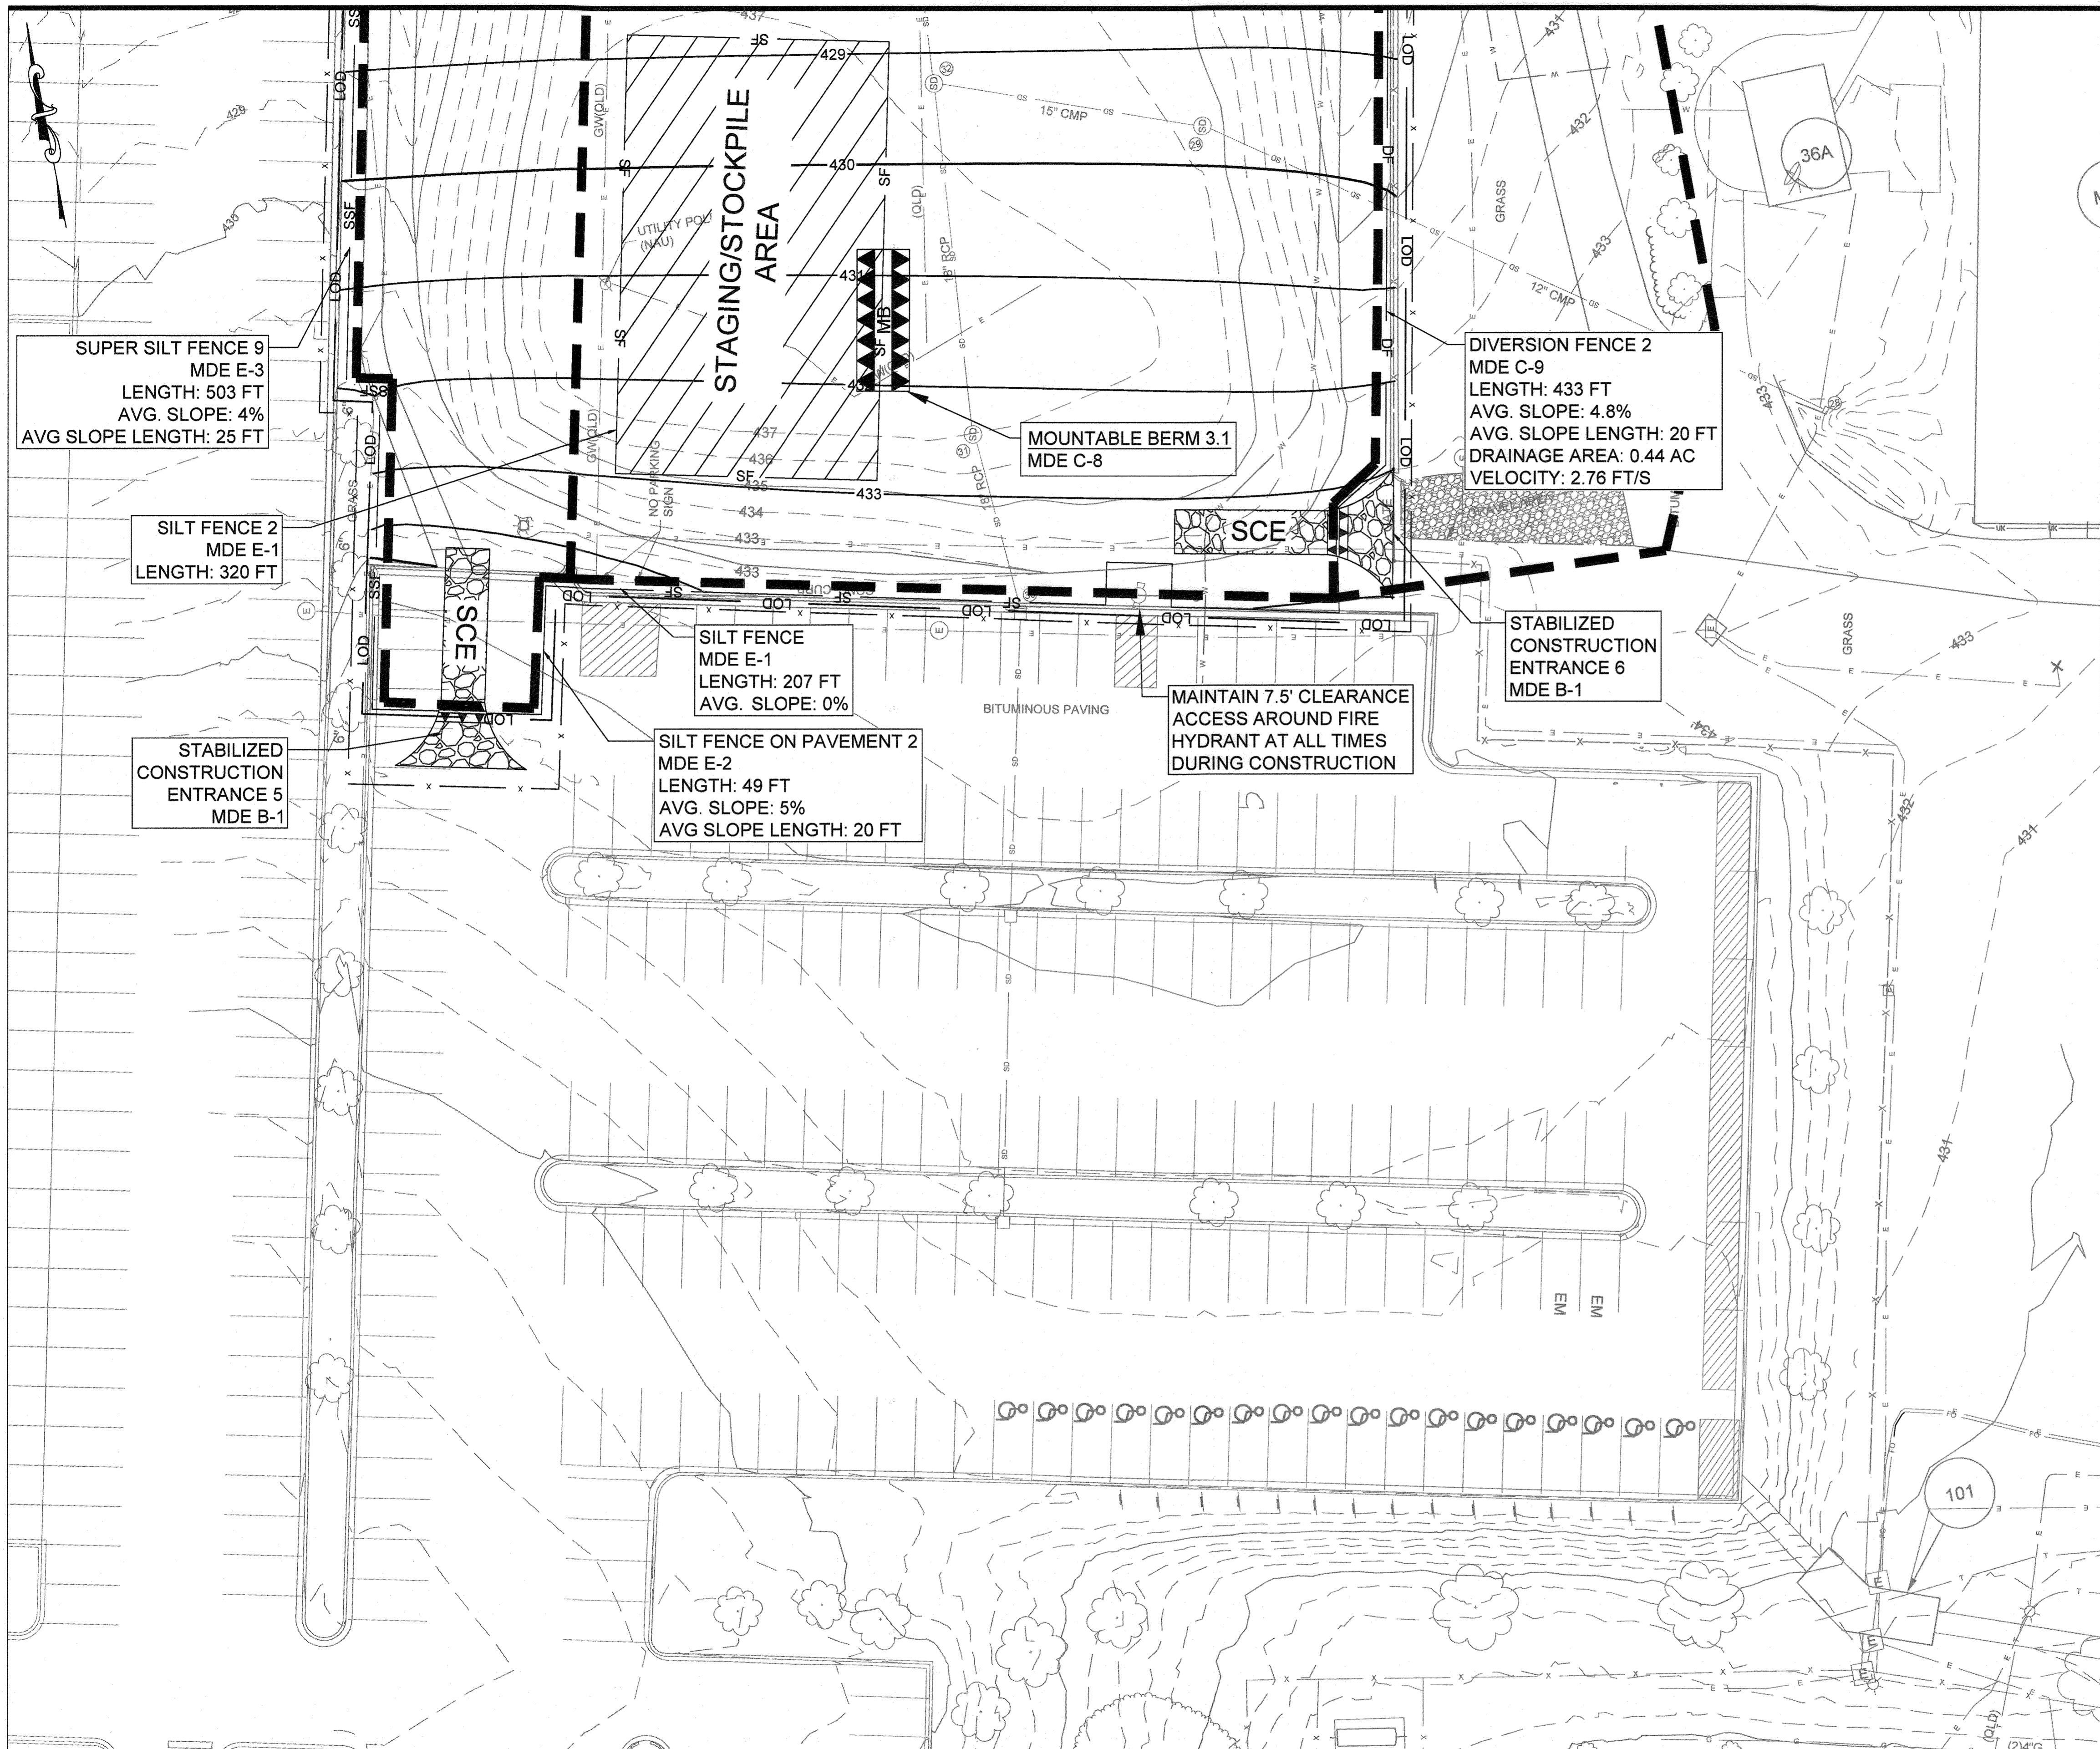

MATCHLINE - SEE SHEET C-687

MATCHLINE - SEE SHEET C-687

GENERAL NOTES

- TOPOGRAPHIC AND SURFACE INFORMATION SHOWN WAS OBTAINED FROM FIELD SURVEY BY RK&K, COMPLETED DECEMBER 23, 2021. UTILITY INFORMATION SHOWN WAS PROVIDED BY AII/DATA ON FEBRUARY 4, 2022.
- IT IS THE CONTRACTOR'S RESPONSIBILITY TO FIELD VERIFY ACTUAL SITE CONDITIONS PRIOR TO THE START OF ANY WORK. THERE IS NO WARRANTY OR GUARANTEE ON THE COMPLETENESS OR CORRECTNESS OF THE EXISTING CONDITION INFORMATION. ANY DISCREPANCY FOUND SHALL BE BROUGHT TO THE IMMEDIATE ATTENTION OF THE ARCHITECT/ENGINEER PRIOR TO THE START OF ANY WORK.
- BEARINGS AND HORIZONTAL COORDINATES SHOWN ON THIS PLAN ARE BASED UPON MARYLAND STATE PLANE COORDINATE SYSTEM NAD83. VERTICAL ELEVATIONS SHOWN ARE BASED UPON VERTICAL DATUM NAVD88.
- THE LOCATION OF EXISTING UNDERGROUND UTILITIES IS SHOWN IN AN APPROXIMATE WAY ONLY, BASED UPON FIELD OBSERVATIONS AND RECORD DOCUMENTS. THEY HAVE NOT BEEN COMPARED TO OR VERIFIED WITH FIELD TEST PITS. THE CONTRACTOR SHALL BE RESPONSIBLE TO VERIFY TO HIS OWN SATISFACTION THE EXACT LOCATION, SIZE AND TYPE OF ALL EXISTING UNDERGROUND UTILITIES BEFORE COMMENCING ANY WORK. THE CONTRACTOR MUST NOTIFY THE UTILITY COMPANIES INVOLVED PRIOR TO THE START OF THE WORK. CONTRACTOR AGREES TO BE FULLY RESPONSIBLE FOR THE COST OF ANY AND ALL DAMAGES WHICH OCCUR AS A RESULT OF A FAILURE TO EXACTLY LOCATE AND PRESERVE ANY AND ALL EXISTING UTILITIES TO REMAIN.
- THE CONTRACTOR SHALL BE RESPONSIBLE FOR NOTIFYING "MISS UTILITY" AT 1-800-257-7777 FIVE DAYS PRIOR TO THE START OF ANY EXCAVATION WORK.
- THE CONTRACTOR SHALL VERIFY ALL EXISTING UTILITY INVERTS AND CLEARANCES FROM NEW WORK PRIOR TO START OF ANY WORK.
- THE CONTRACTOR SHALL STAKE OUT THE LOCATION OF ALL NEW CONSTRUCTION AND VERIFY ALL JURISDICTIONAL SETBACKS AND BUFFERS PRIOR TO START OF ANY WORK.
- EXISTING UTILITIES WHICH ARE NOT TO BE REMOVED OR ABANDONED SHALL REMAIN OPERATIONAL AT ALL TIMES. APPROPRIATE EXISTING UTILITIES SHALL REMAIN IN SERVICE UNTIL REPLACEMENT/RELOCATED UTILITIES ARE OPERATIONAL.
- CONTRACTOR SHALL PROVIDE POSITIVE DRAINAGE AWAY FROM ALL EXISTING AND PROPOSED BUILDING ENTRANCES DURING ALL PHASES OF CONSTRUCTION, UNLESS OTHERWISE NOTED IN THESE DOCUMENTS. CONTRACTOR SHALL NOTIFY ENGINEER / OWNER IF EXISTING OR PROPOSED CONDITIONS RESTRICT ABILITY TO ACHIEVE POSITIVE DRAINAGE FROM BUILDINGS PRIOR TO THE START OF CONSTRUCTION.
- SEE SHEET C-003 FOR FULL EXISTING AND PROPOSED FEATURES LEGEND

SITE SOILS SUMMARY TABLE

| NAME | UNIT | Slope | HSG | HYDRIC | K FACTOR |
|-------------------------------|------|-------|-----|--------|----------|
| Urban land-Udorthents complex | UdD | 8-25% | D | No | Unrated |
| Manor loam | MaB | 3-8% | B | No | 0.24 |
| Manor loam | MaC | 8-15% | B | No | 0.28 |
| Glenville silt loam | GmB | 3-8% | C/D | No | 0.37 |


EROSION AND SEDIMENT CONTROL LEGEND

- LOD LIMIT OF DISTURBANCE
- SSF SUPER SILT FENCE
- SFOP SILT FENCE ON PAVEMENT
- DF DIVERSION FENCE
- SCE STABILIZED CONSTRUCTION ENTRANCE
- CIP CURB INLET PROTECTION
- COIP COMBINATION INLET PROTECTION
- AGIP AT-GRADE INLET PROTECTION
- SAME DAY STABILIZATION
- x TEMPORARY CONSTRUCTION FENCE
- DRAINAGE AREA
- EXISTING STEEP SLOPES (>15%)
- PIPE TO BE REMOVED

HOWARD SCD SIGNATURE BLOCK:
 This plan is approved for soil erosion and sediment control by the Howard Soil Conservation District.

 Howard Soil Conservation District Date 11/15/23

▲ PURPOSE STATEMENT (11/1/23): DESIGN OF OUTDOOR TESTING AREA 3, INCLUDING THE SOURCE OF BORROW MATERIAL, REFERRED TO AS THE EAST AND WEST BORROW AREAS.

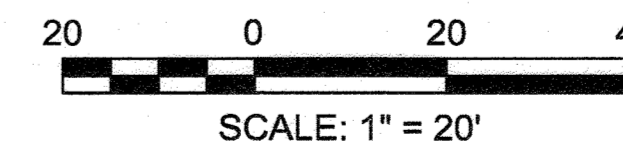


APPROVED: DEPARTMENT OF PLANNING AND ZONING

 Chief, Development Engineering Division Date 12-5-23

 Chief, Division of Land Development Date 2/28/24
 Director Date 2/28/24

RK&K
 RUMMEL, KLEPPER & KAHL, LLP
 ENGINEERS/CONSTRUCTION MANAGERS/PLANNERS/SCIENTISTS
 RESPONSIBLE PROFESSIONAL SOLUTIONS
 700 East Pratt Street, Suite 500
 Baltimore, MD 21202
 Ph: 410.728.2800 Contact: Matt Thomason
 www.rk&k.com

PROFESSIONAL CERTIFICATION: I HEREBY CERTIFY THAT THESE DOCUMENTS WERE PREPARED OR APPROVED BY ME AND THAT I AM A DULY LICENSED PROFESSIONAL ENGINEER UNDER THE LAWS OF THE STATE OF MARYLAND, LICENSE NO. 48432, EXPIRATION DATE: MAY 31, 2026.

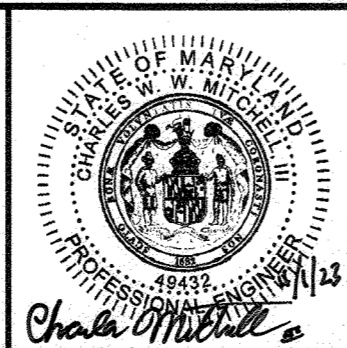

| | | | | | |
|-------------|-----------|------|-----|---|---------|
| DESIGN BY: | SHK | RK&K | 4 | New Sheet - OTA-3 and Borrow Area Modifications | 11/1/23 |
| DRAWN BY: | JMS/DTP | | | | |
| CHECKED BY: | CWMM | | | | |
| DATE: | 11/1/2023 | BY | NO. | REVISION | DATE |

OWNER/DEVELOPER
JOHNS HOPKINS APPLIED PHYSICS LABORATORY
 11100 JOHNS HOPKINS ROAD
 LAUREL, MARYLAND 20723

EROSION SEDIMENT CONTROL PLAN - WEST BORROW AREA (ESC PHASE 2B)
 JOHN HOPKINS UNIVERSITY - APPLIED PHYSICS LABORATORY
OUTDOOR TESTING AREAS
 11100 JOHNS HOPKINS ROAD
 TAX MAP: 41 PARCEL: 123 GRID: 16 ZONED: PEC
 ELECTION DISTRICT 5 - HOWARD COUNTY, MARYLAND
 SHEET 64 OF 73
 SCALE: As Shown


GENERAL NOTES


- TOPOGRAPHIC AND SURFACE INFORMATION SHOWN WAS OBTAINED FROM FIELD SURVEY BY RK&K, COMPLETED DECEMBER 23, 2021. UTILITY INFORMATION SHOWN WAS PROVIDED BY AJI/DATA ON FEBRUARY 4, 2022.
- IT IS THE CONTRACTOR'S RESPONSIBILITY TO FIELD VERIFY ACTUAL SITE CONDITIONS PRIOR TO THE START OF ANY WORK. THERE IS NO WARRANTY OR GUARANTEE ON THE COMPLETENESS OR CORRECTNESS OF THE EXISTING CONDITION INFORMATION. ANY DISCREPANCY FOUND SHALL BE BROUGHT TO THE IMMEDIATE ATTENTION OF THE ARCHITECT/ENGINEER PRIOR TO THE START OF ANY WORK.
- BEARINGS AND HORIZONTAL COORDINATES SHOWN ON THIS PLAN ARE BASED UPON MARYLAND STATE PLANE COORDINATE SYSTEM NAD83. VERTICAL ELEVATIONS SHOWN ARE BASED UPON VERTICAL DATUM NAVD83.
- THE LOCATION OF EXISTING UNDERGROUND UTILITIES IS SHOWN IN AN APPROXIMATE WAY ONLY. BASED UPON FIELD OBSERVATIONS AND RECORD DOCUMENTS. THEY HAVE NOT BEEN COMPARED TO OR VERIFIED WITH FIELD TEST PITS. THE CONTRACTOR SHALL BE RESPONSIBLE TO VERIFY TO HIS OWN SATISFACTION THE EXACT LOCATION, SIZE AND TYPE OF ALL EXISTING UNDERGROUND UTILITIES BEFORE COMMENCING ANY WORK. THE CONTRACTOR MUST NOTIFY THE UTILITY COMPANIES INVOLVED PRIOR TO THE START OF THE WORK. CONTRACTOR AGREES TO BE FULLY RESPONSIBLE FOR THE COST OF ANY AND ALL DAMAGES WHICH OCCUR AS A RESULT OF A FAILURE TO EXACTLY LOCATE AND PRESERVE ANY AND ALL EXISTING UTILITIES TO REMAIN.
- THE CONTRACTOR SHALL BE RESPONSIBLE FOR NOTIFYING "MISS UTILITY" AT 1-800-257-7777 FIVE DAYS PRIOR TO THE START OF ANY EXCAVATION WORK.
- THE CONTRACTOR SHALL VERIFY ALL EXISTING UTILITY INVERTS AND CLEARANCES FROM NEW WORK PRIOR TO START OF ANY WORK.
- THE CONTRACTOR SHALL STAKE OUT THE LOCATION OF ALL NEW CONSTRUCTION AND VERIFY ALL JURISDICTIONAL SETBACKS AND BUFFERS PRIOR TO START OF ANY WORK.
- EXISTING UTILITIES WHICH ARE NOT TO BE REMOVED OR ABANDONED SHALL REMAIN OPERATIONAL AT ALL TIMES. APPROPRIATE EXISTING UTILITIES SHALL REMAIN IN SERVICE UNTIL REPLACEMENT/RELOCATED UTILITIES ARE OPERATIONAL.
- CONTRACTOR SHALL PROVIDE POSITIVE DRAINAGE AWAY FROM ALL EXISTING AND PROPOSED BUILDING ENTRANCES DURING ALL PHASES OF CONSTRUCTION UNLESS OTHERWISE NOTED IN THESE DOCUMENTS. CONTRACTOR SHALL NOTIFY ENGINEER / OWNER IF EXISTING OR PROPOSED CONDITIONS RESTRICT ABILITY TO ACHIEVE POSITIVE DRAINAGE FROM BUILDINGS PRIOR TO THE START OF CONSTRUCTION.
- SEE SHEET C-003 FOR FULL EXISTING AND PROPOSED FEATURES LEGEND

| SITE SOILS SUMMARY TABLE | | | | | |
|-------------------------------|------|-------|-----|--------|----------|
| NAME | UNIT | Slope | HSG | HYDRIC | K FACTOR |
| Urban land-Udorthents complex | UdD | 8-25% | D | No | Unrated |
| Manor loam | MaB | 3-8% | B | No | 0.24 |
| Manor loam | MaC | 8-15% | B | No | 0.28 |
| Glenville silt loam | GmB | 3-8% | C/D | No | 0.37 |

EROSION AND SEDIMENT CONTROL LEGEND

- LOD LIMIT OF DISTURBANCE
- SSF SUPER SILT FENCE
- SFOP SILT FENCE ON PAVEMENT
- DF DIVERSION FENCE
- SCE STABILIZED CONSTRUCTION ENTRANCE
- CIP CURB INLET PROTECTION
- COIP COMBINATION INLET PROTECTION
- AGIP AT-GRADE INLET PROTECTION
- SD SAME DAY STABILIZATION
- TCF TEMPORARY CONSTRUCTION FENCE
- DA DRAINAGE AREA
- ESS EXISTING STEEP SLOPES (>15%)
- PRP PIPE TO BE REMOVED
- PL PROPERTY LINE

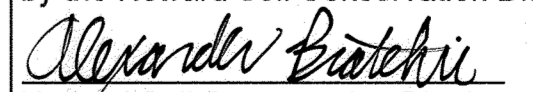HOWARD SCD SIGNATURE BLOCK:
 This plan is approved for soil erosion and sediment control by the Howard Soil Conservation District.

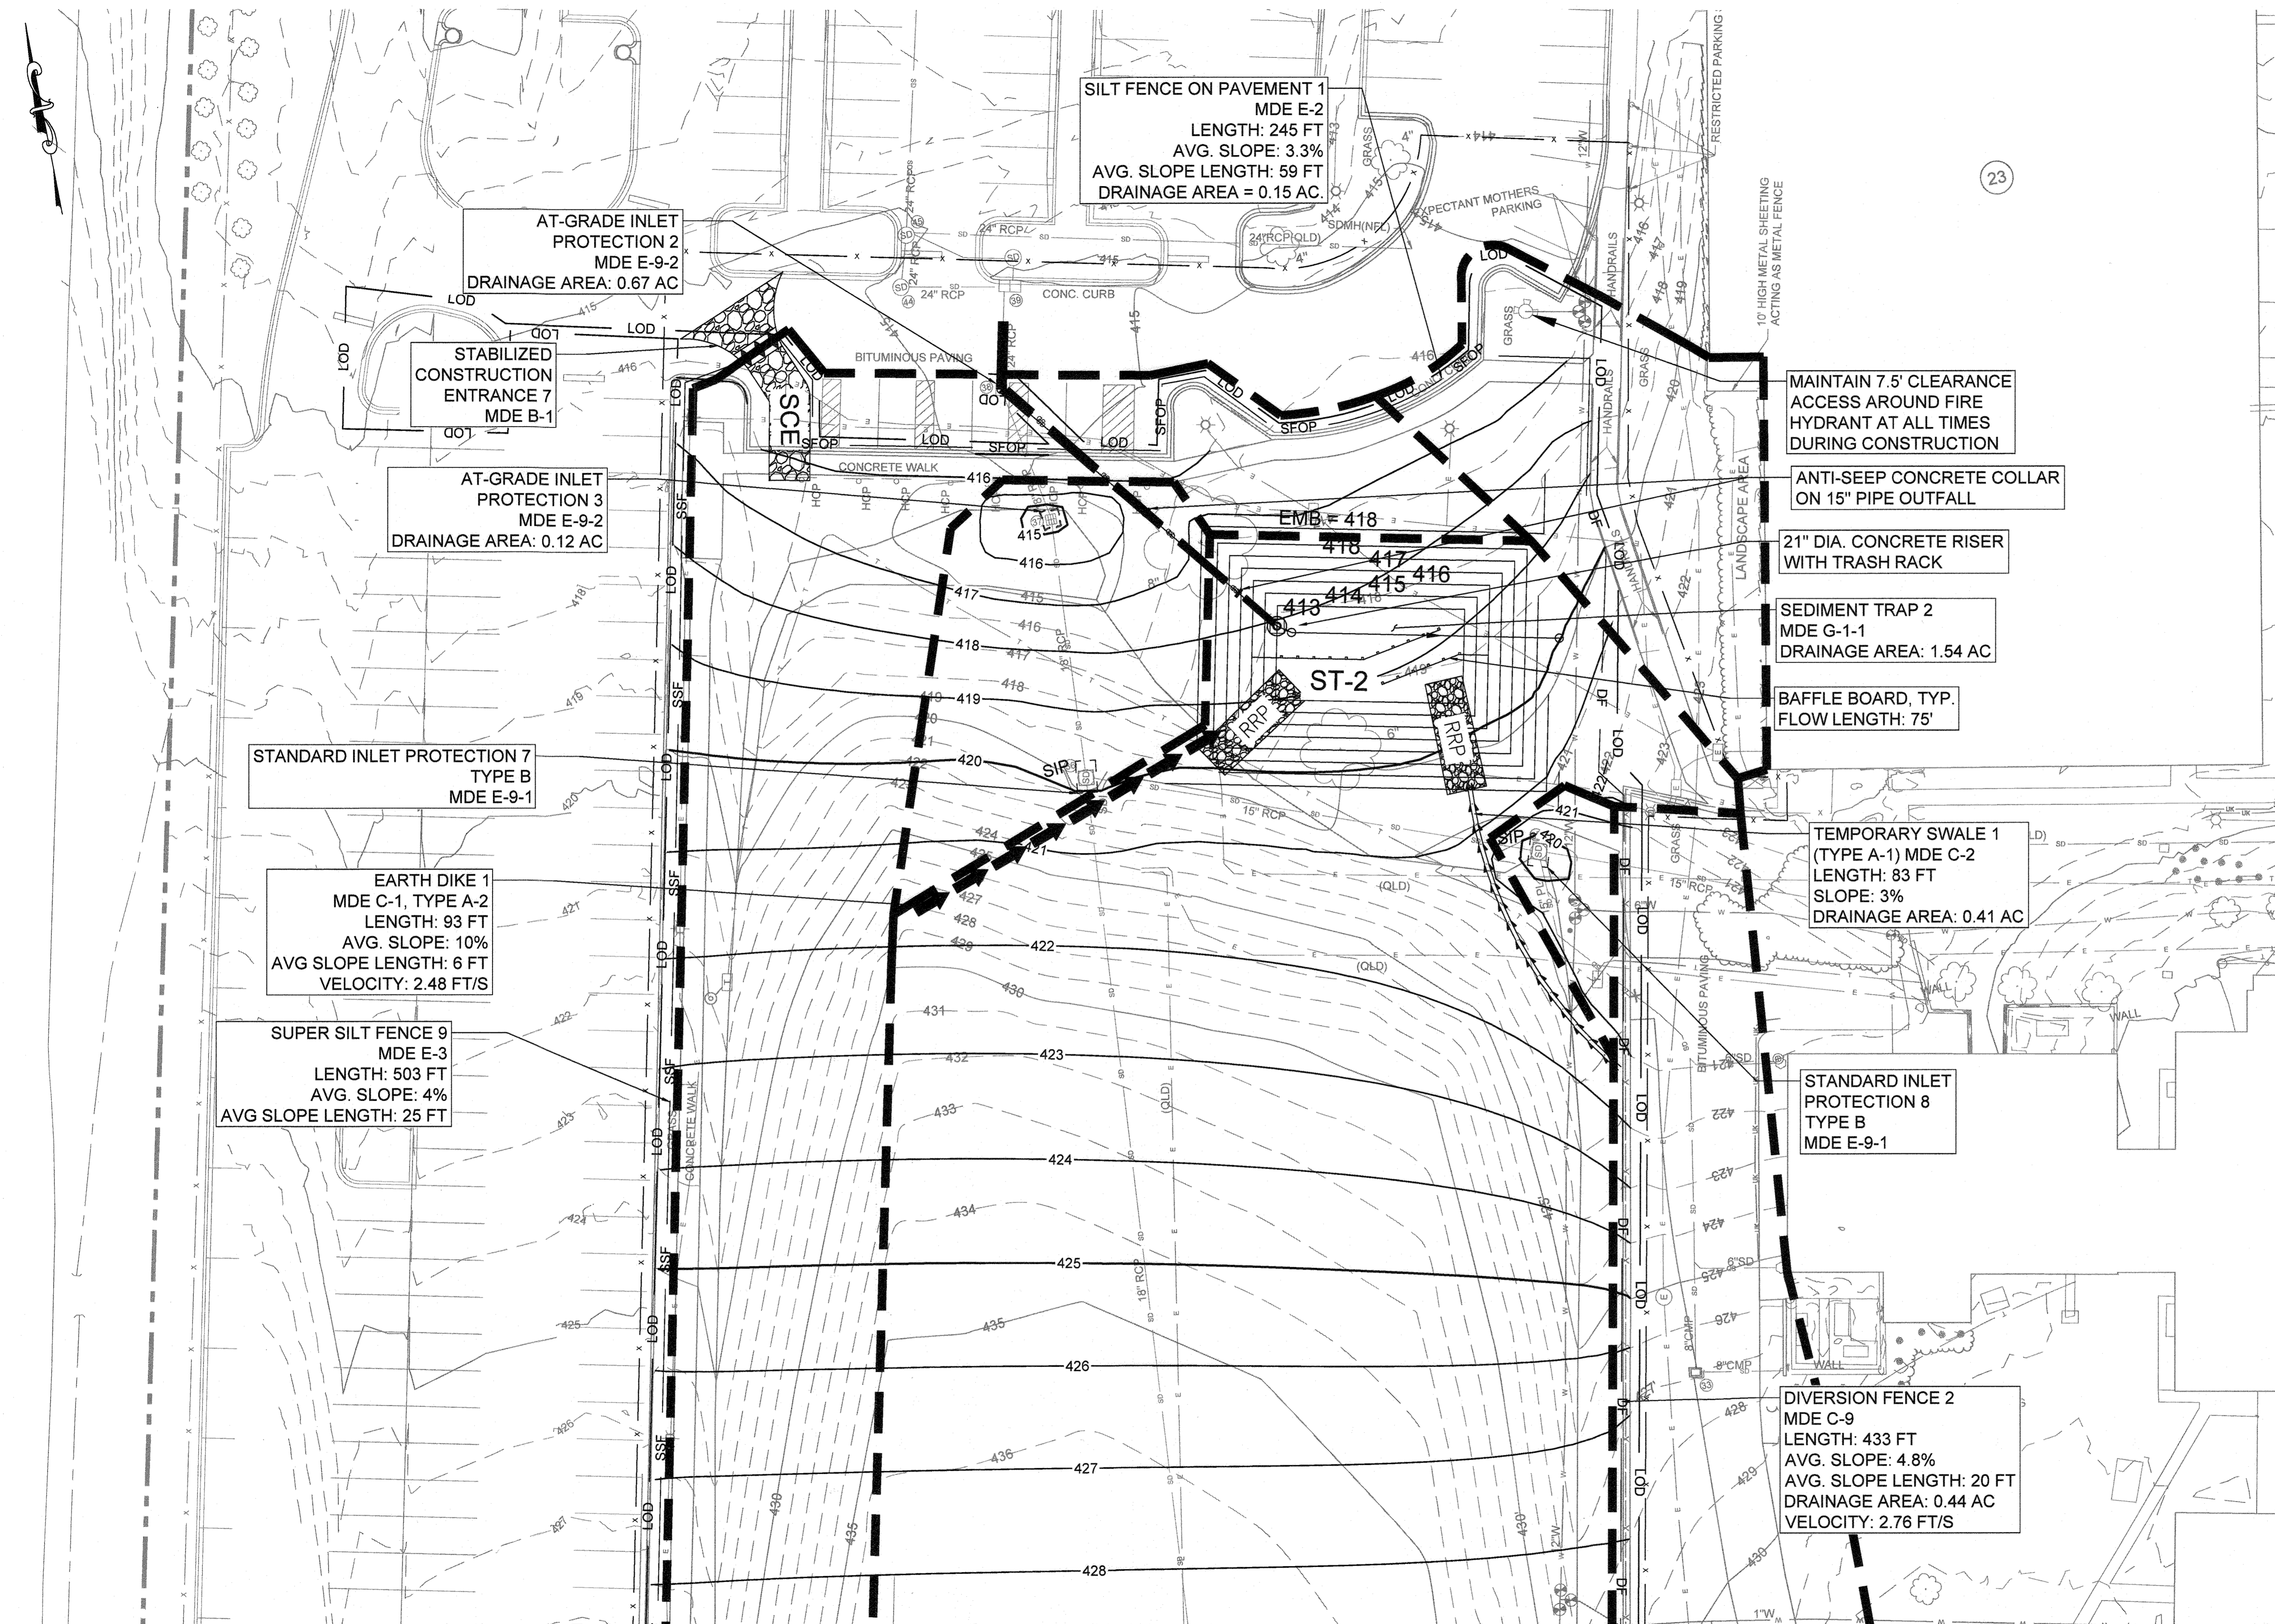 Howard Soil Conservation District
 11/15/23
 Date



MATCHLINE - SEE SHEET C-689

PURPOSE STATEMENT (11/1/23): DESIGN OF OUTDOOR TESTING AREA 3, INCLUDING THE SOURCE OF BORROW MATERIAL REFERRED TO AS THE EAST AND WEST BORROW AREAS.
 SCALE: 1" = 20'

APPROVED: DEPARTMENT OF PLANNING AND ZONING
 Chief, Development Engineering Division
 Chief, Division of Land Development
 Director

RK&K
 RUMMEL, KLEPPER & KAHL, LLP
 ENGINEERS/CONSTRUCTION MANAGERS/PLANNERS/SCIENTISTS
 RESPONSIVE PEOPLE. CREATIVE SOLUTIONS.
 700 East Pratt Street, Suite 500
 Baltimore, MD 21202
 PH: 410.728.2900
 www.rk&k.com

PROFESSIONAL CERTIFICATION: I HEREBY CERTIFY THAT THESE DOCUMENTS WERE PREPARED OR APPROVED BY ME, AND THAT I AM A DULY LICENSED PROFESSIONAL ENGINEER UNDER THE LAWS OF THE STATE OF MARYLAND. LICENSE NO. 48493, EXPIRATION DATE: MAY 31, 2024.


DESIGN BY: SHK
 DRAWN BY: JMS/DTP
 CHECKED BY: CWWW
 DATE: 11/1/2023

| BY | NO. | REVISION | DATE |
|----|-----|---|---------|
| | | New Sheet - OTA-3 and Borrow Area Modifications | 11/1/23 |

OWNER/DEVELOPER
JOHNS HOPKINS APPLIED PHYSICS LABORATORY
 11100 JOHNS HOPKINS ROAD
 LAUREL, MARYLAND 20723

EROSION SEDIMENT CONTROL PLAN - WEST BORROW AREA (ESC PHASE 2B)
 JOHNS HOPKINS UNIVERSITY - APPLIED PHYSICS LABORATORY
OUTDOOR TESTING AREAS
 11100 JOHNS HOPKINS ROAD
 PARCEL: 123 GRID: 16 ZONED: PEG
 ELECTION DISTRICT 5 - HOWARD COUNTY, MARYLAND
 SHEET 65 OF 73
 SDP-18-060

C-690
 RK&K PROJECT NUMBER 21047.013
 SCALE: As Shown

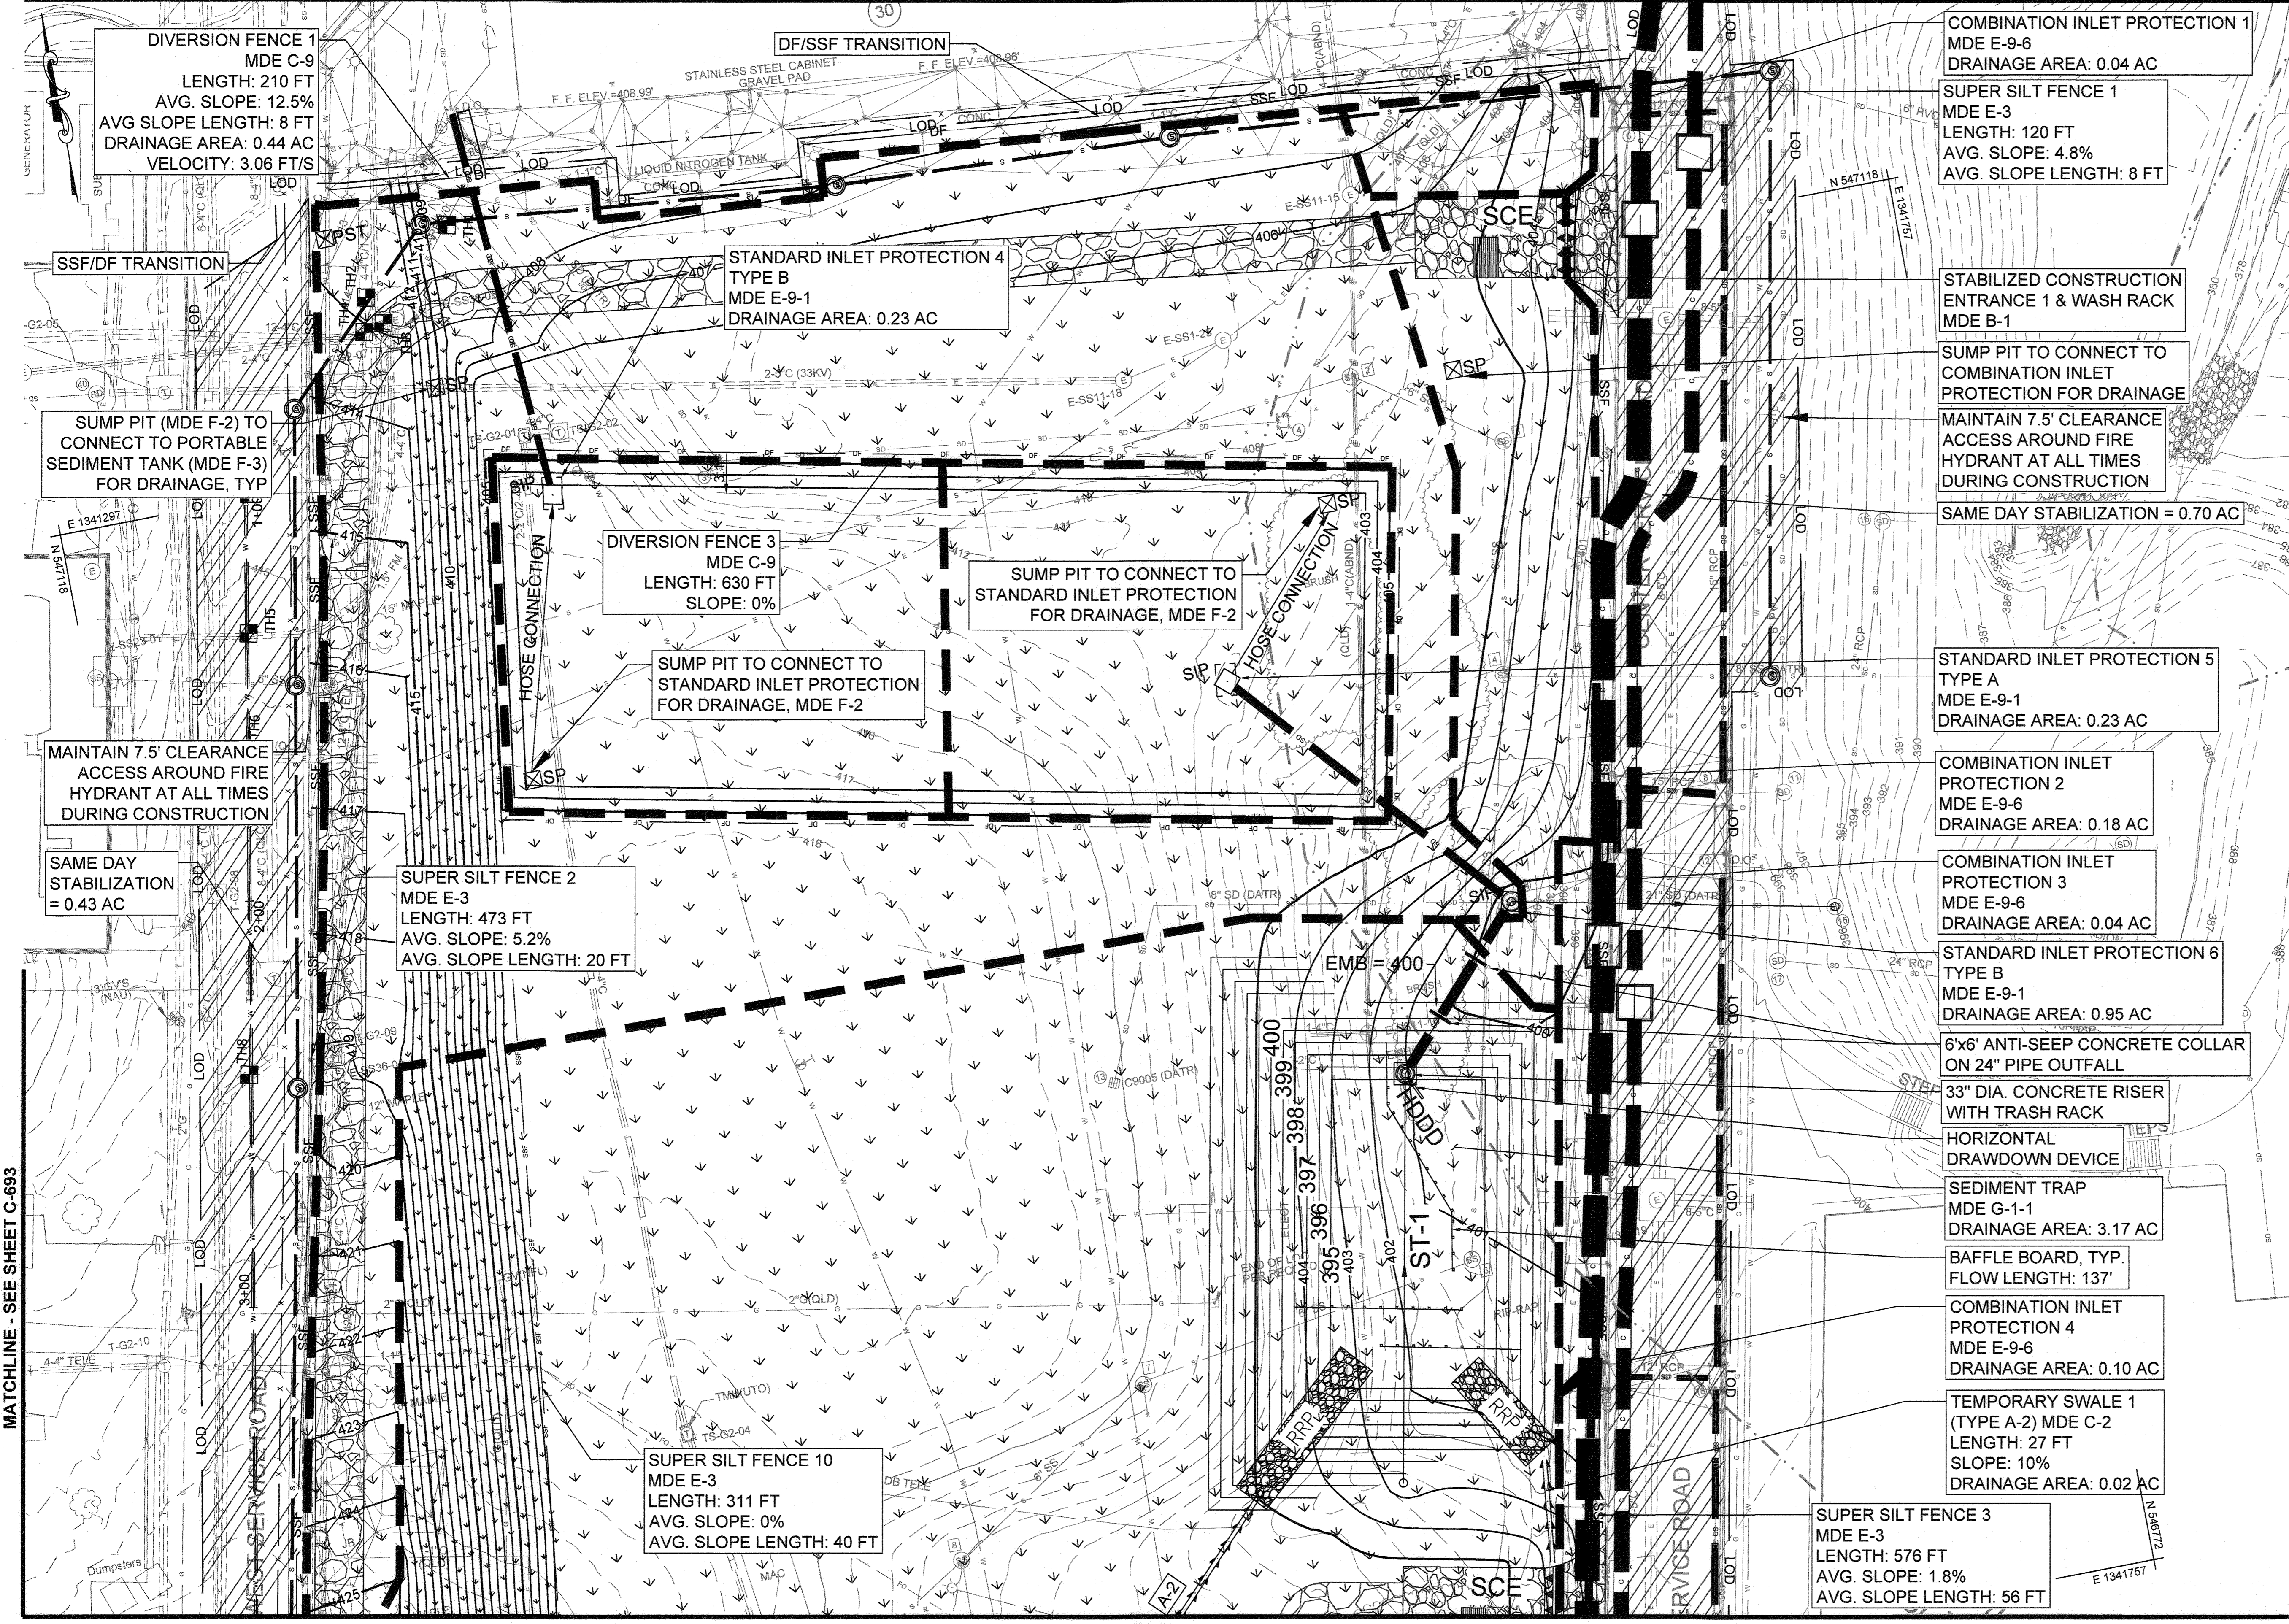

- COMBINATION INLET PROTECTION 1
MDE E-9-6
DRAINAGE AREA: 0.04 AC
- SUPER SILT FENCE 1
MDE E-3
LENGTH: 120 FT
AVG. SLOPE: 4.8%
AVG. SLOPE LENGTH: 8 FT
- STABILIZED CONSTRUCTION ENTRANCE 1 & WASH RACK
MDE B-1
- SUMP PIT TO CONNECT TO COMBINATION INLET PROTECTION FOR DRAINAGE
- MAINTAIN 7.5' CLEARANCE ACCESS AROUND FIRE HYDRANT AT ALL TIMES DURING CONSTRUCTION
- SAME DAY STABILIZATION = 0.70 AC
- STANDARD INLET PROTECTION 5
TYPE A
MDE E-9-1
DRAINAGE AREA: 0.23 AC
- COMBINATION INLET PROTECTION 2
MDE E-9-6
DRAINAGE AREA: 0.18 AC
- COMBINATION INLET PROTECTION 3
MDE E-9-6
DRAINAGE AREA: 0.04 AC
- STANDARD INLET PROTECTION 6
TYPE B
MDE E-9-1
DRAINAGE AREA: 0.95 AC
- 6"x6" ANTI-SEEP CONCRETE COLLAR ON 24" PIPE OUTFALL
- 33" DIA. CONCRETE RISER WITH TRASH RACK
- HORIZONTAL DRAWDOWN DEVICE
- SEDIMENT TRAP
MDE G-1-1
DRAINAGE AREA: 3.17 AC
- BAFFLE BOARD, TYP. FLOW LENGTH: 137'
- COMBINATION INLET PROTECTION 4
MDE E-9-6
DRAINAGE AREA: 0.10 AC
- TEMPORARY SWALE 1 (TYPE A-2) MDE C-2
LENGTH: 27 FT
SLOPE: 10%
DRAINAGE AREA: 0.02 AC
- SUPER SILT FENCE 3
MDE E-3
LENGTH: 576 FT
AVG. SLOPE: 1.8%
AVG. SLOPE LENGTH: 56 FT

GENERAL NOTES

- TOPOGRAPHIC AND SURFACE INFORMATION SHOWN WAS OBTAINED FROM FIELD SURVEY BY RK&K, COMPLETED DECEMBER 23, 2021. UTILITY INFORMATION SHOWN WAS PROVIDED BY ALLIANCE ON FEBRUARY 4, 2022.
- IT IS THE CONTRACTOR'S RESPONSIBILITY TO FIELD VERIFY ACTUAL SITE CONDITIONS PRIOR TO THE START OF ANY WORK. THERE IS NO WARRANTY OR GUARANTEE ON THE COMPLETENESS OR CORRECTNESS OF THE EXISTING CONDITION INFORMATION. ANY DISCREPANCY FOUND SHALL BE BROUGHT TO THE IMMEDIATE ATTENTION OF THE ARCHITECT/ENGINEER PRIOR TO THE START OF ANY WORK.
- BEARINGS AND HORIZONTAL COORDINATES SHOWN ON THIS PLAN ARE BASED UPON MARYLAND STATE PLANE COORDINATE SYSTEM NAD83. VERTICAL ELEVATIONS SHOWN ARE BASED UPON VERTICAL DATUM NAVD83.
- THE LOCATION OF EXISTING UNDERGROUND UTILITIES IS SHOWN IN AN APPROXIMATE WAY ONLY, BASED UPON FIELD OBSERVATIONS AND RECORD DOCUMENTS. THEY HAVE NOT BEEN COMPARED TO OR VERIFIED WITH FIELD TEST PITS. THE CONTRACTOR SHALL BE RESPONSIBLE TO VERIFY TO HIS OWN SATISFACTION THE EXACT LOCATION, SIZE AND TYPE OF ALL EXISTING UNDERGROUND UTILITIES BEFORE COMMENCING ANY WORK. THE CONTRACTOR MUST NOTIFY THE UTILITY COMPANIES INVOLVED PRIOR TO THE START OF THE WORK. CONTRACTOR AGREES TO BE FULLY RESPONSIBLE FOR THE COST OF ANY AND ALL DAMAGES WHICH OCCUR AS A RESULT OF A FAILURE TO EXACTLY LOCATE AND PRESERVE ANY AND ALL EXISTING UTILITIES TO REMAIN.
- THE CONTRACTOR SHALL BE RESPONSIBLE FOR NOTIFYING "MISS UTILITY" AT 1-800-267-7777 FIVE DAYS PRIOR TO THE START OF ANY EXCAVATION WORK.
- THE CONTRACTOR SHALL VERIFY ALL EXISTING UTILITY INVERTS AND CLEARANCES FROM NEW WORK PRIOR TO START OF ANY WORK.
- THE CONTRACTOR SHALL STAKE OUT THE LOCATION OF ALL NEW CONSTRUCTION AND VERIFY ALL JURISDICTIONAL SETBACKS AND BUFFERS PRIOR TO START OF ANY WORK.
- EXISTING UTILITIES WHICH ARE NOT TO BE REMOVED OR ABANDONED SHALL REMAIN OPERATIONAL AT ALL TIMES. APPROPRIATE EXISTING UTILITIES SHALL REMAIN IN SERVICE UNTIL REPLACEMENT/RELOCATED UTILITIES ARE OPERATIONAL.
- CONTRACTOR SHALL PROVIDE POSITIVE DRAINAGE AWAY FROM ALL EXISTING AND PROPOSED BUILDING ENTRANCES DURING ALL PHASES OF CONSTRUCTION, UNLESS OTHERWISE NOTED IN THESE DOCUMENTS. CONTRACTOR SHALL NOTIFY ENGINEER/OWNER IF EXISTING OR PROPOSED CONDUIT IS NOT ABILITY TO ACHIEVE POSITIVE DRAINAGE FROM BUILDINGS PRIOR TO THE START OF CONSTRUCTION.
- SEE SHEET C-003 FOR FULL EXISTING AND PROPOSED FEATURES LEGEND

STANDARD STABILIZATION NOTE:

Following initial soil disturbance or re-disturbance, seeding for permanent or temporary stabilization shall be completed within three (3) calendar days as to the surface of all perimeter controls, dikes, swales, ditches, perimeter slopes, and all slopes greater than 3 horizontal to 1 vertical (3:1); and seven (7) calendar days as to all other disturbed or graded areas on the project site not under active grading. Once vegetation is established, the site shall have 95% groundcover to be considered adequately stabilized.

| SITE SOILS SUMMARY TABLE | | | | | |
|-------------------------------|------|-------|-----|--------|----------|
| NAME | UNIT | Slope | HSG | HYDRIC | K FACTOR |
| Urban land-Udorthents complex | UdD | 8-25% | D | No | Unrated |
| Manor loam | MaB | 3-9% | B | No | 0.24 |
| Manor loam | MaC | 8-15% | B | No | 0.28 |
| Glennville silt loam | GmB | 3-8% | C/D | No | 0.37 |

SEQUENCE OF CONSTRUCTION: PHASE 2C


- COMPLETE SEQUENCE OF CONSTRUCTION - PHASE 2A (SHEET C-681) 24 DAYS
- COMPLETE SEQUENCE OF CONSTRUCTION - PHASE 2B (SHEET C-686) 127 DAYS
- PROVIDE PERMANENT STABILIZATION TO ALL BORROW AREAS. ONCE ALL AREAS ARE PERMANENTLY STABILIZED AND WITH APPROVAL OF THE SEDIMENT CONTROL INSPECTOR, REMOVE ALL REMAINING SEDIMENT CONTROLS AND STABILIZE AREAS DISTURBED BY THIS OPERATION. 2 DAYS

EROSION AND SEDIMENT CONTROL LEGEND

- LOD LIMIT OF DISTURBANCE
- SSF SUPER SILT FENCE
- SFOP SILT FENCE ON PAVEMENT
- DF DIVERSION FENCE
- SCE STABILIZED CONSTRUCTION ENTRANCE
- SAME DAY STABILIZATION
- TEMPORARY CONSTRUCTION FENCE
- DRAINAGE AREA
- SUMP PIT
- PORTABLE SEDIMENT TANK
- PERMANENT SEEDING STABILIZATION (B-4-5)
- PERMANENT SOIL STABILIZATION MATTING SLOPE APPLICATION (PSSMS - 2.25 LBS/FT)
- PROPERTY LINE

HOWARD SCD SIGNATURE BLOCK:
 This plan is approved for soil erosion and sediment control by the Howard Soil Conservation District.
Alexander P. Butcher
 Howard Soil Conservation District
 11/15/23
 Date


MATCHLINE - SEE SHEET C-693

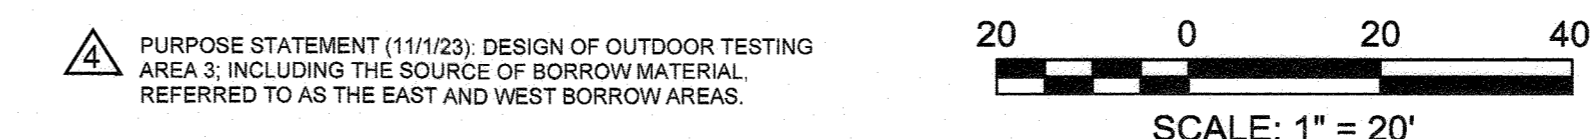

APPROVED: DEPARTMENT OF PLANNING AND ZONING
 Chief, Development Engineering Division
 Date: 12-5-23
 Chief, Division of Land Development
 Date: 2/22/24




Chalmer Moore

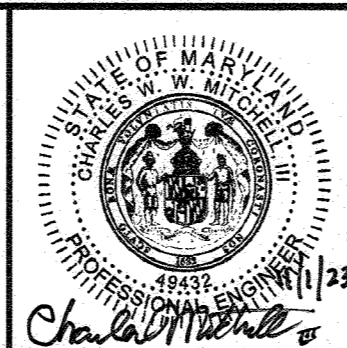

| | | | | |
|-------------------|------|----------|---|---------|
| DESIGN BY: SHK | RK&K | 4 | New Sheet - OTA-3 and Borrow Area Modifications | 11/1/23 |
| DRAWN BY: JMS/DTP | | | | |
| CHECKED BY: CWMM | | | | |
| DATE: 11/1/2023 | | | | |
| BY | NO. | REVISION | DATE | |

OWNER/DEVELOPER
 JOHNS HOPKINS
 APPLIED PHYSICS LABORATORY
 11100 JOHNS HOPKINS ROAD
 LAUREL, MARYLAND 20723

EROSION SEDIMENT CONTROL PLAN - EAST BORROW AREA (ESC PHASE 2C)
 JOHNS HOPKINS UNIVERSITY - APPLIED PHYSICS LABORATORY
 OUTDOOR TESTING AREAS
 11100 JOHNS HOPKINS ROAD
 PARCEL: 123 GRID: 16 ZONED: PEG
 ELECTION DISTRICT 5 - HOWARD COUNTY, MARYLAND
 SHEET 66 OF 73
 SCALE: As Shown
 SDP-18-060

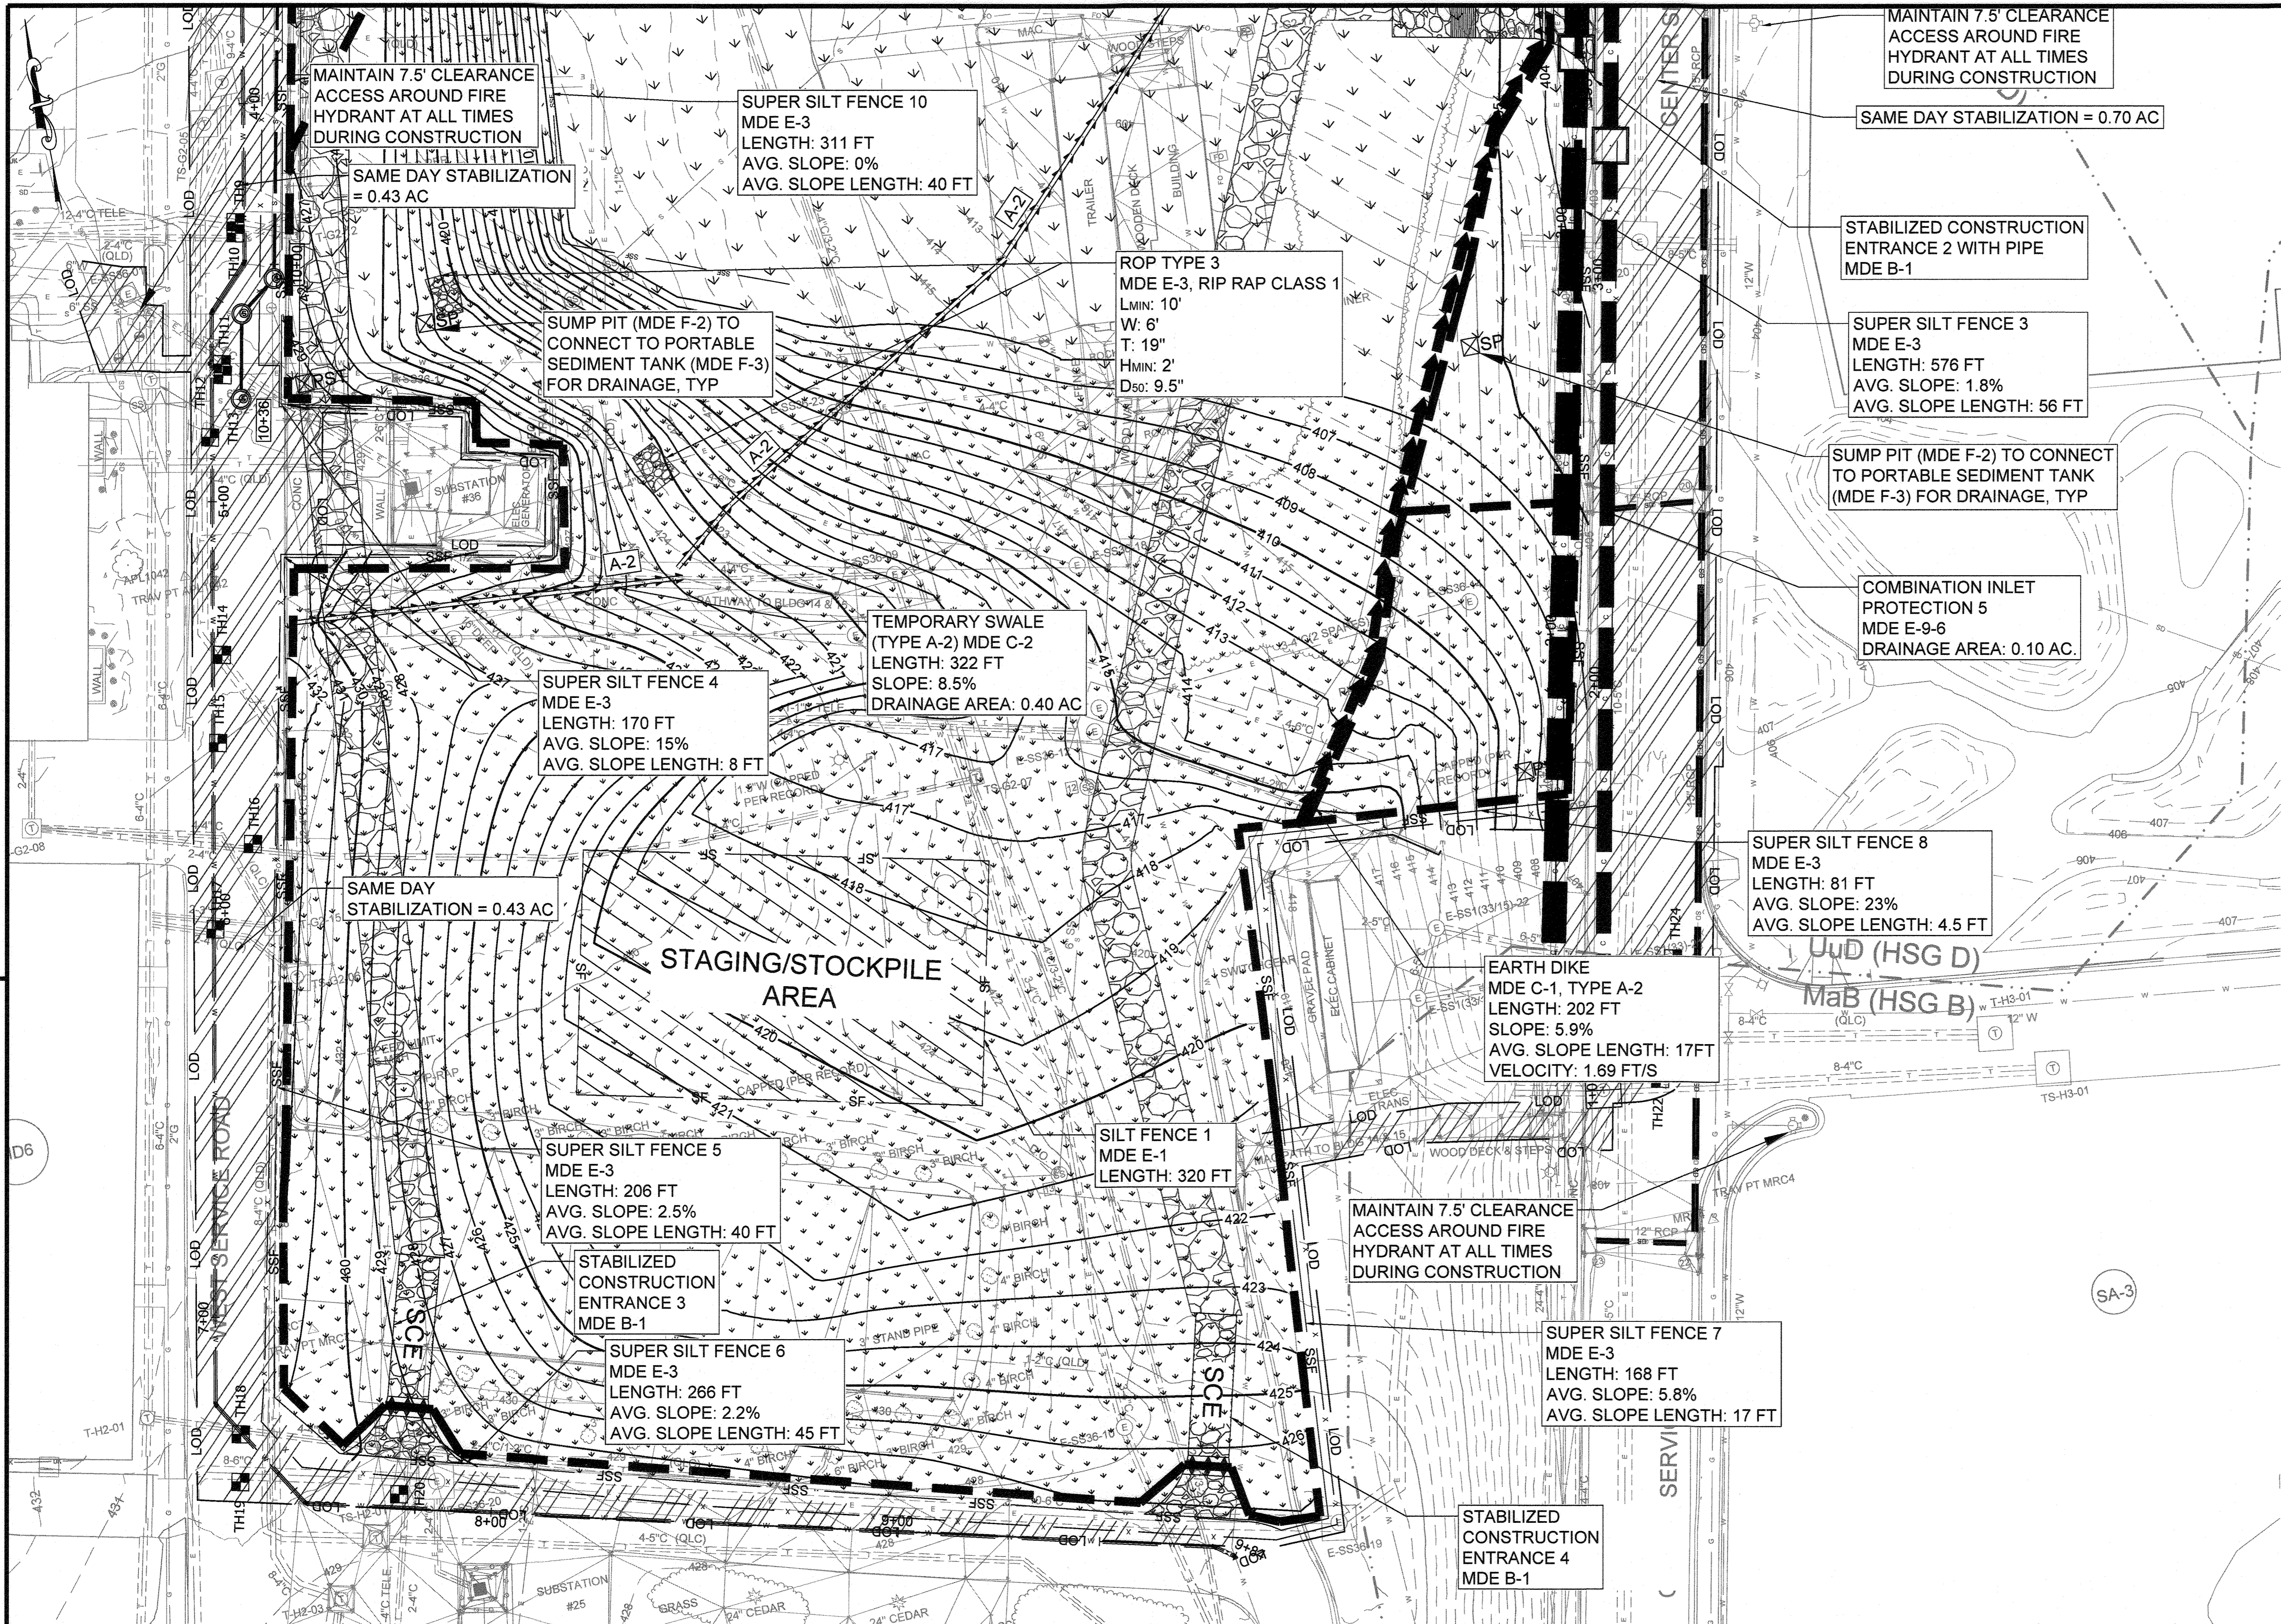


GENERAL NOTES

1. TOPOGRAPHIC AND SURFACE INFORMATION SHOWN WAS OBTAINED FROM FIELD SURVEY BY RK&K, COMPLETED DECEMBER 23, 2021. UTILITY INFORMATION SHOWN WAS PROVIDED BY AIDATA ON FEBRUARY 4, 2022.
2. IT IS THE CONTRACTOR'S RESPONSIBILITY TO FIELD VERIFY ACTUAL SITE CONDITIONS PRIOR TO THE START OF ANY WORK. THERE IS NO WARRANTY OR GUARANTEE ON THE COMPLETENESS OR CORRECTNESS OF THE EXISTING CONDITION INFORMATION. ANY DISCREPANCY FOUND SHALL BE BROUGHT TO THE IMMEDIATE ATTENTION OF THE ARCHITECT/ENGINEER PRIOR TO THE START OF ANY WORK.
3. BEARINGS AND HORIZONTAL COORDINATES SHOWN ON THIS PLAN ARE BASED UPON MARYLAND STATE PLANE COORDINATE SYSTEM NAD83. VERTICAL ELEVATIONS SHOWN ARE BASED UPON VERTICAL DATUM NAVD83.
4. THE LOCATION OF EXISTING UNDERGROUND UTILITIES IS SHOWN IN AN APPROXIMATE WAY ONLY, BASED UPON FIELD OBSERVATIONS AND RECORD DOCUMENTS. THEY HAVE NOT BEEN COMPARED TO OR VERIFIED WITH FIELD TEST PITS. THE CONTRACTOR SHALL BE RESPONSIBLE TO VERIFY TO HIS OWN SATISFACTION THE EXACT LOCATION, SIZE AND TYPE OF ALL EXISTING UNDERGROUND UTILITIES BEFORE COMMENCING ANY WORK. THE CONTRACTOR MUST NOTIFY THE UTILITY COMPANIES INVOLVED PRIOR TO THE START OF THE WORK. CONTRACTOR AGREES TO BE FULLY RESPONSIBLE FOR THE COST OF ANY AND ALL DAMAGES WHICH OCCUR AS A RESULT OF A FAILURE TO EXACTLY LOCATE AND PRESERVE ANY AND ALL EXISTING UTILITIES TO REMAIN.
5. THE CONTRACTOR SHALL BE RESPONSIBLE FOR NOTIFYING "MISS UTILITY" AT 1-800-257-7777 FIVE DAYS PRIOR TO THE START OF ANY EXCAVATION WORK.
6. THE CONTRACTOR SHALL VERIFY ALL EXISTING UTILITY INVERTS AND CLEARANCES FROM NEW WORK PRIOR TO START OF ANY WORK.
7. THE CONTRACTOR SHALL STAKE OUT THE LOCATION OF ALL NEW CONSTRUCTION AND VERIFY ALL JURISDICTIONAL SETBACKS AND BUFFERS PRIOR TO START OF ANY WORK.
8. EXISTING UTILITIES WHICH ARE NOT TO BE REMOVED OR ABANDONED SHALL REMAIN OPERATIONAL AT ALL TIMES. APPROPRIATE EXISTING UTILITIES SHALL REMAIN IN SERVICE UNTIL REPLACEMENT/RELOCATED UTILITIES ARE OPERATIONAL.
9. CONTRACTOR SHALL PROVIDE POSITIVE DRAINAGE AWAY FROM ALL EXISTING AND PROPOSED BUILDING ENTRANCES DURING ALL PHASES OF CONSTRUCTION, UNLESS OTHERWISE NOTED IN THESE DOCUMENTS. CONTRACTOR SHALL NOTIFY ENGINEER/OWNER IF EXISTING OR PROPOSED CONDITIONS RESTRICT ABILITY TO ACHIEVE POSITIVE DRAINAGE FROM BUILDINGS PRIOR TO THE START OF CONSTRUCTION.
10. SEE SHEET C-003 FOR FULL EXISTING AND PROPOSED FEATURES LEGEND


STANDARD STABILIZATION NOTE:

Following initial soil disturbance or re-disturbance, seeding for permanent or temporary stabilization shall be completed within three (3) calendar days as to the surface of all perimeter controls, dikes, swales, ditches, perimeter slopes, and all slopes greater than 3 horizontal to 1 vertical (3:1); and seven (7) calendar days as to all other disturbed or graded areas on the project site not under active grading. Once vegetation is established, the site shall have 95% groundcover to be considered adequately stabilized.

| SITE SOILS SUMMARY TABLE | | | | | | |
|-----------------------------|------|-------|-----|--------|----------|--|
| NAME | UNIT | Slope | HSG | HYDRIC | K FACTOR | |
| Urban land-Urthents complex | UdD | 8-25% | D | No | Unrated | |
| Manor loam | MaB | 3-9% | B | No | 0.24 | |
| Manor loam | MaC | 8-15% | B | No | 0.28 | |
| Glenville silt loam | GmB | 3-8% | C/D | No | 0.37 | |

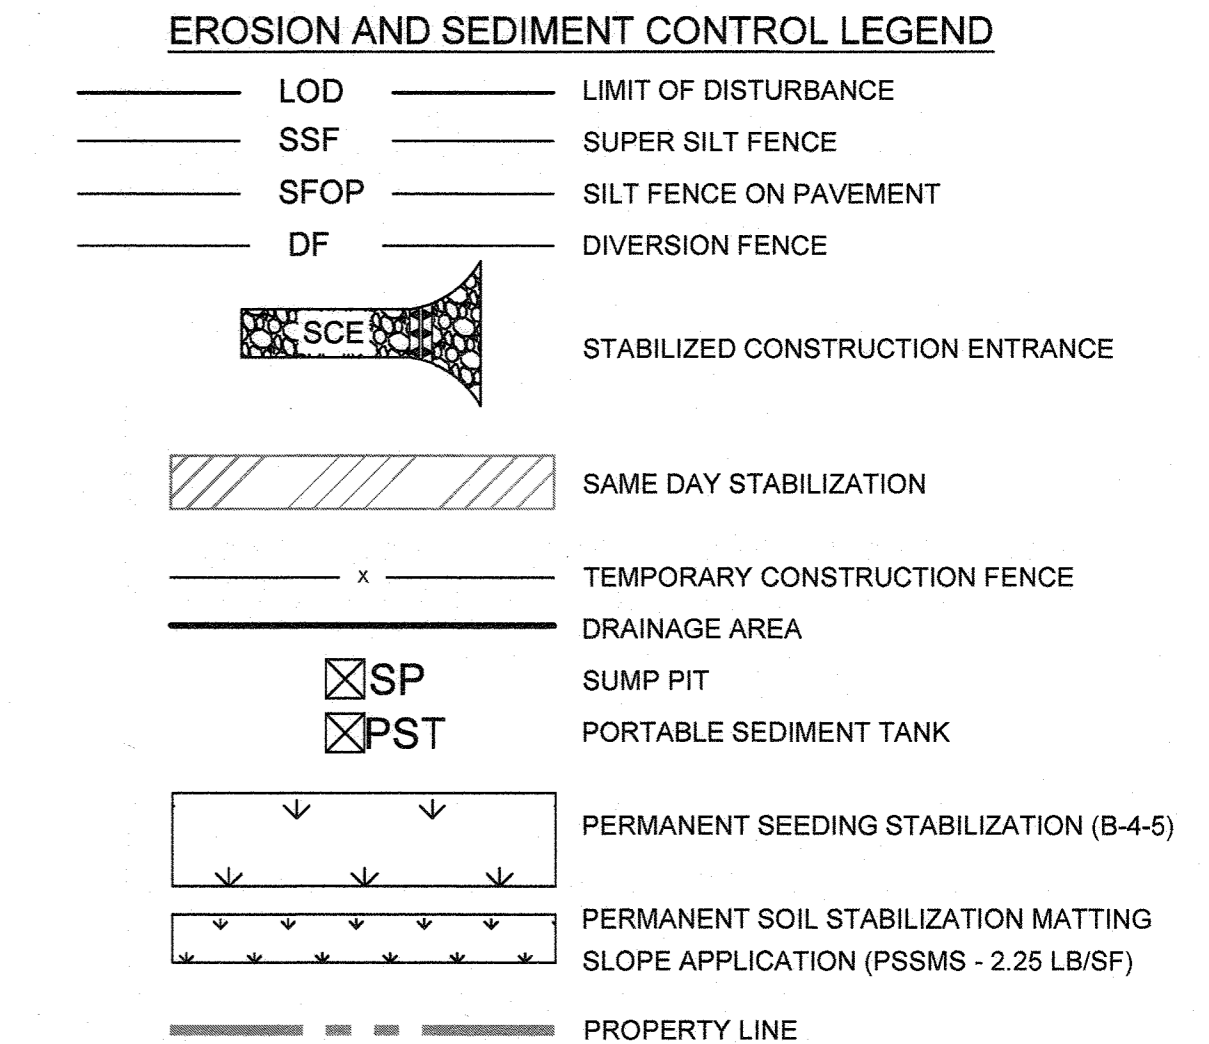


HOWARD SCD SIGNATURE BLOCK:
 This plan is approved for soil erosion and sediment control by the Howard Soil Conservation District.
Howard Soil Conservation District
 Date: 1/15/23

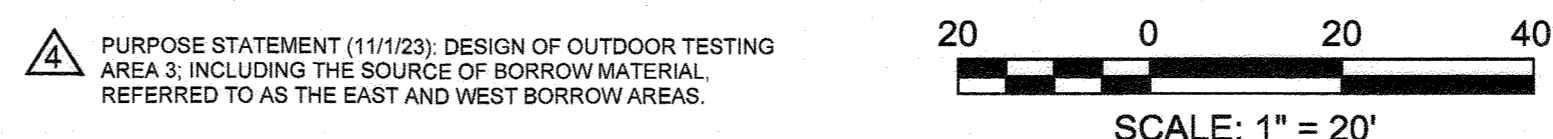

PURPOSE STATEMENT (11/1/23): DESIGN OF OUTDOOR TESTING AREA 3, INCLUDING THE SOURCE OF BORROW MATERIAL, REFERRED TO AS THE EAST AND WEST BORROW AREAS.

APPROVED: DEPARTMENT OF PLANNING AND ZONING
 Chief, Development Engineering Division
 Date: 12-5-23
 Chief, Division of Land Development
 Date: 2/22/24

RK&K
 RUMMEL, KLEPPER & KAHL, LLP
 ENGINEERS/CONSTRUCTION MANAGERS/PLANNERS/SCIENTISTS/RESPONSIVE PEOPLE-ORIENTED SOLUTIONS
 700 East Pratt Street, Suite 500
 Baltimore, MD 21202
 PH: 410.728.2900
 www.rk&k.com

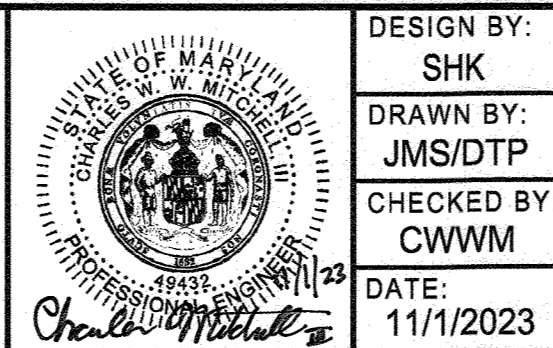


| | | | |
|-------------|-----------|----------|-----------|
| DESIGN BY: | SHK | DATE: | 11/1/2023 |
| DRAWN BY: | JMS/DTP | | |
| CHECKED BY: | CWMM | | |
| DATE: | 11/1/2023 | | |
| BY | NO. | REVISION | DATE |

OWNER/DEVELOPER
JOHNS HOPKINS APPLIED PHYSICS LABORATORY
 11100 JOHNS HOPKINS ROAD
 LAUREL, MARYLAND 20723

EROSION SEDIMENT CONTROL PLAN - EAST BORROW AREA (ESC PHASE 2C) OUTDOOR TESTING AREAS
 11100 JOHNS HOPKINS ROAD
 TAX MAP: 41 PARCEL: 123 GRID: 16 ZONED: PEG
 ELECTION DISTRICT 5 - HOWARD COUNTY, MARYLAND
 SHEET 67 OF 73
 SCALE: As Shown
 SDP-18-060

\\ad.rkk.com\fs\Cloud\Projects\2021\21047_APL2021MSA\Projects\Task 13 - OTA 3\CADD\Plans\C-691 - C-695 Erosion Sediment Control Plan - East Borrow Area (Phase 2C).dwg Oct 31, 2023 3:57pm dplachowski

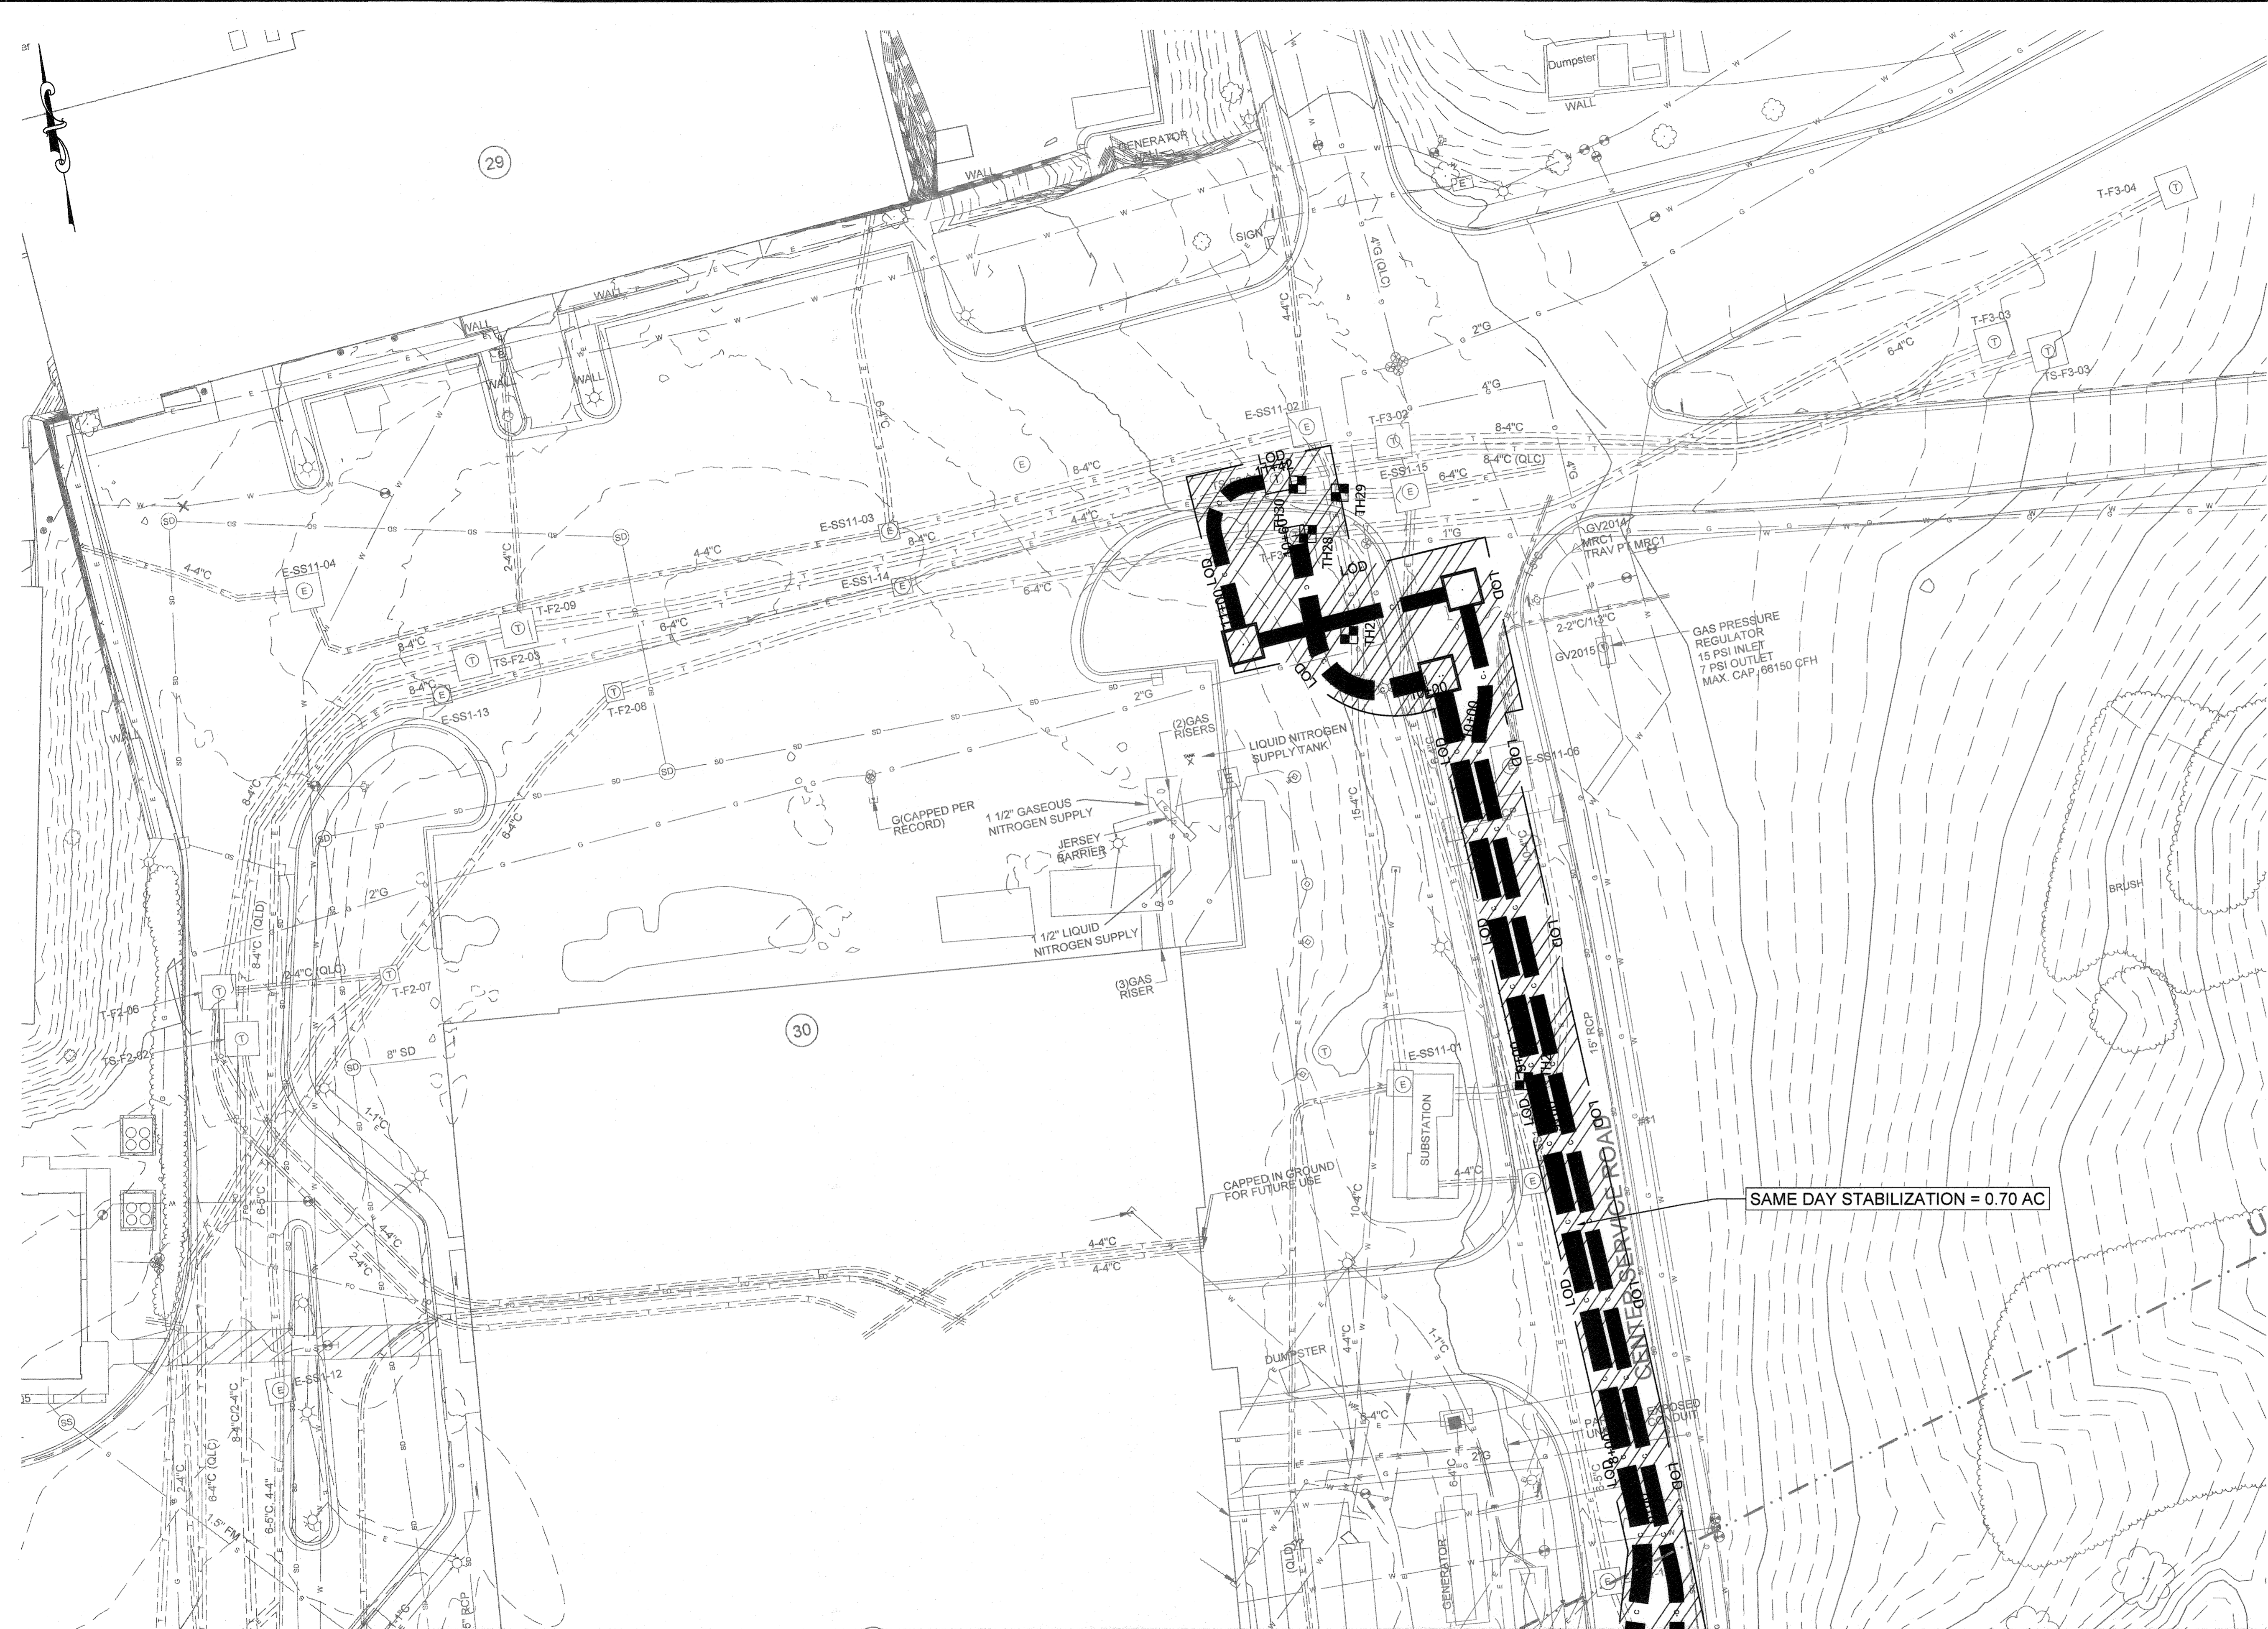

GENERAL NOTES

1. TOPOGRAPHIC AND SURFACE INFORMATION SHOWN WAS OBTAINED FROM FIELD SURVEY BY RK&K COMPLETED DECEMBER 23, 2021. UTILITY INFORMATION SHOWN WAS PROVIDED BY AJJIDATA ON FEBRUARY 4, 2022.
2. IT IS THE CONTRACTOR'S RESPONSIBILITY TO FIELD VERIFY ACTUAL SITE CONDITIONS PRIOR TO THE START OF ANY WORK. THERE IS NO WARRANTY OR GUARANTEE ON THE COMPLETENESS OR CORRECTNESS OF THE EXISTING CONDITION INFORMATION. ANY DISCREPANCY FOUND SHALL BE BROUGHT TO THE IMMEDIATE ATTENTION OF THE ARCHITECT/ENGINEER PRIOR TO THE START OF ANY WORK.
3. BEARINGS AND HORIZONTAL COORDINATES SHOWN ON THIS PLAN ARE BASED UPON MARYLAND STATE PLANE COORDINATE SYSTEM NAD83. VERTICAL ELEVATIONS SHOWN ARE BASED UPON VERTICAL DATUM NAVD83.
4. THE LOCATION OF EXISTING UNDERGROUND UTILITIES IS SHOWN IN AN APPROXIMATE WAY ONLY, BASED UPON FIELD OBSERVATIONS AND RECORD DOCUMENTS. THEY HAVE NOT BEEN COMPARED TO OR VERIFIED WITH FIELD TEST PITS. THE CONTRACTOR SHALL BE RESPONSIBLE TO VERIFY TO HIS OWN SATISFACTION THE EXACT LOCATION, SIZE AND TYPE OF ALL EXISTING UNDERGROUND UTILITIES BEFORE COMMENCING ANY WORK. THE CONTRACTOR MUST NOTIFY THE UTILITY COMPANIES INVOLVED PRIOR TO THE START OF THE WORK. CONTRACTOR AGREES TO BE FULLY RESPONSIBLE FOR THE COST OF ANY AND ALL DAMAGES WHICH OCCUR AS A RESULT OF A FAILURE TO EXACTLY LOCATE AND PRESERVE ANY AND ALL EXISTING UTILITIES TO REMAIN.
5. THE CONTRACTOR SHALL BE RESPONSIBLE FOR NOTIFYING "MISS UTILITY" AT 1-800-257-7777 FIVE DAYS PRIOR TO THE START OF ANY EXCAVATION WORK.
6. THE CONTRACTOR SHALL VERIFY ALL EXISTING UTILITY INVERTS AND CLEARANCES FROM NEW WORK PRIOR TO START OF ANY WORK.
7. THE CONTRACTOR SHALL STAKE OUT THE LOCATION OF ALL NEW CONSTRUCTION AND VERIFY ALL JURISDICTIONAL SETBACKS AND BUFFERS PRIOR TO START OF ANY WORK.
8. EXISTING UTILITIES WHICH ARE NOT TO BE REMOVED OR ABANDONED SHALL REMAIN OPERATIONAL AT ALL TIMES. APPROPRIATE EXISTING UTILITIES SHALL REMAIN IN SERVICE UNTIL REPLACEMENT/RELOCATED UTILITIES ARE OPERATIONAL.
9. CONTRACTOR SHALL PROVIDE POSITIVE DRAINAGE AWAY FROM ALL EXISTING AND PROPOSED BUILDING ENTRANCES DURING ALL PHASES OF CONSTRUCTION, UNLESS OTHERWISE NOTED IN THESE DOCUMENTS. CONTRACTOR SHALL NOTIFY ENGINEER/OWNER IF EXISTING OR PROPOSED CONDITIONS RESTRICT ABILITY TO ACHIEVE POSITIVE DRAINAGE FROM BUILDINGS PRIOR TO THE START OF CONSTRUCTION.
10. SEE SHEET C-003 FOR FULL EXISTING AND PROPOSED FEATURES LEGEND

STANDARD STABILIZATION NOTE:

Following initial soil disturbance or re-disturbance, seeding for permanent or temporary stabilization shall be completed within three (3) calendar days as to the surface of all perimeter controls, dikes, swales, ditches, perimeter slopes, and all slopes greater than 3 horizontal to 1 vertical (3:1); and seven (7) calendar days as to all other disturbed or graded areas on the project site not under active grading. Once vegetation is established, the site shall have 95% groundcover to be considered adequately stabilized.


| SITE SOILS SUMMARY TABLE | | | | | | |
|-------------------------------|------|-------|-----|--------|----------|--|
| NAME | UNIT | Slope | HSG | HYDRIC | K FACTOR | |
| Urban land-Udorthents complex | UdD | 8-25% | D | No | Unrated | |
| Manor loam | MaB | 3-8% | B | No | 0.24 | |
| Manor loam | MaC | 8-15% | B | No | 0.28 | |
| Glenville silt loam | GmB | 3-8% | C/D | No | 0.37 | |

EROSION AND SEDIMENT CONTROL LEGEND

- LOD ——— LIMIT OF DISTURBANCE
- SAME DAY STABILIZATION

MATCHLINE - SEE SHEET C-691

▲ PURPOSE STATEMENT (11/1/23): DESIGN OF OUTDOOR TESTING AREA 3, INCLUDING THE SOURCE OF BORROW MATERIAL, REFERRED TO AS THE EAST AND WEST BORROW AREAS.

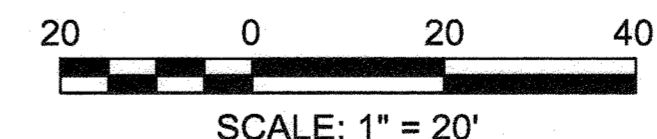

HOWARD SCD SIGNATURE BLOCK:
 This plan is approved for soil erosion and sediment control by the Howard Soil Conservation District.
Wendy Batchie 11/15/23
 Howard Soil Conservation District Date

APPROVED: DEPARTMENT OF PLANNING AND ZONING
 Chief, Development Engineering Division
 Date: 12-5-23
 Chief, Division of Land Development
 Date: 2/22/24



PROFESSIONAL CERTIFICATION: I HEREBY CERTIFY THAT THESE DOCUMENTS WERE PREPARED OR APPROVED BY ME, AND THAT I AM A DULY LICENSED PROFESSIONAL ENGINEER UNDER THE LAWS OF THE STATE OF MARYLAND, LICENSE NO. 48492, EXPIRATION DATE: MAY 31, 2024.




| | | | | | |
|-------------|-----------|------|-----|---|---------|
| DESIGN BY: | SHK | RK&K | 4 | New Sheet - OTA-3 and Borrow Area Modifications | 11/1/23 |
| DRAWN BY: | JMS/DTP | | | | |
| CHECKED BY: | CWMM | | | | |
| DATE: | 11/1/2023 | BY | NO. | REVISION | DATE |

OWNER/DEVELOPER
 JOHNS HOPKINS
 APPLIED PHYSICS LABORATORY
 11100 JOHNS HOPKINS ROAD
 LAUREL, MARYLAND 20723

EROSION SEDIMENT CONTROL PLAN - EAST BORROW AREA (ESC PHASE 2C)
 JOHNS HOPKINS UNIVERSITY - APPLIED PHYSICS LABORATORY
OUTDOOR TESTING AREAS
 11100 JOHNS HOPKINS ROAD
 TAX MAP: 41 PARCEL: 123 GRID: 16 ZONED: PEC
 ELECTION DISTRICT 5 - HOWARD COUNTY, MARYLAND
 SHEET 68 OF 73

C-693
 RK&K PROJECT NUMBER 21047.013
 SCALE: As Shown

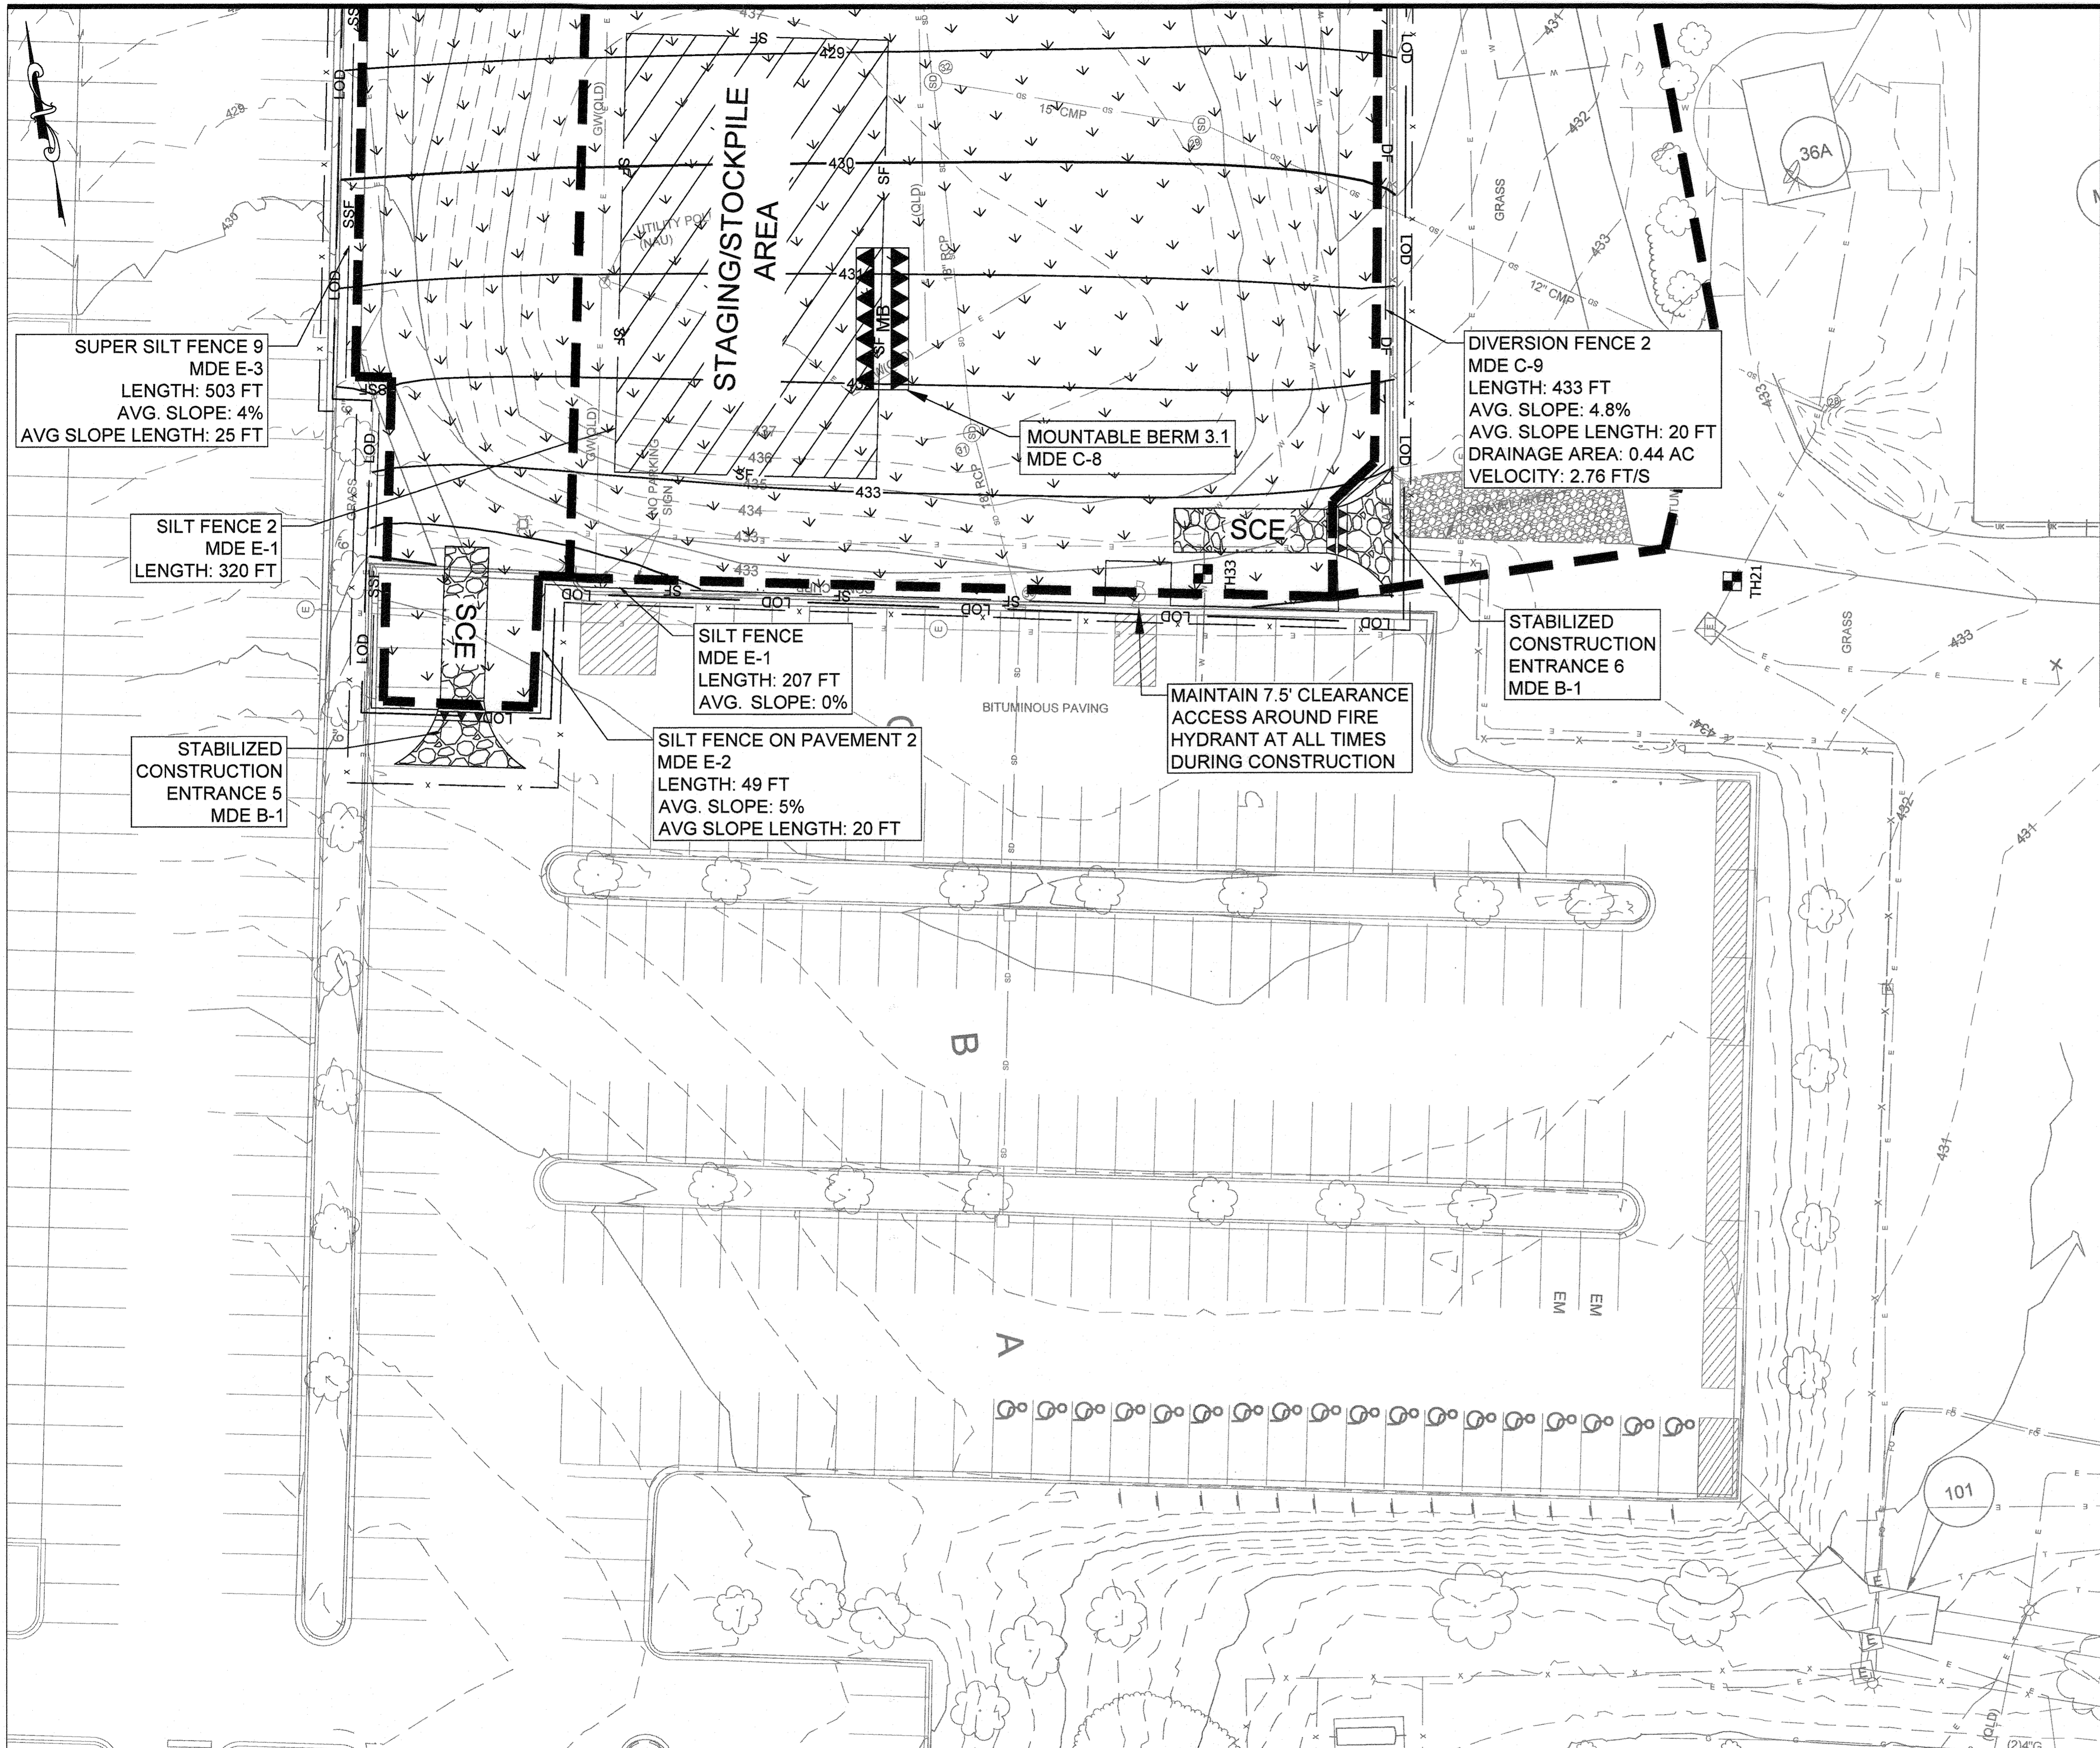

MATCHLINE - SEE SHEET C-692

MATCHLINE - SEE SHEET C-692

GENERAL NOTES

1. TOPOGRAPHIC AND SURFACE INFORMATION SHOWN WAS OBTAINED FROM FIELD SURVEY BY RK&K, COMPLETED DECEMBER 23, 2021. UTILITY INFORMATION SHOWN WAS PROVIDED BY AII/DATA ON FEBRUARY 4, 2022.
2. IT IS THE CONTRACTOR'S RESPONSIBILITY TO FIELD VERIFY ACTUAL SITE CONDITIONS PRIOR TO THE START OF ANY WORK. THERE IS NO WARRANTY OR GUARANTEE ON THE COMPLETENESS OR CORRECTNESS OF THE EXISTING CONDITION INFORMATION. ANY DISCREPANCY FOUND SHALL BE BROUGHT TO THE IMMEDIATE ATTENTION OF THE ARCHITECT/ENGINEER PRIOR TO THE START OF ANY WORK.
3. BEARINGS AND HORIZONTAL COORDINATES SHOWN ON THIS PLAN ARE BASED UPON MARYLAND STATE PLANE COORDINATE SYSTEM NAD83. VERTICAL ELEVATIONS SHOWN ARE BASED UPON VERTICAL DATUM NAVD83.
4. THE LOCATION OF EXISTING UNDERGROUND UTILITIES IS SHOWN IN AN APPROXIMATE WAY ONLY, BASED UPON FIELD OBSERVATIONS AND RECORD DOCUMENTS. THEY HAVE NOT BEEN COMPARED TO OR VERIFIED WITH FIELD TEST PITS. THE CONTRACTOR SHALL BE RESPONSIBLE TO VERIFY TO HIS OWN SATISFACTION THE EXACT LOCATION, SIZE AND TYPE OF ALL EXISTING UNDERGROUND UTILITIES BEFORE COMMENCING ANY WORK. THE CONTRACTOR MUST NOTIFY THE UTILITY COMPANIES INVOLVED PRIOR TO THE START OF THE WORK. CONTRACTOR AGREES TO BE FULLY RESPONSIBLE FOR THE COST OF ANY AND ALL DAMAGES WHICH OCCUR AS A RESULT OF A FAILURE TO EXACTLY LOCATE AND PRESERVE ANY AND ALL EXISTING UTILITIES TO REMAIN.
5. THE CONTRACTOR SHALL BE RESPONSIBLE FOR NOTIFYING "MISS UTILITY" AT 1-800-257-7777 FIVE DAYS PRIOR TO THE START OF ANY EXCAVATION WORK.
6. THE CONTRACTOR SHALL VERIFY ALL EXISTING UTILITY INVERTS AND CLEARANCES FROM NEW WORK PRIOR TO START OF ANY WORK.
7. THE CONTRACTOR SHALL STAKE OUT THE LOCATION OF ALL NEW CONSTRUCTION AND VERIFY ALL JURISDICTIONAL SETBACKS AND BUFFERS PRIOR TO START OF ANY WORK.
8. EXISTING UTILITIES WHICH ARE NOT TO BE REMOVED OR ABANDONED SHALL REMAIN OPERATIONAL AT ALL TIMES. APPROPRIATE EXISTING UTILITIES SHALL REMAIN IN SERVICE UNTIL REPLACEMENT/RELOCATED UTILITIES ARE OPERATIONAL.
9. CONTRACTOR SHALL PROVIDE POSITIVE DRAINAGE AWAY FROM ALL EXISTING AND PROPOSED BUILDING ENTRANCES DURING ALL PHASES OF CONSTRUCTION, UNLESS OTHERWISE NOTED IN THESE DOCUMENTS. CONTRACTOR SHALL NOTIFY ENGINEER/OWNER IF EXISTING OR PROPOSED CONDITIONS RESTRICT ABILITY TO ACHIEVE POSITIVE DRAINAGE FROM BUILDINGS PRIOR TO THE START OF CONSTRUCTION.
10. SEE SHEET C-003 FOR FULL EXISTING AND PROPOSED FEATURES LEGEND

STANDARD STABILIZATION NOTE:

Following initial soil disturbance or re-disturbance, seeding for permanent or temporary stabilization shall be completed within three (3) calendar days as to the surface of all perimeter controls, dikes, swales, ditches, perimeter slopes, and all slopes greater than 3 horizontal to 1 vertical (3:1); and seven (7) calendar days as to all other disturbed or graded areas on the project site not under active grading. Once vegetation is established, the site shall have 95% groundcover to be considered adequately stabilized.

SITE SOILS SUMMARY TABLE

| NAME | UNIT | Slope | HSG | HYDRIC | K FACTOR |
|-------------------------------|------|-------|-----|--------|----------|
| Urban land-Udorthents complex | UdD | 8-25% | D | No | Unrated |
| Minor loam | MaB | 3-8% | B | No | 0.24 |
| Minor loam | MaC | 8-15% | B | No | 0.28 |
| Glenville silt loam | GmB | 3-8% | C/D | No | 0.37 |


EROSION AND SEDIMENT CONTROL LEGEND

- LOD ——— LIMIT OF DISTURBANCE
- SSF ——— SUPER SILT FENCE
- SFOP ——— SILT FENCE ON PAVEMENT
- DF ——— DIVERSION FENCE
- STABILIZED CONSTRUCTION ENTRANCE
- SAME DAY STABILIZATION
- x ——— TEMPORARY CONSTRUCTION FENCE
- ——— DRAINAGE AREA
- SUMP PIT
- PORTABLE SEDIMENT TANK
- PERMANENT SEEDING STABILIZATION (B-4-5)
- PERMANENT SOIL STABILIZATION MATTING SLOPE APPLICATION (PSSMS - 2.25 LB/SF)

HOWARD SCD SIGNATURE BLOCK:

This plan is approved for soil erosion and sediment control by the Howard Soil Conservation District.
Alexander Butcher 11/15/23
 Howard Soil Conservation District Date

▲ PURPOSE STATEMENT (11/1/23): DESIGN OF OUTDOOR TESTING AREA 3, INCLUDING THE SOURCE OF BORROW MATERIAL. REFERRED TO AS THE EAST AND WEST BORROW AREAS.

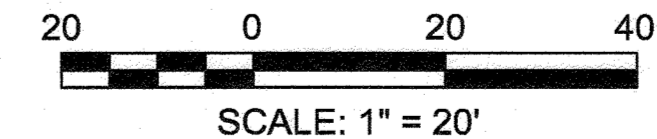

APPROVED: DEPARTMENT OF PLANNING AND ZONING
 Chief, Development Engineering Division
 Date: 12-5-23
 Date: 2/22/24



PROFESSIONAL CERTIFICATION: I HEREBY CERTIFY THAT THESE DOCUMENTS WERE PREPARED OR APPROVED BY ME AND THAT I AM A DULY LICENSED PROFESSIONAL ENGINEER UNDER THE LAWS OF THE STATE OF MARYLAND, LICENSE NO. 4842, EXPIRATION DATE: MAY 31, 2024.



| | | | | | |
|-------------|-----------|------|-----|---|---------|
| DESIGN BY: | SHK | RK&K | 4 | New Sheet - OTA-3 and Borrow Area Modifications | 11/1/23 |
| DRAWN BY: | JMS/DTP | | | | |
| CHECKED BY: | CWMM | | | | |
| DATE: | 11/1/2023 | BY | NO. | REVISION | DATE |

OWNER/DEVELOPER
JOHNS HOPKINS APPLIED PHYSICS LABORATORY
 11100 JOHNS HOPKINS ROAD
 LAUREL, MARYLAND 20723

EROSION SEDIMENT CONTROL PLAN - WEST BORROW AREA (ESC PHASE 2C)
 JOHNS HOPKINS UNIVERSITY - APPLIED PHYSICS LABORATORY
OUTDOOR TESTING AREAS
 11100 JOHNS HOPKINS ROAD
 PARCEL: 123 GRID: 14 ZONED: PEG
 ELECTION DISTRICT 5 - HOWARD COUNTY, MARYLAND
 SHEET 69 OF 73

C-694
 RK&K PROJECT NUMBER 21047.013
 SCALE: As Shown

GENERAL NOTES

- TOPOGRAPHIC AND SURFACE INFORMATION SHOWN WAS OBTAINED FROM FIELD SURVEY BY RK&K, COMPLETED DECEMBER 23, 2021. UTILITY INFORMATION SHOWN WAS PROVIDED BY AIDATA ON FEBRUARY 4, 2022.
- IT IS THE CONTRACTOR'S RESPONSIBILITY TO FIELD VERIFY ACTUAL SITE CONDITIONS PRIOR TO THE START OF ANY WORK. THERE IS NO WARRANTY OR GUARANTEE ON THE COMPLETENESS OR CORRECTNESS OF THE EXISTING CONDITION INFORMATION. ANY DISCREPANCY FOUND SHALL BE BROUGHT TO THE IMMEDIATE ATTENTION OF THE ARCHITECT/ENGINEER PRIOR TO THE START OF ANY WORK.
- BEARINGS AND HORIZONTAL COORDINATES SHOWN ON THIS PLAN ARE BASED UPON MARYLAND STATE PLANE COORDINATE SYSTEM NAD83. VERTICAL ELEVATIONS SHOWN ARE BASED UPON VERTICAL DATUM NAVD83.
- THE LOCATION OF EXISTING UNDERGROUND UTILITIES IS SHOWN IN AN APPROXIMATE WAY ONLY, BASED UPON FIELD OBSERVATIONS AND RECORD DOCUMENTS. THEY HAVE NOT BEEN COMPARED TO OR VERIFIED WITH FIELD TEST PITS. THE CONTRACTOR SHALL BE RESPONSIBLE TO VERIFY TO HIS OWN SATISFACTION THE EXACT LOCATION, SIZE AND TYPE OF ALL EXISTING UNDERGROUND UTILITIES BEFORE COMMENCING ANY WORK. THE CONTRACTOR MUST NOTIFY THE UTILITY COMPANIES INVOLVED PRIOR TO THE START OF THE WORK. CONTRACTOR AGREES TO BE FULLY RESPONSIBLE FOR THE COST OF ANY AND ALL DAMAGES WHICH OCCUR AS A RESULT OF A FAILURE TO EXACTLY LOCATE AND PRESERVE ANY AND ALL EXISTING UTILITIES TO REMAIN.
- THE CONTRACTOR SHALL BE RESPONSIBLE FOR NOTIFYING "MISS UTILITY" AT 1-800-257-7777 FIVE DAYS PRIOR TO THE START OF ANY EXCAVATION WORK.
- THE CONTRACTOR SHALL VERIFY ALL EXISTING UTILITY INVERTS AND CLEARANCES FROM NEW WORK PRIOR TO START OF ANY WORK.
- THE CONTRACTOR SHALL STAKE OUT THE LOCATION OF ALL NEW CONSTRUCTION AND VERIFY ALL JURISDICTIONAL SETBACKS AND BUFFERS PRIOR TO START OF ANY WORK.
- EXISTING UTILITIES WHICH ARE NOT TO BE REMOVED OR ABANDONED SHALL REMAIN OPERATIONAL AT ALL TIMES. APPROPRIATE EXISTING UTILITIES SHALL REMAIN IN SERVICE UNTIL REPLACEMENT/RELOCATED UTILITIES ARE OPERATIONAL.
- CONTRACTOR SHALL PROVIDE POSITIVE DRAINAGE AWAY FROM ALL EXISTING AND PROPOSED BUILDING ENTRANCES DURING ALL PHASES OF CONSTRUCTION, UNLESS OTHERWISE NOTED IN THESE DOCUMENTS. CONTRACTOR SHALL NOTIFY ENGINEER/OWNER IF EXISTING OR PROPOSED CONDITIONS RESTRICT ABILITY TO ACHIEVE POSITIVE DRAINAGE FROM BUILDINGS PRIOR TO THE START OF CONSTRUCTION.
- SEE SHEET C-003 FOR FULL EXISTING AND PROPOSED FEATURES LEGEND.

STANDARD STABILIZATION NOTE:


Following initial soil disturbance or re-disturbance, seeding for permanent or temporary stabilization shall be completed within three (3) calendar days as to the surface of all perimeter controls, dikes, swales, ditches, perimeter slopes, and all slopes greater than 3 horizontal to 1 vertical (3:1); and seven (7) calendar days as to all other disturbed or graded areas on the project site not under active grading. Once vegetation is established, the site shall have 95% groundcover to be considered adequately stabilized.

| SITE SOILS SUMMARY TABLE | | | | | |
|-------------------------------|------|-------|-----|--------|----------|
| NAME | UNIT | Slope | H5G | HYDRIC | K FACTOR |
| Urban land-Udorthents complex | UdD | 8-25% | D | No | Unrated |
| Manor loam | MaB | 3-8% | B | No | 0.24 |
| Manor loam | MaC | 8-15% | B | No | 0.28 |
| Glenville silt loam | GmB | 3-8% | C/D | No | 0.37 |

EROSION AND SEDIMENT CONTROL LEGEND

- LOD LIMIT OF DISTURBANCE
- SSF SUPER SILT FENCE
- SFOP SILT FENCE ON PAVEMENT
- DF DIVERSION FENCE
- SCE STABILIZED CONSTRUCTION ENTRANCE
- SD SAME DAY STABILIZATION
- TCF TEMPORARY CONSTRUCTION FENCE
- DA DRAINAGE AREA
- SP SUMP PIT
- PST PORTABLE SEDIMENT TANK
- PS PERMANENT SEEDING STABILIZATION (B-4-5)
- PM PERMANENT SOIL STABILIZATION MATTING SLOPE APPLICATION (PSSMS - 2.25 LB/SF)
- PL PROPERTY LINE

HOWARD SCD SIGNATURE BLOCK:
 This plan is approved for soil erosion and sediment control by the Howard Soil Conservation District.
Howard SCD District 11/15/23
 Date

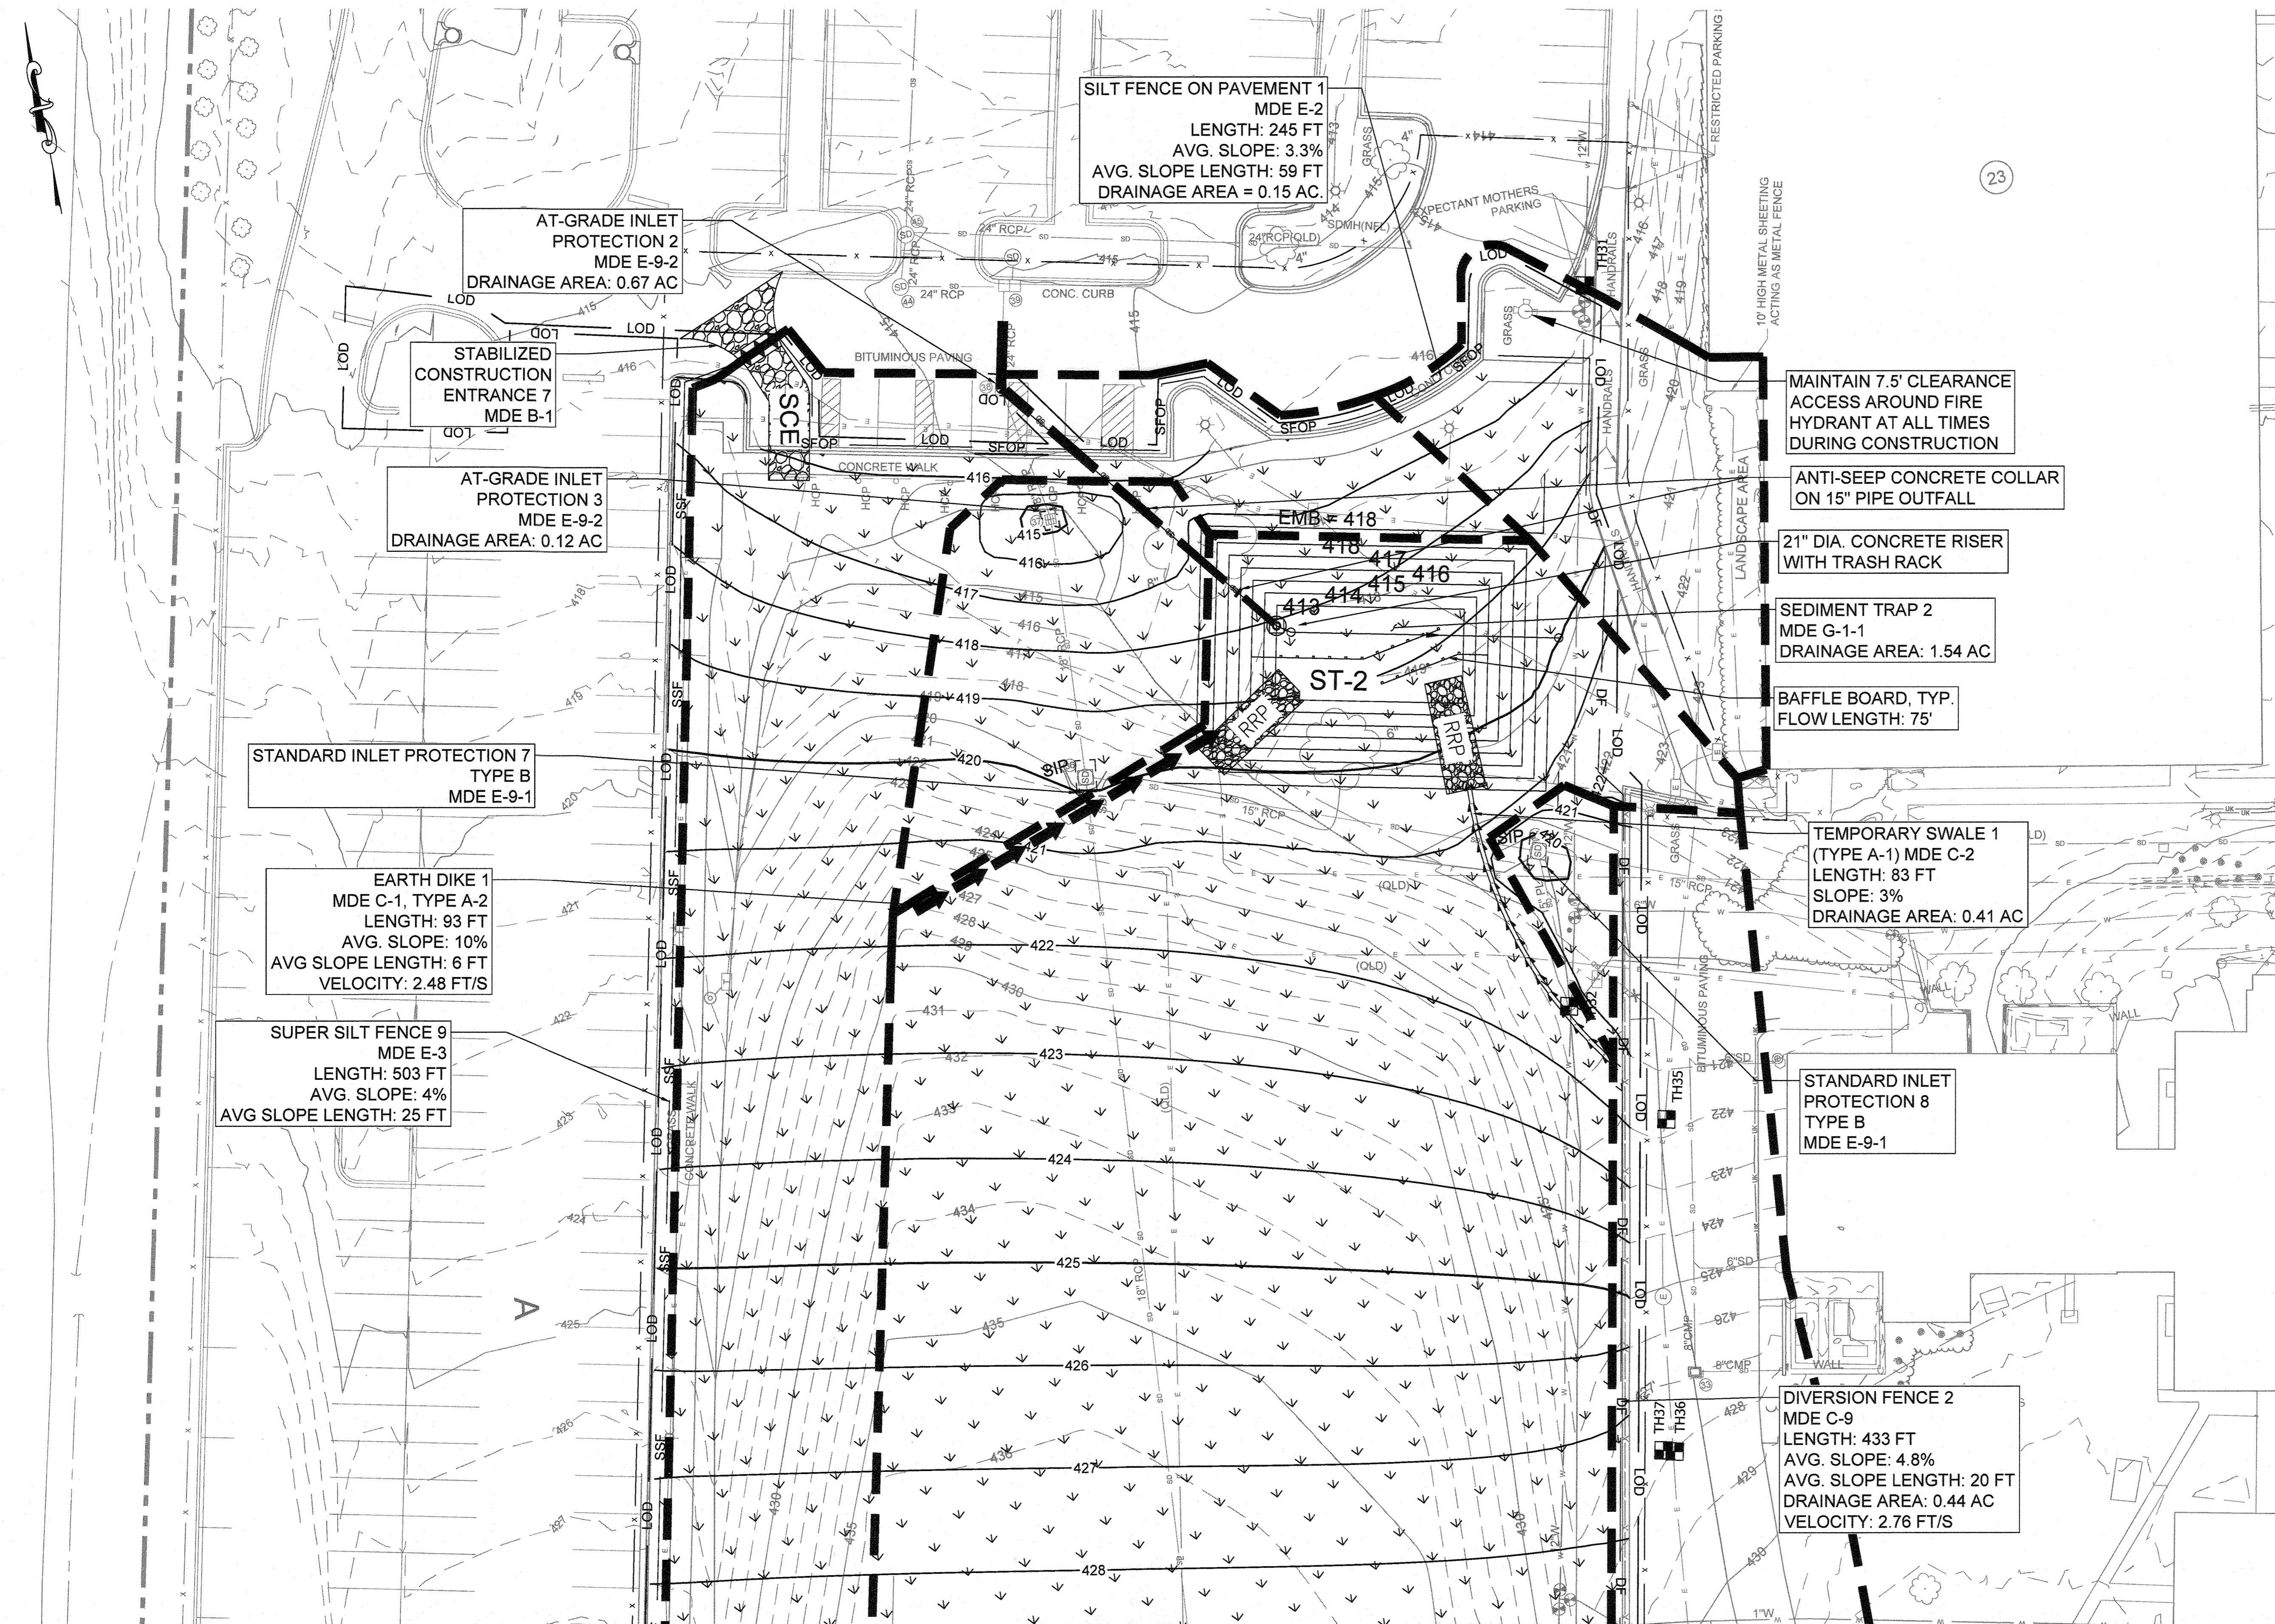


MATCHLINE - SEE SHEET C-694

PURPOSE STATEMENT (11/1/23): DESIGN OF OUTDOOR TESTING AREA 3, INCLUDING THE SOURCE OF BORROW MATERIAL REFERRED TO AS THE EAST AND WEST BORROW AREAS.
 SCALE: 1" = 20'

APPROVED: DEPARTMENT OF PLANNING AND ZONING
 Chief, Development Engineering Division
 Date: 12.5.23
 Chief, Division of Land Development
 Date: 2/22/24








PROFESSIONAL CERTIFICATION: I HEREBY CERTIFY THAT THESE DOCUMENTS WERE PREPARED OR APPROVED BY ME, AND THAT I AM A DULY LICENSED PROFESSIONAL ENGINEER UNDER THE LAWS OF THE STATE OF MARYLAND. LICENSE NO. 48432, EXPIRATION DATE: MAY 31, 2026.

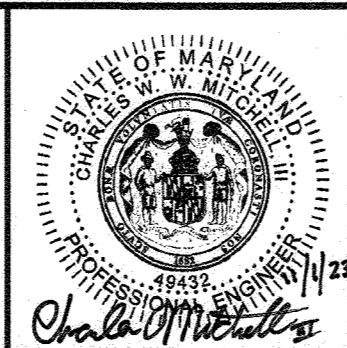

| | | | | |
|-------------------|------|-----|---|---------|
| DESIGN BY: SHK | RK&K | 4 | New Sheet - OTA-3 and Borrow Area Modifications | 11/1/23 |
| DRAWN BY: JMS/DTP | | | | |
| CHECKED BY: CWWW | | | | |
| DATE: 11/1/2023 | BY | NO. | REVISION | DATE |

OWNER/DEVELOPER
 JOHNS HOPKINS
 APPLIED PHYSICS LABORATORY
 11100 JOHNS HOPKINS ROAD
 LAUREL, MARYLAND 20723

EROSION SEDIMENT CONTROL PLAN - WEST BORROW AREA (ESC PHASE 2C)
 JOHNS HOPKINS UNIVERSITY - APPLIED PHYSICS LABORATORY
OUTDOOR TESTING AREAS
 11100 JOHNS HOPKINS ROAD
 PARCEL: 123 GRID: 16 ZONED: PEG
 ELECTION DISTRICT 5 - HOWARD COUNTY, MARYLAND
 SHEET 70 OF 73
 SCALE: As Shown

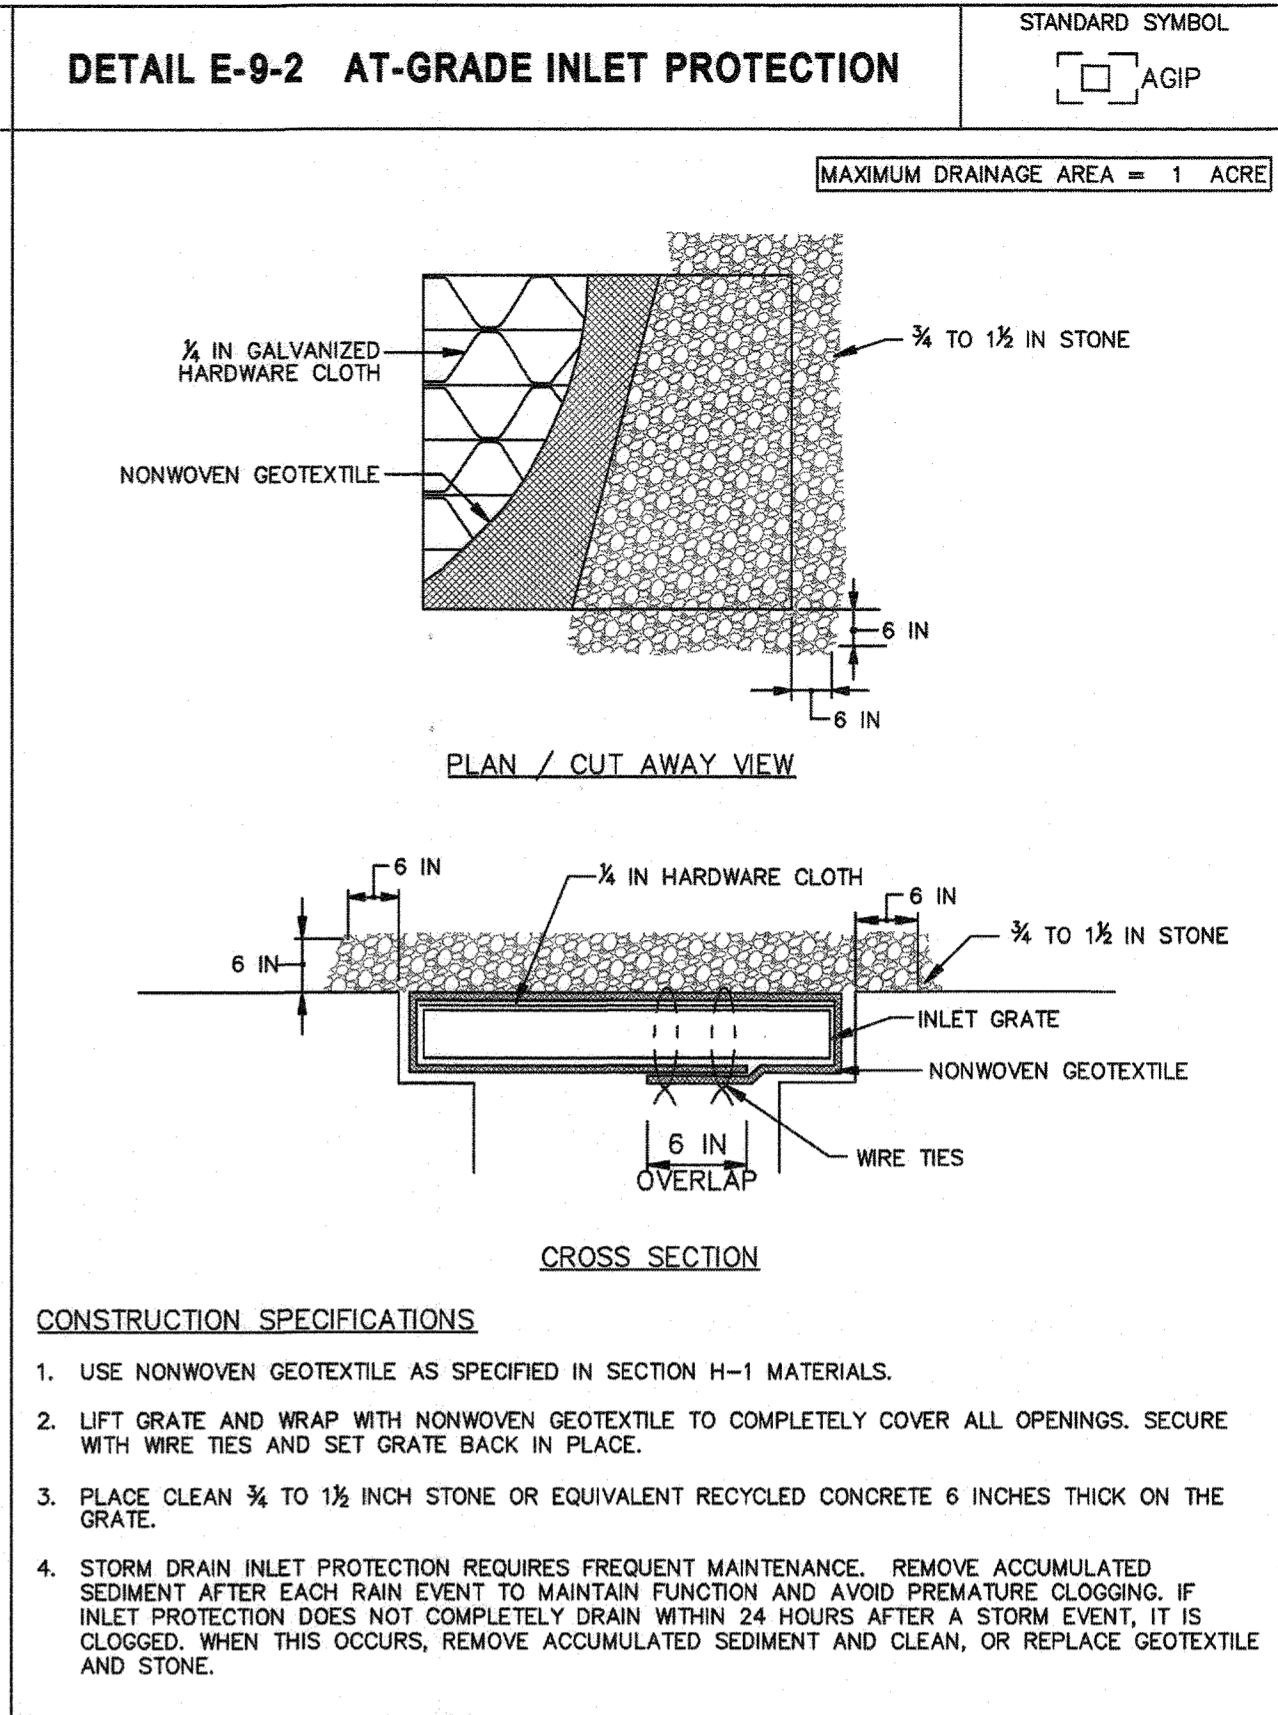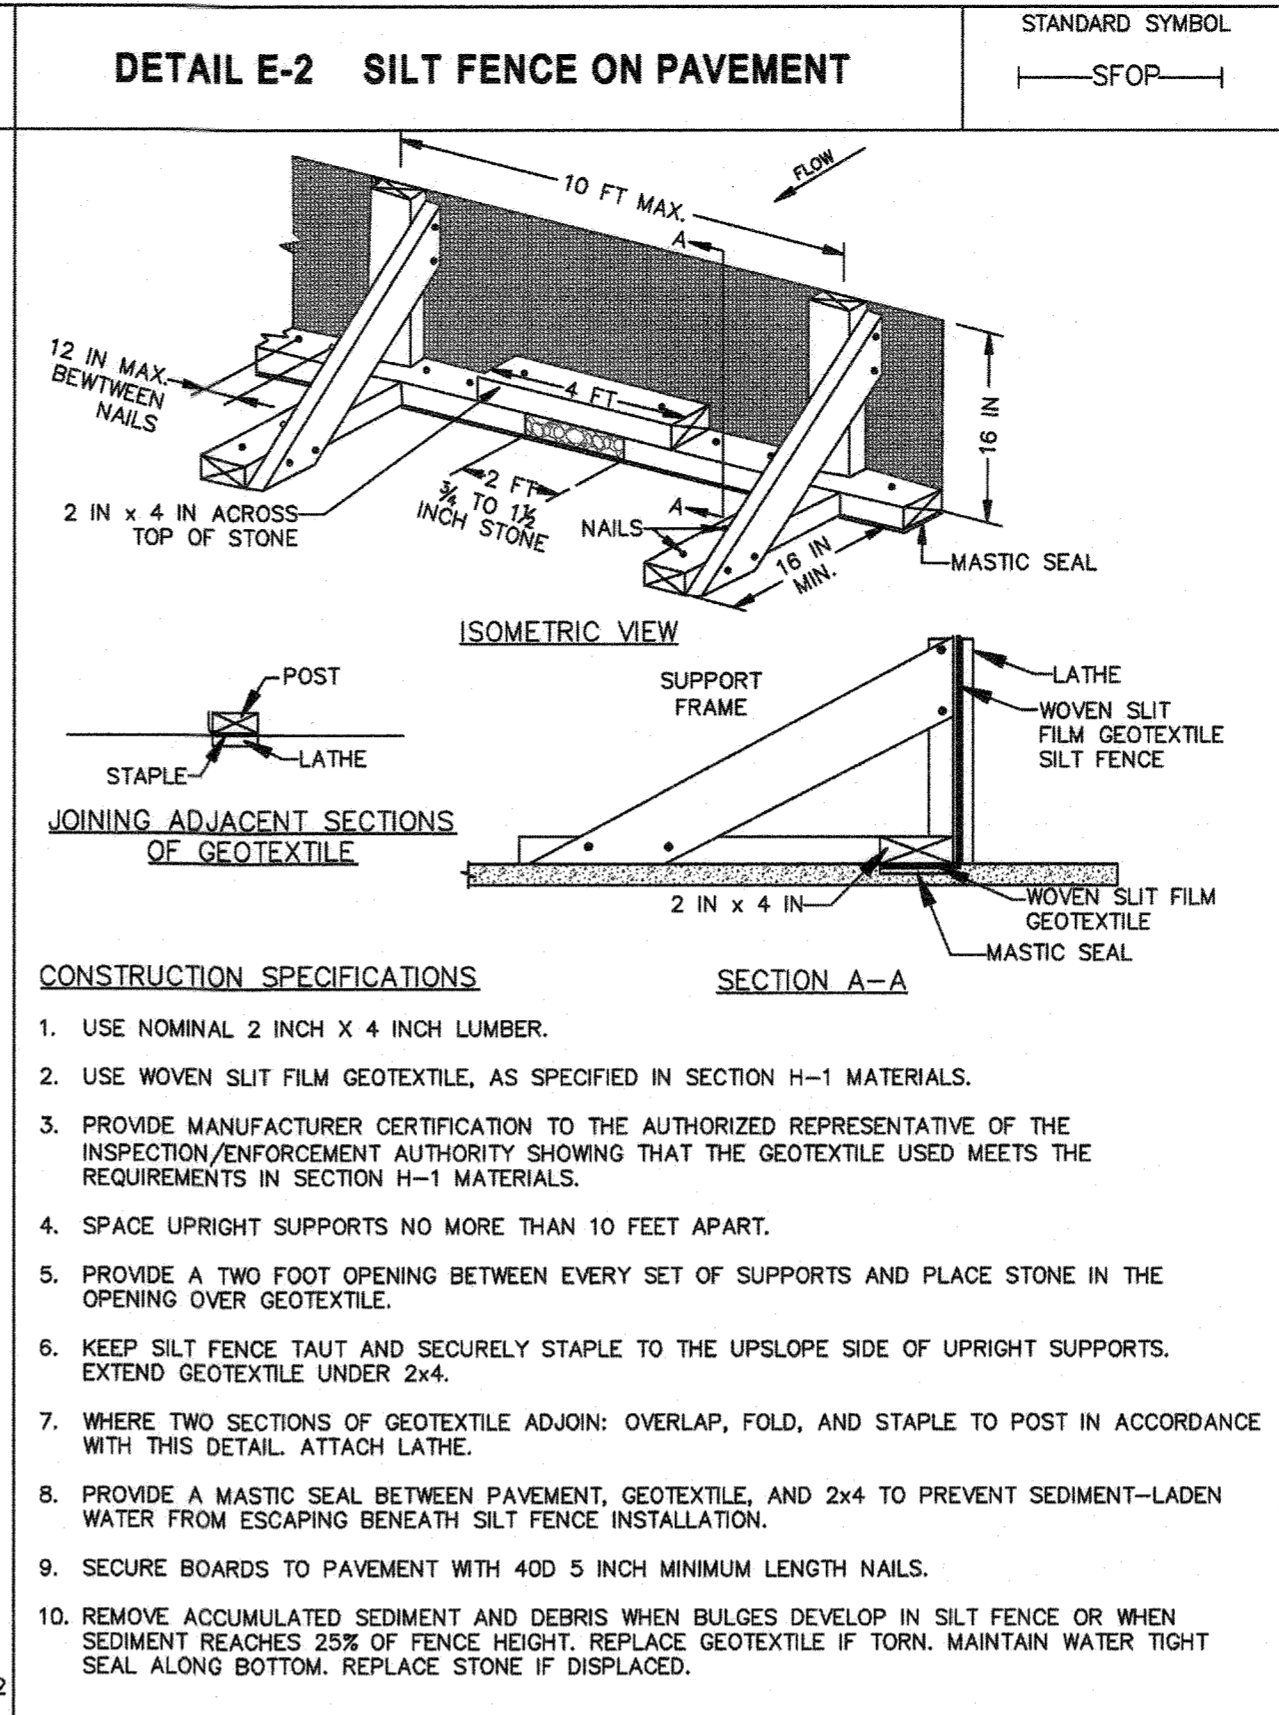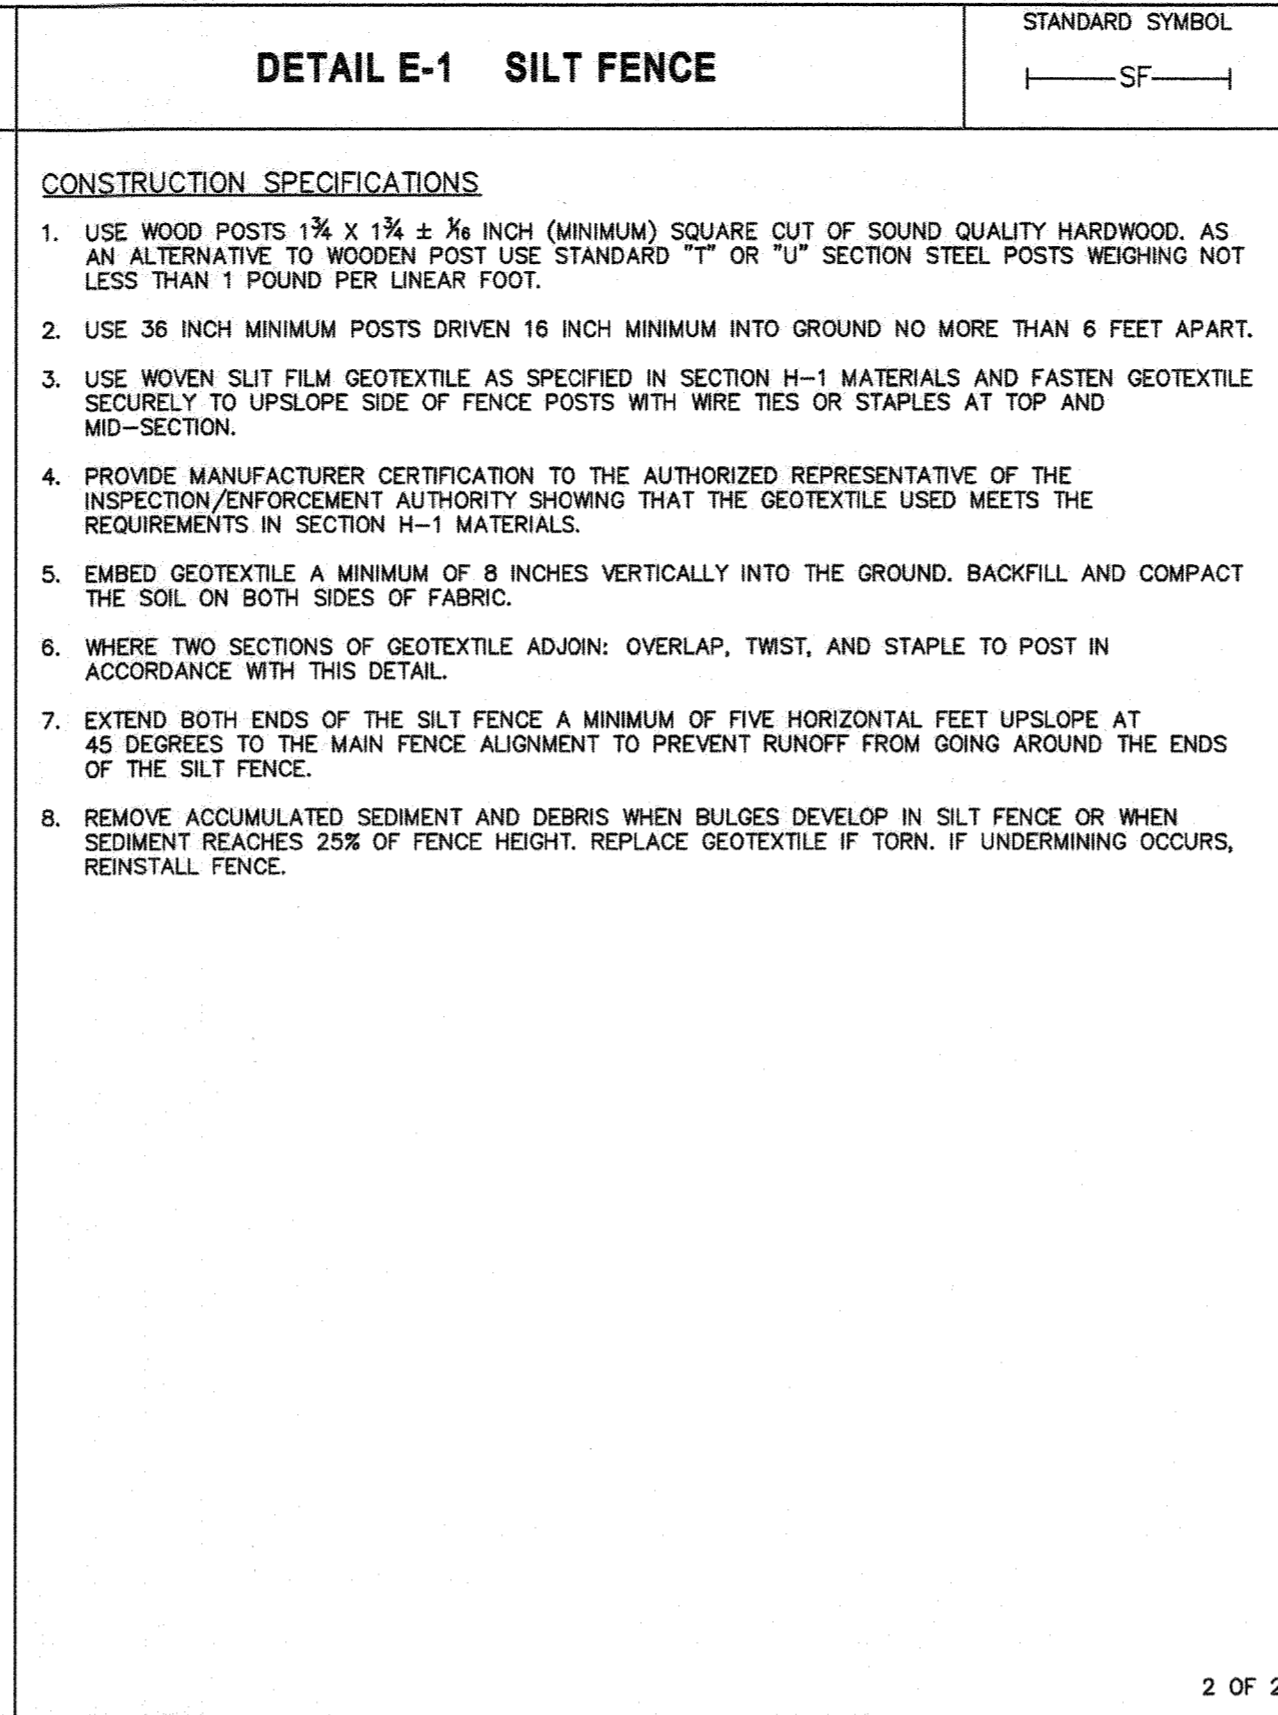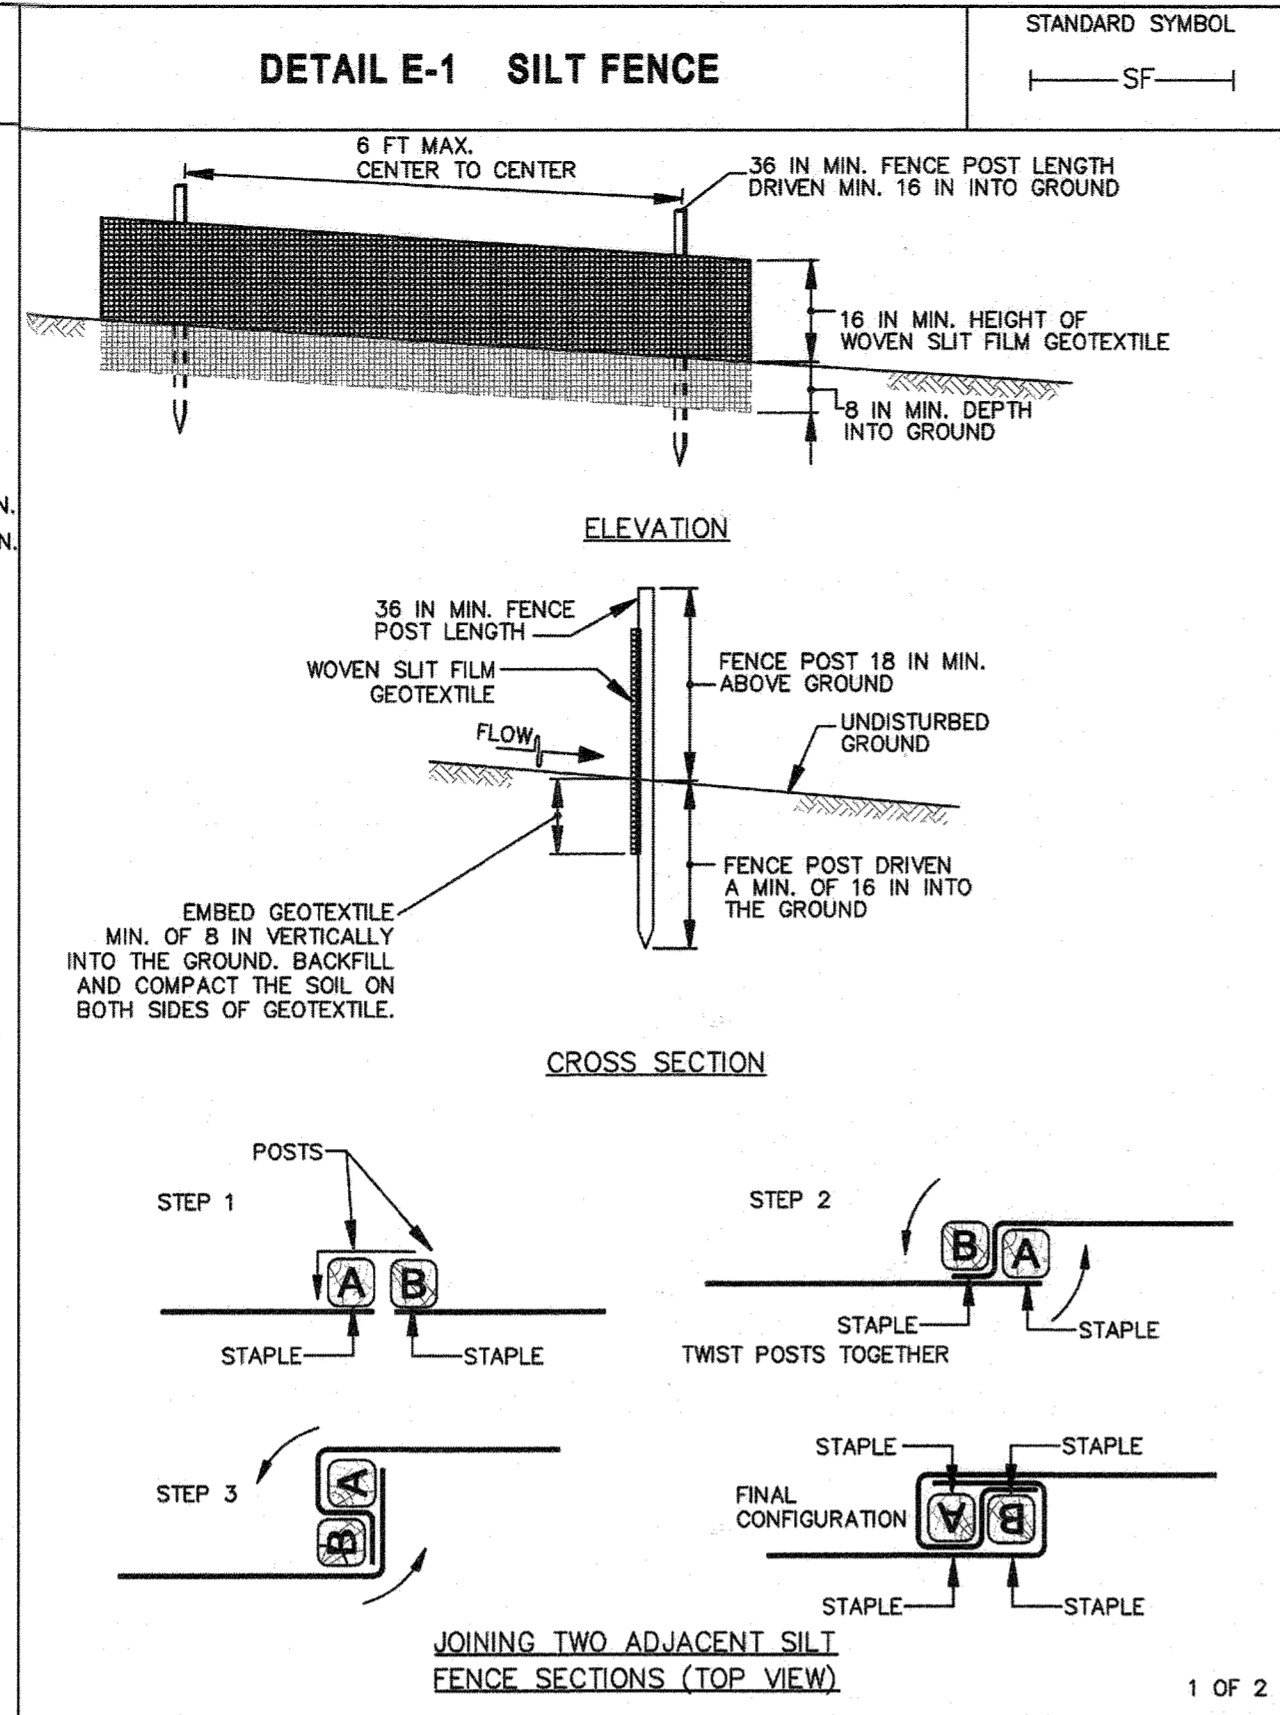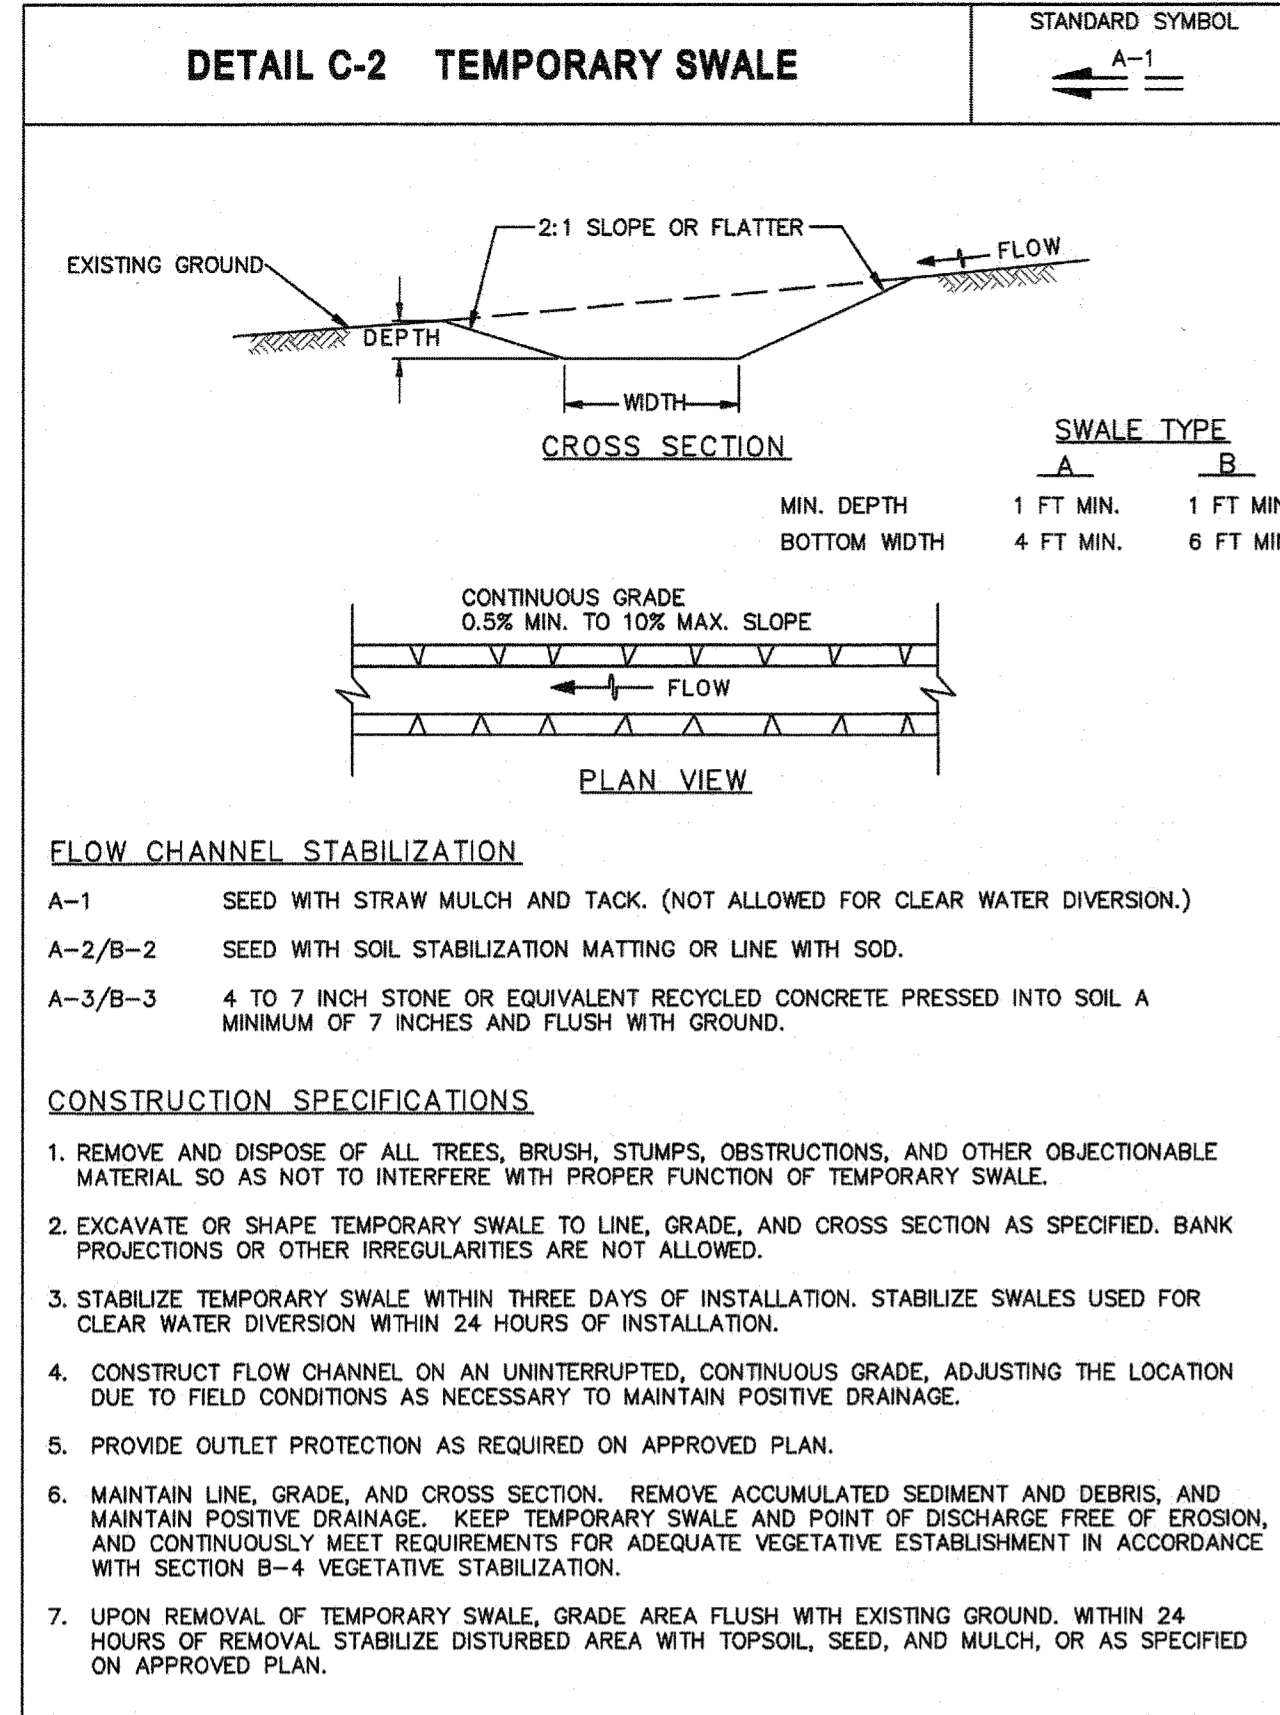

MARYLAND STANDARDS AND SPECIFICATIONS FOR SOIL EROSION AND SEDIMENT CONTROL

U.S. DEPARTMENT OF AGRICULTURE NATURAL RESOURCES CONSERVATION SERVICE 2011

MARYLAND DEPARTMENT OF ENVIRONMENT WATER MANAGEMENT ADMINISTRATION

MARYLAND STANDARDS AND SPECIFICATIONS FOR SOIL EROSION AND SEDIMENT CONTROL

U.S. DEPARTMENT OF AGRICULTURE NATURAL RESOURCES CONSERVATION SERVICE 2011

MARYLAND DEPARTMENT OF ENVIRONMENT WATER MANAGEMENT ADMINISTRATION

MARYLAND STANDARDS AND SPECIFICATIONS FOR SOIL EROSION AND SEDIMENT CONTROL

U.S. DEPARTMENT OF AGRICULTURE NATURAL RESOURCES CONSERVATION SERVICE 2011

MARYLAND DEPARTMENT OF ENVIRONMENT WATER MANAGEMENT ADMINISTRATION

MARYLAND STANDARDS AND SPECIFICATIONS FOR SOIL EROSION AND SEDIMENT CONTROL






U.S. DEPARTMENT OF AGRICULTURE NATURAL RESOURCES CONSERVATION SERVICE 2011

MARYLAND DEPARTMENT OF ENVIRONMENT WATER MANAGEMENT ADMINISTRATION

MARYLAND STANDARDS AND SPECIFICATIONS FOR SOIL EROSION AND SEDIMENT CONTROL

U.S. DEPARTMENT OF AGRICULTURE NATURAL RESOURCES CONSERVATION SERVICE 2011

MARYLAND DEPARTMENT OF ENVIRONMENT WATER MANAGEMENT ADMINISTRATION

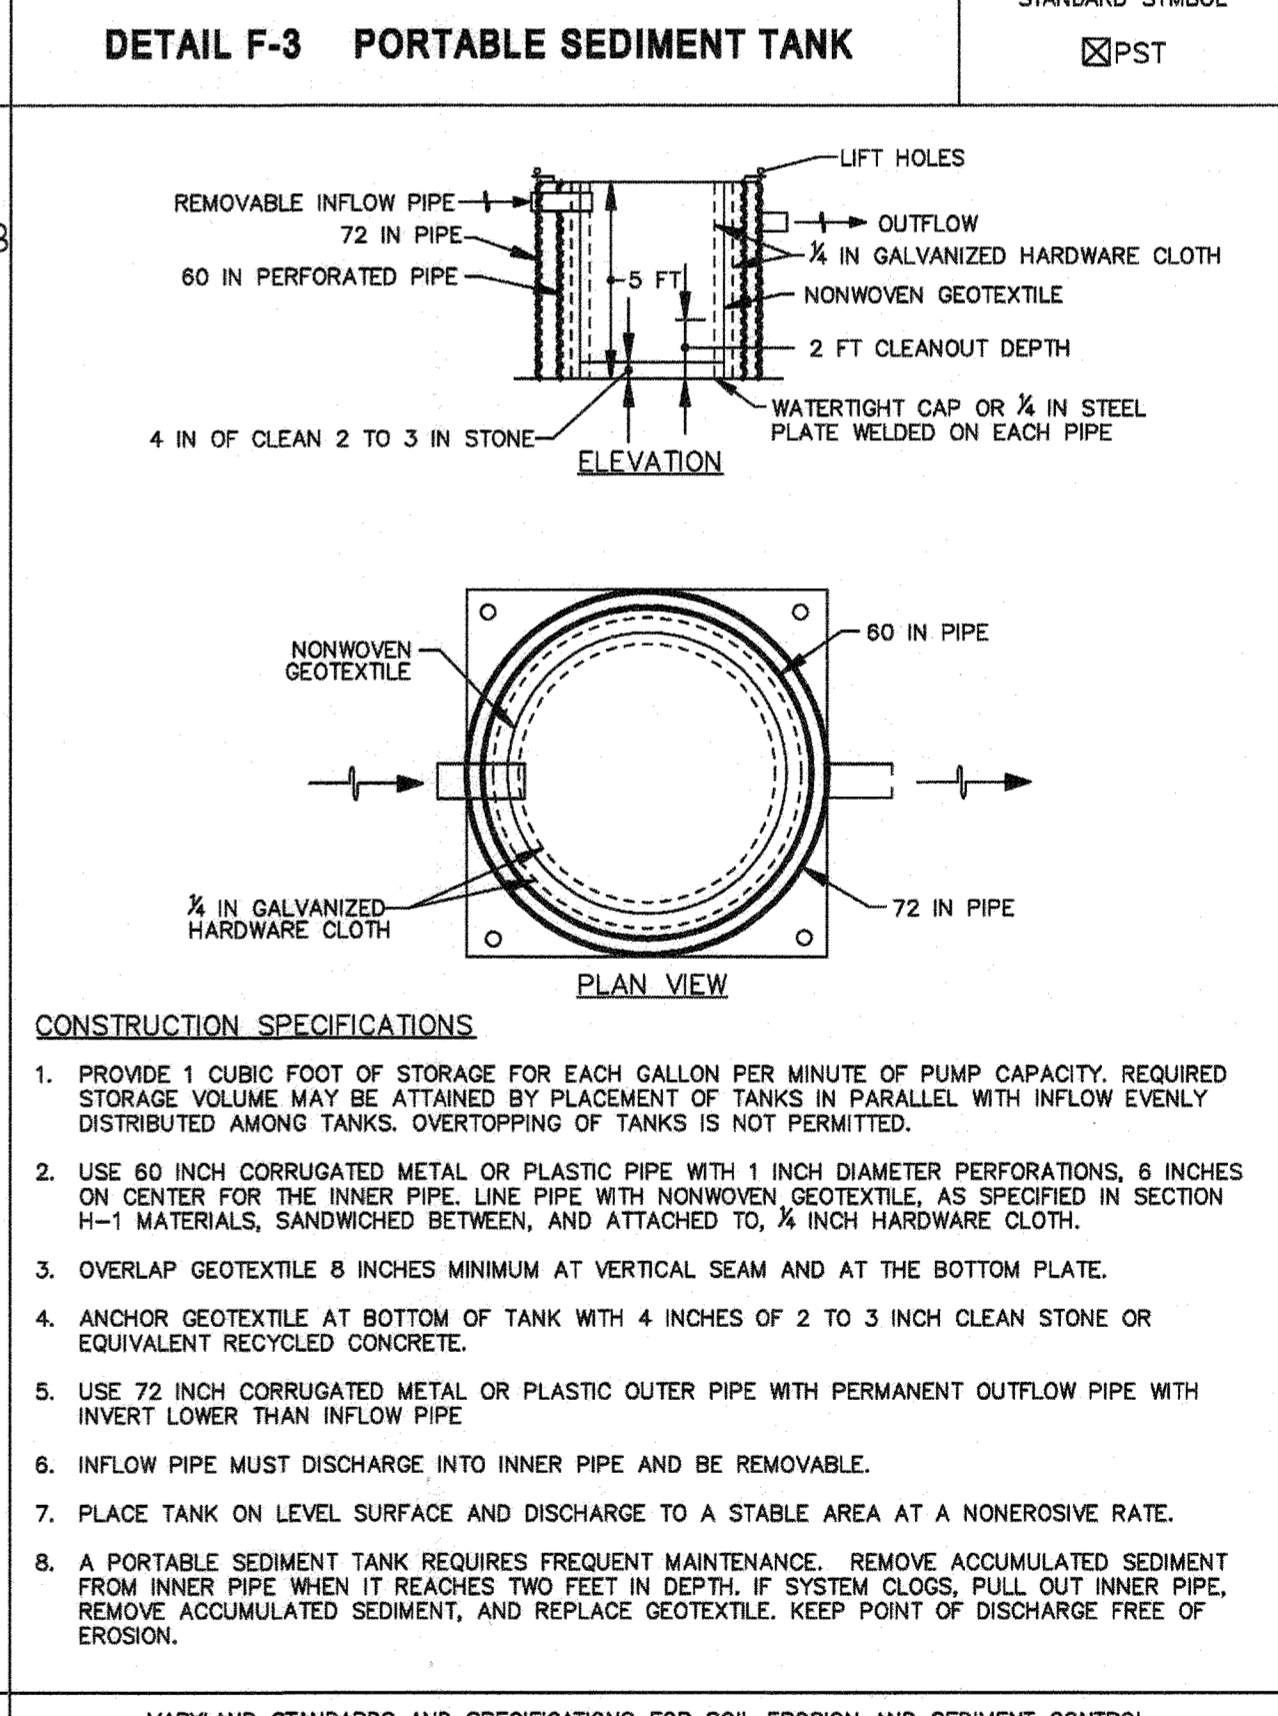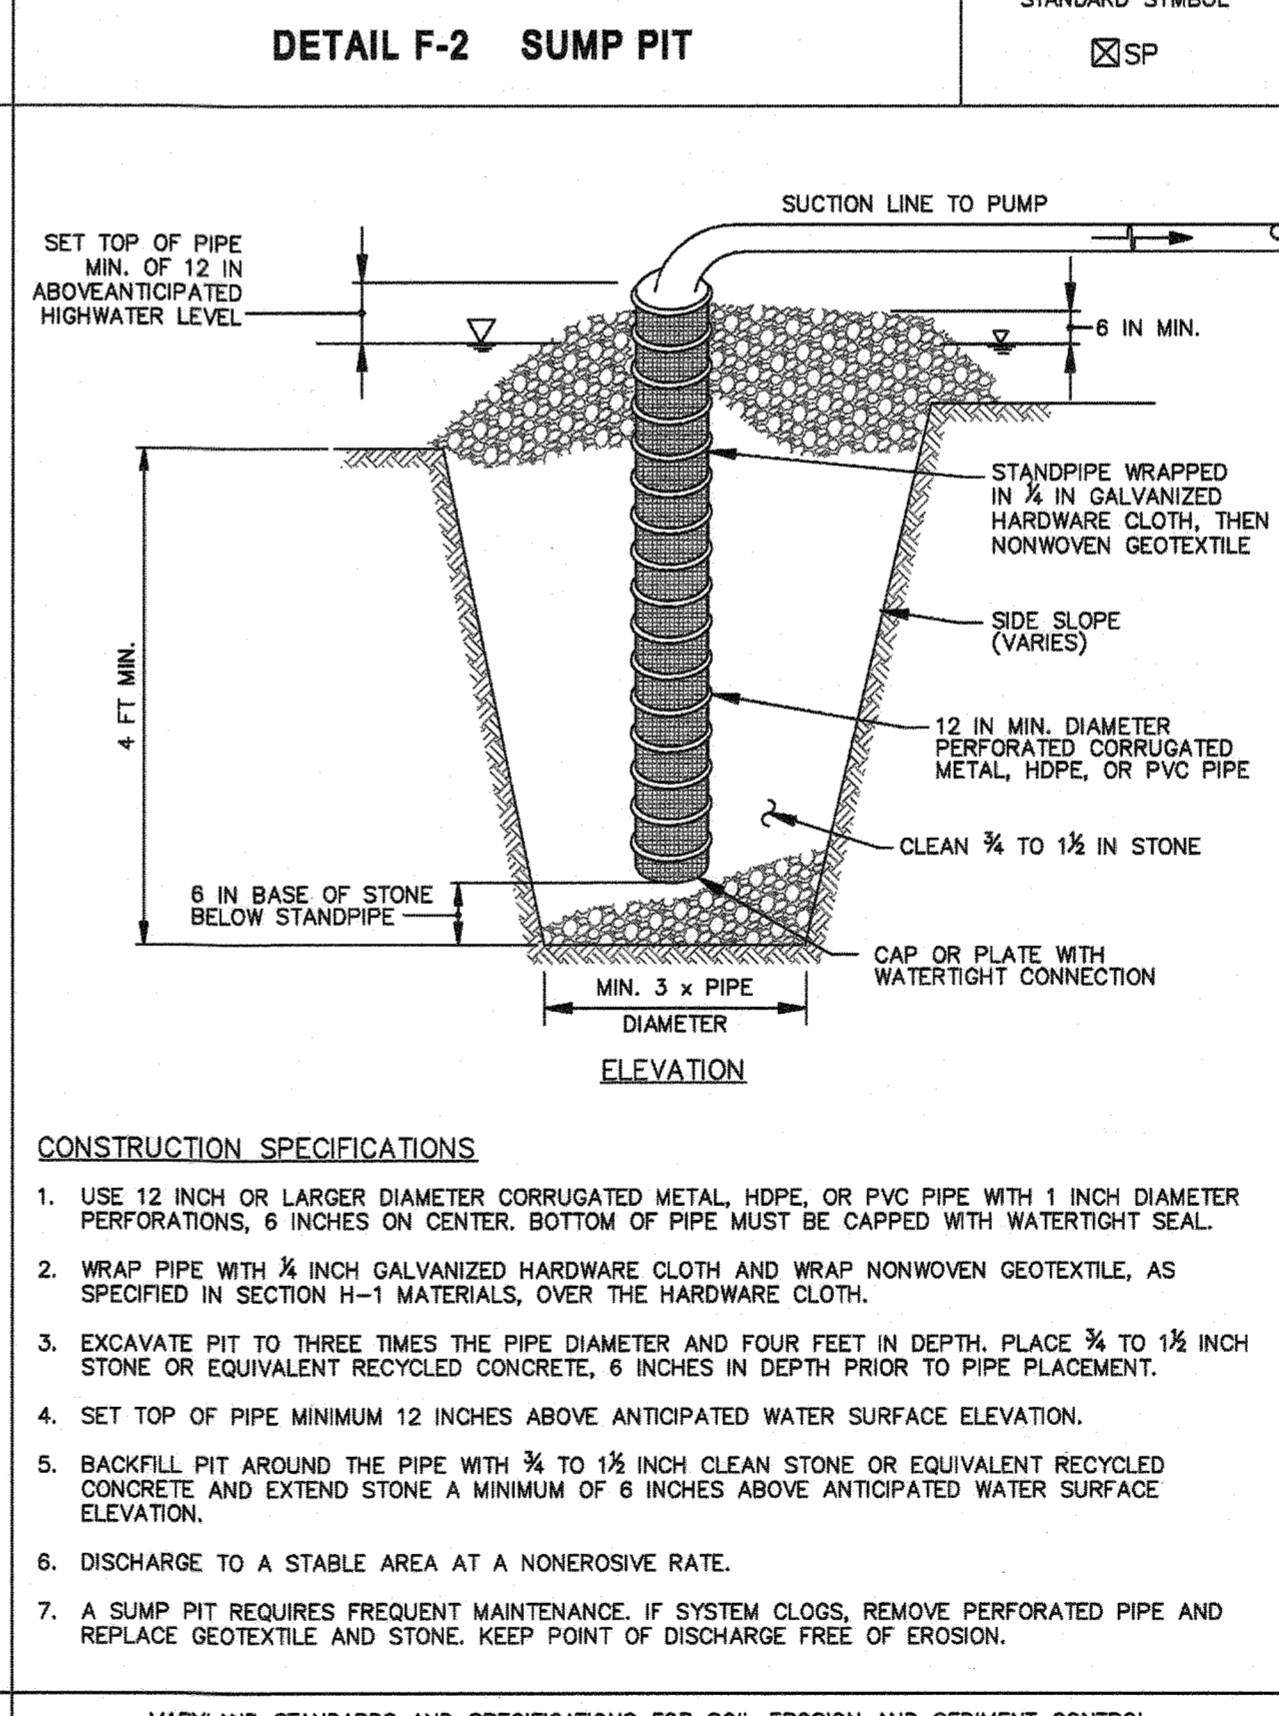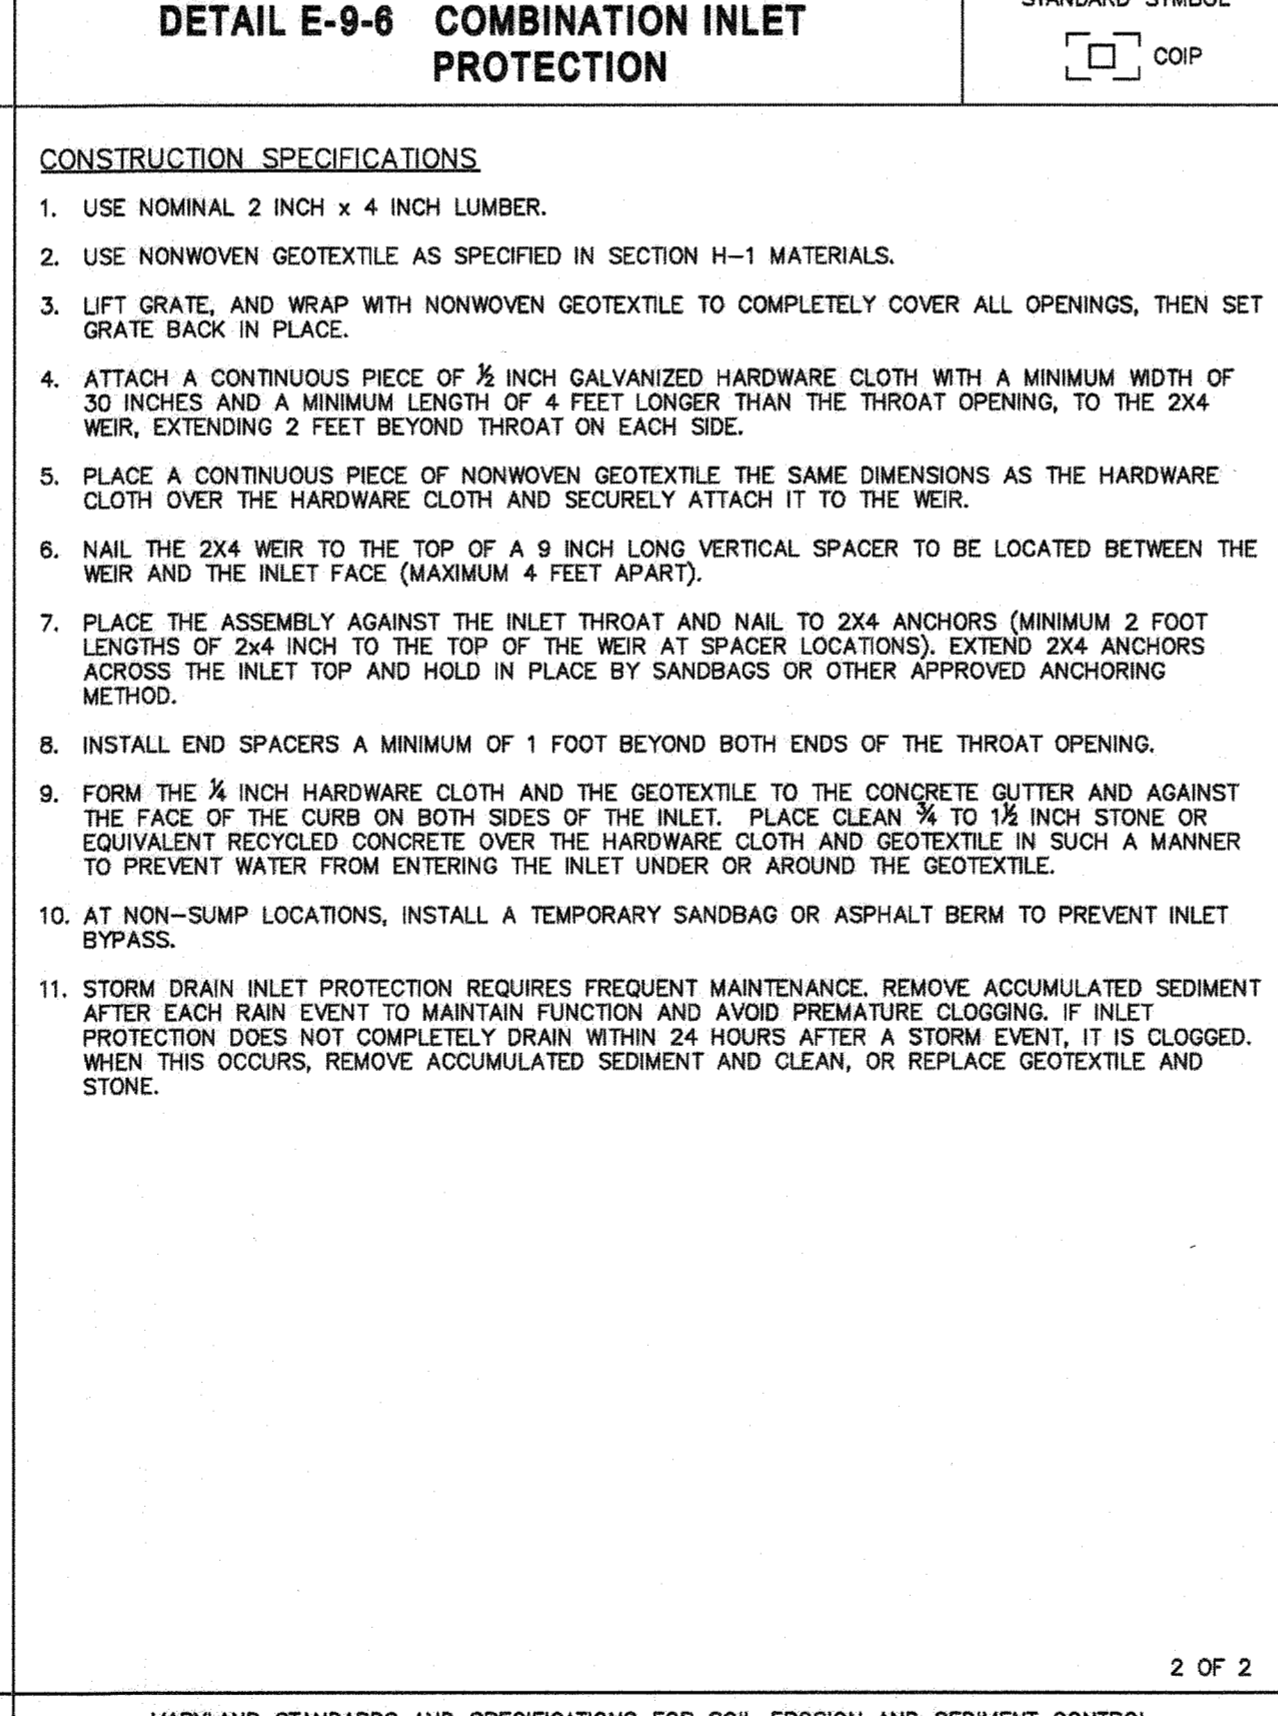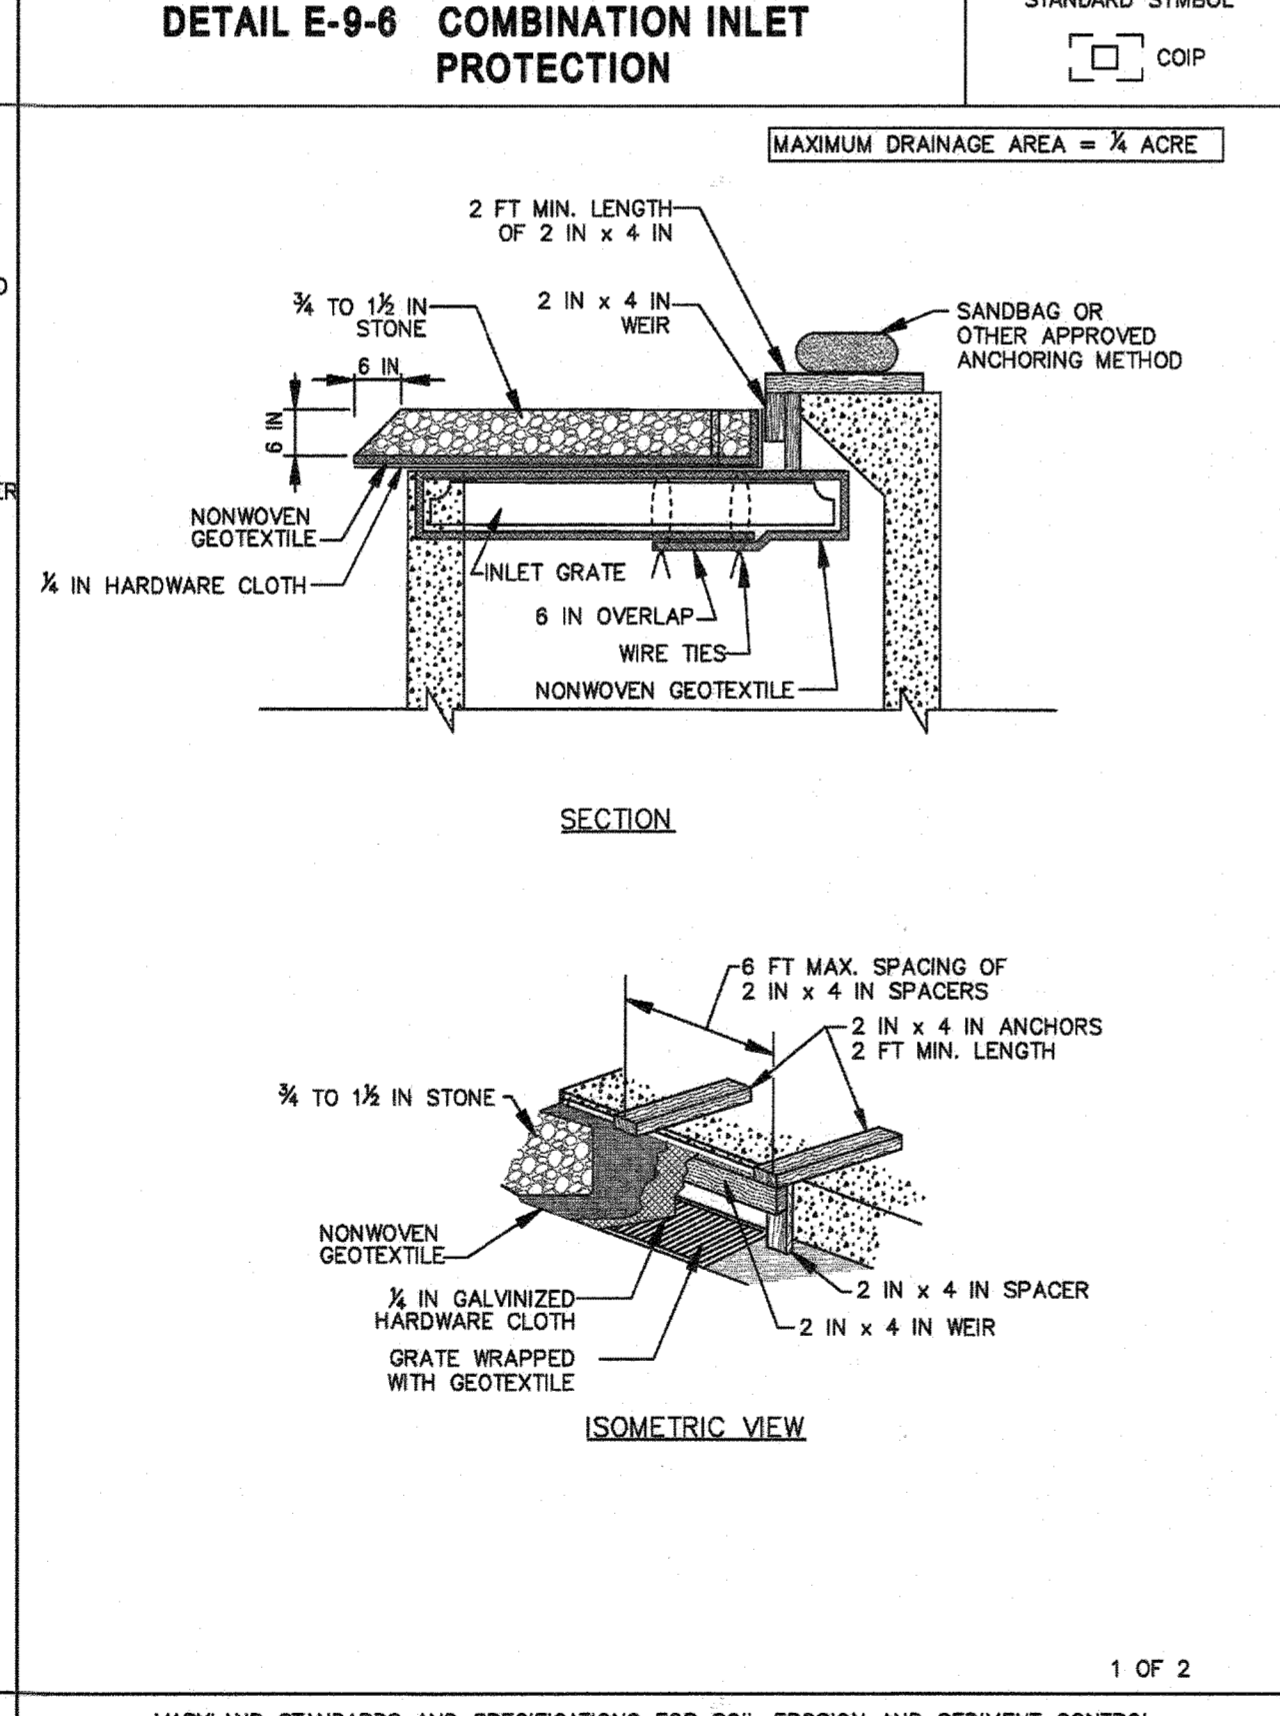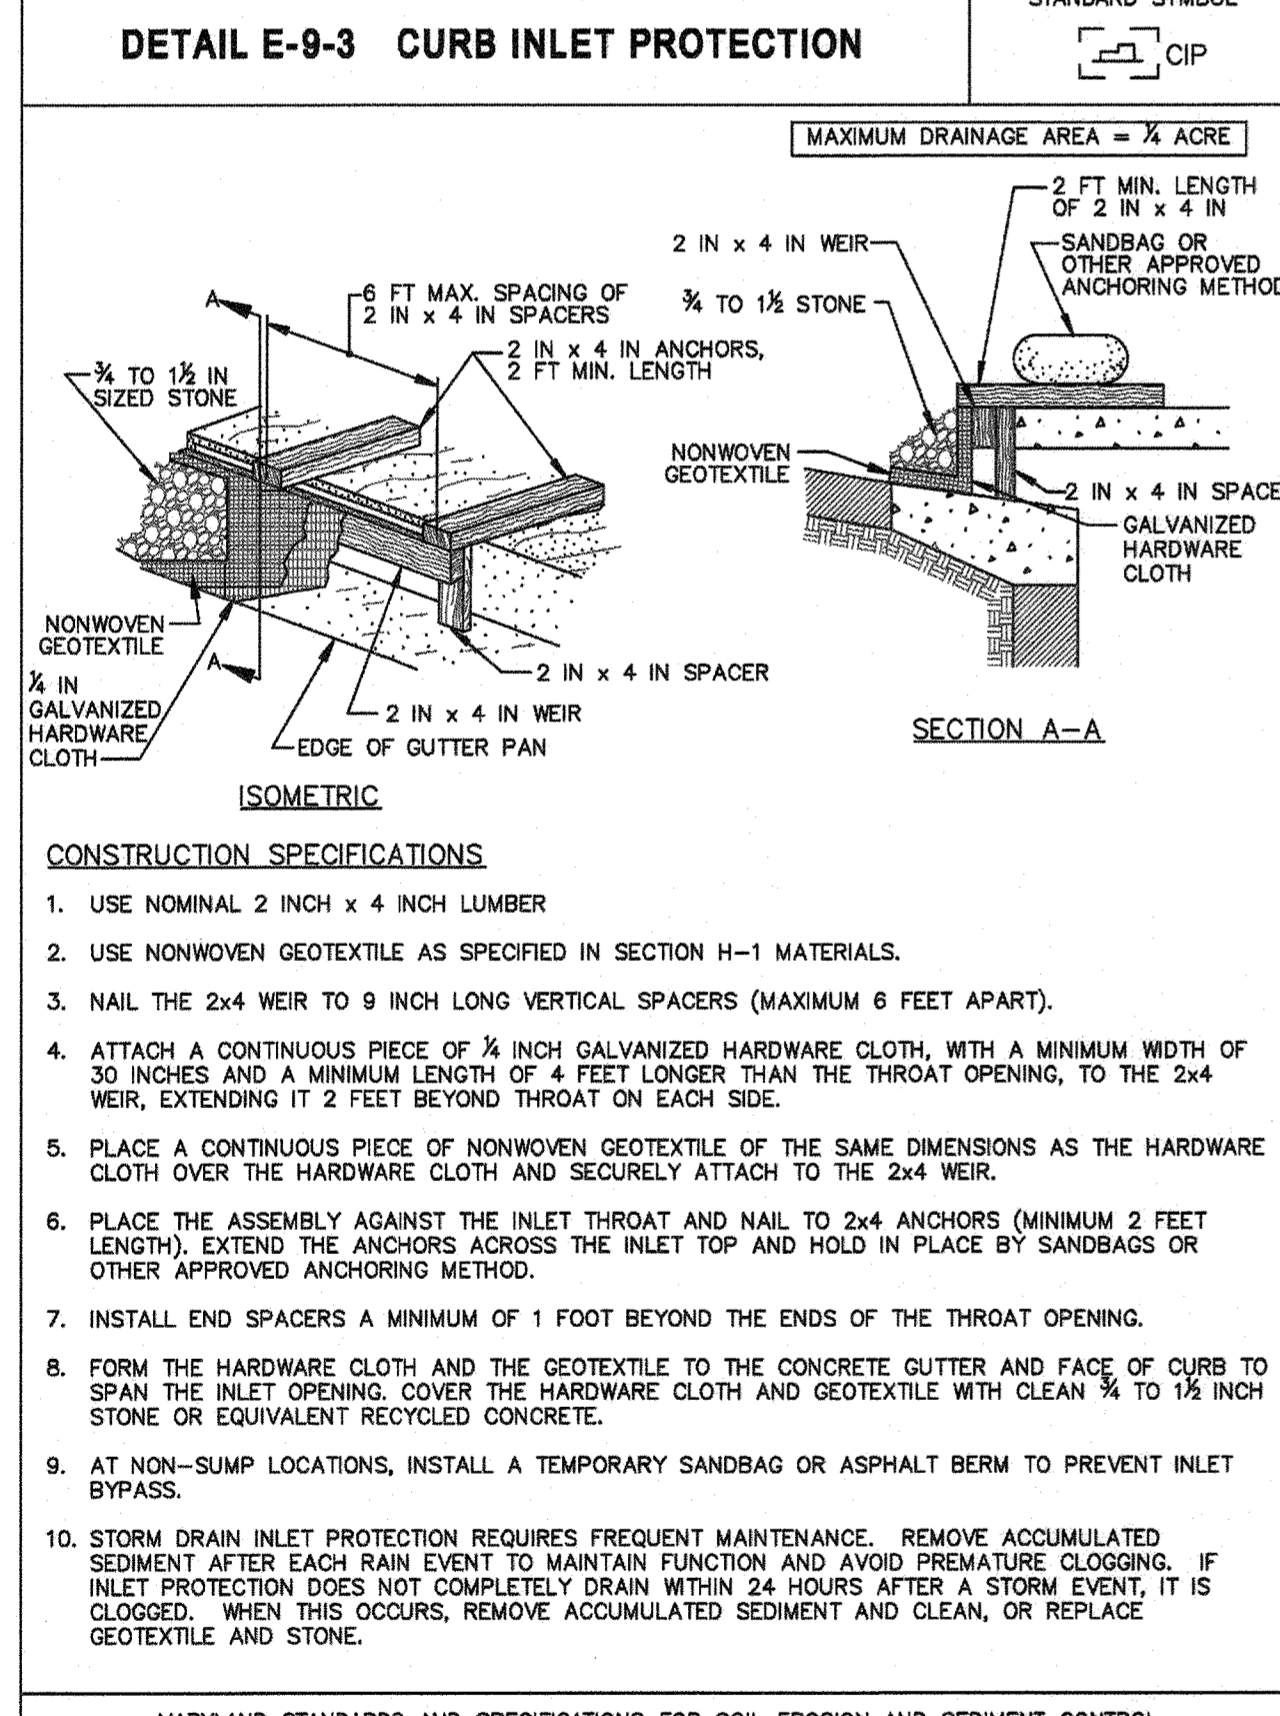

MARYLAND STANDARDS AND SPECIFICATIONS FOR SOIL EROSION AND SEDIMENT CONTROL

U.S. DEPARTMENT OF AGRICULTURE NATURAL RESOURCES CONSERVATION SERVICE 2011

MARYLAND DEPARTMENT OF ENVIRONMENT WATER MANAGEMENT ADMINISTRATION

MARYLAND STANDARDS AND SPECIFICATIONS FOR SOIL EROSION AND SEDIMENT CONTROL

U.S. DEPARTMENT OF AGRICULTURE NATURAL RESOURCES CONSERVATION SERVICE 2011

MARYLAND DEPARTMENT OF ENVIRONMENT WATER MANAGEMENT ADMINISTRATION

MARYLAND STANDARDS AND SPECIFICATIONS FOR SOIL EROSION AND SEDIMENT CONTROL

U.S. DEPARTMENT OF AGRICULTURE NATURAL RESOURCES CONSERVATION SERVICE 2011

MARYLAND DEPARTMENT OF ENVIRONMENT WATER MANAGEMENT ADMINISTRATION

MARYLAND STANDARDS AND SPECIFICATIONS FOR SOIL EROSION AND SEDIMENT CONTROL

U.S. DEPARTMENT OF AGRICULTURE NATURAL RESOURCES CONSERVATION SERVICE 2011

MARYLAND DEPARTMENT OF ENVIRONMENT WATER MANAGEMENT ADMINISTRATION

MARYLAND STANDARDS AND SPECIFICATIONS FOR SOIL EROSION AND SEDIMENT CONTROL

U.S. DEPARTMENT OF AGRICULTURE NATURAL RESOURCES CONSERVATION SERVICE 2011

MARYLAND DEPARTMENT OF ENVIRONMENT WATER MANAGEMENT ADMINISTRATION

HOWARD SCD SIGNATURE BLOCK:

This plan is approved for soil erosion and sediment control by the Howard Soil Conservation District.

Alexander Prater 11/15/23
Howard Soil Conservation District Date

APPROVED: DEPARTMENT OF PLANNING AND ZONING

Chief, Development Engineering Division 12-5-23
Date

Chief, Division of Land Development 2/22/24
Date

RK&K
RUMMEL, KLEPPER & KAHL, LLP
ENGINEERS/CONSTRUCTION MANAGERS/PLANNERS/SCIENTISTS
RESPECTIVE PEOPLE. CREATIVE SOLUTIONS.
700 East Pratt Street, Suite 600
Baltimore, MD 21202
Ph: 410.728.2900
www.rkk.com

DESIGN BY: SHK
DRAWN BY: JMS/DTP
CHECKED BY: CWMM
DATE: 11/1/2023


BY NO. REVISION DATE

OWNER/DEVELOPER
JOHNS HOPKINS APPLIED PHYSICS LABORATORY
11100 JOHNS HOPKINS ROAD
LAUREL, MARYLAND 20723

11/1/23

EROSION CONTROL NOTES & DETAILS - BORROW AREAS
JOHNS HOPKINS UNIVERSITY - APPLIED PHYSICS LABORATORY
OUTDOOR TESTING AREAS
11100 JOHNS HOPKINS ROAD
TAX MAP 41: PARCEL: 123 GRID: 15 ZONED: PEC
ELECTION DISTRICT 5 - HOWARD COUNTY, MARYLAND
SHEET 71 OF 73

C-696
RK&K PROJECT NUMBER 21047.013
SCALE: As Shown

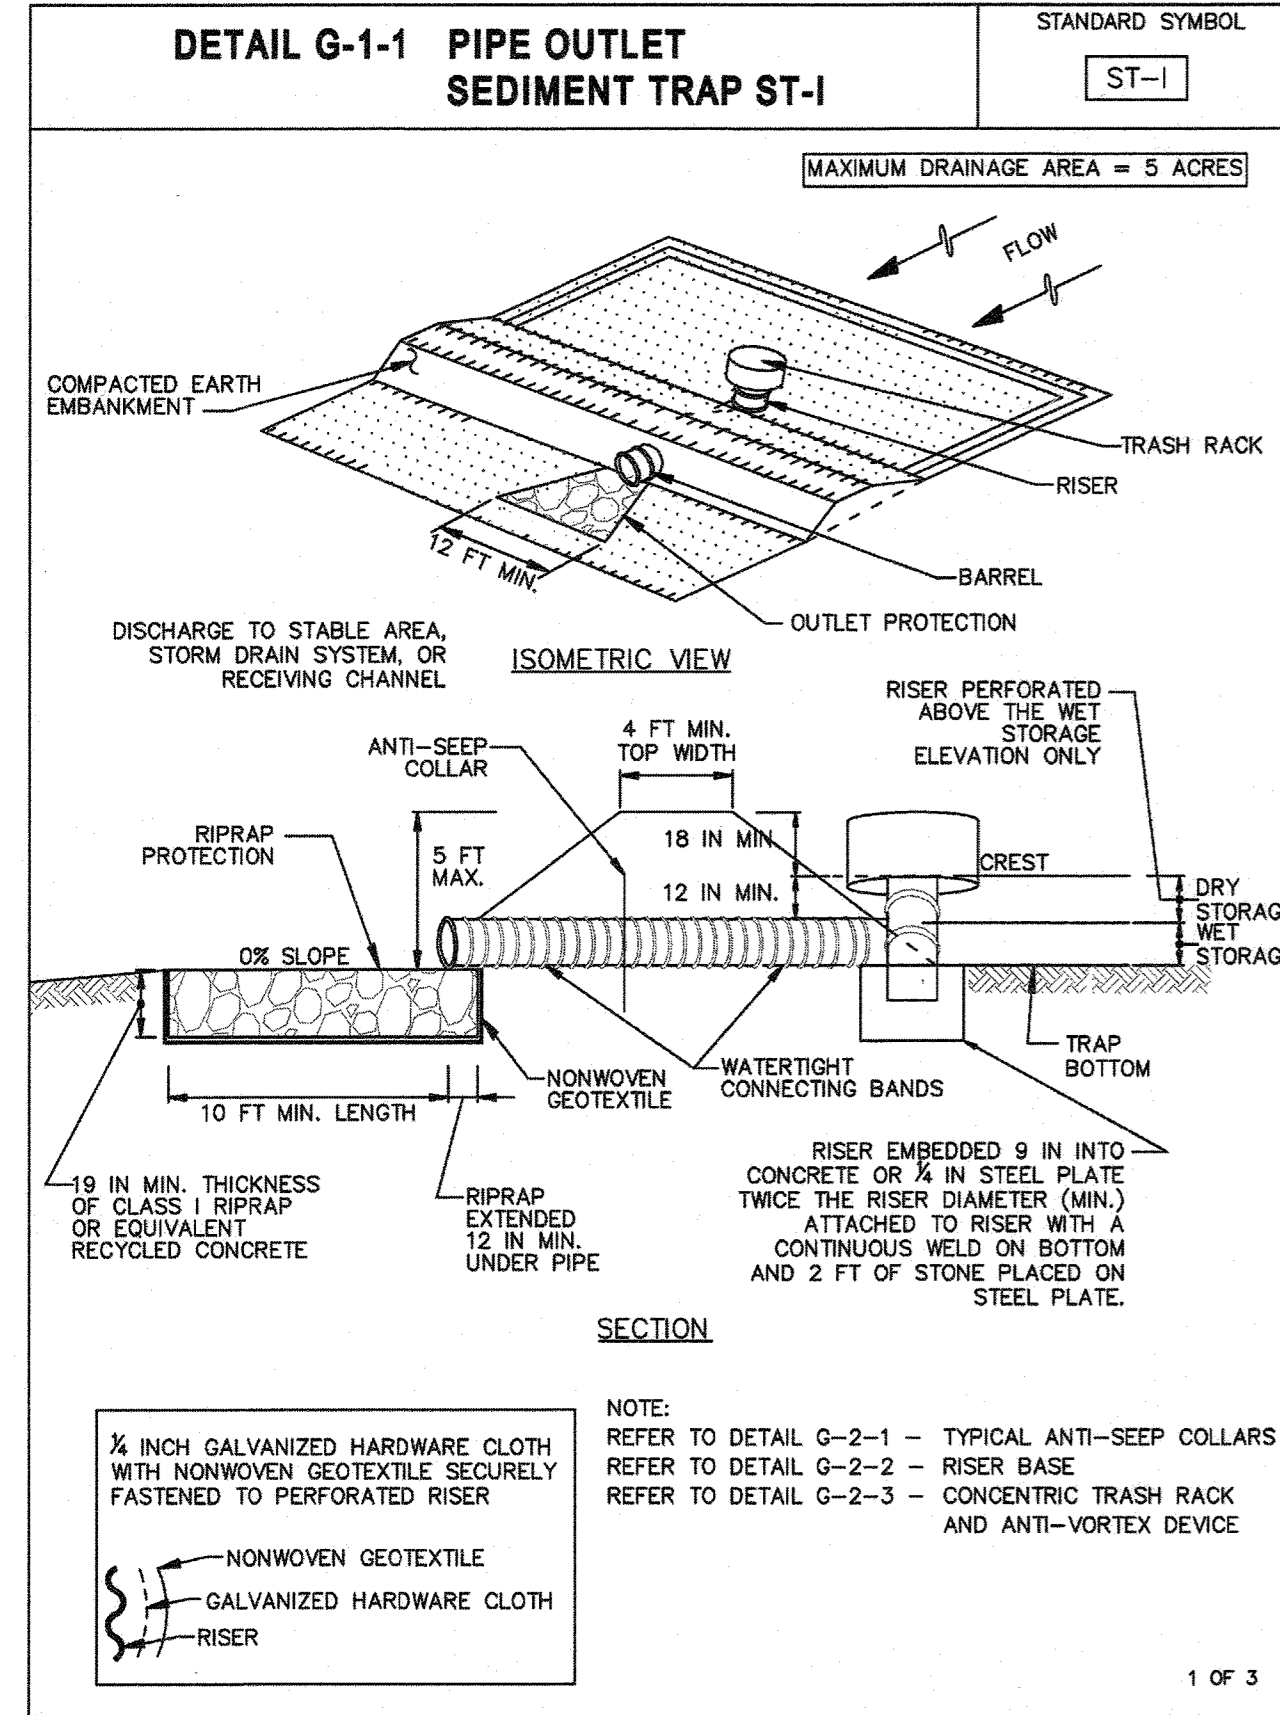

DETAIL G-1-1 PIPE OUTLET SEDIMENT TRAP ST-1

STANDARD SYMBOL: ST-1

CONSTRUCTION SPECIFICATIONS

- CONSTRUCT TRAP IN SUCH A MANNER THAT EROSION AND WATER POLLUTION ARE AVOIDED.
- CLEAR, GRUB, AND STRIP ANY VEGETATION AND ROOT MAT FROM THE AREA UNDER THE EMBANKMENT AND TRAP BOTTOM.
- PERFORATE THE RISER WITH 1 INCH DIAMETER HOLES SPACED 6 INCHES ON CENTER WITH THE LOWEST PERFORATIONS AT THE WET STORAGE ELEVATION OR PROVIDE A HORIZONTAL OR VERTICAL DRAW-DOWN DEVICE PERFORATED ACCORDING TO APPROVED PLAN. DO NOT PERFORATE THE RISER WITHIN 6 INCHES OF THE TOP OF THE HORIZONTAL BARREL.
- SET RISER/BARREL ASSEMBLY PRIOR TO EMBANKMENT CONSTRUCTION. MAKE ALL PIPE CONNECTIONS WATER-TIGHT. OFFSET RISER FROM EMBANKMENT TO ACCOMMODATE PLACEMENT OF THE TRASH RACK. ANCHOR THE RISER WITH EITHER A REINFORCED CONCRETE BASE OR STEEL PLATE BASE TO PREVENT FLOTATION. MAKE CONCRETE BASES AT LEAST TWICE THE RISER DIAMETER AND 18 INCHES THICK WITH THE RISER EMBEDDED 9 INCHES.
- USE FILL MATERIAL FREE OF ROOTS, WOODY VEGETATION, OVERSIZED STONES, ROCKS, ORGANIC MATERIAL, OR OTHER OBJECTIONABLE MATERIAL FOR THE EMBANKMENT.
- HAND COMPACT IN 4 INCH LAYERS FILL MATERIAL AROUND THE PIPE SPILLWAY. PLACE A MINIMUM OF 2 FEET OF HAND COMPACTED BACKFILL OVER THE PIPE SPILLWAY BEFORE CROSSING IT WITH CONSTRUCTION EQUIPMENT.
- CONSTRUCT TOP OF EMBANKMENT 1 FOOT MINIMUM ABOVE RISER CREST. COMPACT THE EMBANKMENT BY TRAVERSING WITH EQUIPMENT WHILE IT IS BEING CONSTRUCTED.
- MAKE ALL CUT AND FILL SLOPES 2:1 OR FLATTER.
- WRAP THE RISER WITH 1/4 INCH GALVANIZED HARDWARE CLOTH THEN WRAP WITH NONWOVEN GEOTEXTILE. DO NOT WRAP WITH MORE THAN ONE LAYER OF GEOTEXTILE. EXTEND HARDWARE CLOTH AND GEOTEXTILE AT LEAST 6 INCHES ABOVE THE HIGHEST PERFORATIONS AND AT LEAST 6 INCHES BELOW THE LOWEST PERFORATIONS. OVERLAP, FOLD AND FASTEN WHERE ENDS OF GEOTEXTILE COME TOGETHER TO PREVENT BYPASS. REPLACE GEOTEXTILE AS NECESSARY TO PREVENT CLOGGING.
- USE STRAPS OR CONNECTING BANDS AT THE TOP AND BOTTOM OF THE GEOTEXTILE TO HOLD THE GEOTEXTILE AND HARDWARE CLOTH IN PLACE.
- USE NONWOVEN GEOTEXTILE AS SPECIFIED IN SECTION H-1 MATERIALS.
- STABILIZE THE EMBANKMENT AND INTERIOR SLOPES WITH SEED AND MULCH. STABILIZE POINTS OF CONCENTRATED INFLOW AS SHOWN ON APPROVED PLAN.
- CONSTRUCT AND MAINTAIN THE OUTLET ACCORDING TO THE APPROVED PLAN AND IN SUCH A MANNER THAT EROSION AT OR BELOW THE OUTLET DOES NOT OCCUR.
- REMOVE SEDIMENT AND RESTORE TRAP TO ORIGINAL DIMENSIONS WHEN SEDIMENT HAS ACCUMULATED TO CLEANOUT ELEVATION (50% OF WET STORAGE DEPTH). DEPOSIT REMOVED SEDIMENT IN AN APPROVED AREA AND IN SUCH A MANNER THAT IT WILL NOT ERODE. KEEP POINTS OF INFLOW AND OUTFLOW AS WELL AS INTERIOR OF THE TRAP FREE FROM EROSION, AND REMOVE ACCUMULATED DEBRIS. MAINTAIN EMBANKMENTS TO CONTINUOUSLY MEET REQUIREMENTS FOR ADEQUATE VEGETATIVE ESTABLISHMENT IN ACCORDANCE WITH SECTION B-4 VEGETATIVE STABILIZATION. REMOVE ANY TREES, BRUSH, OR OTHER WOODY VEGETATION GROWING ON EMBANKMENT OR NEAR PRINCIPAL SPILLWAY. MAINTAIN LINE, GRADE, AND CROSS SECTION. MAINTAIN WATER TIGHT CONNECTIONS. REPLACE GEOTEXTILE AROUND PERFORATED RISER IF DRY STORAGE VOLUME DOES NOT DRAW DOWN WITHIN 10 HOURS.
- WHEN DEWATERING TRAP, PASS REMOVED WATER THROUGH AN APPROVED SEDIMENT CONTROL PRACTICE.
- UPON REMOVAL, GRADE AND STABILIZE THE AREA OCCUPIED BY TRAP.

DETAIL G-1-1 PIPE OUTLET SEDIMENT TRAP ST-1

STANDARD SYMBOL: ST-1

PIPE OUTLET SEDIMENT TRAP ST-1, TRAP NO. 1


| | | |
|---|----------|-----------|
| DRAINAGE AREA - INITIAL | 3.09 | ACRES |
| DRAINAGE AREA - INTERM | 3.17 | ACRES |
| DRAINAGE AREA - FINAL | 3.17 | ACRES |
| TOTAL STORAGE REQUIRED | 11340 | CF |
| TOTAL STORAGE PROVIDED | 13428 | CF |
| WET STORAGE REQUIRED | 5870 | CF |
| WET STORAGE PROVIDED | 7252 | CF |
| DRY STORAGE REQUIRED | 5870 | CF |
| DRY STORAGE PROVIDED | 6176 | CF |
| TRAP BOTTOM ELEVATION | 395.00 | FT |
| TRAP BOTTOM DIMENSIONS | 76 x 38 | FT x FT |
| RISER CREST (DRY STORAGE) ELEVATION | 398.25 | FT |
| OUTLET (WET STORAGE) ELEVATION | 397.00 | FT |
| CLEANOUT ELEVATION | 395.00 | FT |
| TOP OF EMBANKMENT ELEVATION | 400.00 | FT |
| SIDE SLOPE | 3:1 | H:V RATIO |
| EMBANKMENT TOP WIDTH | 4 | FT |
| PRINCIPAL SPILLWAY MATERIAL (BARREL, RISER, ANTI-SEEP COLLAR) | CONCRETE | |
| RISER DIAMETER | 33 | IN |
| BARREL DIAMETER | 24 | IN |
| TRASH RACK DIAMETER | 48 | IN |
| TRASH RACK HEIGHT | 23 | IN |
| ANTI-SEEP COLLAR DIMENSIONS | 6 | FT |
| OUTLET PROTECTION - LENGTH | N/A | FT |
| OUTLET PROTECTION - WIDTH | N/A | FT |
| OUTLET PROTECTION - DEPTH | N/A | IN |

DETAIL G-1-1 PIPE OUTLET SEDIMENT TRAP ST-1

STANDARD SYMBOL: ST-1

PIPE OUTLET SEDIMENT TRAP ST-1, TRAP NO. 2

| | | |
|---|----------|-----------|
| DRAINAGE AREA - INITIAL | 1.15 | ACRES |
| DRAINAGE AREA - INTERM | 1.54 | ACRES |
| DRAINAGE AREA - FINAL | 1.54 | ACRES |
| TOTAL STORAGE REQUIRED | 5508 | CF |
| TOTAL STORAGE PROVIDED | 6047 | CF |
| WET STORAGE REQUIRED | 2754 | CF |
| WET STORAGE PROVIDED | 3049 | CF |
| DRY STORAGE REQUIRED | 2754 | CF |
| DRY STORAGE PROVIDED | 2998 | CF |
| TRAP BOTTOM ELEVATION | 413.00 | FT |
| TRAP BOTTOM DIMENSIONS | 46 x 23 | FT x FT |
| RISER CREST (DRY STORAGE) ELEVATION | 416.25 | FT |
| OUTLET (WET STORAGE) ELEVATION | 415.00 | FT |
| CLEANOUT ELEVATION | 414.00 | FT |
| TOP OF EMBANKMENT ELEVATION | 418.00 | FT |
| SIDE SLOPE | 3:1 | H:V RATIO |
| EMBANKMENT TOP WIDTH | 4 | FT |
| PRINCIPAL SPILLWAY MATERIAL (BARREL, RISER, ANTI-SEEP COLLAR) | CONCRETE | |
| RISER DIAMETER | 21 | IN |
| BARREL DIAMETER | 15 | IN |
| TRASH RACK DIAMETER | 30 | IN |
| TRASH RACK HEIGHT | 19 | IN |
| ANTI-SEEP COLLAR DIMENSIONS | 5.25 | FT |
| OUTLET PROTECTION - LENGTH | N/A | FT |
| OUTLET PROTECTION - WIDTH | N/A | FT |
| OUTLET PROTECTION - DEPTH | N/A | IN |

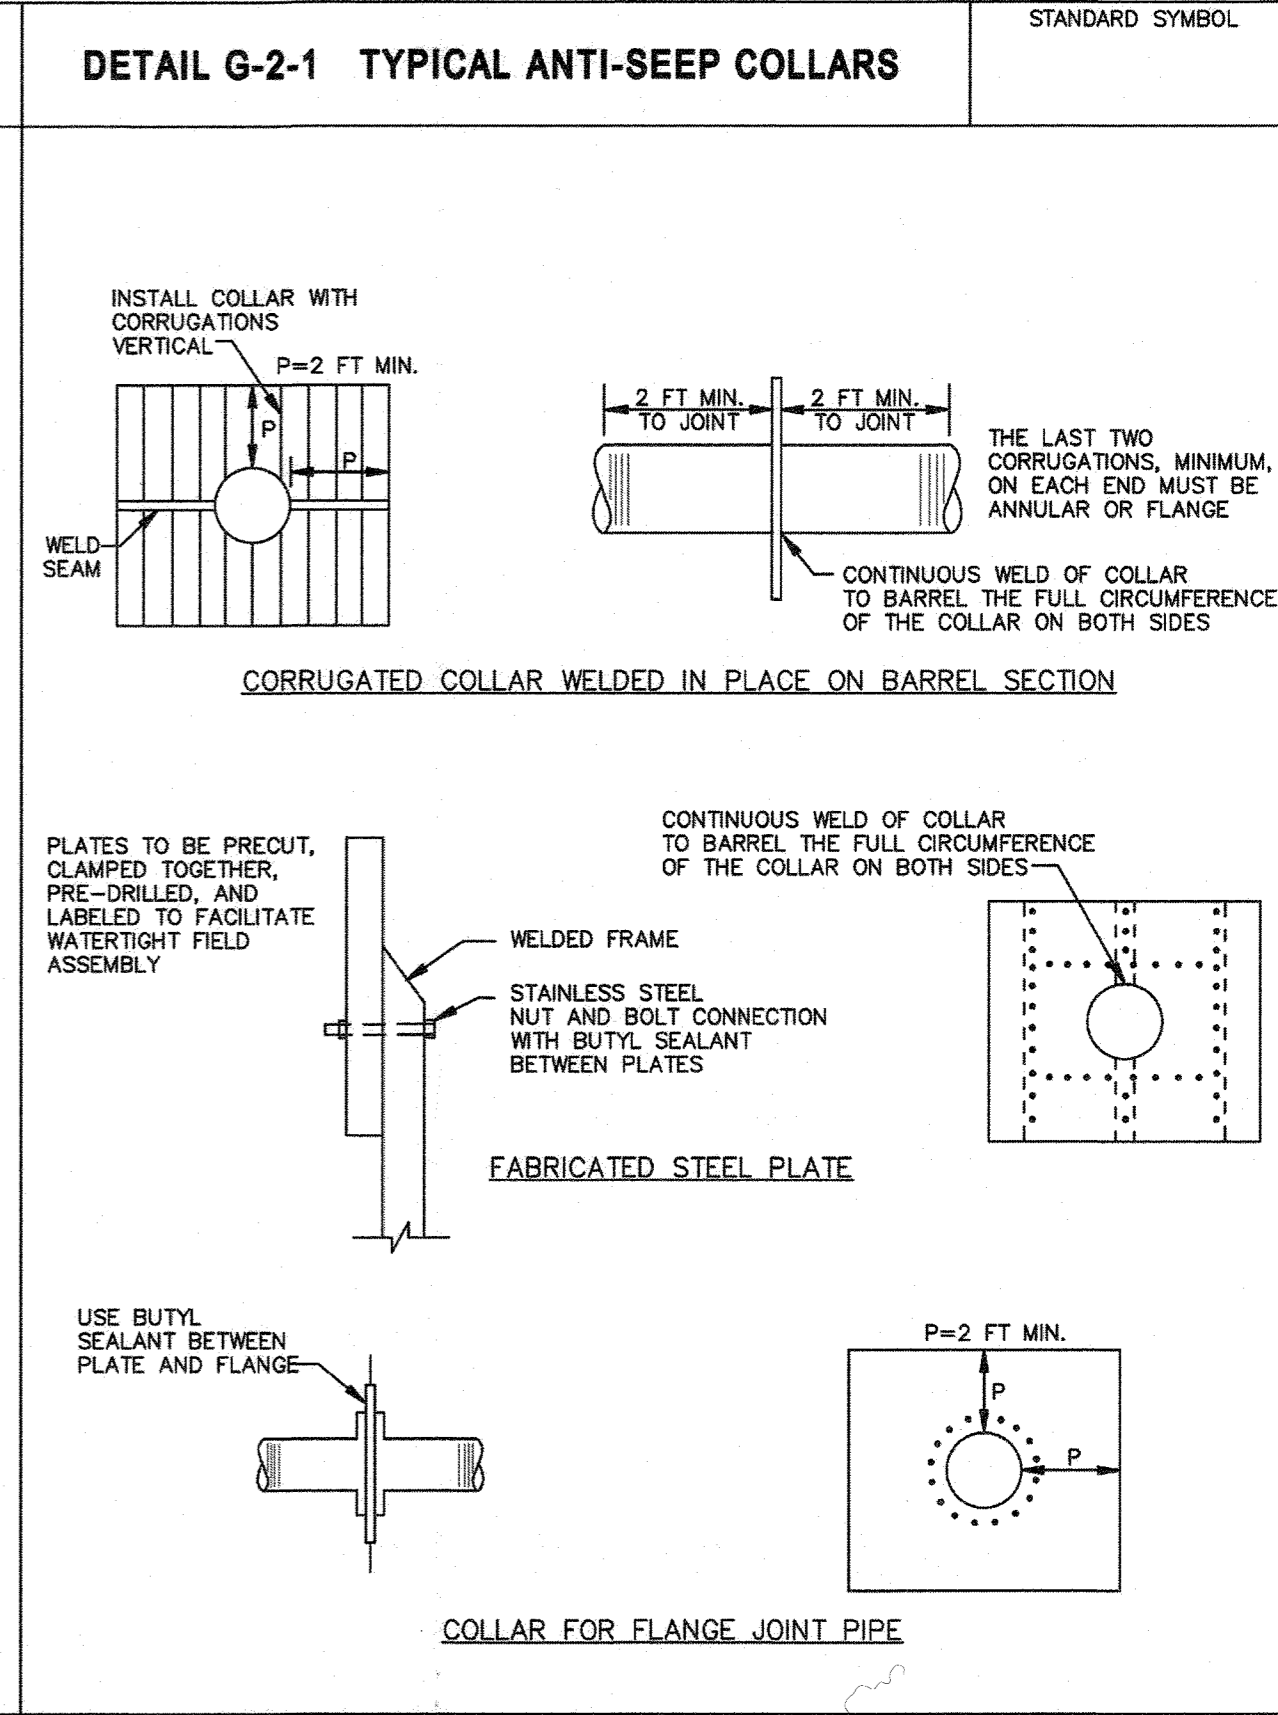

MARYLAND STANDARDS AND SPECIFICATIONS FOR SOIL EROSION AND SEDIMENT CONTROL

U.S. DEPARTMENT OF AGRICULTURE NATURAL RESOURCES CONSERVATION SERVICE 2011

MARYLAND DEPARTMENT OF ENVIRONMENT WATER MANAGEMENT ADMINISTRATION

MARYLAND STANDARDS AND SPECIFICATIONS FOR SOIL EROSION AND SEDIMENT CONTROL

U.S. DEPARTMENT OF AGRICULTURE NATURAL RESOURCES CONSERVATION SERVICE 2011

MARYLAND DEPARTMENT OF ENVIRONMENT WATER MANAGEMENT ADMINISTRATION

MARYLAND STANDARDS AND SPECIFICATIONS FOR SOIL EROSION AND SEDIMENT CONTROL

U.S. DEPARTMENT OF AGRICULTURE NATURAL RESOURCES CONSERVATION SERVICE 2011

MARYLAND DEPARTMENT OF ENVIRONMENT WATER MANAGEMENT ADMINISTRATION

MARYLAND STANDARDS AND SPECIFICATIONS FOR SOIL EROSION AND SEDIMENT CONTROL



U.S. DEPARTMENT OF AGRICULTURE NATURAL RESOURCES CONSERVATION SERVICE 2011

MARYLAND DEPARTMENT OF ENVIRONMENT WATER MANAGEMENT ADMINISTRATION

MARYLAND STANDARDS AND SPECIFICATIONS FOR SOIL EROSION AND SEDIMENT CONTROL

U.S. DEPARTMENT OF AGRICULTURE NATURAL RESOURCES CONSERVATION SERVICE 2011

MARYLAND DEPARTMENT OF ENVIRONMENT WATER MANAGEMENT ADMINISTRATION

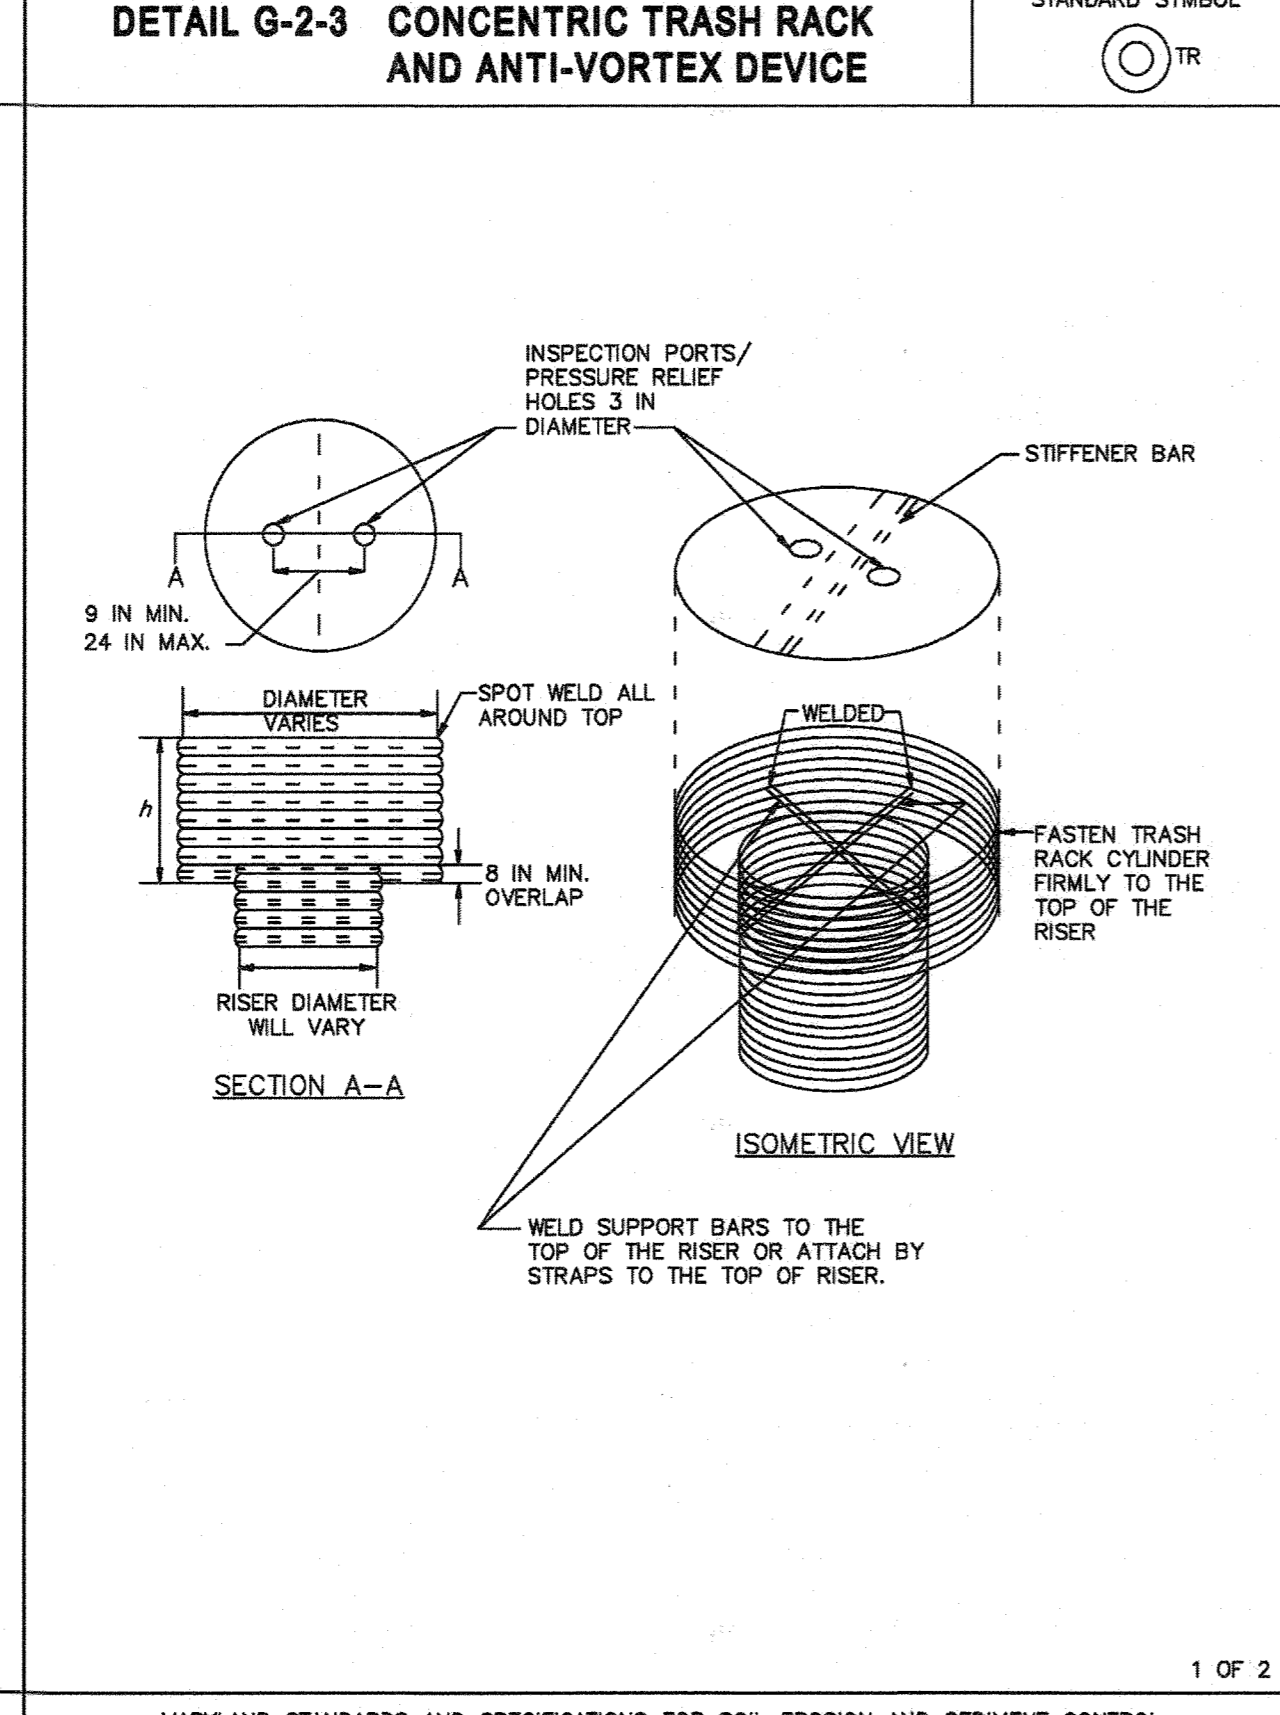
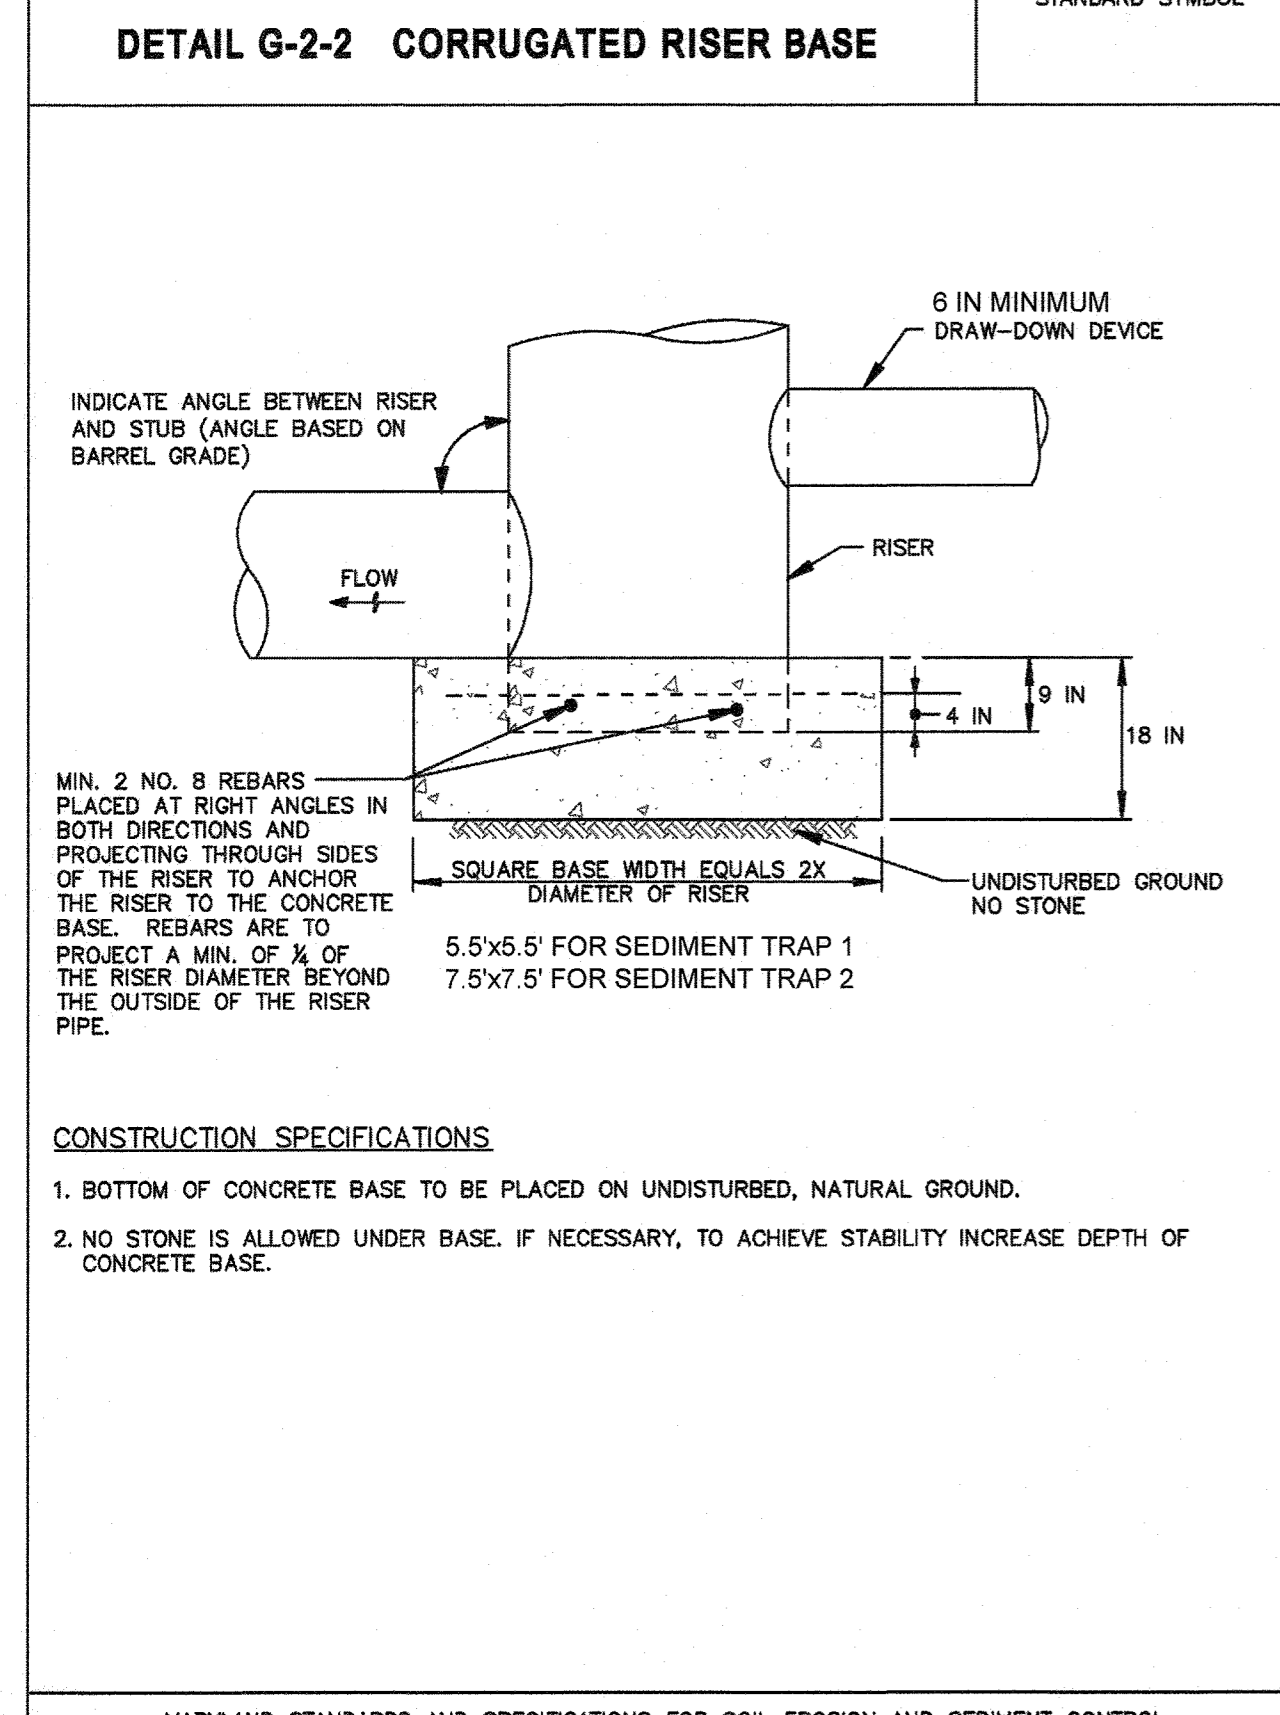


DETAIL G-2-3 CONCENTRIC TRASH RACK AND ANTI-VORTEX DEVICE

STANDARD SYMBOL: TR

| RISER DIAM. (IN) | DIAM. (IN) | THICKNESS (GAUGE) | h (IN) | MINIMUM SIZE SUPPORT BAR | THICKNESS (GAUGE) | STIFFENER |
|------------------|------------|-------------------|--------|--|-------------------|---------------------------|
| 12 | 18 | 16 | 14 | #6 REBAR | 16 | N/A |
| 15 | 21 | 16 | 15 | #6 REBAR | 16 | N/A |
| 18 | 27 | 16 | 16 | #6 REBAR | 16 | N/A |
| 21 | 30 | 16 | 19 | #6 REBAR | 16 | N/A |
| 24 | 36 | 16 | 21 | #6 REBAR | 14 | N/A |
| 27 | 42 | 16 | 21 | #6 REBAR | 14 | N/A |
| 36 | 54 | 14 | 25 | #8 REBAR | 12 | N/A |
| 42 | 60 | 14 | 27 | #8 REBAR | 12 | N/A |
| 48 | 72 | 12 | 28 | 1/4 IN PIPE OR 1/4 x 1/4 x 1/4 ANGLE | 10 | N/A |
| 54 | 78 | 12 | 33 | 1/4 IN PIPE OR 1/4 x 1/4 x 1/4 ANGLE | 8 | N/A |
| 60 | 90 | 12 | 37 | 1/2 IN PIPE OR 1/2 x 1/2 x 1/2 ANGLE | 8 | N/A |
| 66 | 96 | 10 | 41 | 2 IN PIPE OR 2 x 2 x 3/8 ANGLE | 8 | 2 x 2 x 3/8 ANGLE |
| 72 | 102 | 10 | 44 | 2 IN PIPE OR 2 x 2 x 3/8 ANGLE | 8 | 2 1/2 x 2 1/2 x 1/2 ANGLE |
| 78 | 114 | 10 | 47 | 2 1/2 IN PIPE OR 2 x 2 x 3/8 ANGLE | 8 | 2 1/2 x 2 1/2 x 1/2 ANGLE |
| 84 | 120 | 10 | 50 | 2 1/2 IN PIPE OR 2 1/2 x 2 1/2 x 1/2 ANGLE | 8 | 2 1/2 x 2 1/2 x 3/8 ANGLE |

NOTE: THE ABOVE TRASH RACK AND ANTI-VORTEX DEVICE INFORMATION IS FOR CORRUGATED METAL PIPE ONLY. CONCRETE RISERS MUST MEET THE REQUIREMENTS OF MD 378.

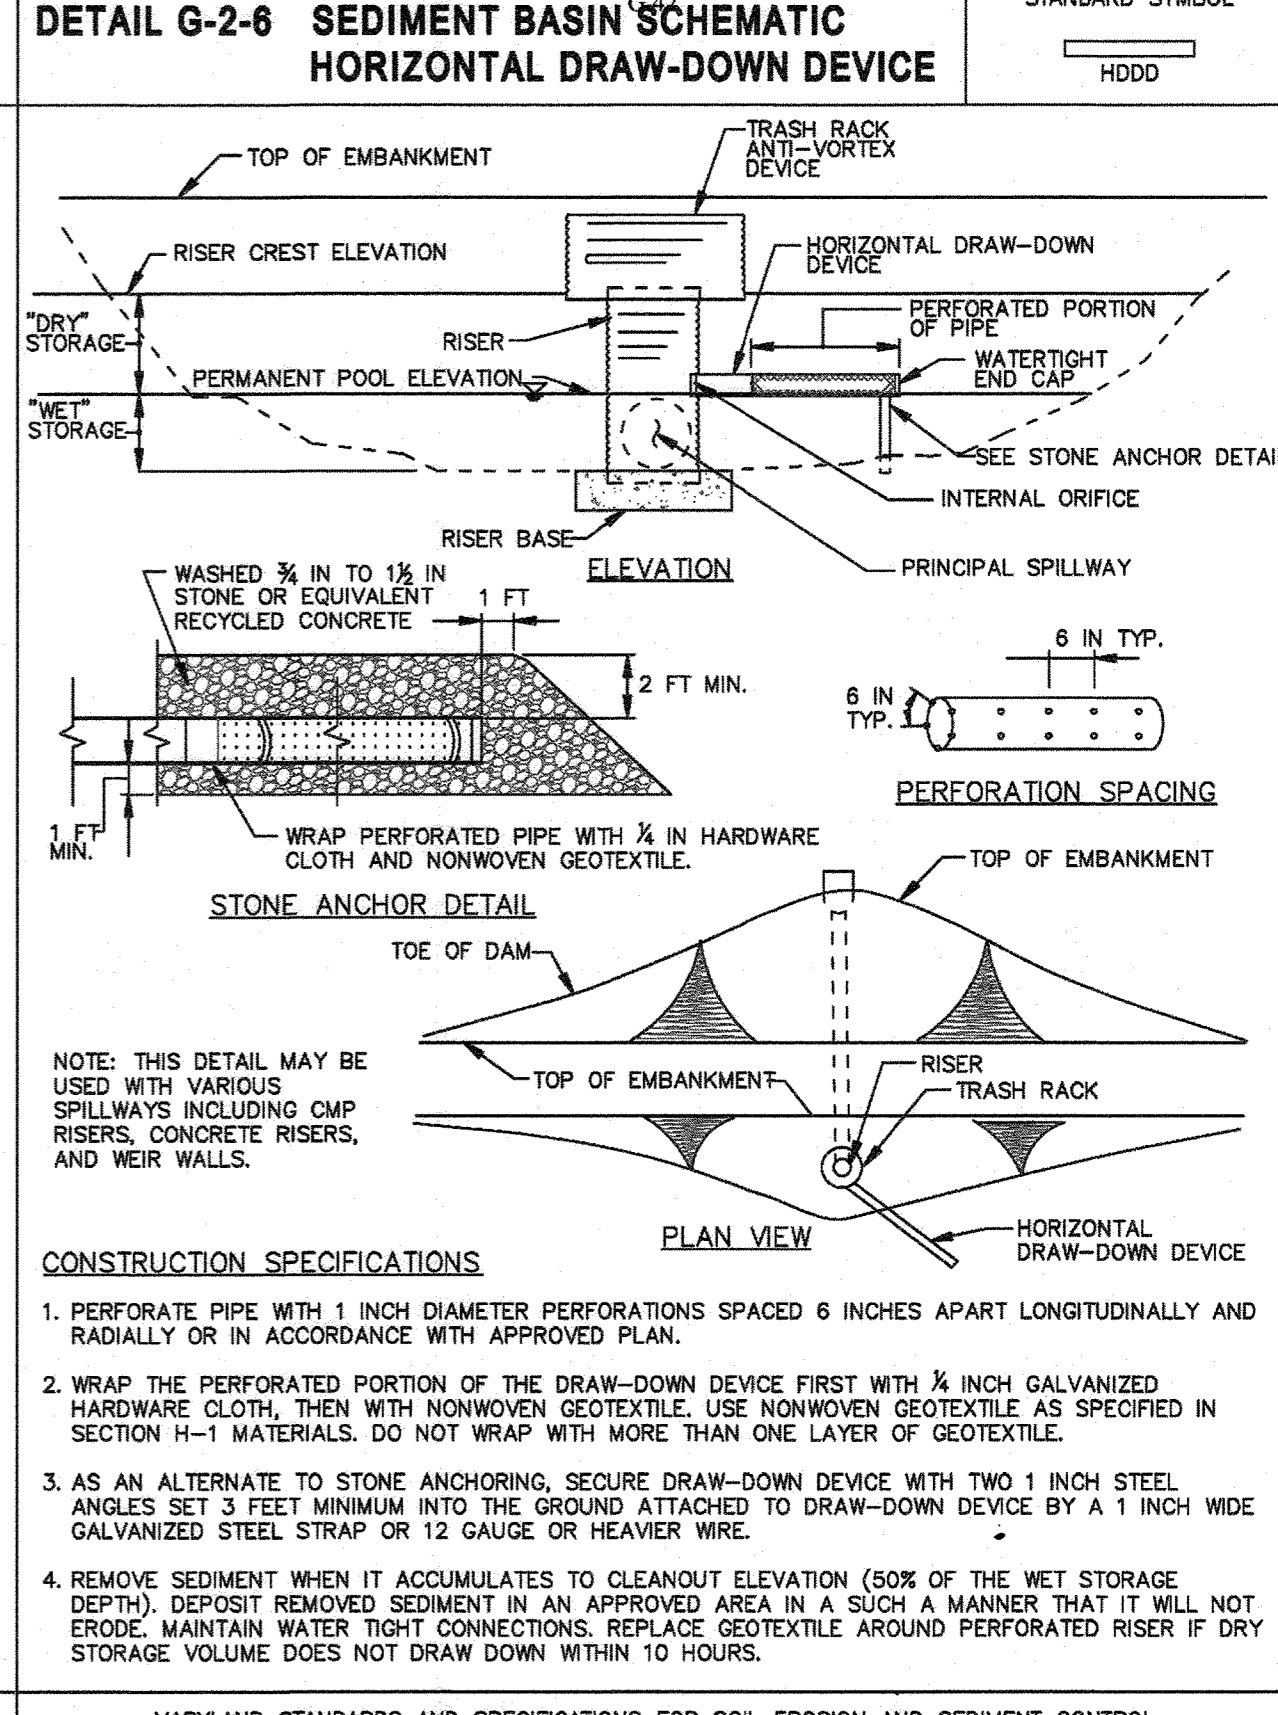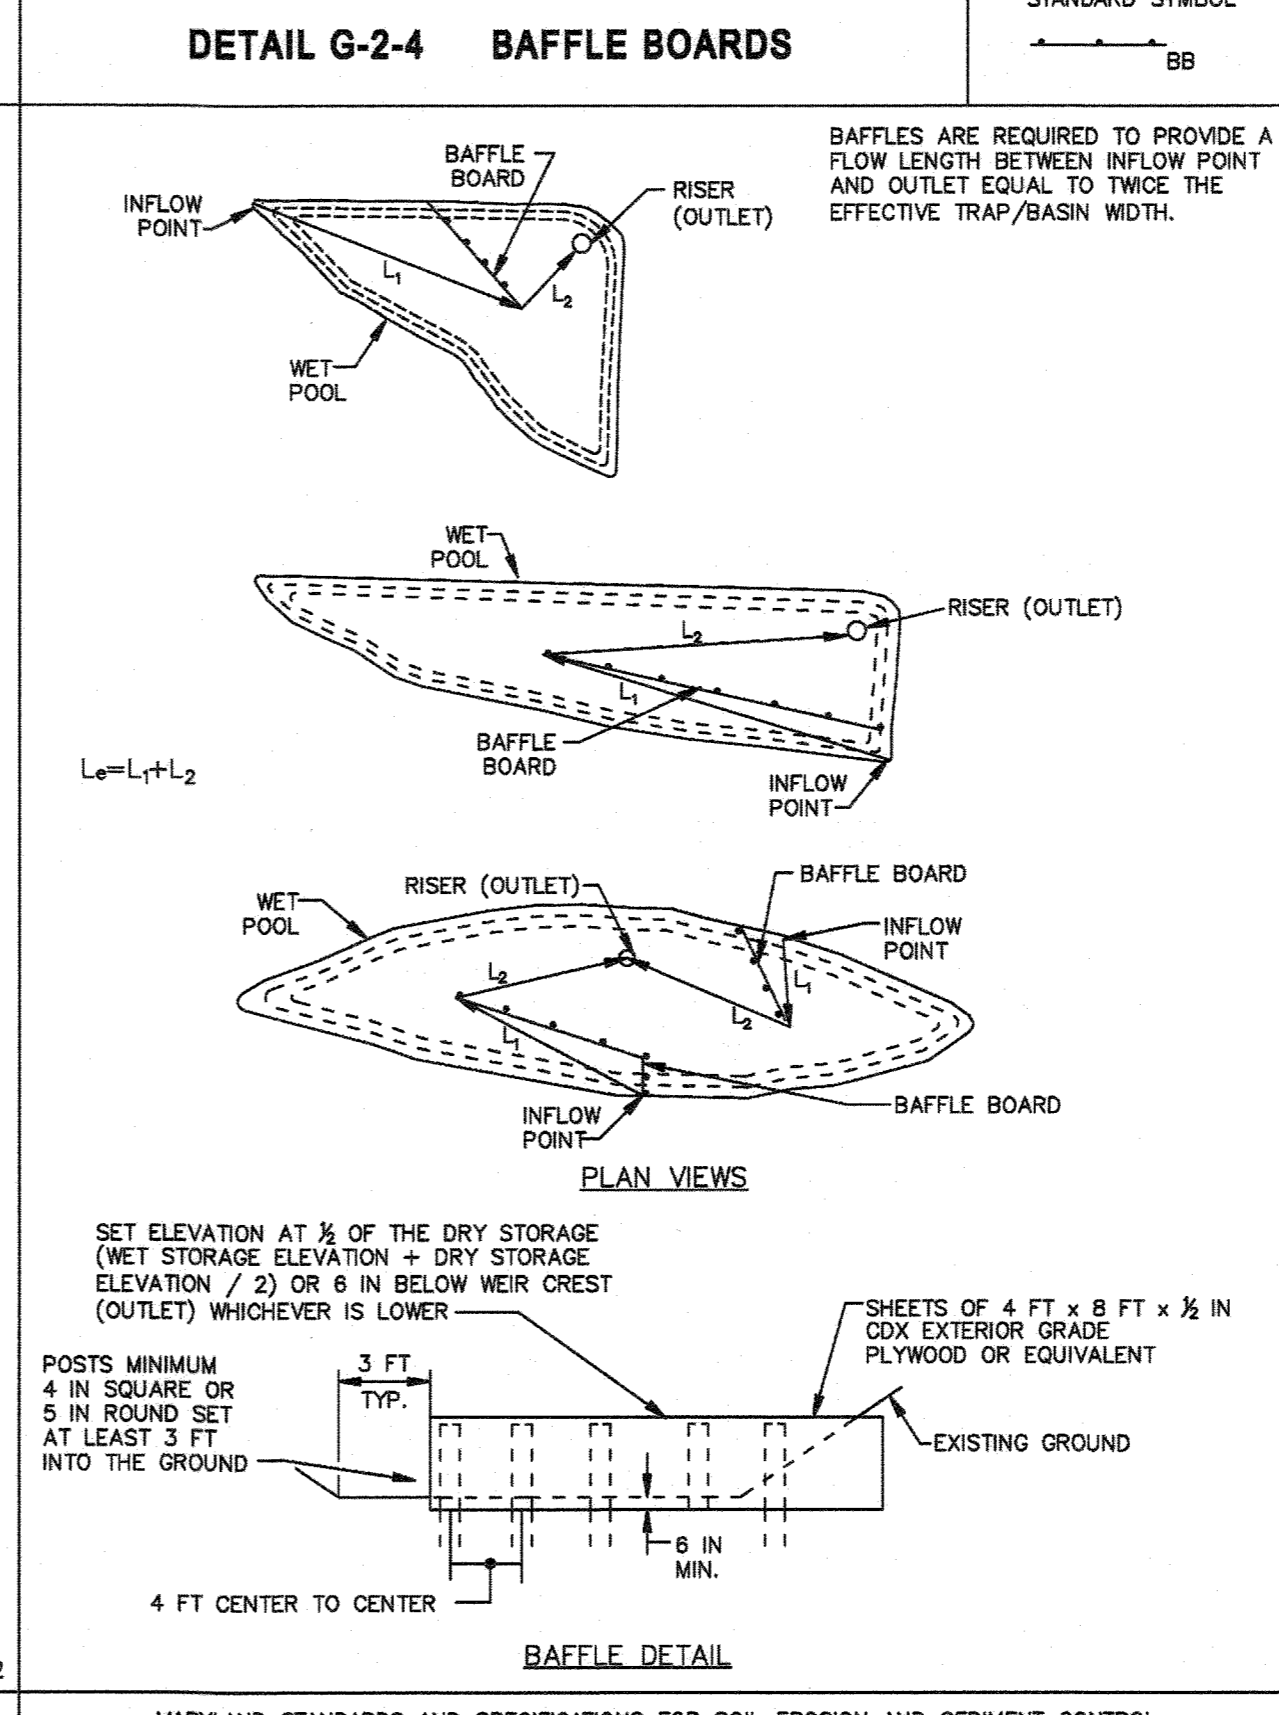

MARYLAND STANDARDS AND SPECIFICATIONS FOR SOIL EROSION AND SEDIMENT CONTROL

U.S. DEPARTMENT OF AGRICULTURE NATURAL RESOURCES CONSERVATION SERVICE 2011

MARYLAND DEPARTMENT OF ENVIRONMENT WATER MANAGEMENT ADMINISTRATION

MARYLAND STANDARDS AND SPECIFICATIONS FOR SOIL EROSION AND SEDIMENT CONTROL

U.S. DEPARTMENT OF AGRICULTURE NATURAL RESOURCES CONSERVATION SERVICE 2011

MARYLAND DEPARTMENT OF ENVIRONMENT WATER MANAGEMENT ADMINISTRATION

MARYLAND STANDARDS AND SPECIFICATIONS FOR SOIL EROSION AND SEDIMENT CONTROL

U.S. DEPARTMENT OF AGRICULTURE NATURAL RESOURCES CONSERVATION SERVICE 2011

MARYLAND DEPARTMENT OF ENVIRONMENT WATER MANAGEMENT ADMINISTRATION

MARYLAND STANDARDS AND SPECIFICATIONS FOR SOIL EROSION AND SEDIMENT CONTROL

U.S. DEPARTMENT OF AGRICULTURE NATURAL RESOURCES CONSERVATION SERVICE 2011

MARYLAND DEPARTMENT OF ENVIRONMENT WATER MANAGEMENT ADMINISTRATION

MARYLAND STANDARDS AND SPECIFICATIONS FOR SOIL EROSION AND SEDIMENT CONTROL

U.S. DEPARTMENT OF AGRICULTURE NATURAL RESOURCES CONSERVATION SERVICE 2011

MARYLAND DEPARTMENT OF ENVIRONMENT WATER MANAGEMENT ADMINISTRATION

HOWARD SCD SIGNATURE BLOCK:

This plan is approved for soil erosion and sediment control by the Howard Soil Conservation District.

Alvander Butcher
Howard Soil Conservation District

11/15/23
Date

APPROVED: DEPARTMENT OF PLANNING AND ZONING

Chad DeWitt
Chief, Development Engineering Division

12.5.23
Date

Demetrius Waters
Director

2/22/24
Date

2/22/24
Date

RK&K
RUMMEL, KLEPPER & KAHL, LLP
ENGINEERS/CONSTRUCTION MANAGERS/PLANNERS/SCIENTISTS
RESPONSIVE PEOPLE-CREATIVE SOLUTIONS

700 East Pratt Street, Suite 500
Baltimore, MD 21202
Ph: 410.728.2900
Contact: Matt Thomason
www.rk&k.com

PROFESSIONAL CERTIFICATION: I HEREBY CERTIFY THAT THESE DOCUMENTS WERE PREPARED OR APPROVED BY ME, AND THAT I AM A DULY LICENSED PROFESSIONAL ENGINEER UNDER THE LAWS OF THE STATE OF MARYLAND, LICENSE NO. 48492, EXPIRATION DATE: MAY 31, 2024.

Chad DeWitt
11/1/2023

DESIGN BY: SHK

DRAWN BY: JMS/DTP

CHECKED BY: CWWW

DATE: 11/1/2023

REVISION

NO.

DATE

BY

NO.

DATE

OWNER/DEVELOPER

JOHNS HOPKINS
APPLIED PHYSICS LABORATORY
11100 JOHNS HOPKINS ROAD
LAUREL, MARYLAND 20723

EROSION CONTROL NOTES & DETAILS - BORROW AREAS

JOHNS HOPKINS UNIVERSITY - APPLIED PHYSICS LABORATORY

OUTDOOR TESTING AREAS





11100 JOHNS HOPKINS ROAD
PARCEL: 123 GRID: 16 ZONED: PEC
ELECTION DISTRICT 5 HOWARD COUNTY, MARYLAND

SHEET 72 OF 73

C-697

RK&K PROJECT NUMBER 21047.013

SCALE: As Shown

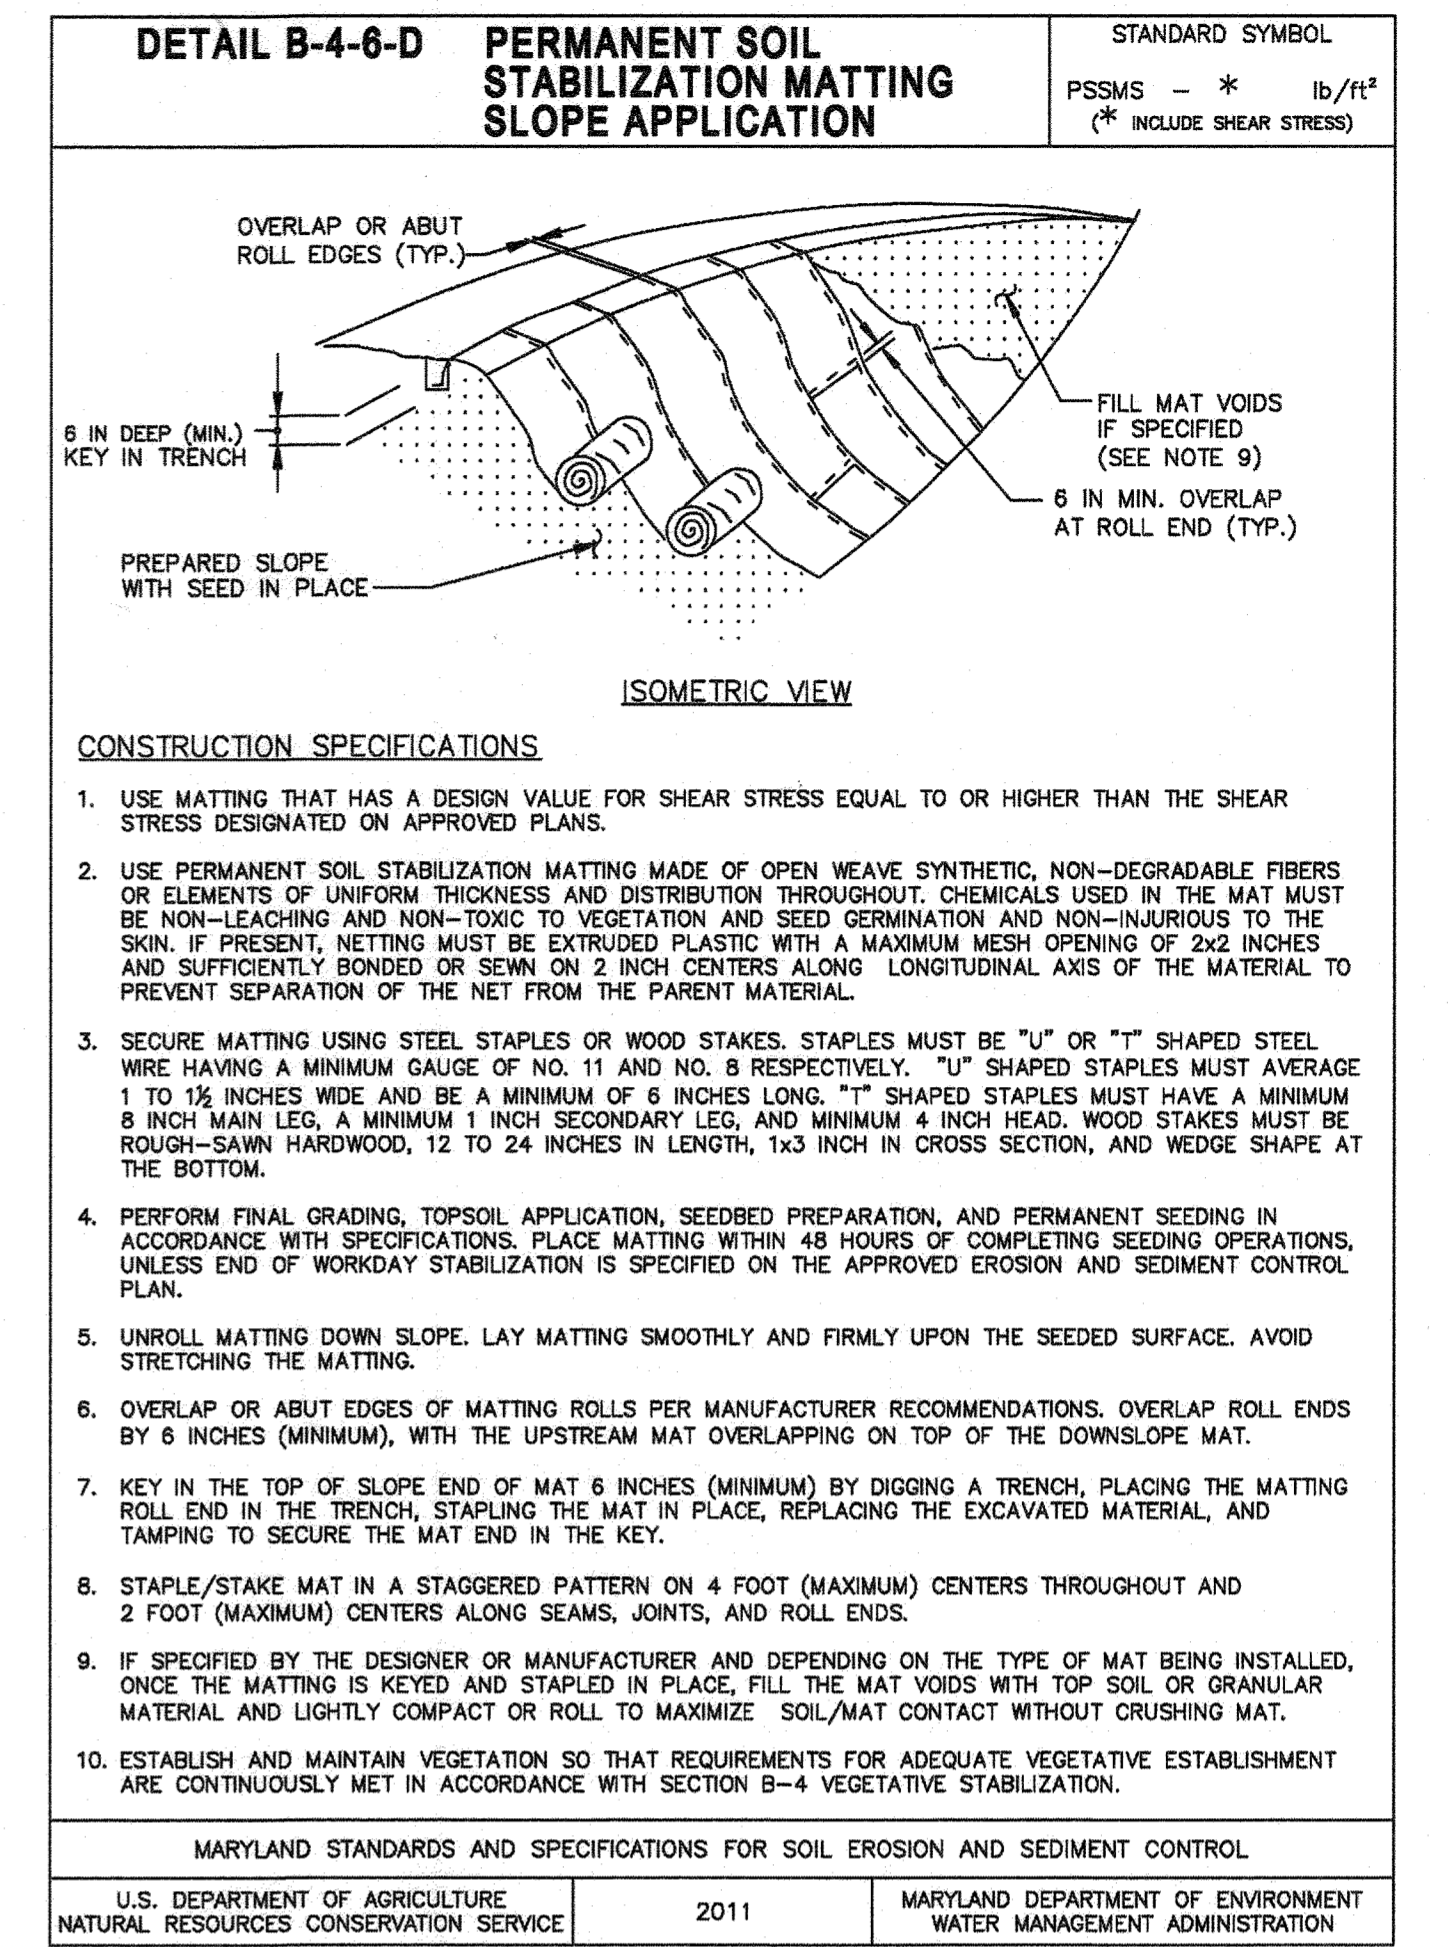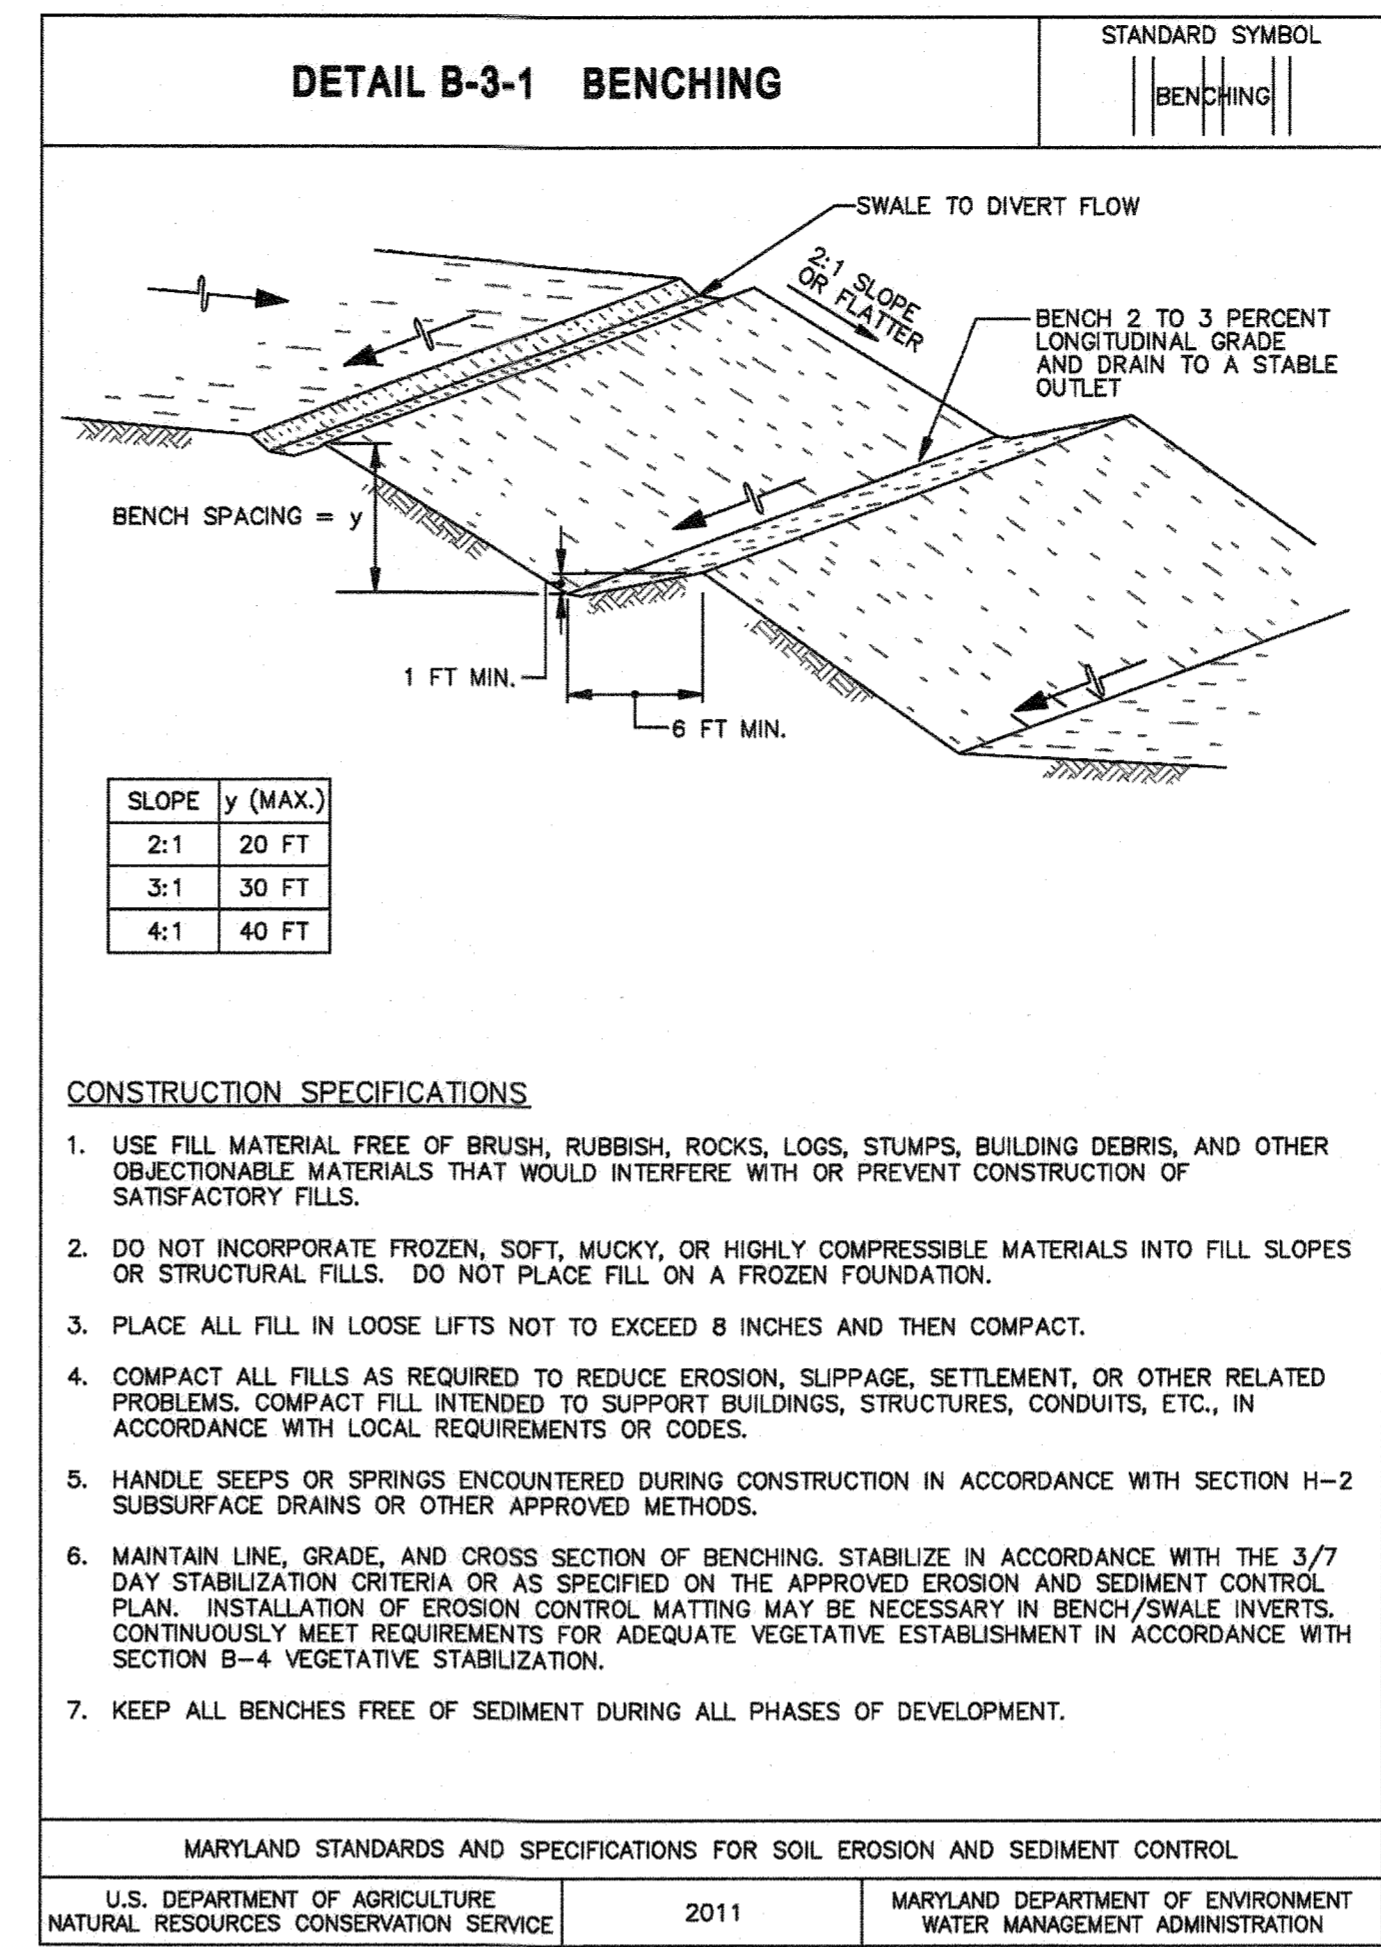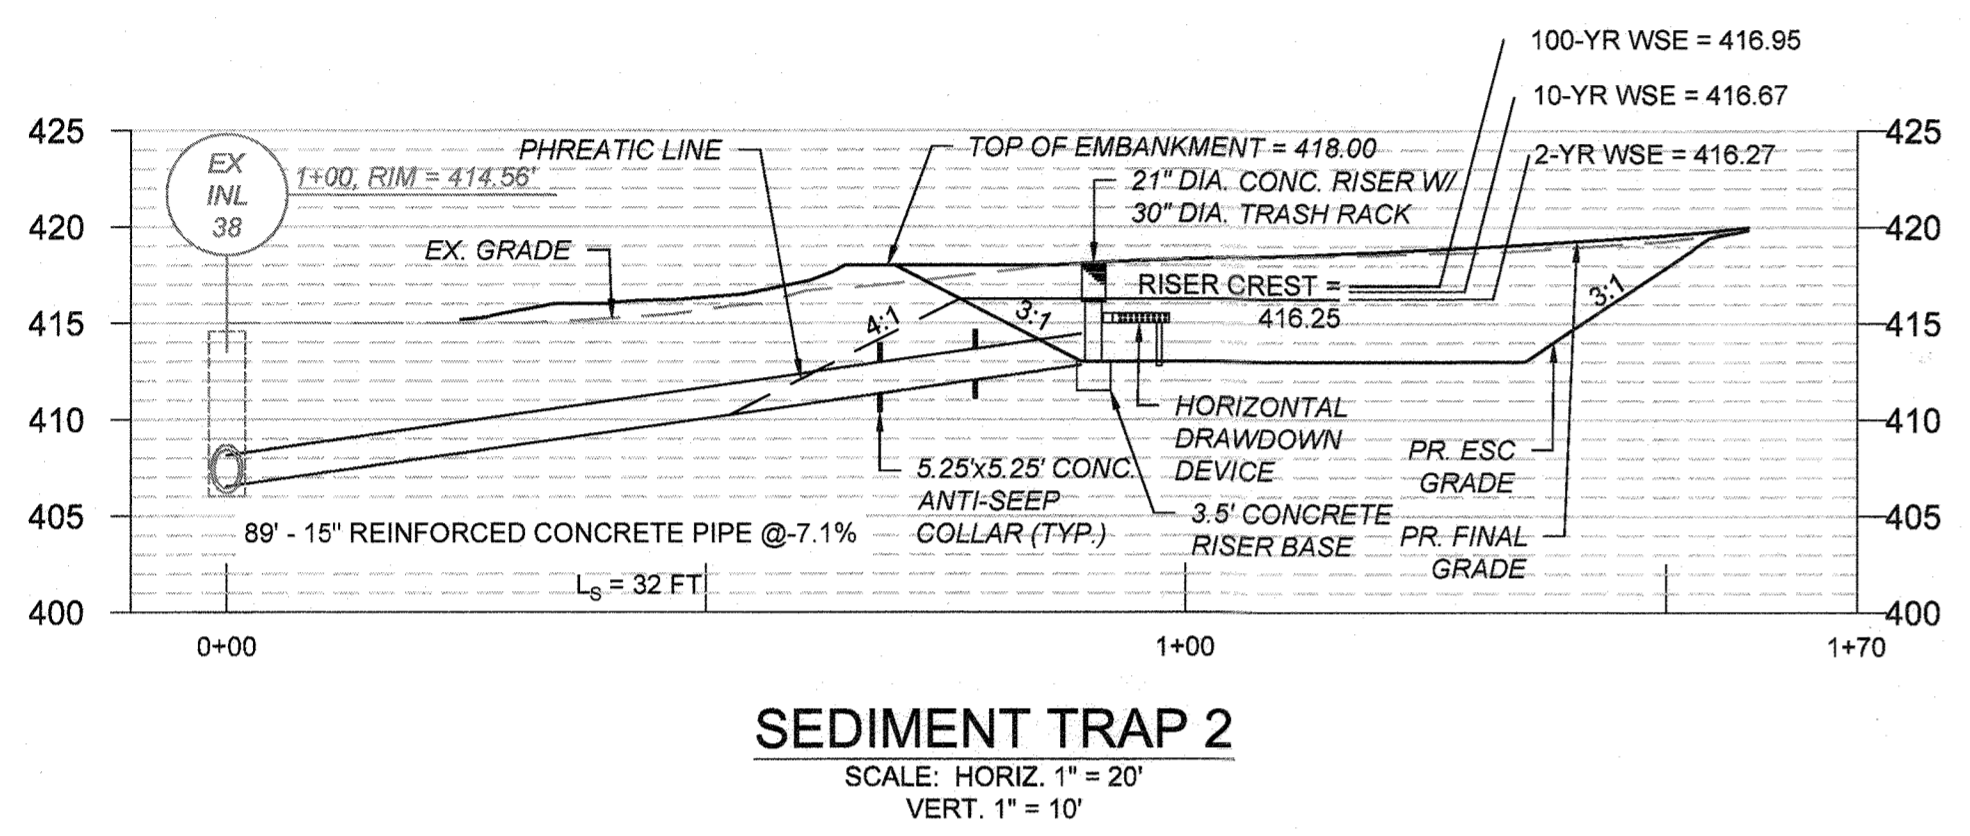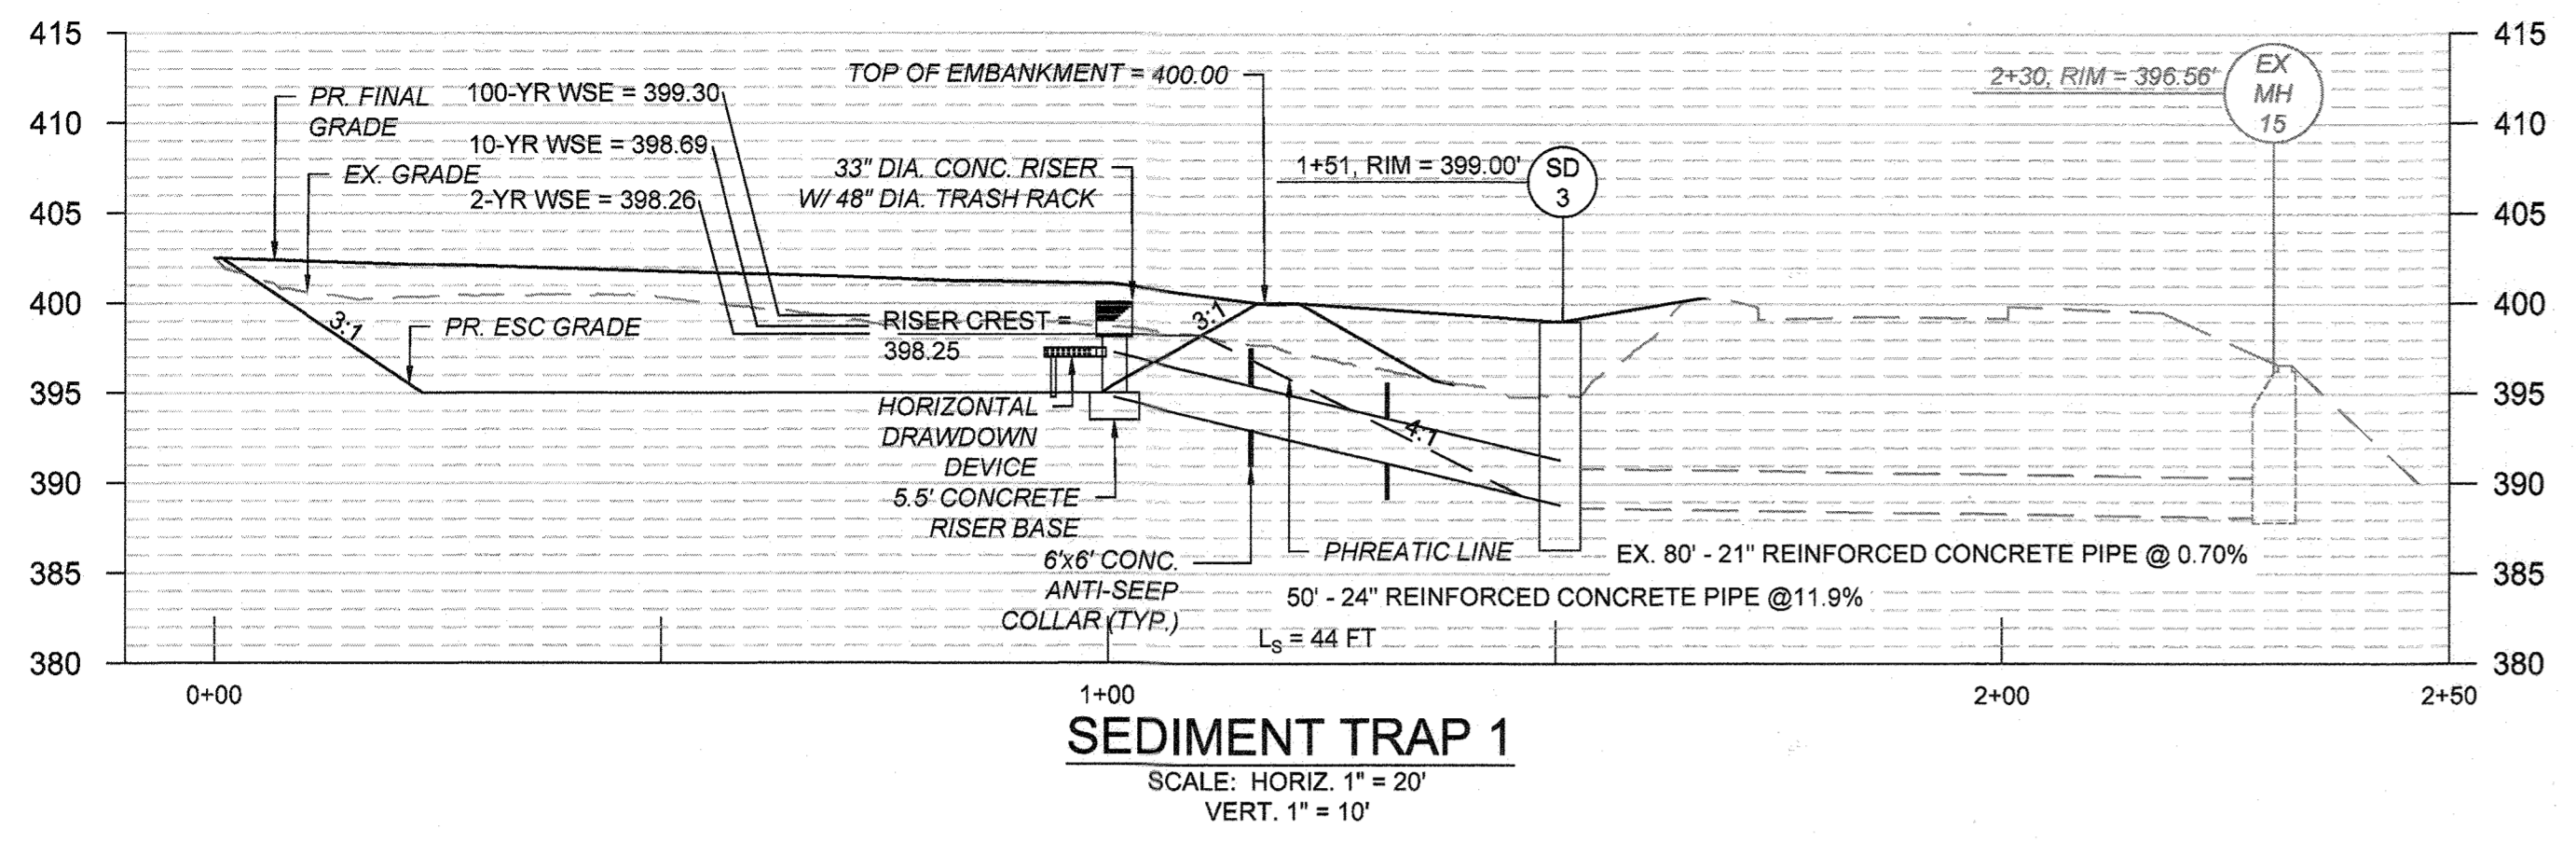

HOWARD SCD SIGNATURE BLOCK:
This plan is approved for soil erosion and sediment control by the Howard Soil Conservation District.
Howard Soil Conservation District
Date: 11/15/23

APPROVED: DEPARTMENT OF PLANNING AND ZONING
Chief, Development Engineering Division
Date: 12-5-23
Chief, Division of Land Development
Date: 2/22/24

RK&K
RUMMEL, KLEPPER & KAHL, LLP
ENGINEERS, CONSTRUCTION MANAGERS, PLANNERS, ARCHITECTS
RESPONSIVE PEOPLE. CREATIVE SOLUTIONS.
700 East Pratt Street, Suite 500
Baltimore, MD 21202
PH: 410.728.2900
WWW.RK&K.COM

| | |
|-------------------|-----------------|
| DESIGN BY: SHK | DATE: 11/1/2023 |
| DRAWN BY: JMS/DTP | |
| CHECKED BY: CWWW | |
| BY NO. | REVISION |
| DATE | DATE |

OWNER/DEVELOPER
JOHNS HOPKINS APPLIED PHYSICS LABORATORY
11100 JOHNS HOPKINS ROAD
LAUREL, MARYLAND 20723

EROSION CONTROL PROFILES & DETAILS - BORROW AREAS
JOHNS HOPKINS UNIVERSITY - APPLIED PHYSICS LABORATORY
OUTDOOR TESTING AREAS
11100 JOHNS HOPKINS ROAD
TAX MAP: 41 PARCEL: 123 GRID: 16 ZONED: PEC
ELECTION DISTRICT 5 - HOWARD COUNTY, MARYLAND
SHEET 73 OF 73

C-698
RK&K PROJECT NUMBER 21047.013
SCALE: As Shown

▲ PURPOSE STATEMENT (11/1/23): DESIGN OF OUTDOOR TESTING AREA 3, INCLUDING THE SOURCE OF BORROW MATERIAL REFERRED TO AS THE EAST AND WEST BORROW AREAS.