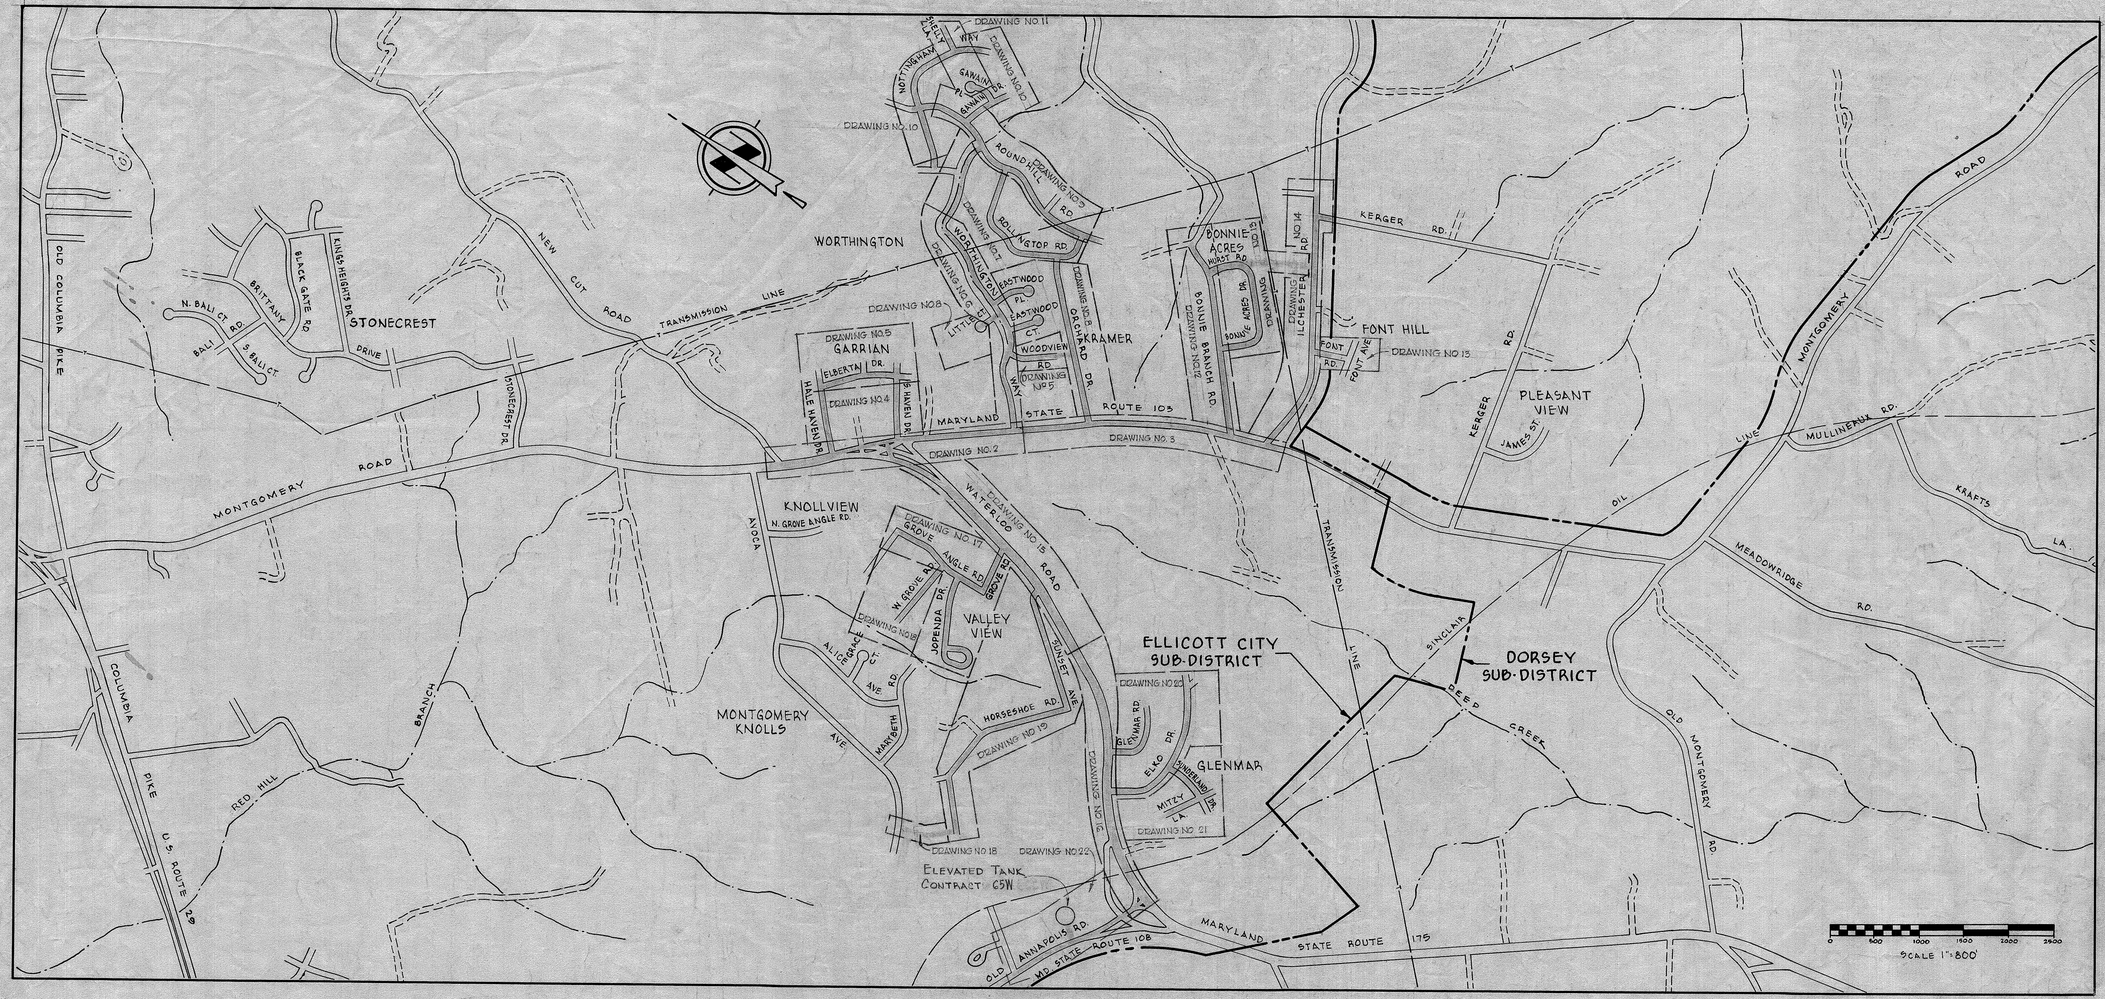


# CONTRACT 64W
# WATER MAIN EXTENSIONS
# HOWARD COUNTY METROPOLITAN COMMISSION
## ELLICOTT CITY SUB-DISTRICT

| | | | | | | |
|---|---|---|---|---|---|---|
| WHITMAN, REQUARDT & ASSOCIATES<br>ENGINEERS<br>1304 ST. PAUL ST.<br>BALTIMORE, MARYLAND | HOWARD COUNTY METROPOLITAN COMMISSION<br>Aug. 30, 1963 (DATE)<br>CHIEF ENGINEER | CONTRACT NO. 64W | LOCATION MAP OF WATER MAIN EXTENSIONS | ELLICOTT CITY SUB-DISTRICT | DRAWING NO. 1 OF 31 | SCALE AS SHOWN |

W. O. 5318-2

AS BUILT 7 JAN. 1966

WS 64W/1

K. ELLIOTT CO., PITTSBURGH REORDER A-28070

Note:
Connect to 12"W if constructed under contract 12W

NEW CUT ROAD

GARRIAN ORCHARDS SECTION 1

MONTGOMERY ROAD (STATE ROUTE 103)

HALE HAVEN DRIVE

For Continuation See Drawing No 4

F.F. 490.00

C. 486.64

C 489.14

C 496.52

C 496.86

C 499.19

Match Line "A-A" See This Drawing

12"D

12"W

12"x6"T

POT. 1+21

POT. 1+87

To PI 1+M

LIMIT OF CONTRACT

Ex. 15"C.M.P.

Ex. 4"G

PI 2+M

Ex. 18"C.M.P.

Ex. 15"R.C.P.

12"x12"T

8"W

8"V

12"x8"T

Strap valve and reducer to Tee

Ex. 18"R.C.P.

for Profile See Drawing No. 23

C 470.97

C 470.83

F.F. 481.6 N.C.

C 478.35

C 476.01

21.50°S 52.50°W

22.00°S 52.00°W

NOTE: 110 L.F. 8"WATER MAIN, 6" VALVE & FIRE HYDRANT SET BY HO.CO. D.P.W. UNDER CAPITAL PROJ-W-8-8117

For Continuation See Drawing No 15

W.R.&A. B.M. #M-17 Elev. 497.87
R.R. Spike in C.&P. Pole #52 @ Intersection Montgomery Road & South Haven Drive.

For Continuation See Drawing No 4

GARRIAN SECTION 1

SOUTH HAVEN DRIVE

C 500.61

C 512.98

C 512.37

C 515.17

C 516.42

PROPERTY OF WOODROW W MOORE AND ISABELLE V. MOORE

MONTGOMERY ROAD (STATE ROUTE 103)

WORTHINGTON WAY

WORTHINGTON SECTION 1

C 507.72

W.R.&A. BM #M-17

W.R.&A. BM #M-16

Hedges to be removed and replaced on property line

Ex. 18"C.M.P.

Ex. 18"R.C.P.

Ex. 24" R.C.P.

Ex. 4"G

Ex. 6"G

Ex. 2"G

12"W

WATERLOO ROAD (STATE ROUTE 175)

C 509.21

C 513.13

C 512.33

C 519.80

C 502.79

22.50°S 51.00°W

22.75°S 51.00°W

23.25°S 51.00°W

Match Line "A-A" See This Drawing

Match Line "B-B" See Drawing No 5

W.R.&A. B.M. #M-16 Elev. 507.33
R.R. Spike C.&P. Pole #76 @ Intersection Montgomery Road & Worthington Way.

| Rev. No. | Rev. Date | Revision Description. |
|---|---|---|
| 1 | 12-15-81 | Added 110 LF 8"W, 6"V & F.H. Vicinity Watermont S.C. |

Contract No 64 W

| | | | | | |
|---|---|---|---|---|---|
| WHITMAN, REQUARDT & ASSOCIATES ENGINEERS 1304 ST. PAUL ST. BALTIMORE, MARYLAND | HOWARD COUNTY METROPOLITAN COMMISSION 6 Sept. 1963 DATE — CHIEF ENGINEER | CONTRACT NO. 64 W | PLAN OF WATER MAINS | ELLICOTT CITY SUB-DISTRICT | DRAWING NO. 2 OF 31 | SCALE 1"=50' | 22°25'W 38.29'45"N 84. |

FB 3018, 3017

W. O. 5318-2

AS BUILT 7 JAN 1966

WS 64W/2

E. J. ELLIOTT CO., PITTSBURGH REORDER A-39070

For Continuation See Drawing No 8

Match Line 'C-C' See Drawing No 2

PROPERTY OF HERMAN H. JR. & JULIA C. KRAMER

KRAMER'S SUBDIVISION

ORCHARD DRIVE

PROPERTY OF EARL E. & JOYCE A. BARTH

PROPERTY OF NELSON J. & SARAH H. ARNOLD

MONTGOMERY ROAD

STATE ROUTE 103

Tunnel Tree

Match Line 'C-C' See This Drawing

PROPERTY OF JAMES T. JR. & MARIA POWELL

For Continuation See Drawing No 12

BONNIE BRANCH ROAD

PROPERTY OF RIEHL & KNODE INSURANCE AGENCY, INC

For Continuation See Drawing No 14

ILCHESTER ROAD

To Pl. 12-M

Strap 12"V to 12"x8"T

W.R.&A. B.M. #M-14 Elev. 500.19
P.K. Spike in G.&E. Pole #170567 West side Montgomery Rd., opposite Bonnie Branch Rd.

W.R.&A. B.M. #M-13 Elev. 481.40
P.K. Spike base G.&E. Pole #168893 @ Intersection Montgomery Rd. & Ilchester Rd.

for Profile See Drawing No. 23

| | | | | | | |
|---|---|---|---|---|---|---|
| WHITMAN, REQUARDT & ASSOCIATES ENGINEERS 1304 ST. PAUL ST. BALTIMORE, MARYLAND | HOWARD COUNTY METROPOLITAN COMMISSION 6 Sept. 1968 DATE — Carl W. Mayer CHIEF ENGINEER | CONTRACT NO. 64 W | PLAN OF WATER MAINS | ELLICOTT CITY SUB-DISTRICT | DRAWING NO. 3 OF 31 | SCALE 1" = 50' |

Contract No. 64W

W. O. 5318-2

AS BUILT 7 JAN 1966

FB 3018,3017

WS 64W/3

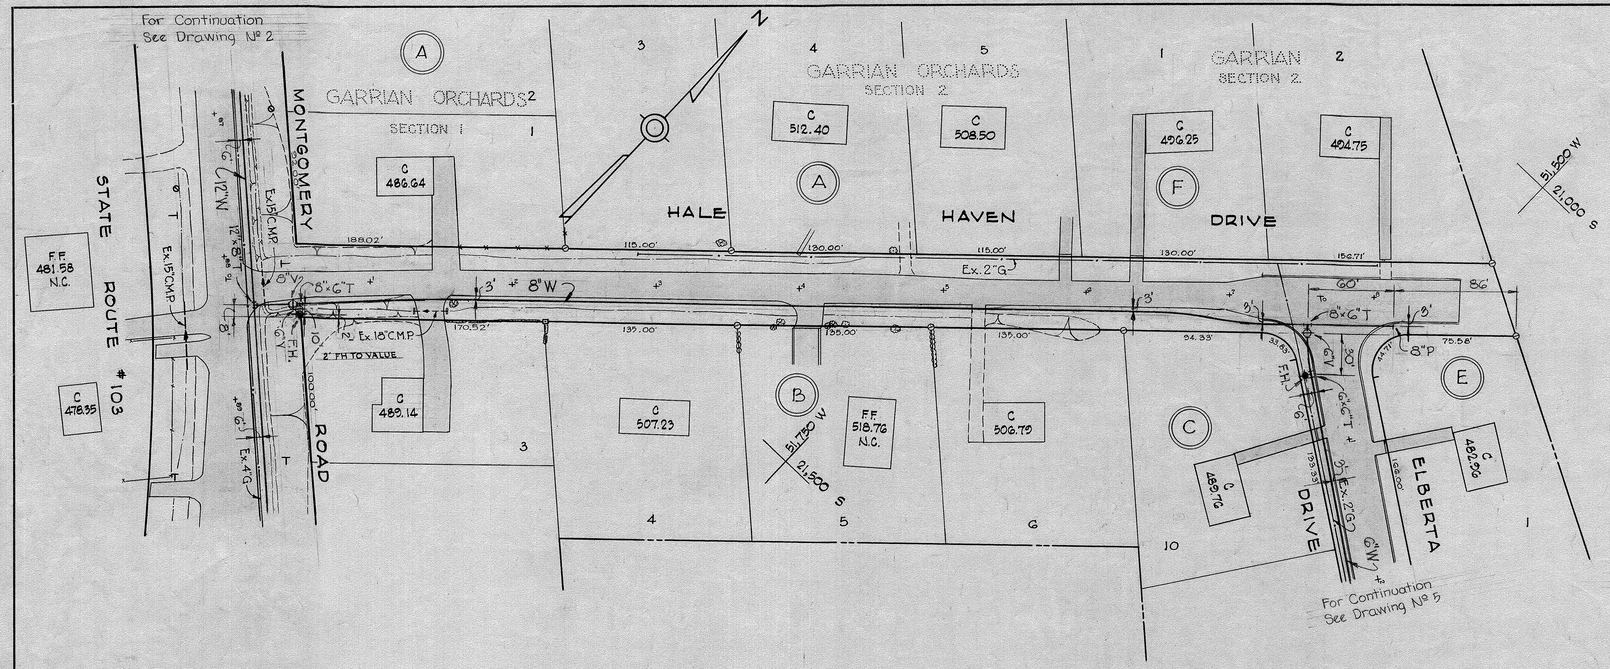


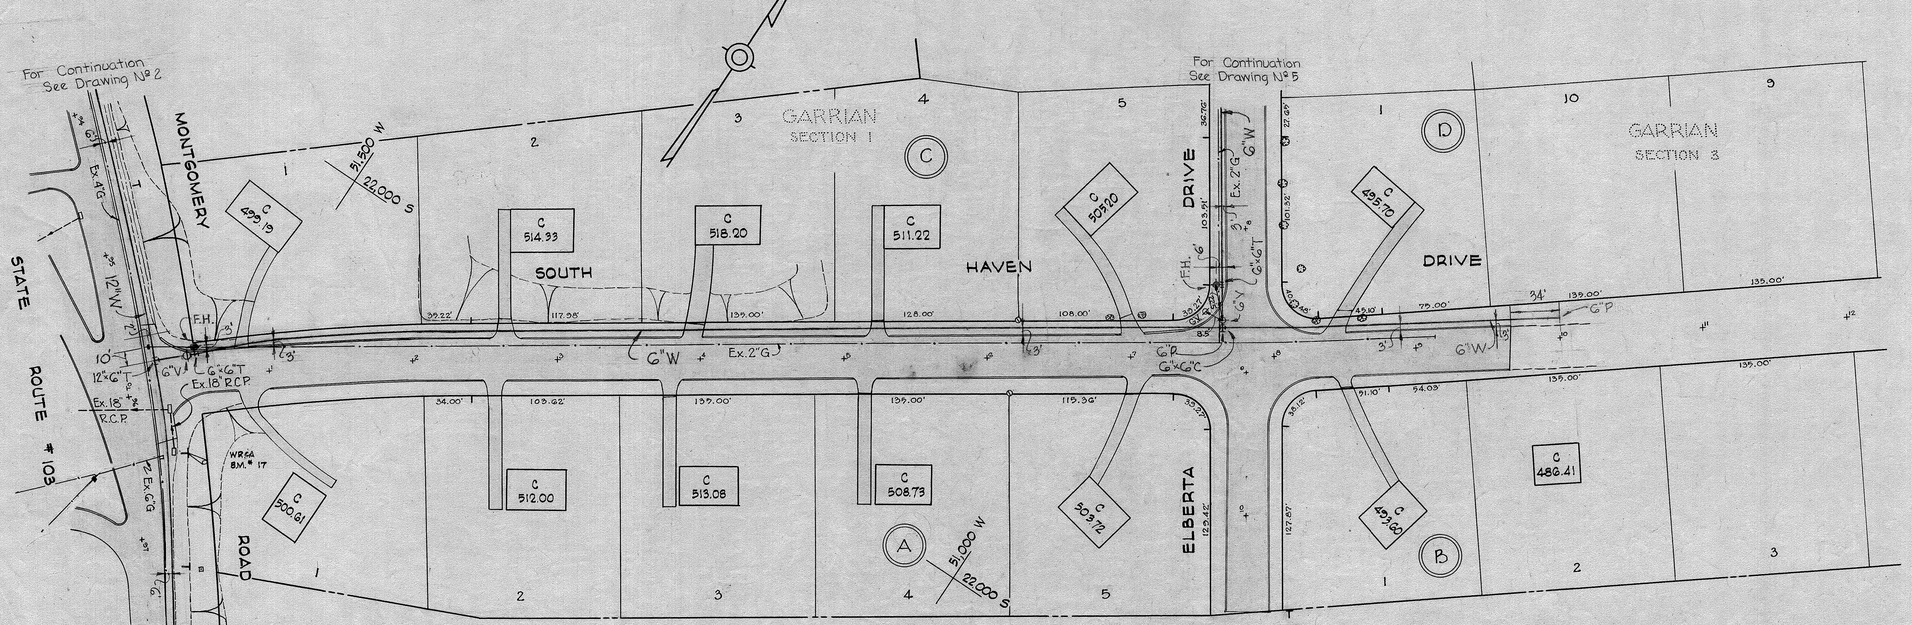


## GENERAL NOTES

1. Approximate location of existing mains are shown. The Contractor shall take all necessary precautions to protect the existing mains and services and maintain uninterrupted supply. Any damage incurred shall be repaired immediately.
2. All pipe elevations shown are invert Ø elevations
3. The contractor shall locate existing utilities a minimum of two weeks in advance of construction operations in vicinity of utilities.
4. For all standard details, see Standards bound in Specifications.
5. Block all fittings with concrete, see standard details bound in Specifications.
6. Bury line elevation on Fire Hydrants shall be set the same as edge of paving or as directed by the Engineer in the field.
7. All 6"W and 8"W to be class 22 C.I.P. all 12"W to be class 23, Water Mains to have a minimum of 3½' cover unless otherwise noted.
8. Before digging, pushing pipe or doing other work near Telephone Cables call collect any time Lexington 9-9900 Ext. 553, 554 or 555, Baltimore, Maryland.
9. Clear all poles by 2'-0" minimum.
10. The location of all valves, fittings etc. have been located in plan and dimensions shall be strictly adhered to unless otherwise directed by the Engineer in writing.
11. Buttress Fire Hydrants with concrete; provide copper pipe at weep holes as required for positive drainage. For buttress dimensions see Standard Detail W-8 Buttress For Caps.
12. 2"W to be copper Type "K" and have a minimum cover of 3½' unless otherwise noted.

Contract № 64 W

| | | | | | | |
|---|---|---|---|---|---|---|
| WHITMAN, REQUARDT & ASSOCIATES ENGINEERS 1304 ST. PAUL ST. BALTIMORE, MARYLAND | HOWARD COUNTY METROPOLITAN COMMISSION 6 Sept. 1963 DATE — Carl W. Mayer CHIEF ENGINEER | CONTRACT NO. 64 W | PLAN OF WATER MAINS | ELLICOTT CITY SUB-DISTRICT | DRAWING NO. 4 OF 31 | SCALE 1" = 50' |

22 SW 34
22,23 SW 35

W. O. 5318-2

F.B. 3015, 3021

AS BUILT 7 JAN 1966

WS 64W/4

J. K. ELLIOTT CO., PITTSBURGH REORDER A-39070

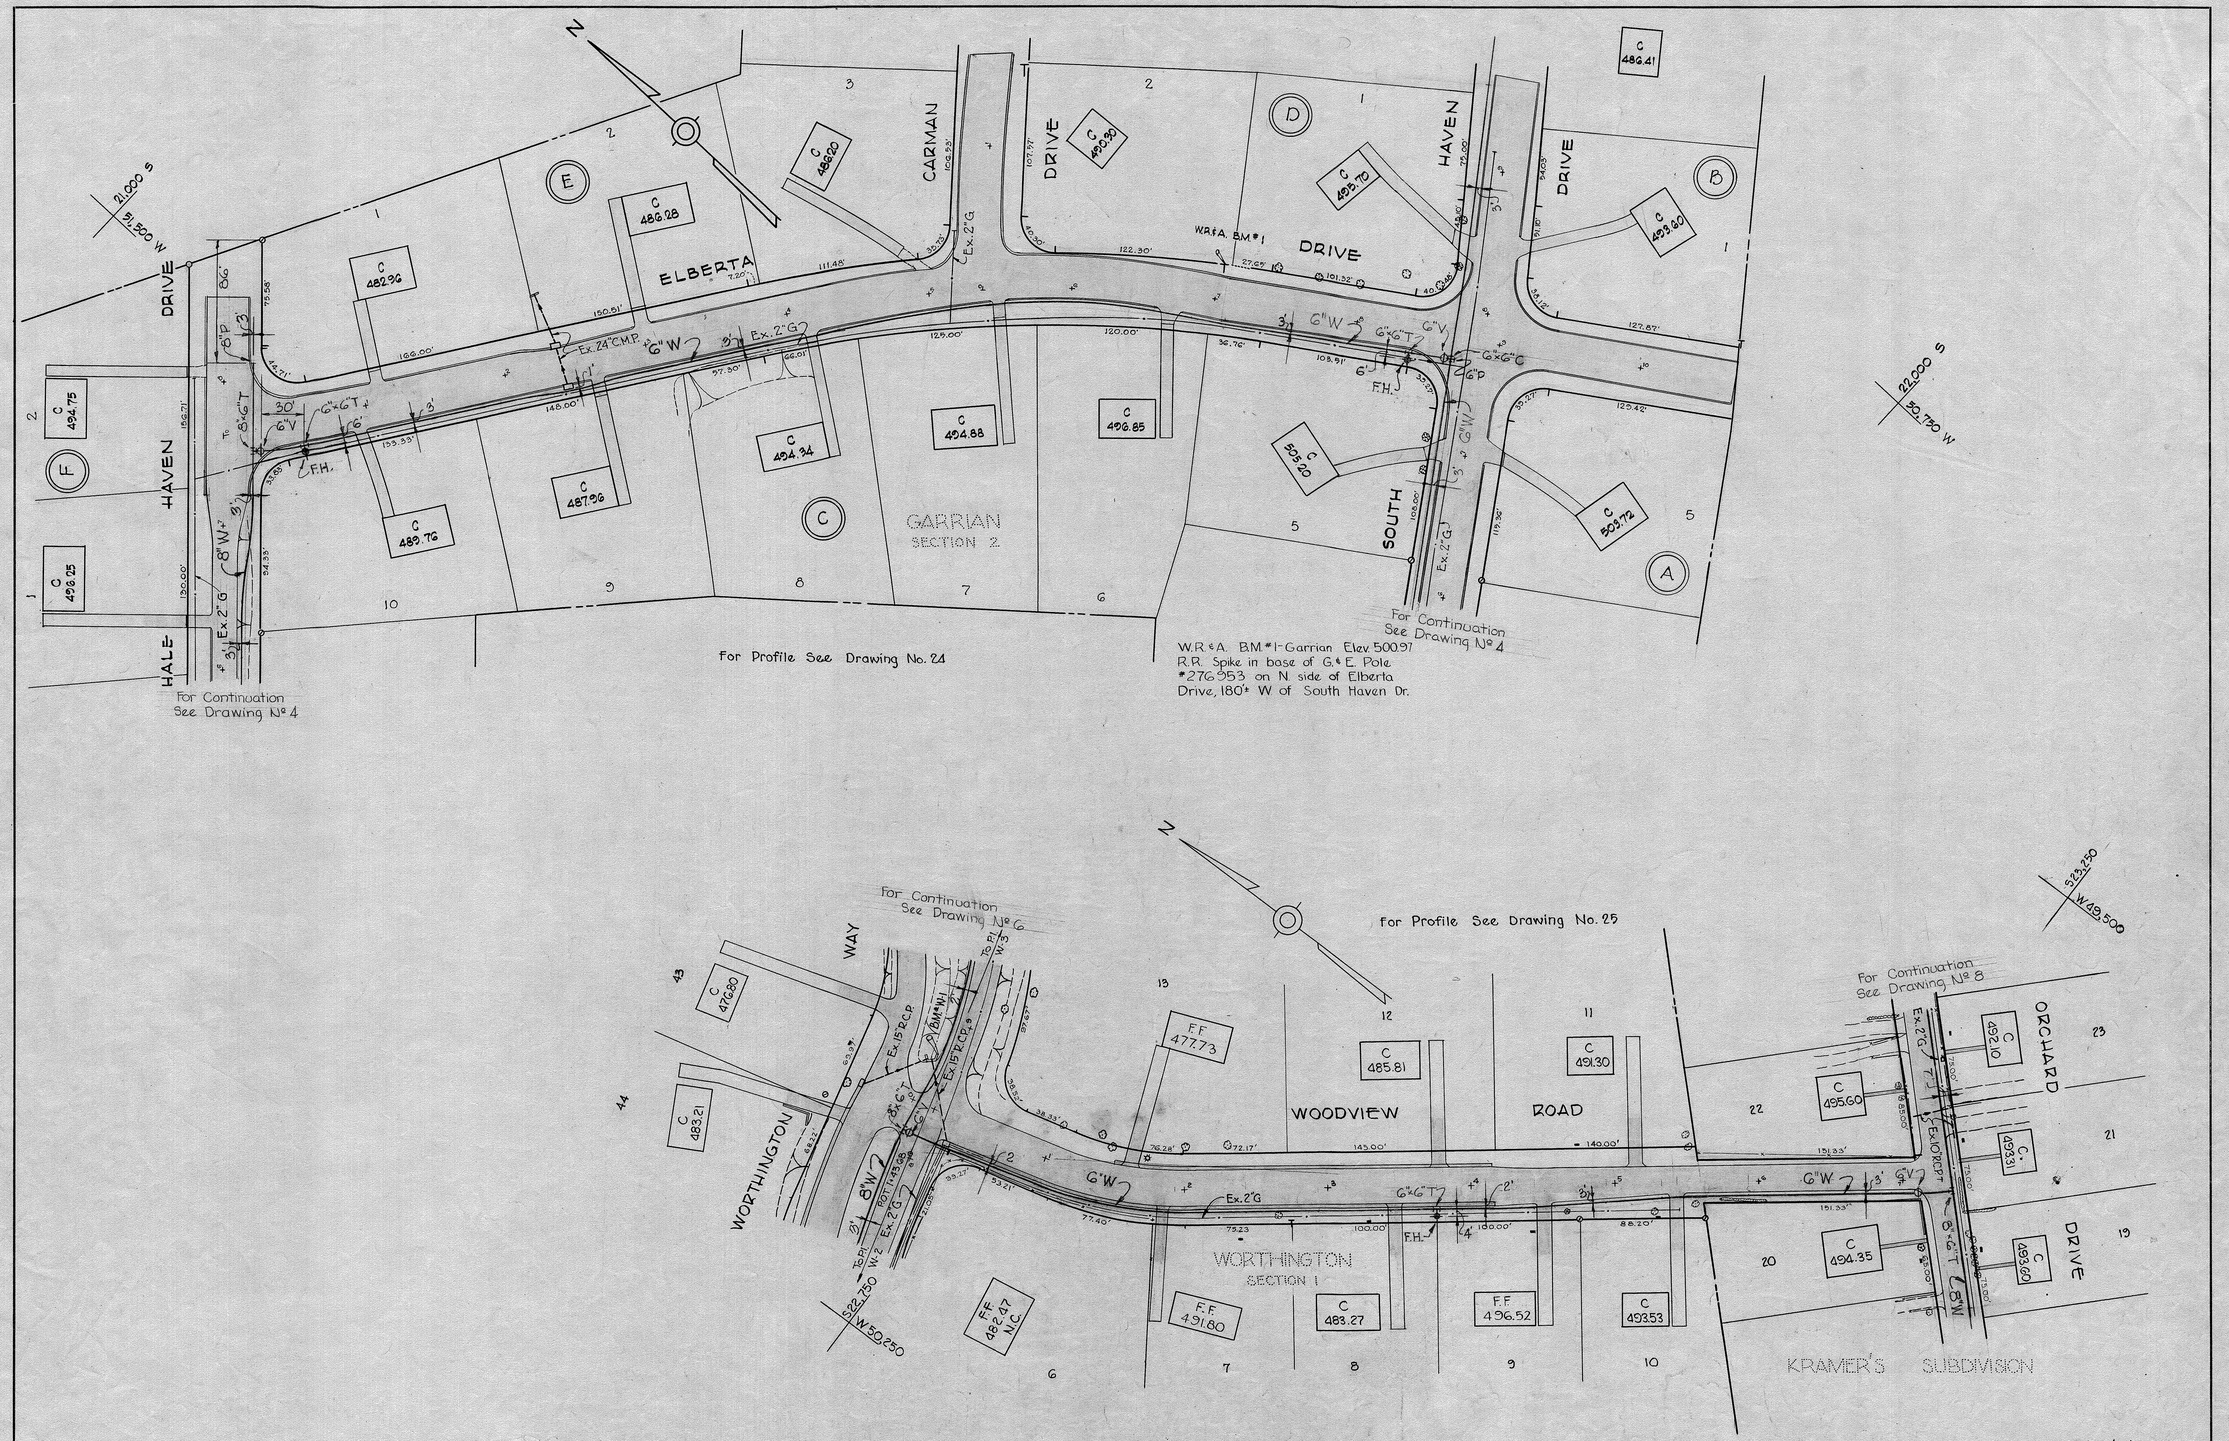


| | | | | | | |
|---|---|---|---|---|---|---|
| WHITMAN, REQUARDT & ASSOCIATES<br>ENGINEERS<br>1304 ST. PAUL ST.<br>BALTIMORE, MARYLAND | HOWARD COUNTY METROPOLITAN COMMISSION<br>6 Sept. 1963 (DATE)<br>Carl W. Meyer (CHIEF ENGINEER) | CONTRACT NO. 64 W | PLAN OF<br>WATER MAINS | ELLICOTT CITY SUB-DISTRICT | DRAWING NO. 5 OF 31 | SCALE<br>1" = 50' |

Contract № G4 W

W. O. 5318-2

AS BUILT 7 JAN. 1966

F.B. 3021, 3032, 3027

22-5W 34-22-5W 35, 23, 24 SW 34

WS 64W/5

R. K. ELLIOTT CO., PITTSBURGH REORDER A-59070

For Continuation See Drawing № 8

For Continuation See Drawing № 2

STATE ROUTE #103

ROAD

MONTGOMERY

WORTHINGTON

WAY

WOODVIEW ROAD

LITTLE COURT

EASTWOOD COURT

WORTHINGTON SECTION 1

WORTHINGTON SECTION 2

For Continuation See Drawing № 3

For Continuation See Drawing № 5

For Continuation See Drawing № 8

For Profile See Drawing No. 24

W.R. & A. B.M. #W-1 Elev. 471.95
□-cut on headwall, 12' left of sta. 2+15 between P.I. W-2 & P.I. W-3, @ intersection of Woodview Road & Worthington Way.

W.R. & A. B.M. #W-2 Elev. 458.16
□ cut on top of headwall 36' left of sta. 0+30 between P.I. W-4 & P.I. W-5 @ Intersection of Worthington Way & Little Ct.

W.R. & A. B.M. #W-3 Elev. 418.86
P.K. spike in base of 30" Maple, 30' left of sta. 5+90 between P.I. W-5 & P.I. W-6

PROPERTY OF W.R. & A. B.M. #W-3

WORTHINGTON CONSTRUCTION CORPORATION

PLACE

EASTWOOD

WORTHINGTON SECTION 2

WORTHINGTON SECTION 3

Match Line "DD" See This Drawing

Match Line "EE" See Drawing No. 7

Contract № 64W

| | | | | | | |
|---|---|---|---|---|---|---|
| WHITMAN, REQUARDT & ASSOCIATES ENGINEERS 1304 ST. PAUL ST. BALTIMORE, MARYLAND | HOWARD COUNTY METROPOLITAN COMMISSION — 6 Sept. 1966 DATE — Carl W. Meyer CHIEF ENGINEER | CONTRACT NO. 64 W | PLAN OF WATER MAINS | ELLICOTT CITY SUB-DISTRICT | DRAWING NO. 6 OF 31 | SCALE 1" = 50' — 22 SW 33, 22 SW 34, 23 SW 34, 24 SW 34 |

W. O. 5318-2

AS BUILT 7 JAN 1966

FB-3025

WS 64W/6

© E. ELLIOTT CO., PITTSBURGH REORDER A-39070

ORCHARD DRIVE
ROLLINGTOP
ROLLINGTOP
ROUNDHILL ROAD
ROAD
ROAD
ROUNDHILL ROAD
ROUNDHILL ROAD
WORTHINGTON WAY
WORTHINGTON ADDITION SECTION 1
WORTHINGTON ADDITION SECTION 3
PARCEL #2
PARCEL #7
PROPERTY OF WORTHINGTON CONSTRUCTION CORPORATION
Match Line "E-E" See Drawing No. 6
for Profile See Drawing No. 26
for Profile See Drawing No. 24
Contract No. 64 W
W.R. & A. B.M. #W-6 Elev. 493.91
P.R. spike in base of Power Pole #281016, 20' Left of sta. 1+50 Between Pl. W-14 & Pl. W-15.
BM #W-6
Pl. W-13
Pl. W-14
Pl. W-15
Pl. W-16
Pl. R-3
Pl. R-2
Pl. R-1
Pl. W-11
Pl. W-10
To Pl. W-9
P.O.T. 1-7 G.
F.F. 455.98 N.C.
F.F. 470.20 N.C.
F.F. 469.50 N.C.
F.F. 466.80 N.C.
F.F. 499.82 N.C.
F.F. 425.40 N.C.
F.F. 491.31
F.F. 479.10
C 491.56
C 492.50
C 491.13
C 491.94
C 485.03
C 485.50
C 486.07
C 483.07
C 487.98
C 485.07
C 485.60
C 484.18
C 483.53
C 440.77
C 439.20
C 427.40
C 408.45
22,750 S 49,000 W
22,250 S 48,750 W
21,750 S 48,500 W
21,250 S 48,750 W
21,000 S 48,250 W
N

| | | | | | | |
|---|---|---|---|---|---|---|
| WHITMAN, REQUARDT & ASSOCIATES ENGINEERS 1304 ST. PAUL ST. BALTIMORE, MARYLAND | HOWARD COUNTY METROPOLITAN COMMISSION 6 Sept. 1963 DATE — Fred W. Meyer CHAIRMAN | CONTRACT NO. 64 W | PLAN OF WATER MAINS | ELLICOTT CITY SUB-DISTRICT | DRAWING NO. 7 OF 31 | SCALE 1" = 50' |

5318-2

AS BUILT 7 JAN 1966

FB. 3027 3025

WS 64W/7

For Continuation See Drawing Nº 3

For Continuation See Drawing Nº 5

W.R.& A. B.M.#W-7 Elev. 490.28
P.K. spike in base of Power Pole #215697, N. side of Orchard Drive, 480'± E. of Woodview Road.

MONTGOMERY ROAD STATE ROUTE 103

ORCHARD DRIVE

WOODVIEW ROAD

KRAMER'S SUBDIVISION

Match Line "F.F." See This Drawing

For Continuation See Drawing Nº 7

For Continuation See Drawing Nº 6

ORCHARD DRIVE

ROLLINGTOP ROAD

WORTHINGTON ADDITION SECTION 1

EASTWOOD PLACE

WORTHINGTON WAY

LITTLE COURT

EASTWOOD COURT

WORTHINGTON ADDITION SECTION 2

Tunnel Tree

For Profile See Drawing No. 25

| | | | | | | |
|---|---|---|---|---|---|---|
| WHITMAN, REQUARDT & ASSOCIATES ENGINEERS 1304 ST. PAUL ST. BALTIMORE, MARYLAND | HOWARD COUNTY METROPOLITAN COMMISSION 6 Sept. 1963 DATE — Carl W. Mayer CHIEF ENGINEER | CONTRACT NO. 64 W | PLAN OF WATER MAINS | ELLICOTT CITY SUB-DISTRICT | DRAWING NO. 8 OF 31 | SCALE 1"=50' |

Contract Nº 64 W

W. O. 5318-2

AS BUILT 7 JAN 1966

WS 64W/8

For Continuation See Drawing №7

ROUNDHILL ROAD

BOLLINGTON ROAD

WORTHINGTON ADDITION SECTION 2

WORTHINGTON ADDITION SECTION 3

BONNIE VIEW COURT

Tunnel this proj

Match Line "G-G" See This Drawing

W.R. & A. B.M. #W-5 Elev. 461.87
R.R. spike in base of Power Pole #299957, 30' Right of sta. 0+60. Between P.I. W-12 & P.I. W-13

W.R. & A. B.M. #W-4 Elev. 397.90
R.R. spike in base of 14" Oak 30' Right of sta. 0+40 between P.I. W-9 & P.I. W-10 - Near intersection Worthington Way & Roundhill Road.

For Profile See Drawing No. 26

WORTHINGTON WAY

For Continuation See Drawing №10

NOTTINGHAM WAY

B.M.#W-10 Elev. 472.64
Cut Nail & Tin Top in G. & E. Pole #3474.34, E. side Roundhill Road, 220'± N.W. of Nottingham Way.

Park, Utility & Drainage Reservation

WORTHINGTON ADDITION SECTION 4

GAWAIN DRIVE

| | | | | | | |
|---|---|---|---|---|---|---|
| WHITMAN, REQUARDT & ASSOCIATES<br>ENGINEERS<br>1304 ST. PAUL ST.<br>BALTIMORE, MARYLAND | HOWARD COUNTY METROPOLITAN COMMISSION<br>6 Sept. 1963 (DATE) — Carl W. Mayer (CHAIRMAN) | CONTRACT NO. 64 W | PLAN OF WATER MAINS | ELLICOTT CITY SUB-DISTRICT | DRAWING NO. 9 OF 31 | SCALE 1" = 50' |

Contract № 64 W

5318-2

AS BUILT 7 JAN 1966

WS 64W/9

ELLIOTT CO., PGH., PA. REORDER A-21638

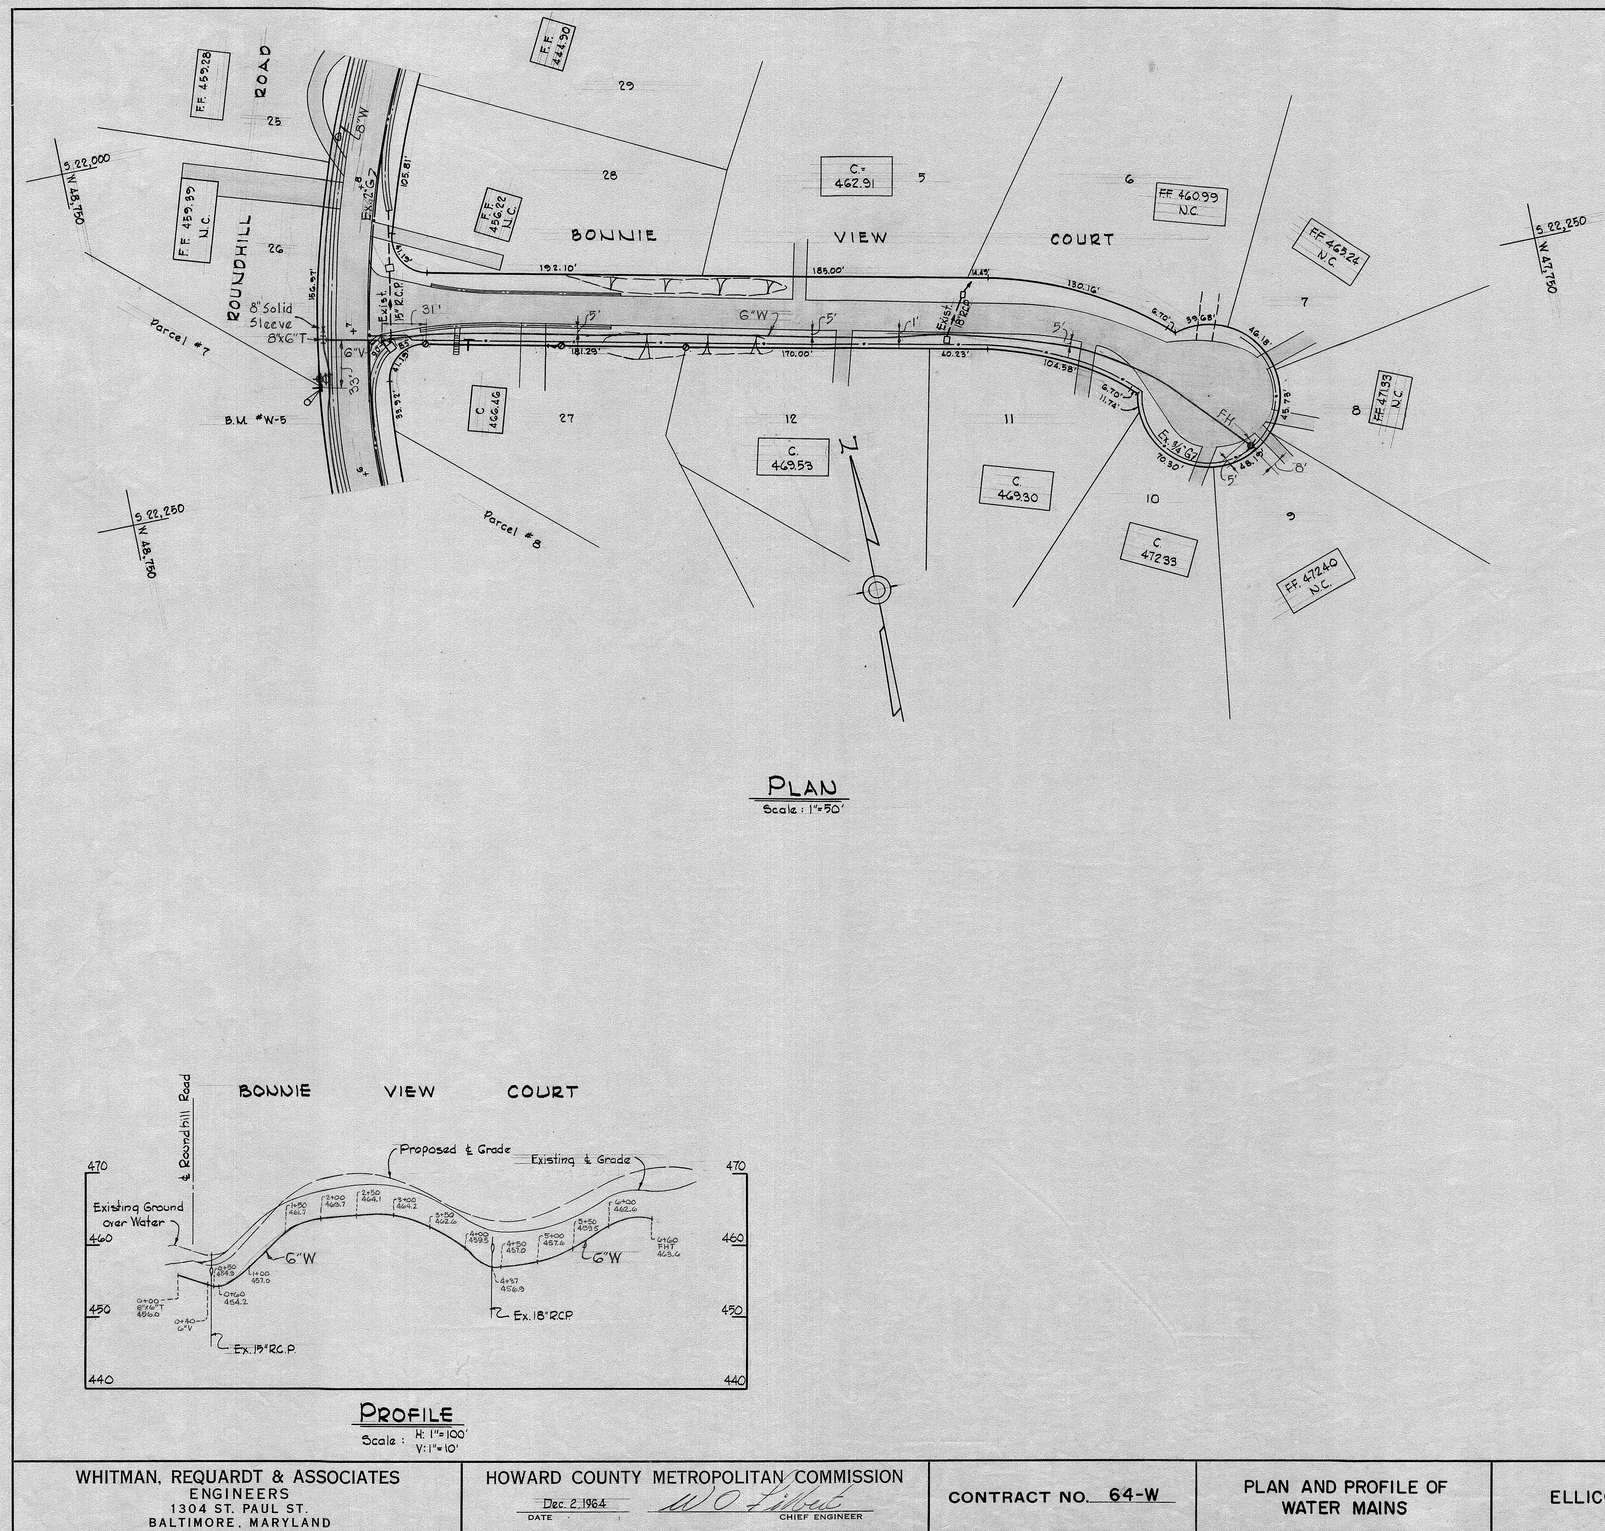


PLAN
Scale : 1"=50'




PROFILE
Scale : H: 1"=100'
V: 1"=10'

Contract 64-W

| | | | | | | |
|---|---|---|---|---|---|---|
| WHITMAN, REQUARDT & ASSOCIATES<br>ENGINEERS<br>1304 ST. PAUL ST.<br>BALTIMORE, MARYLAND | HOWARD COUNTY METROPOLITAN COMMISSION<br>Dec. 2, 1964 (DATE) W O Liberty (CHIEF ENGINEER) | CONTRACT NO. 64-W | PLAN AND PROFILE OF WATER MAINS | ELLICOTT CITY SUB-DISTRICT | DRAWING NO. 9A OF 31 | SCALE AS SHOWN<br>25 SW 32, 33 |

W. O. 5318-2

AS BUILT 7 JAN. 1966

FB. 2984

WS 64W/9A

K. ELLIOTT CO., PITTSBURGH REORDER A-39070

W.R. & A. B.M.#W-9 Elev. 465.36
Cut Nail & Tin Top in 12" poplar N.W. corner of Intersection of Nottingham Way & Shelly Lane.

W.R. & A. B.M.#W-8 Elev. 444.60
□-Cut on corner concrete headwall road side.
℄ Intersection of Gawain Drive & Gawain Place.

For Profile See Drawing No. 25

For Continuation See Drawing No 9

For Continuation See Drawing No 11

For Continuation See Drawing No 9

For Continuation See Drawing No 11

Match Line P-2 See Drawing No 10A

WORTHINGTON ADDITION SECTION 5

WORTHINGTON ADDITION SECTION 4

NOTTINGHAM WAY

ROUNDHILL ROAD

SHELLEY LANE

GAWAIN DRIVE

GAWAIN PLACE

| No | Date | Revision |
|---|---|---|
| 1 | 12-7-64 | 6"W extended. |

| | | | | | | | |
|---|---|---|---|---|---|---|---|
| WHITMAN, REQUARDT & ASSOCIATES ENGINEERS 1304 ST. PAUL ST. BALTIMORE, MARYLAND | HOWARD COUNTY METROPOLITAN COMMISSION 6 Sept. 1963 DATE — Carl W. Meyer CHIEF ENGINEER | CONTRACT NO. 64 W | PLAN OF WATER MAINS | ELLICOTT CITY SUB-DISTRICT | DRAWING NO. 10 OF 31 | SCALE 1"=50' | 21SW 32 & 33 |

W. O. 5318-2

AS BUILT 7 JAN., 1966

Contract No 64 W

WS 64W/10

K. ELLIOTT CO., PITTSBURGH REORDER A-29070

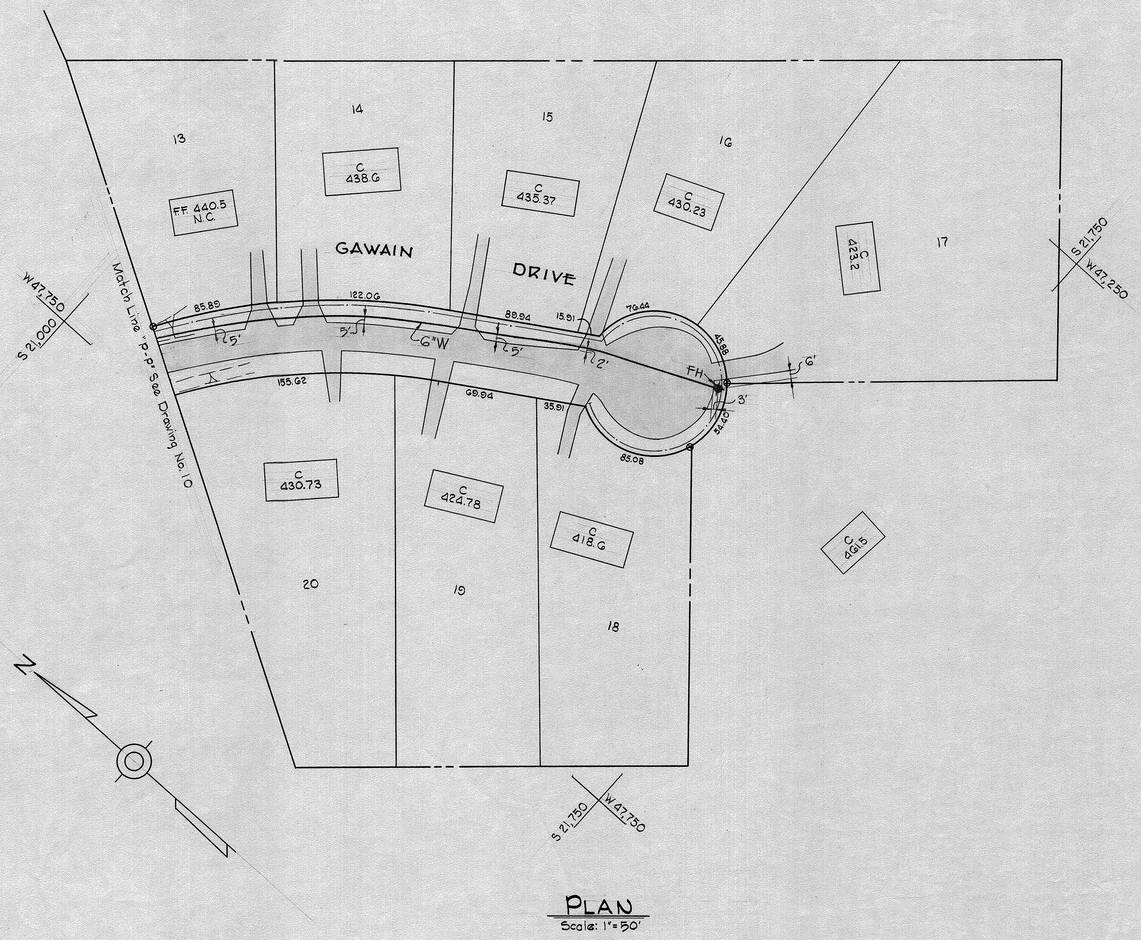


PLAN
Scale: 1"=50'

GAWAIN DRIVE

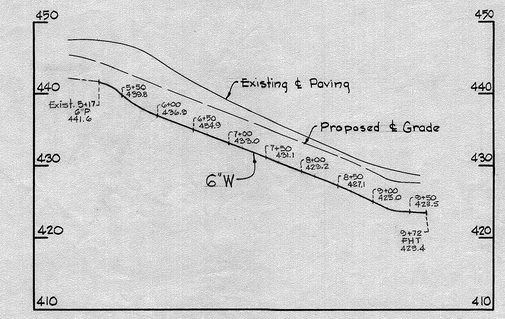


PROFILE
Scale: H: 1"=100'
V: 1"=10'

Contract No G4W

| | | | | | | |
|---|---|---|---|---|---|---|
| WHITMAN, REQUARDT & ASSOCIATES<br>ENGINEERS<br>1304 ST. PAUL ST.<br>BALTIMORE, MARYLAND | HOWARD COUNTY METROPOLITAN COMMISSION<br>Dec. 8, 1964 (DATE) W.O. Talbert (CHIEF ENGINEER) | CONTRACT NO. 64-W | PLAN AND PROFILE OF WATER MAINS | ELLICOTT CITY SUB-DISTRICT | DRAWING NO. 10A OF 31 | SCALE AS SHOWN |

W. O. 3318-2

AS BUILT 7 JAN. 1966 F.B. 3024

WS 64W/10A

K. ELLIOTT CO., PGH., PA. REORDER A-26874

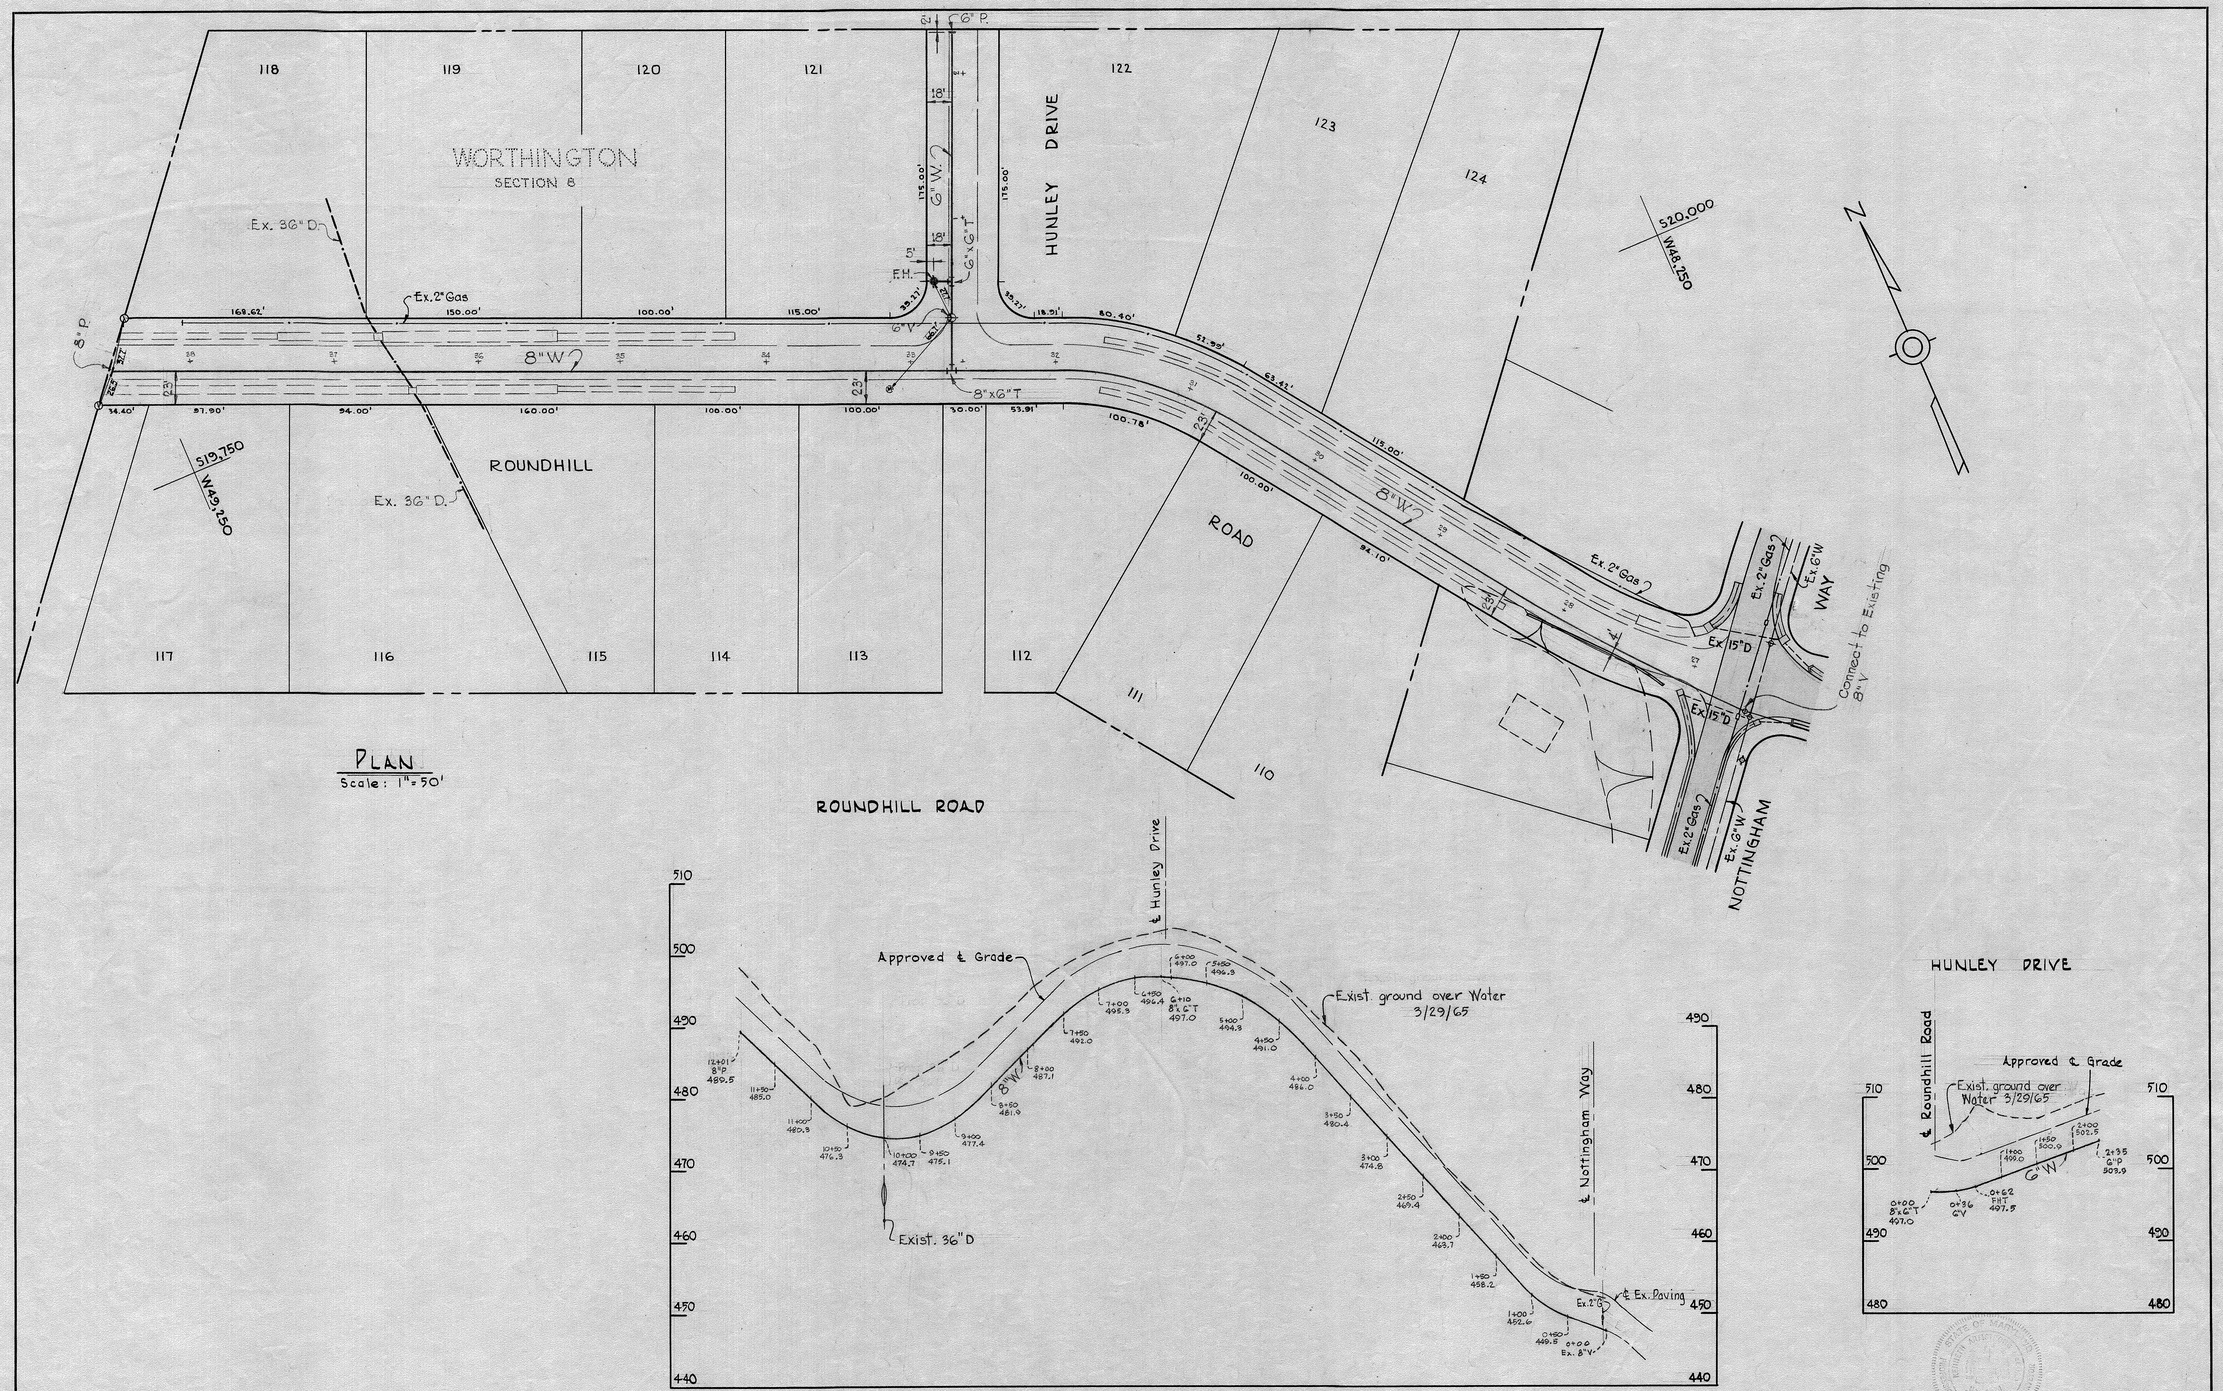


WHITMAN, REQUARDT & ASSOCIATES
ENGINEERS
1304 ST. PAUL ST.
BALTIMORE, MARYLAND

HOWARD COUNTY METROPOLITAN COMMISSION
7 APR 65 (DATE) — W O Tibbets (CHIEF ENGINEER)

CONTRACT NO. 64-W

PLAN AND PROFILE OF WATER MAINS

ELLICOTT CITY SUB-DISTRICT

DRAWING NO. 10B OF 31

SCALE AS SHOWN

20 SW 33
21 SW 33

FD. 5228

Kenneth A. McLeod

Contract No. 64 W

W. O. 5318-2

AS BUILT 7 JAN, 66

WS 64W/10B

K. ELLIOTT CO., PGH., PA. REORDER A-26874

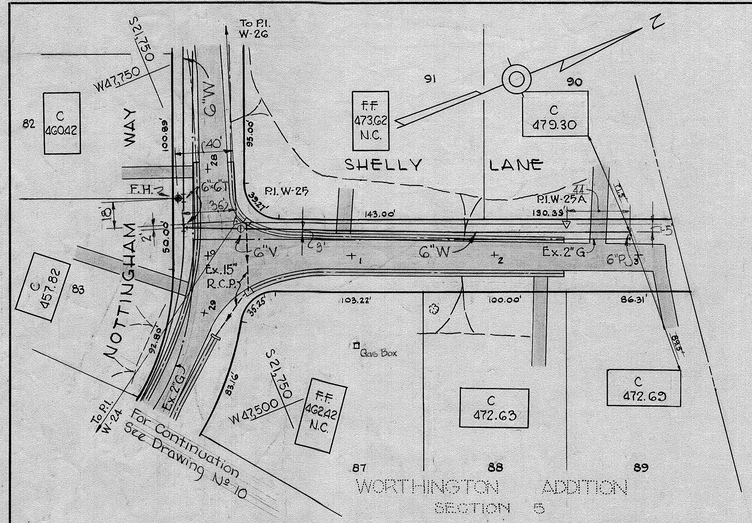


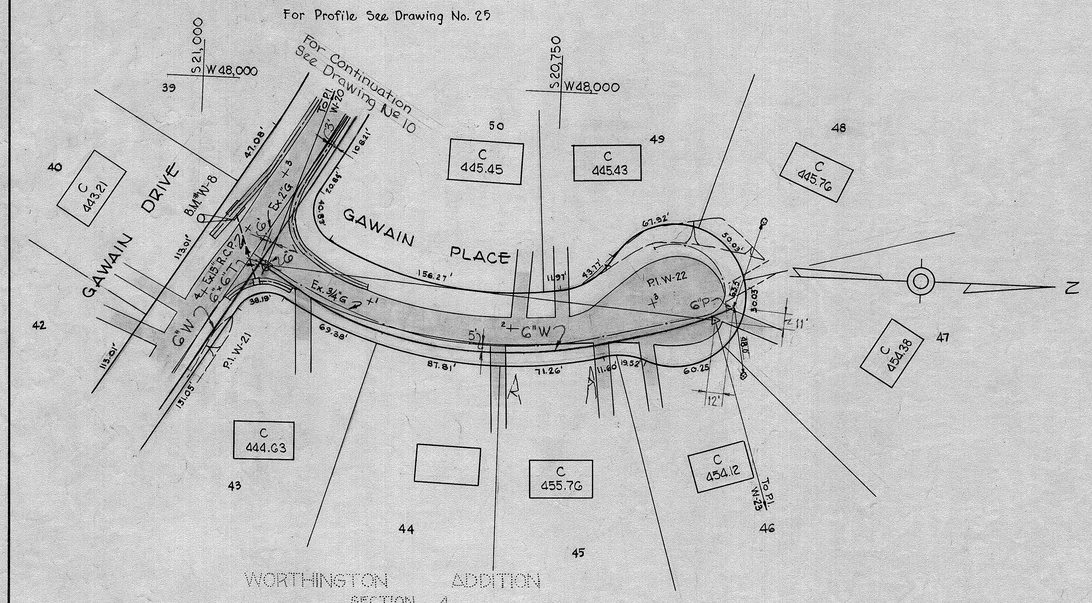


| | | | | | | |
|---|---|---|---|---|---|---|
| WHITMAN, REQUARDT & ASSOCIATES<br>ENGINEERS<br>1304 ST. PAUL ST.<br>BALTIMORE, MARYLAND | HOWARD COUNTY METROPOLITAN COMMISSION<br>8 Sept. 1963 (DATE) Carl W. Meyer (CHIEF ENGINEER) | CONTRACT NO. 64 W | PLAN OF WATER MAINS | ELLICOTT CITY SUB-DISTRICT | DRAWING NO. 11 OF 31 | SCALE 1"=50' |

Contract N° 64W

21 GW 32 & 33
225 W 32

FB 3049

W. O. 5318-2

AS BUILT 7 JAN. 1966

WS 64W/11

K. ELLIOTT CO., PITTSBURGH REORDER A-59070

MONTGOMERY ROAD
STATE ROUTE 103
W&A B.M.#14
W 6,500 S 25,000
For Continuation See Drawing Nº 3
BONNIE BRANCH ROAD
F.F.=49227 N.C.
W.R.&A. B.M. #B-1 Elev. 480.14
R.R. spike in base of Power Pole #170571, W.side Intersection Bonnie Branch Rd. & Bonnie Acres Rd.
Ex. 6"T.C.P.
Ex. 18"C.M.P.
Ex. 18"R.C.P.
Ex. 15"R.C.P.
Ex. 10"C.M.P.
B.M.#B-1
F.H. 5' F.H. TO VALVE
F.H. 10'x10' R/W 4' F.H. TO VALVE
PROPERTY OF RIEHL & WOODE INSURANCE AGENCY, INC.
PROPERTY OF STANLEY L. & VALETTA M. ROTH
Shrubs to be reset 5' from property line.
Tunnel Tree
Replace drain if disturbed
BONNIE ACRES ROAD
W 48,500 S 24,500
Match Line "H-1" See This Drawing
C 49393
C 478.04
C 482.82
C 465.33
C 457.87
C 457.09
C 451.63
C 479.61
C 471.82
1 2 3 4 5 6
W.R.&A. B.M. #B-3 Elev. 414.21
R.R. spike in base of 20" Maple, 18' Left of sta. 3+05. Between P.I. B-3 & P.I. B-4.
B.M.#B-3
P.I. B-4
P.I. B-3
C 531.2
C 398.7
For Continuation See Drawing Nº 13
For Profile See Drawing No. 27
BONNIE ACRES
W.R.&A. B.M.#B-2 Elev. 443.72
R.R. spike in base of Power Pole #170573, 15' Left of sta. 6+90, between P.I. B-2 & P.I. B-3.
C 427.19
C 440.06
C 442.11
B.M.#B-2
Ex. 12"C.M.P.
Ex. 15"C.M.P.
To P.I. 12"x8"R B-2
To P.I. B-3
Ex. 8"C.M.P.
Ex. 12"R.C.P.
HURST ROAD
17
7 8 9 16
W 48,000 S 24,250
For Continuation See Drawing Nº 13
Match Line "H-1" See This Drawing
P.O.T. 2+66
Ex. 24"C.M.P.
P.O.T. 11+17
CMP 23+71
P.I. 3-1
P.I. 3-2
PROPERTY OF BALTIMORE GAS AND ELECTRIC COMPANY
W 47,500 S 23,500
W 47,250 S 23,750
Approximate ℄ Transmission Line
Contract Nº 64 W

| | | | | | | |
|---|---|---|---|---|---|---|
| WHITMAN, REQUARDT & ASSOCIATES<br>ENGINEERS<br>1304 ST. PAUL ST.<br>BALTIMORE, MARYLAND | HOWARD COUNTY METROPOLITAN COMMISSION<br>6 Sept. 1963 DATE<br>Carl W. Mayer CHIEF ENGINEER | CONTRACT NO. 64 W | PLAN OF WATER MAINS | ELLICOTT CITY SUB-DISTRICT | DRAWING NO. 12 OF 31 | SCALE 1"=50' |

W. O. 5318-2

AS BUILT 17 JAN. 1966

F.B. 5017, 5031

WS 64W/12

K. ELLIOTT CO., PITTSBURGH REORDER A-39070

BONNIE BRANCH ROAD

C 465.33

B.M.#B-1

8"W 47' 8"G"T 3'

Tunnel Tree

101.18' 39.27' 109.92' 81.04'

6"V

5'

C 179.61

For Continuation See Drawing No. 12

6"W

175.00'

178.00'

BONNIE ACRES ROAD

125.00'

100.00'

5'

C 475.71

C 475.03

C 466.17

2

1

3

8

9

10

11

12

13

14

15

16

17

18

19

20

21

BONNIE ACRES

C 471.25

C 466.74

C 457.04

C 458.76

C 460.50

C 457.39

C 448.68

22

23

4

5

6

7

FH

31.04'

100.00'

6"BD

Ex. 18" C.M.P

6"GT

8'

5'

6"W

122.00'

121.00'

119.20'

117.80'

103.85'

12.16'

For Profile See Drawing No. 27

W 48.500 S 24.500

For Continuation See Drawing No. 14

ELLICOTT CITY SUB-DISTRICT

DORSEY SUB-DISTRICT

FONT ROAD

ILCHESTER ROAD

Pl. F-1

Pl. F-2

Pl. F-3

B.M.#F-1

6"W

6"x6"T

6"P

To Pl. Spur #1

F.H.

5'

5'

530'

520'

24'

30'

194'

For Profile See Drawing No. 28

S 25.750 W 48.250

C 451.51

C 457.17

C 454.65

C 449.14

FONT AVE.

FONT HILL

C 442.19

C 440.06

BONNIE BRANCH ROAD

Ex. 15" C.M.P

B.M.#B-2

Pl. B-3

To P.I. B-2

10"x8"R

12"x8"R

7'

6"x6"T 8"W

Ex. 12" C.M.P

8"V

12"V

F.H.

100.00'

108.82'

Ex. 15" C.M.P

12"x12"T

To Pl. B-4

5'

3'

12"W

130.00'

HURST ROAD

110.00'

105.85'

34.98'

105.26'

125.00'

5'

C 442.11

C 432.05

C 423.97

For Continuation See Drawing No. 12

W 43.000 S 24.500

W 43.750 S 24.250

Ex. 24" C.M.P

PROPERTY OF TALBOTT LUMBER CO.

For Continuation See This Drawing

For Profile See Drawing No. 28

For Continuation See This Drawing

HURST ROAD

12"W

125.00'

165.26'

BONNIE ACRES

FH

Ex. 18" C.M.P

12"x6"T

Ex. 24" C.M.P

182.51'

Conc. Encase C+40 to C+70

PROPERTY OF TALBOTT LUMBER CO.

BONNIE ACRES

20' Construction Strip

10' Right of Way 20

182.53'

275.04'

P.I. Curve

Δ = 18° 08' 20"

T = 44.71

R = 280.09

L = 88.67

C = 88.30

℄ Transmission Line

44.71'

284.79'

Tower No. 2

PROPERTY OF BALTIMORE GAS & ELECTRIC COMPANY

323.52'

W 47.250 S 24.750

20' Construction Strip

10' Right of Way

PROPERTY OF HENRY R. & BETTY J. WEHLAND

PROPERTY OF THEODORE C. & MARIE H. MATTHEISS

C. 441.15

204.80'

545.20'

For Continuation See Drawing No. 14

175.00'

140.00'

2' 8"W 12"x8"R 8"V 12"x12"T Ex. 12" C.M.P

170.00'

125.00'

ILCHESTER ROAD

12"W

2'

Contract No. 64 W

| | | | | | | |
|---|---|---|---|---|---|---|
| WHITMAN, REQUARDT & ASSOCIATES<br>ENGINEERS<br>1304 ST. PAUL ST.<br>BALTIMORE, MARYLAND | HOWARD COUNTY METROPOLITAN COMMISSION<br>6 Sept. 1963 DATE<br>Carl W. Meyer CHIEF ENGINEER | CONTRACT NO. 64 W | PLAN OF WATER MAINS | ELLICOTT CITY SUB-DISTRICT | DRAWING NO. 13 OF 31 | SCALE 1"=50' |

25 GW 32 33
26 SW 32 33
21 SW 33

F.B. 3020, 3091

W. O. 5318-Z

AS BUILT 7 JAN. 1966

WS 64W/13

ELLIOTT CO., PITTSBURGH REORDER A-39070

MONTGOMERY ROAD (STATE ROUTE 103)

W.R. & A. B.M. "M13 Elev. 481.40
2 R. Spike base of G.F.E. Pole #208393
@ Intersection Montgomery Rd & Ilchester Rd.

ILCHESTER ROAD

W.R. & A. B.M.#F-1 Elev. 457.72
R.R. spike in base of Power Pole #241698,
25' Lef of sta. 4+60. Between P.I. F-2 & P.I. F-3
@ Intersection Ilchester Road & Font Road.

FONT ROAD

Match Line "I-I" See This Drawing

For Continuation See Drawing No 3

PROPERTY OF GEORGE W. & OTTILIE I. BECK

ELLICOTT CITY SUB-DISTRICT

DORSEY SUB-DISTRICT

For Profile See Drawing No. 28

For Continuation See Drawing No 13

PROPERTY OF LILLIAN S. TYLER & KENNETH B. TYLER

DIVISION VALVE KEEP CLOSED

W.R. & A. B.M.#F-2 Elev 471.23
R.R. spike in base of Power Pole #101320, N. side of intersection Ilchester Road & Kerger Road

KERGER ROAD

KERGER ROAD SUBDIVISION

Match Line "P-P" See This Drawing

Contract No 64 W

| | | | | | | |
|---|---|---|---|---|---|---|
| WHITMAN, REQUARDT & ASSOCIATES ENGINEERS 1304 ST. PAUL ST. BALTIMORE, MARYLAND | HOWARD COUNTY METROPOLITAN COMMISSION 6 Sept 1963 DATE — Carl W. Meyer CHIEF ENGINEER | CONTRACT NO. 64 W | PLAN OF WATER MAINS | ELLICOTT CITY SUB-DISTRICT | DRAWING NO. 14 OF 31 | SCALE 1" = 50' — 25 SW 32, 26 SW 32, 33 |

W. O. 5318-2 — WRA & AS BUILT 5/22/23 — AS BUILT 7 JAN. 66 — PB 3020, 3031, 2990

WS 64W/14

WATERLOO ROAD

STATE ROUTE 175

SUNSET AVE.

GROVE ROAD

MONTGOMERY ROAD

Match Line "J-J" See This Drawing

Match Line "K-K" See Drawing No 16

For Continuation See Drawing No 2

For Continuation See Drawing No 17

For Continuation See Drawing No 19

For Profile See Drawing No. 29

W.D. & A. B.M. #A-2 Elev. 476.40
P.P. Spike in base of P. Pole. G. & E.
# 253850 East side Waterloo Road;
590'± South of ℄ Sunset Avenue.

W.D. & A. B.M. #A-1 Elev. 490.11
P.P. Spike in base of P. Pole. -G. & E.
#253843 East of Intersection Waterloo Road & Grove Road.

| | | | | | | |
|---|---|---|---|---|---|---|
| WHITMAN, REQUARDT & ASSOCIATES ENGINEERS 1304 ST. PAUL ST. BALTIMORE, MARYLAND | HOWARD COUNTY METROPOLITAN COMMISSION 6 Sept. 1963 DATE — Carl W. Mayer CHIEF ENGINEER | CONTRACT NO. 64 W | PLAN OF WATER MAINS | ELLICOTT CITY SUB-DISTRICT | DRAWING NO. 15 OF 31 | SCALE 1"=50' |

Contract № 64 W

W. O. 5318-2

AS BUILT 7 JAN. 1966

WS 64W/15

Match Line "L-1" See This Drawing

Ex.18"CMP

5'

12"W Ex.24" RCP

12"V

W.R. & A. B.M. #A-3

GLENMAR ROAD

6"V

6"W

Conc. Walk

Ex. 6"G

WATERLOO

Ex.8"TCP

W 58.000 S 25.750

W 53.000 S 26.000

C 488.78

C 484.16

C 476.5

C 470.8

C 470.93

ROAD

Match Line "L-2" See Drawing No. 13

12"W Ex.6"G

Ex.6"G

6"V

FH

2' FH TO VALVE

Ex.24" RCP

12"G

5'

175

STATE ROUTE

For Continuation See Drawing No. 20

W.R. & A. B.M. #A-3 Elev. 503.72
P.K. Spike in base of P. Pole G.& E.
#293891 East side Waterloo Road; 145'± South of ℄ Glenmar Road.

For Profile See Drawing No. 29

W.R. & A. B.M. #A-4 Elev. 513.78
P.K. Spike in base of P. Pole G.& E.
#63442 West side Waterloo Road; 450'± South of ℄ Elko Drive.

W.R. & A. B.M. #A-4

C 498.00

W 53.250 S 26.250

ROAD

C 505.7

C 503.4

C 498.4

Ex.12"CMP

Match Line "L-1" See This Drawing

12"W Ex.6"G

12"x8"T

Ex.18"CMP

8"V

DRIVE

ELKO

C 508.0

FF 502.5 N.C.

FF 502.60 N.C.

FF 506.0 N.C.

W 54.250 S 26.750

Proposed Oil Line

Similar Oil Line

WATERLOO

10'

2' FH TO VALVE

F.H.

6"V

12"x6"T

Ex.12"CMP

STATE ROUTE

C 511.49

C 508.75

175

For Continuation See Drawing No. 20

Ex.24"RCP

Match Line "M-1" See This Drawing

W 53.750 S 26.750

For Continuation See Drawing No. 22

OLD ANNAPOLIS ROAD

Top Inlet

5'

12"W

Match Line "M-1" See This Drawing

12"V

23.5'

6"x12"T

55'

12"V

P.I. A.S.=10

Ex.18"CMP

W 54.250 S 27.250

WATERLOO ROAD

For Continuation See Drawing No. 16

| | | | | | | |
|---|---|---|---|---|---|---|
| WHITMAN, REQUARDT & ASSOCIATES<br>ENGINEERS<br>1304 ST. PAUL ST.<br>BALTIMORE, MARYLAND | HOWARD COUNTY METROPOLITAN COMMISSION<br>6 Sept. 1963 DATE<br>Carl W. Mayer CHIEF ENGINEER | CONTRACT NO. 64 W | PLAN OF<br>WATER MAINS | ELLICOTT CITY SUB-DISTRICT | DRAWING NO. 16 OF 31 | SCALE 1"=50' |

Contract No. 64 W

W. O. 5318-2

AS BUILT 27 JAN. 1966

WS 64W/16

ELLIOTT CO., PITTSBURGH REORDER A-39070

VALLEY VIEW

JOPENDA DRIVE

For Continuation See This Drawing

For Continuation See Drawing No. 18

WEST GROVE ROAD

For Profile See Drawing No. 30

W.R. & A. B.M. #A-5

Ex. 18" C.M.P.

Ex. 12" C.M.P.

Pl. K-1

Pl. K-2

Pl. K-7

G"V 4.0' VALUE TO POLE

8"W

8"XG"T

8"G"T

8"S"B

10'x10' R/W

F.H. 2' FH TO VALUE

PROPERTY OF ROMAN W. & CATHERINE C. HNAT

POT. 2+98.28

GROVE ANGLE ROAD

Ex. 24" C.M.P.

10'x10' R/W

2' FH TO VALUE

W.R. & A. B.M. #A-8

PROPERTY OF JOHN J. DOYLE AND MARGARET M. DOYLE

W.R. & A. B.M. #A-6 Elev. 451.50
R.R. Spike in base of C. & P. Pole #5 @ S.E. Corner Intersection of Jopenda Drive & Jopenda Drive

W.R. & A. B.M. #A-8 Elev. 455.95
R.R. Spike in base of G. & E. Pole #253356 on E. side of Grove Angle Road, 375'± N. of ℄ West Grove Road

W.R. & A. B.M. #A-5 Elev. 460.60
R.R. Spike in base of G. & E. Pole #214334 @ Intersection Grove Angle Road & Jopenda Drive

JOPENDA DRIVE

Reserved

GROVE ANGLE ROAD

For Continuation See Drawing No. 17

WATERLOO ROAD STATE ROUTE 175

For Continuation See Drawing No. 15

Ex. 6"G

P.I. A-2

12"W 12"x8"T

W.R. & A. B.M. #A-6

Ex. 18" C.M.P.

6"x2" Tapped T F.H.

VALLEY VIEW

For Profile See Drawing No. 31

N

S 23,250 W 52,500

S 23,750 W 52,250

S 23,750 W 53,750

N 33,500 S 24,000

| | | | | | | |
|---|---|---|---|---|---|---|
| WHITMAN, REQUARDT & ASSOCIATES ENGINEERS 1304 ST. PAUL ST. BALTIMORE, MARYLAND | HOWARD COUNTY METROPOLITAN COMMISSION 6 Sept 1963 DATE — Carl W. Meyers CHIEF ENGINEER | CONTRACT NO. 64 W | PLAN OF WATER MAINS | ELLICOTT CITY SUB-DISTRICT | DRAWING NO. 17 OF 31 | SCALE 1"=50' |

Contract No. 64 W

25 SW 357 SC
24 SW 356 SC
25 SW SC

W. O. 5318-2

AS BUILT 7 JAN. 1966

FB 3034

WS 64W/17

C. ELLICOTT CO., PITTSBURGH REORDER A-39070

JOPENDA DRIVE

WEST GROVE ROAD

GROVE ANGLE ROAD

WATERLOO ROAD STATE ROUTE 175

VALLEY VIEW

B.M. For Constr. W.R.&A. BM "A-5 Ex 18"CMP 100.0

WR&A BM "A-C" Elev 451.50
RR Spike in base of C&P Pole #5 @ S.E. Corner Intersection of Jopenda Drive & Jopenda Drive

WR&A BM "A-8" Elev 455.95
RR Spike in base of G&E Pole #253356 on E side of Grove Angle Road, 375' N of ℄ West Grove Road

WR&A BM "A-5" Elev 460.60
RR Spike in base of G&E Pole #214334 @ Intersection Grove Angle Road & Jopenda Drive

PROPERTY OF ROMAN W & CATHERINE C. NIJAT

PROPERTY OF JOHN J DOYLE AND MARGARET M. DOYLE

For Profile See Drawing No. 30

For Profile See Drawing No. 31

## GENERAL NOTES

1. Maintain 3'-6" minimum cover over proposed water mains.
2. Strap proposed hydrant to main.
3. All construction to conform to standard specifications.
4. Approx. location of exist utilities are shown. Maintain uninterrupted service and repair all damage incurred immediately.
5. All pipe elevations shown are invert elevations unless noted.
6. Clear all utilities by 6" min. and all leaks by 2'-0" min.
7. Notify "Miss Utility" at 559-0100 for existing utilities locations.
8. Place regulation "MEN WORKING" signs as required.

8"x6" F.H.T. - 2' plug & Buttress

30' R/W (prescription)

Proposed 8"x6' F.H.T & plug.
Proposed 6"V
Proposed 4.5' F.H. Bury Line Elev. 454.0
existing fence along R/W

Exist 8"D

Exist. 8"W

Remove existing 8" plug and buttress.

Proposed 60 L.F. - 8" Water extension to be constructed under Cont. 64 W

PROFILE OF ADDITIONAL CONSTRUCTION
Scale: Horiz. 1"=50'
Vert. 1"=5'

Exist grnd over 8"W.

0+00 452.1
0+20 451.2
0+40 450.3
0+60 449.3 8"x6"FHT & 8" plug.

Exist 6+00: 452.8

Exist 8"W (Cont 64 W)

60 LF Prop. 8"W (Cont 64 W)

460 / 455 / 450 / 445

Approved for additional construction
DEPARTMENT OF PUBLIC WORKS
HOWARD COUNTY, MARYLAND

T. J. Regan Jr. P.E. No 9844 — Date 10-26-77
DIRECTOR OF PUBLIC WORKS

W. O. Filbert P.E. No 5901 — Date 10-25-77
CHIEF - BUREAU OF ENGINEERING

WHITMAN, REQUARDT & ASSOCIATES
ENGINEERS
1304 ST. PAUL ST.
BALTIMORE, MARYLAND

HOWARD COUNTY METROPOLITAN COMMISSION
6 Sept 1963 — DATE
W. O. Filbert 8-1-77 — CHIEF ENGINEER

ADDITION TO CONTRACT NO. 64 W

PLAN OF WATER MAINS

ELLICOTT CITY SUB-DISTRICT

DRAWING NO. 17-A OF 31

SCALE 1"=50'

23 SW 357 SG
24 SW 356 SG
25 SW 36

FB 3034

Contract No 64 W

W. O. 5318-2

WS 64W/17A

For Continuation See Drawing No. 17

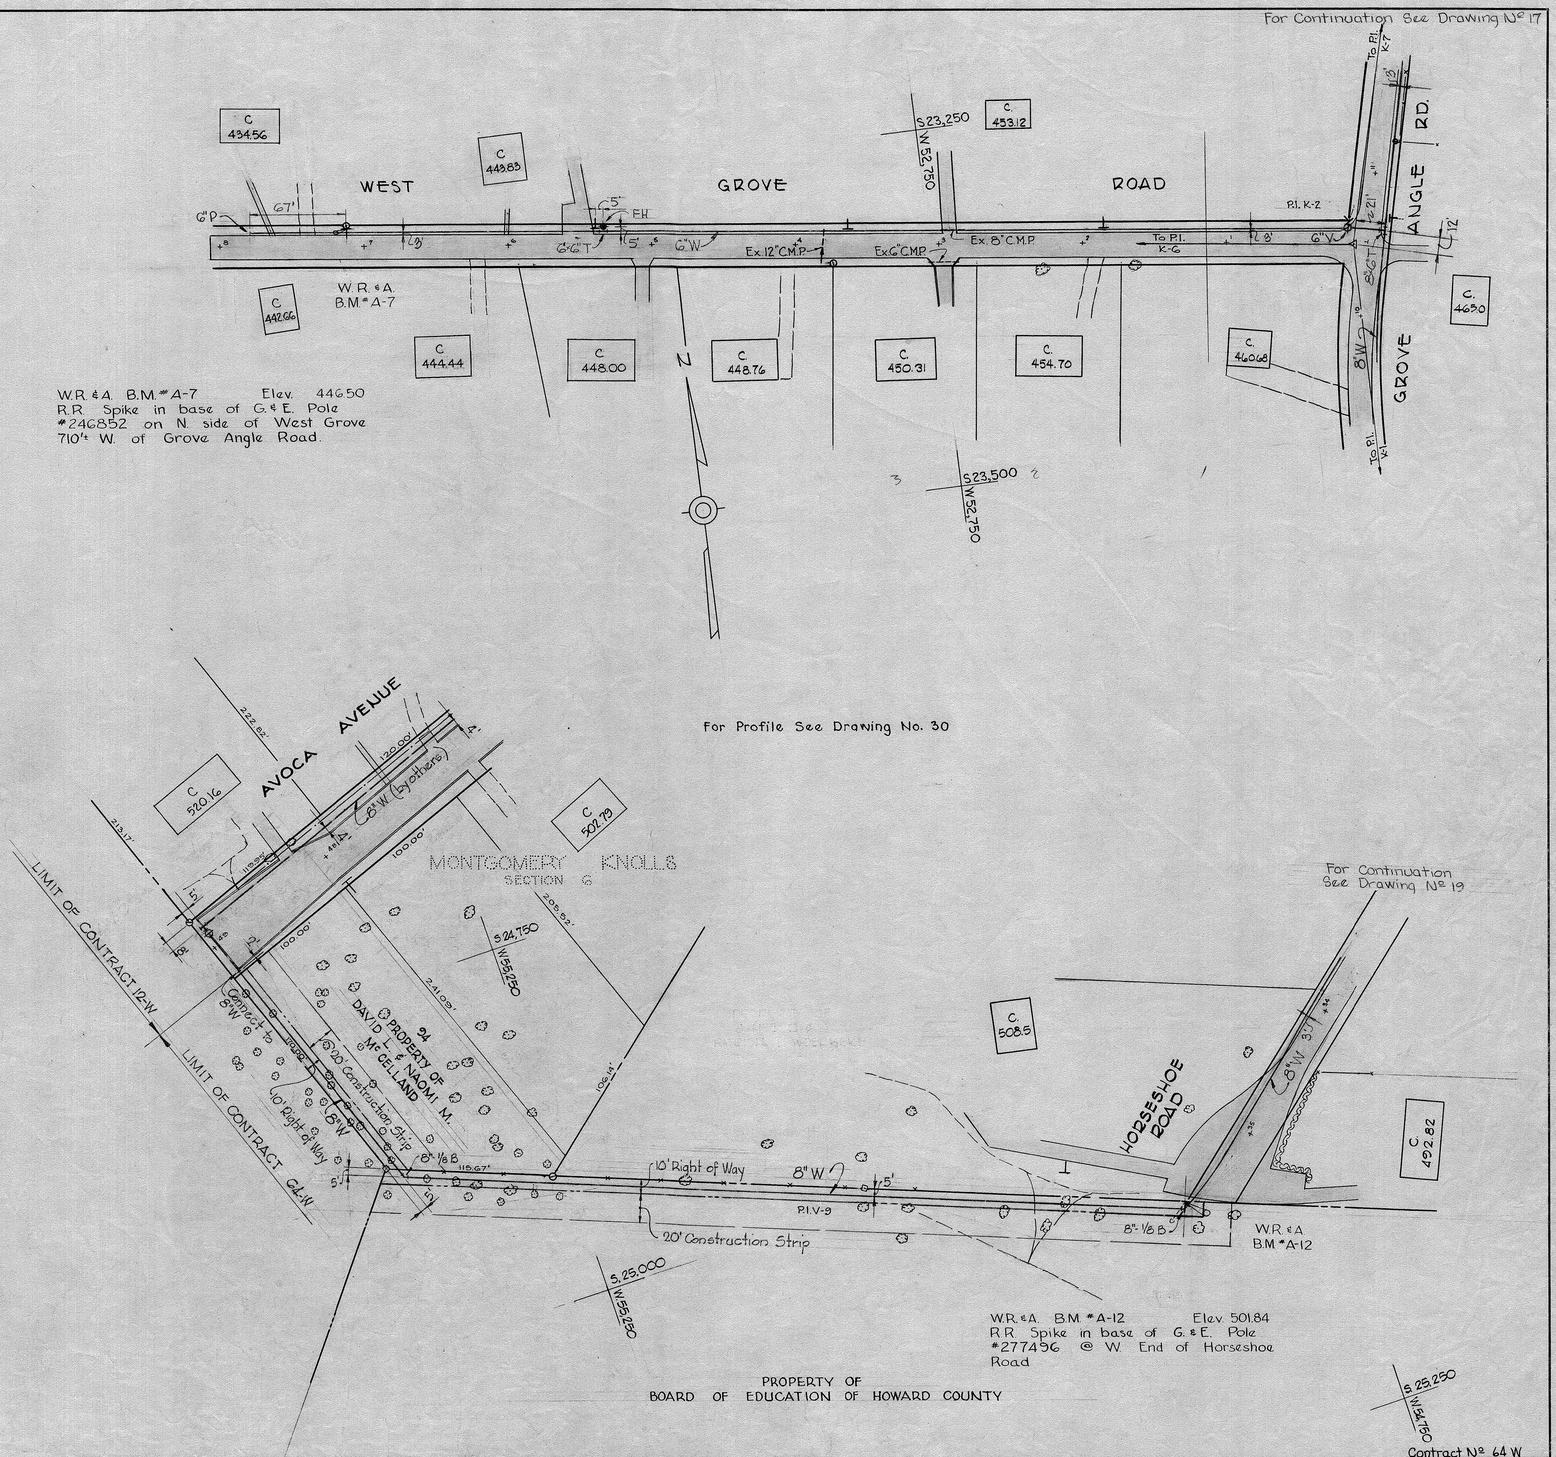


| | | | | | | |
|---|---|---|---|---|---|---|
| WHITMAN, REQUARDT & ASSOCIATES ENGINEERS 1304 ST. PAUL ST. BALTIMORE, MARYLAND | HOWARD COUNTY METROPOLITAN COMMISSION 6 Sept. 1963 DATE — Carl W. Mayer CHIEF ENGINEER | CONTRACT NO. 64 W | PLAN OF WATER MAINS | ELLICOTT CITY SUB-DISTRICT | DRAWING NO. 18 OF 31 | SCALE 1"=50' |

W. O. 5318-2

AS BUILT 17 JAN. 1966

WS 64W/18

ELLIOTT CO., PITTSBURGH REORDER A-39070

For Continuation See This Drawing

HORSESHOE ROAD

To P.I. V-4

Ex. 12" R.C.P.

C 459.38

8"V

8"x8" B

F.F. 471.72 N.C.

36'

10'

1'

36'

SUNSET AVENUE

C 472.40

C 476.55

C 482.53

C 496.6

W 52.500 S 24.500

8"W

Ex. 12" R.C.P.

F.H.

6"V

8"x6"T

2'

100'

Ex. 12" CMP

Garage

W.R. & A. B.M. #A-9

P.I. V-1

25'

8"-1/8 B

60'

74.5'

WATERLOO ROAD

P.I. A2-3

8"V

12"V

Ex. 6" G.P.

12"W

35'

W 53.000 S 25.500

W.R. & A. B.M. #A-9 Elev. 492.35
R.R. Spike in base of G & E. Pole #215288 on E. side of Sunset Ave., 250' S. of Waterloo Road.

For Profile See Drawing No. 30

For Continuation See Drawing No. 15

STATE ROUTE 175

For Continuation See This Drawing

C 455.56

F.F. 465.31 N.C.

8"x6" Fire hydrant Tee + 6" valve

8" Waterline

SMH 1A 8" Sewer

C 459.38

SUNSET AVE.

W.R. & A. B.M. #A-11 Elev. 453.10
R.R. Spike in base of Power Pole (No Number) on N. side of Horseshoe Road, 1100'± W. of ℄ Sunset Ave.

PROPERTY OF CHARLES W. & LUCY L. CUNNINGHAM

W.R. & A. B.M. #A-11

C 453.55

10-10" RW

F.H.

6"V

8"x6"T

8"W

Ex. 36" R.C.P.

HORSESHOE ROAD

F.H.

6"V

8"x6"T

8"W

To P.I. V-4

Ex. 12" R.C.P.

8"V

8"-1/8 B

P.I. V-3

10'

36'

W.R. & A. B.M. #A-10

FOR UPDATED UTILITIES SEE ACRA PROPERTIES CONTRACT # SDP-19-016

S 24.500 W 54.000

C 466.53

Match Line "N-N" See This Drawing

C 450.70

C 464.98

C 465.30

S 25.250 W 53.250

F.F. 471.72 N.C.

W.R. & A. B.M. #A-10 Elev. 466.72
R.R. Spike in base of G & E. Pole #215291 on S side of Horseshoe Road, 90'± W. of ℄ Sunset Ave.

SMH 1A 8" Sewer 24' 22' 6" Sewer 33'

TWMC 9' SMH 24' TWMC 1B

F.F. 473.34 N.C.

For Continuation See Drawing No. 18

C 508.5

10' Right of Way

20' Construction Strip

8"W

8"-1/8 B

PROPERTY OF BOARD OF EDUCATION OF HOWARD COUNTY

W.R. & A. B.M. #A-12 Elev. 501.84
R.R. Spike in base of G & E. Pole #277496 @ W. End of Horseshoe Road.

W 55.000 S 25.250

PROPERTY OF JAMES D. & PATRICIA L. WOERNBKE

W.R. & A. B.M. #A-12

C 488.12

F.F. 483.3 N.C.

HORSESHOE ROAD

F.H. R/W

F.H.

6"V

8"x6"T

8"W

S 24.750 W 54.500

To P.I. V-6

P.I. V-6

8"V

8"-1/8 B

10' x 7" To P.I. V-5

Match Line "N-N" See This Drawing

C 452.82

C 491.52

C 488.39

C 473.06

Contract No. 64 W

| | | | | | | |
|---|---|---|---|---|---|---|
| WHITMAN, REQUARDT & ASSOCIATES ENGINEERS 1304 ST. PAUL ST. BALTIMORE, MARYLAND | HOWARD COUNTY METROPOLITAN COMMISSION 6 Sept. 1963 DATE — Carl W. Meyer CHIEF ENGINEER | CONTRACT NO. 64 W | PLAN OF WATER MAINS | ELLICOTT CITY SUB-DISTRICT | DRAWING NO. 19 OF 31 | SCALE 1"=50' |

25 SW 35 36 47 37 26 SW 36

FB 3017

W. O. 5318-2

AS BUILT 17 JAN. 1966

WS 64W/19

E. C. ELLIOTT CO., PITTSBURGH REORDER A-39070

STATE ROUTE 175

For Continuation See Drawing No. 16

Ex. 24" RCP

Ex. 12"W

Ex. GG

12"GT

12"W

5'

12'

6"V

GV

ROAD

W 33,000

S 26,000

Abandonment of 6"W at main

6" Valve

Cone Walk

NEW 6" VALVE

WATERLOO

55.00'

33.27'

Church

FF 499.88 N.C.

C 503.16

Garage

22

Ex. 12"G

GW

Macadam Parking Lot

G 1/8

Gravel Parking Lot

W.R. & A. B.M.= A-13
R.R. Spike in base of 14" Locust on N. side of Glenmar Road @ End of Paving.

PIE 3

6"P

46'

30'

6"W

6"GT

FH

12"

5'

103'

ROAD

C 4605

C 4644

to PIE 4

14

15

FF 481.8 N.C.

W 52,500

S 26,250

C 503.20

C 503.24

20

GLENMAR

PIE 2

C 495.4

16

17

18

19

GLENMAR

For Profile See Drawing No. 31

For Continuation See Drawing No. 16

STATE ROUTE 175

12"GT

12"W

Ex. 6"G

5'

ROAD

1

2

3

4

5

6

7

8

W 26,500

S W 53,000

Barn

C 510.58

C 472.9

C 473.04

C 467.1

PIE 5

ELKO

DRIVE

SUNDERLAND

GLENMAR

WATERLOO

56

57

58

59

60

61

68

69

70

C 510.59

C 508.5

FF 511.3 N.C.

C 488.3

C 488.3

C 488.3

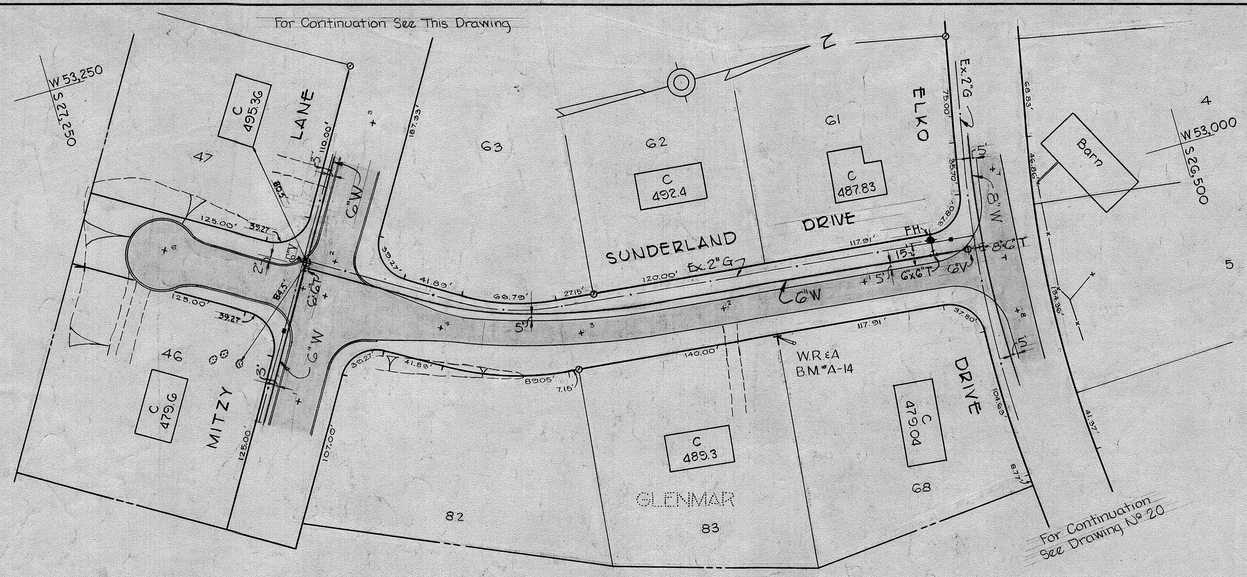


For Profile See Drawing No. 31

W.R.&A. B.M. "A-14 Elev. 491.14'
R.R. Spike in base of G&E. Pole
#284503 on E. side of Sunderland
Drive 160'± S. of Elko Drive

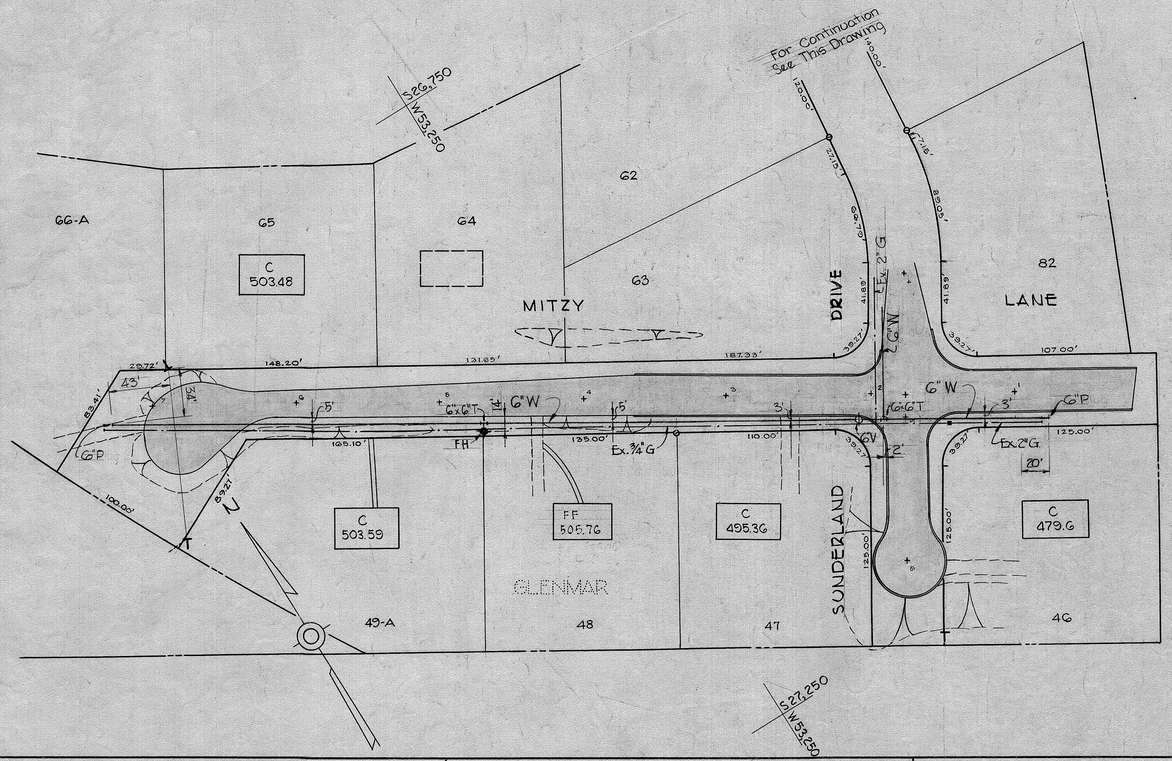


| | | | | | | |
|---|---|---|---|---|---|---|
| WHITMAN, REQUARDT & ASSOCIATES<br>ENGINEERS<br>1304 ST. PAUL ST.<br>BALTIMORE, MARYLAND | HOWARD COUNTY METROPOLITAN COMMISSION<br>6 Sept. 1963 (DATE) Carl W. Mayer (CHIEF ENGINEER) | CONTRACT NO. 64 W | PLAN OF WATER MAINS | ELLICOTT CITY SUB-DISTRICT | DRAWING NO. 21 OF 31 | SCALE 1"=50' |

Contract Nº 64 W

27 (25 SW 3G)

PB 3038

W. O. 5318-2

AS BUILT 27 JAN 1966

WS 64W/21

ELLIOTT CO., PITTSBURGH REORDER A-38070

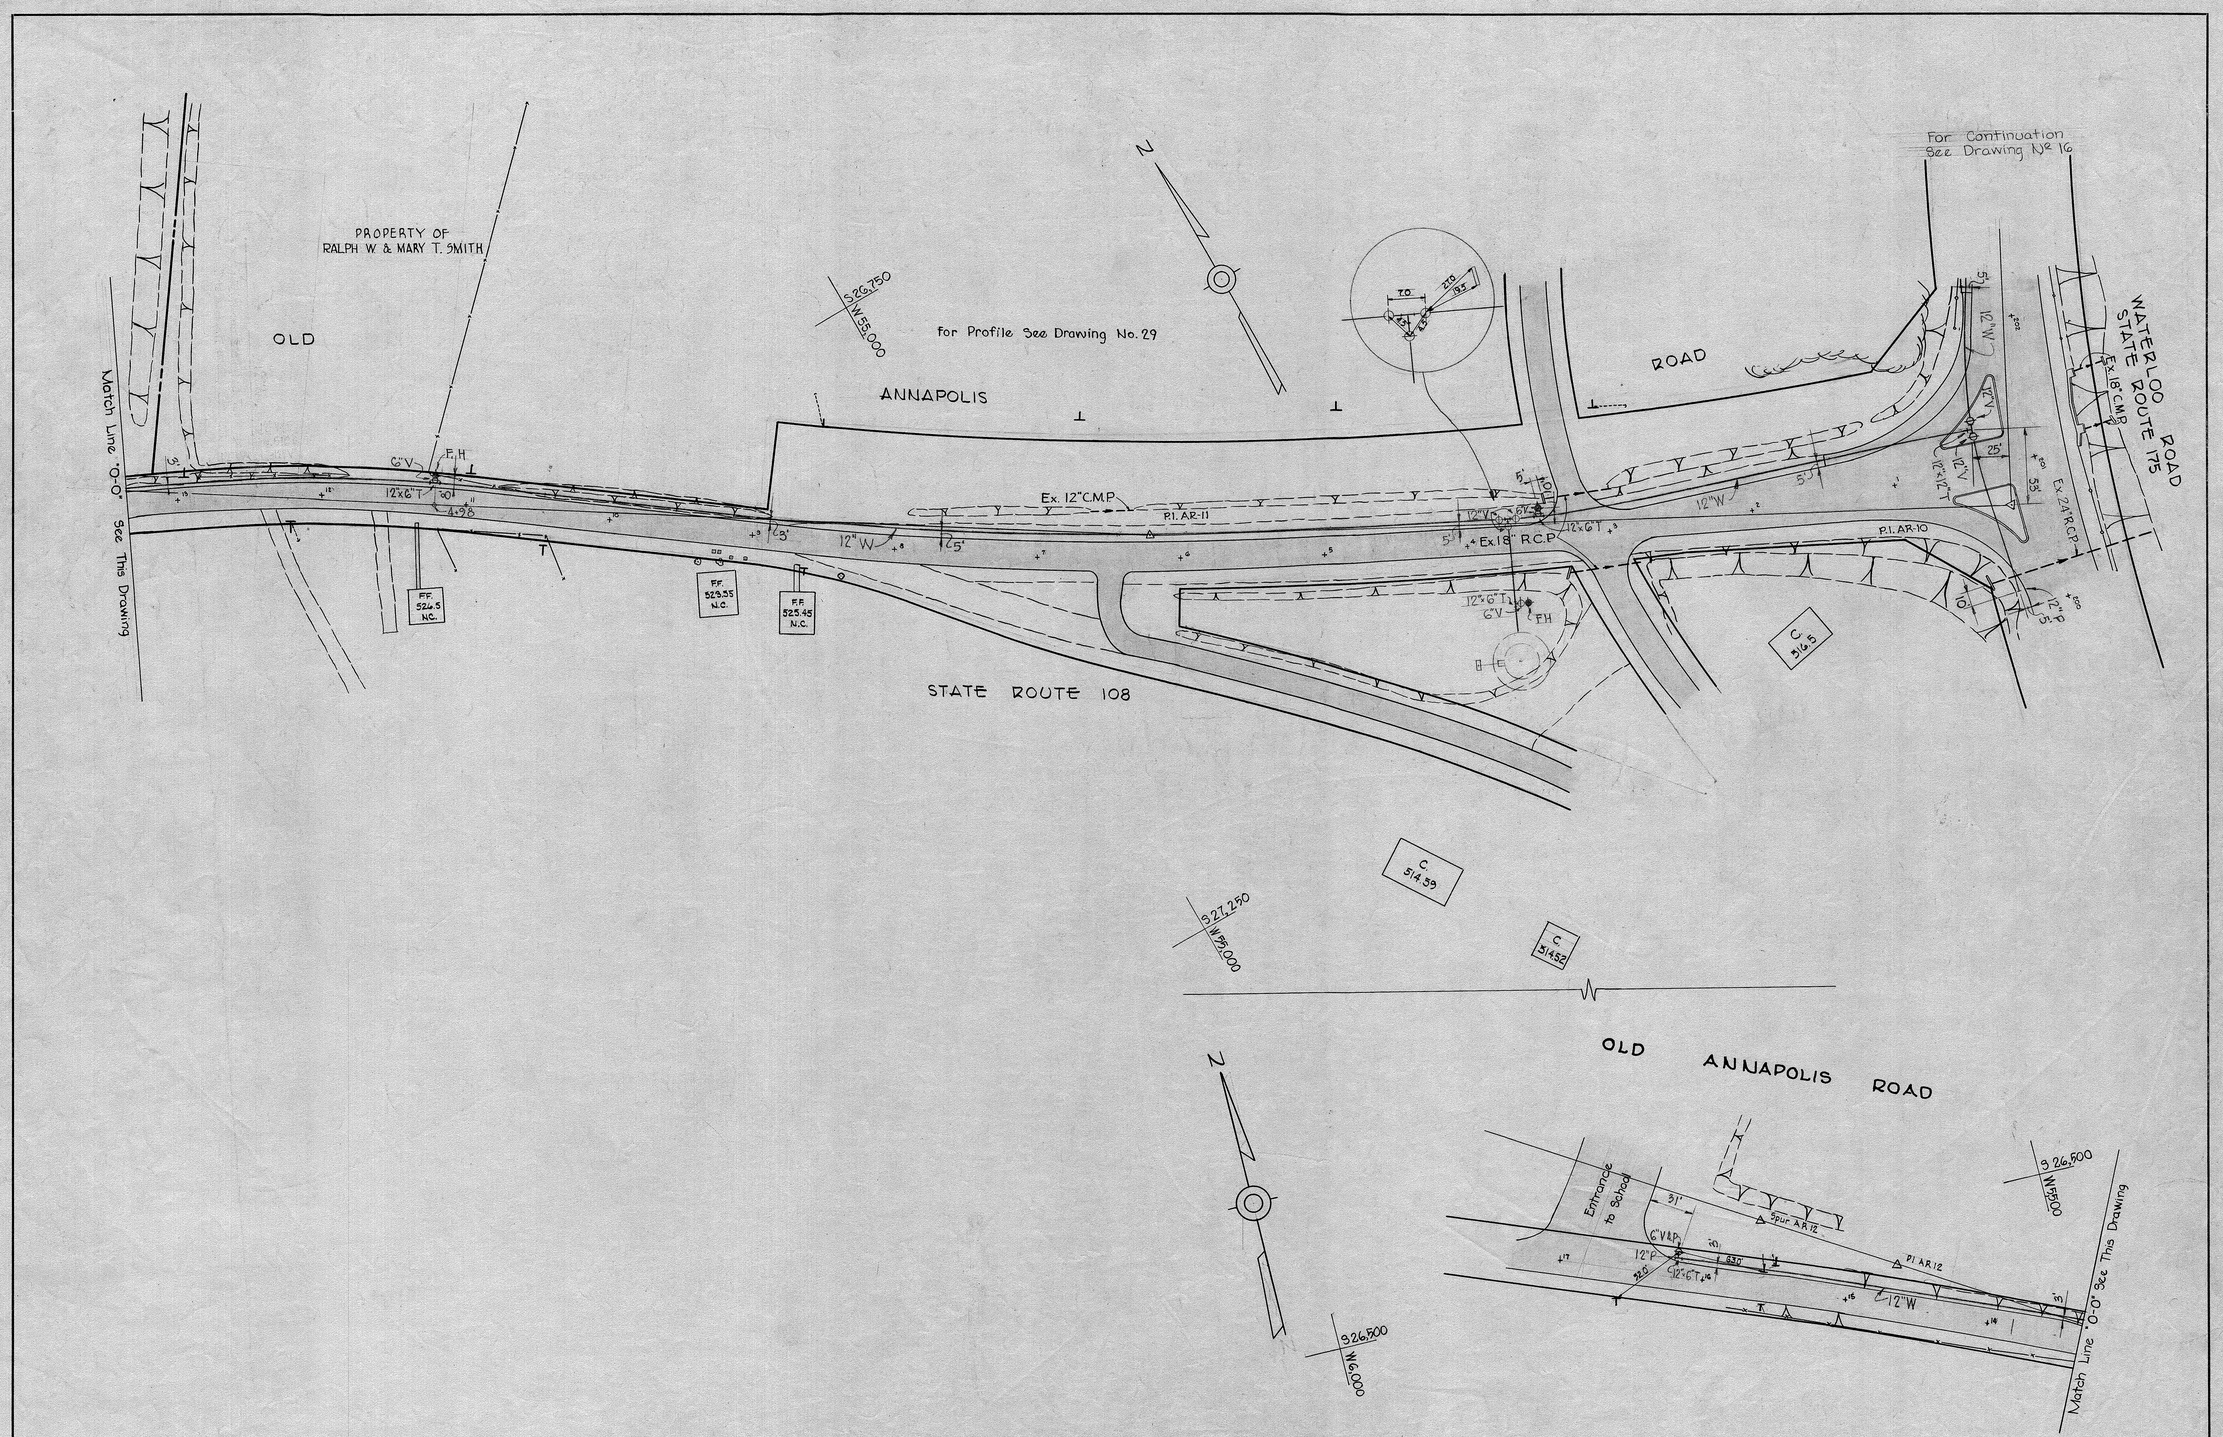


| | | | | | | | |
|---|---|---|---|---|---|---|---|
| WHITMAN, REQUARDT & ASSOCIATES<br>ENGINEERS<br>1304 ST. PAUL ST.<br>BALTIMORE, MARYLAND | HOWARD COUNTY METROPOLITAN COMMISSION<br>6 Sept. 1963 (DATE) Carl W. Meyer (CHIEF ENGINEER) | CONTRACT NO. 64 W | PLAN OF<br>WATER MAINS | ELLICOTT CITY SUB-DISTRICT | DRAWING NO. 22 OF 31 | SCALE 1"=50' | 27 28 29 N 87 |

Contract No. 64 W

W. O. 5318-2

AS BUILT 7 JAN. 1966

FB 3088

WS 64W/22

ELLIOTT CO., PITTSBURGH REORDER A-33070

## MONTGOMERY ROAD ~ STATE ROUTE #103

For Plan See Drawing No. 2 & 3

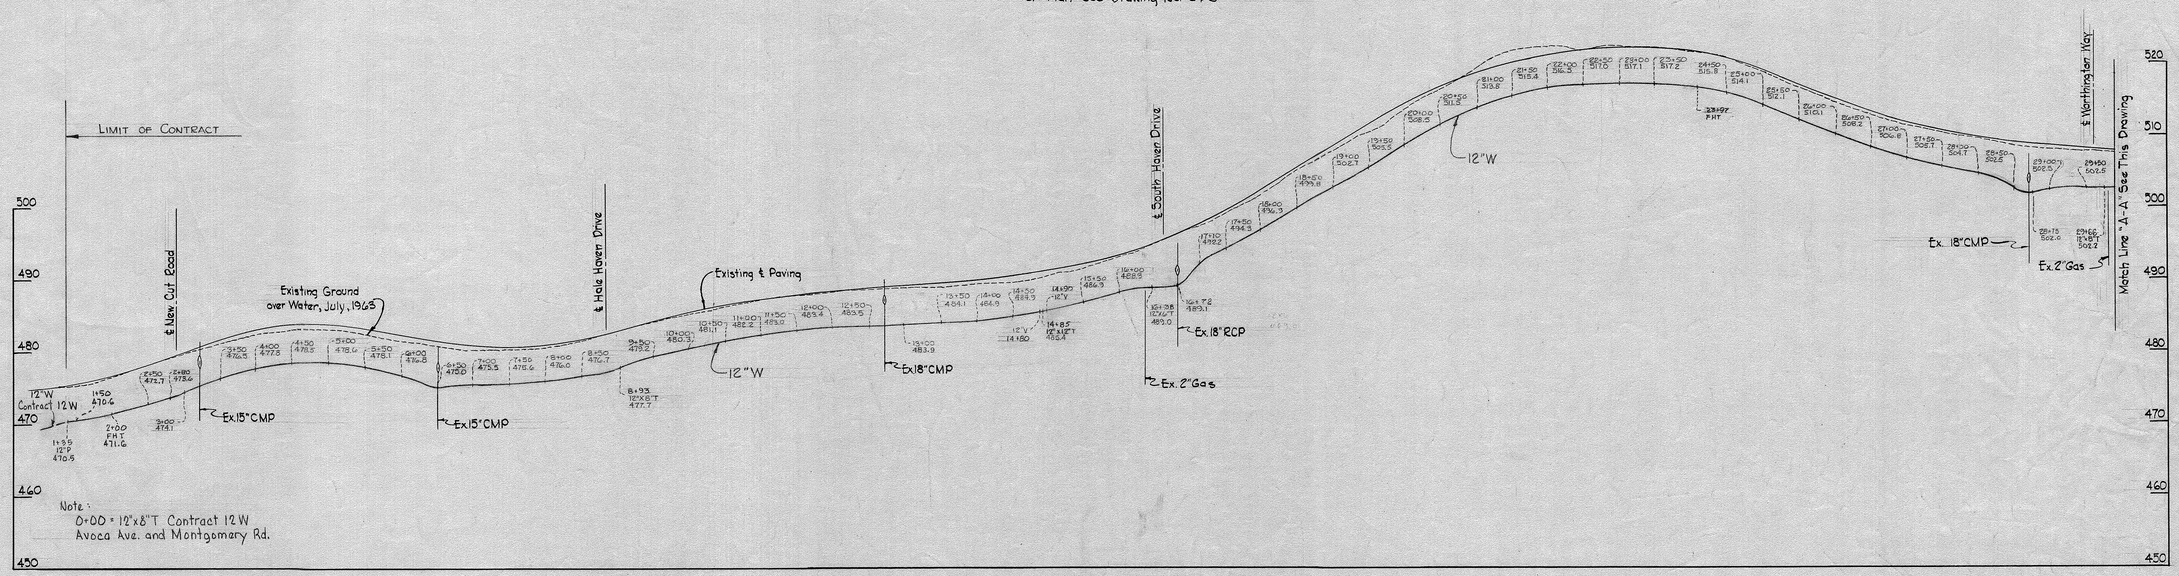


Note :
0+00 = 12"x8"T Contract 12 W
Avoca Ave. and Montgomery Rd.

## MONTGOMERY ROAD ~ STATE ROUTE #103

for Plan See Drawing No. 2 & 3

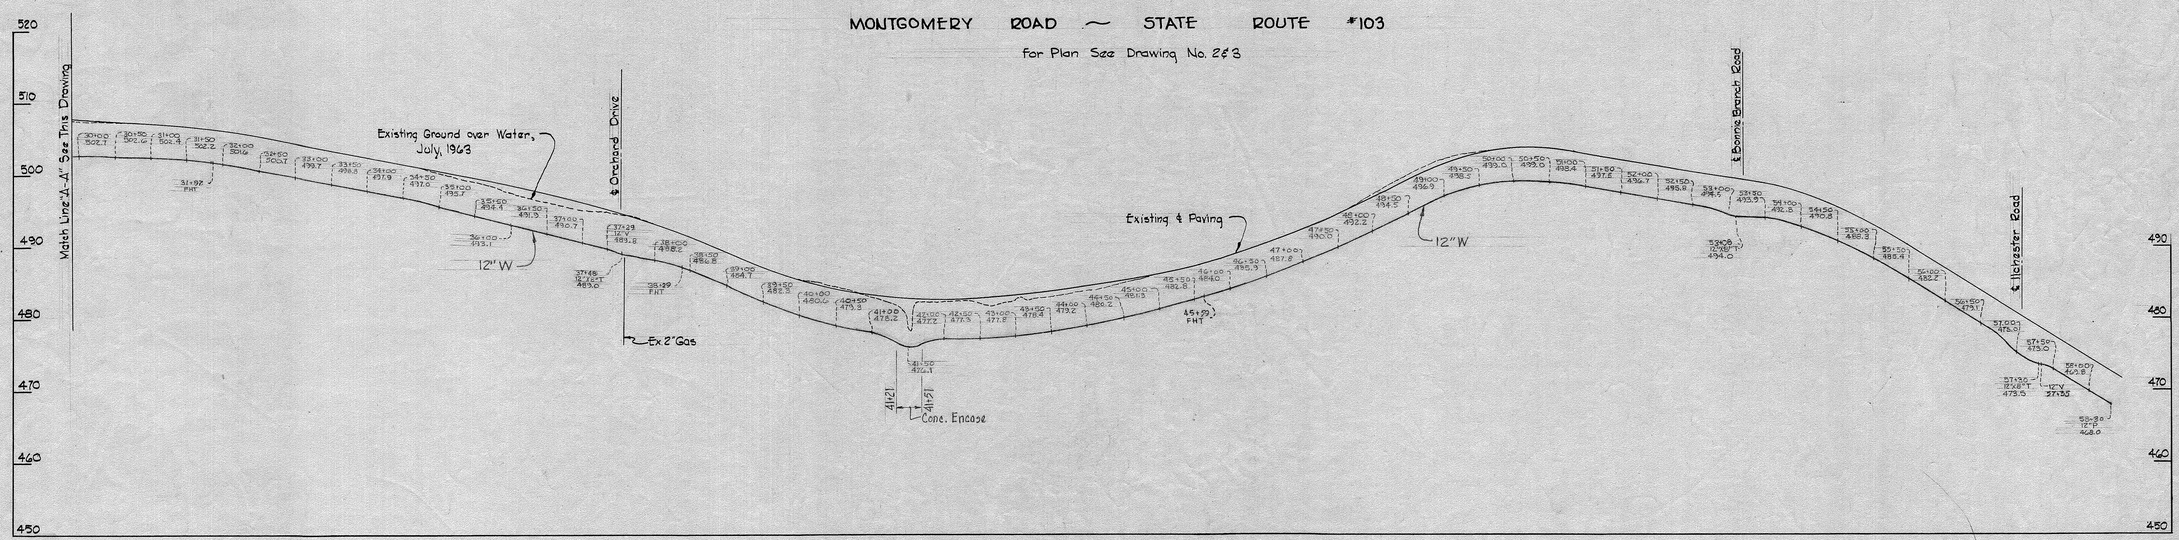


| | | | | | | |
|---|---|---|---|---|---|---|
| WHITMAN, REQUARDT & ASSOCIATES<br>ENGINEERS<br>1304 ST. PAUL ST.<br>BALTIMORE, MARYLAND | HOWARD COUNTY METROPOLITAN COMMISSION<br>July 17, 1964 (DATE) W O Talbert (CHIEF ENGINEER) | CONTRACT NO. 64 W | PROFILES OF WATER MAIN EXTENSIONS | ELLICOTT CITY SUB-DISTRICT | DRAWING NO. 23 OF 31 | SCALE H-1"=100' V-1"=10' |

Contract Nº 64 W

W. O. 5318-2

AS BUILT 7 JAN. 1966

WS 64W/23

ELLIOTT CO., PITTSBURGH REORDER A-39070

## HALE HAVEN DRIVE

for Plan See Drawing No.4

4+15 250'V.C.
P.V.I. 523.09
P.O.C. 516.53

Proposed ℄ Grade by W.R.&A.
Existing ℄ Paving
Existing Ground over Water, July, 1963
0+37 50'V.C.
P.V.I. 483.40
P.O.C. 483.93
10.50%
8"W
℄ Montgomery Rd.
℄ Elberta Drive
End of Paving
Property Line Section 2
Approved ℄ Grade
Ex.4"Gas
15"CMP
Ex.2"Gas

## SOUTH HAVEN DRIVE

for Plan See Drawing No.4

Existing ℄ Paving
℄ Montgomery Rd.
Existing Ground over Water
6"W
℄ Elberta Drive
End of Paving
Ex.4"Gas
Ex.2"Gas
Approved ℄ Grade
Property Line Section 3

## ELBERTA DRIVE

for Plan See Drawing No.5

℄ Hale Haven Drive
℄ Carmen Drive
℄ South Haven Drive
Property Line Section 1
Approved ℄ Grade
Existing ℄ Paving
6"W
Ex.2"Gas
Ex.2"Gas
Ex.24"CMP
Ex.2"Gas

## WORTHINGTON WAY

for Plan See Drawing No.6,7

℄ Montgomery Road
Existing ℄ Paving
Ex.4"Gas
8"W
℄ Woodview Drive
℄ Eastwood Court
℄ Little Court
℄ Eastwood Place
Ex.15"RCP
Ex.15"CMP
Approved ℄ Grade
℄ Bottom Stream
Ex.15"CMP
8"W
Ex.15"CMP
PROPERTY OF WORTHINGTON CONSTRUCTION CORPORATION
24+50 200'V.C.
P.V.I. 419.55
P.O.C. 419.86
3.3%
Proposed ℄ Grade by W.R.&A.
2.25%
Match Line 'B-B' See This Sheet

## WORTHINGTON WAY

for Plan See Drawing No.7

PROPERTY OF WORTHINGTON CONSTRUCTION CORPORATION
34+00 100'V.C.
P.V.I. 398.17
P.O.C. 398.58
Existing ℄ Paving
2.25%
Proposed ℄ Grade by W.R.&A.
1.0%
℄ Roundhill Rd.
Ex.15"CMP
8"W
Match Line 'B-B' See This Sheet

Contract N° 64W

| | | | | | | |
|---|---|---|---|---|---|---|
| WHITMAN, REQUARDT & ASSOCIATES<br>ENGINEERS<br>1304 ST. PAUL ST.<br>BALTIMORE, MARYLAND | HOWARD COUNTY METROPOLITAN COMMISSION<br>July 17, 1964 (DATE) W.O. Talbert (CHIEF ENGINEER) | CONTRACT NO. 64 W | PROFILES OF WATER MAIN EXTENSIONS | ELLICOTT CITY SUB-DISTRICT | DRAWING NO. 24 OF 31 | SCALE H-1"=100' V-1"=10' |

W. O. 5318-2

12 MARCH 1964

WS 64W/24

K. ELLIOTT CO., PITTSBURGH REORDER A-39070

## WOODVIEW ROAD

for Plan See Drawing No. 5

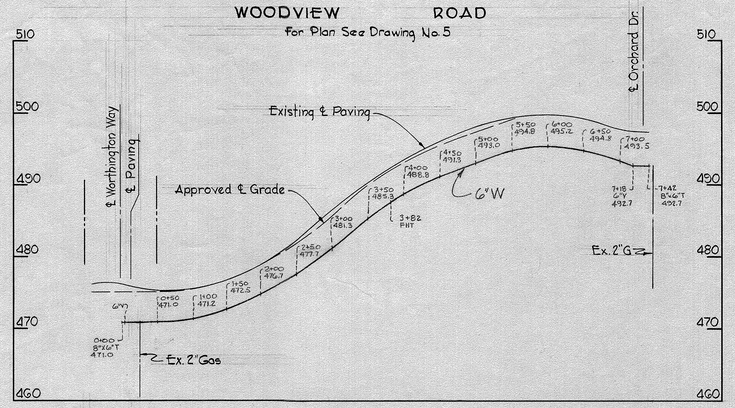


## EASTWOOD COURT

for Plan See Drawing No. 8

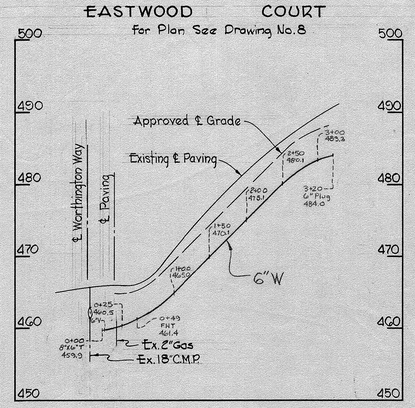


## EASTWOOD PLACE

for Plan See Drawing No. 8

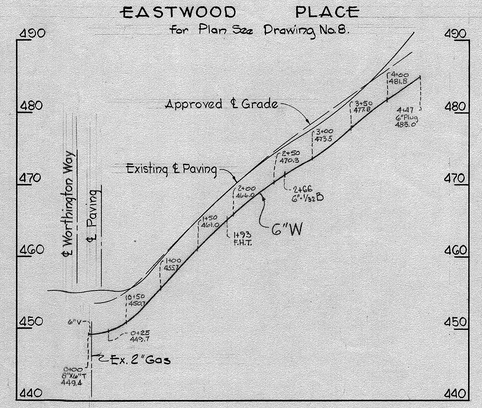


## LITTLE COURT

for Plan See Drawing No. 8

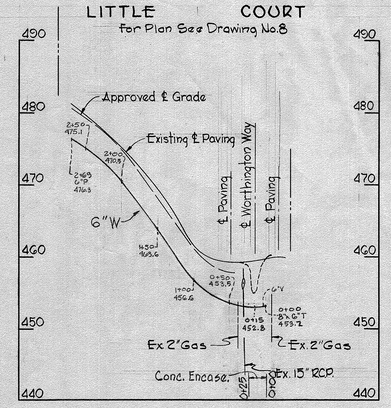


## ORCHARD DRIVE

for Plan See Drawing No. 8

| | | | |
|---|---|---|---|
| 0+12 494.8 | 2+00 - 100' V.C. P.V.I. 485.40 P.O.C. 486.46 | 6+00 - 200' V.C. P.V.I. 499.40 P.O.C. 498.27 | 8+00 - 100' V.C. P.V.I. 427.40 P.O.C. 497.71 |
| 9+00 - 100' V.C. P.V.I. 498.90 P.O.C. 498.52 | 12+00 - 100' V.C. P.V.I. 494.40 P.O.C. 493.59 | 14+50 - 300' V.C. P.V.I. 474.40 P.O.C. 479.84 | |

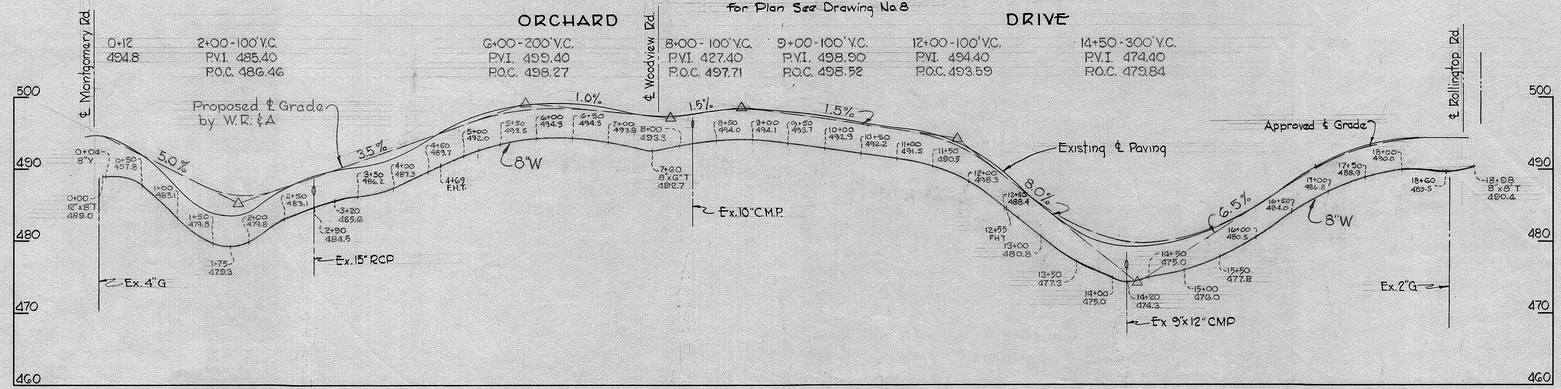


## GAWAIN PLACE

for Plan See Drawing No. 11

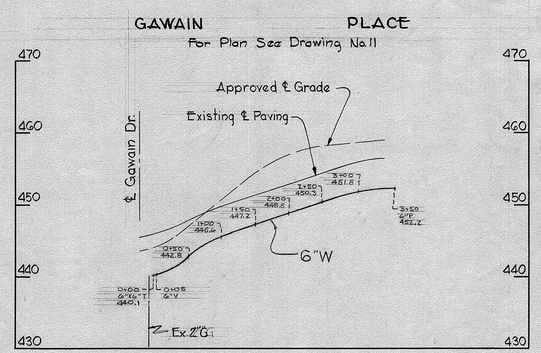


## NOTTINGHAM WAY

For Plan See Drawing No. 10

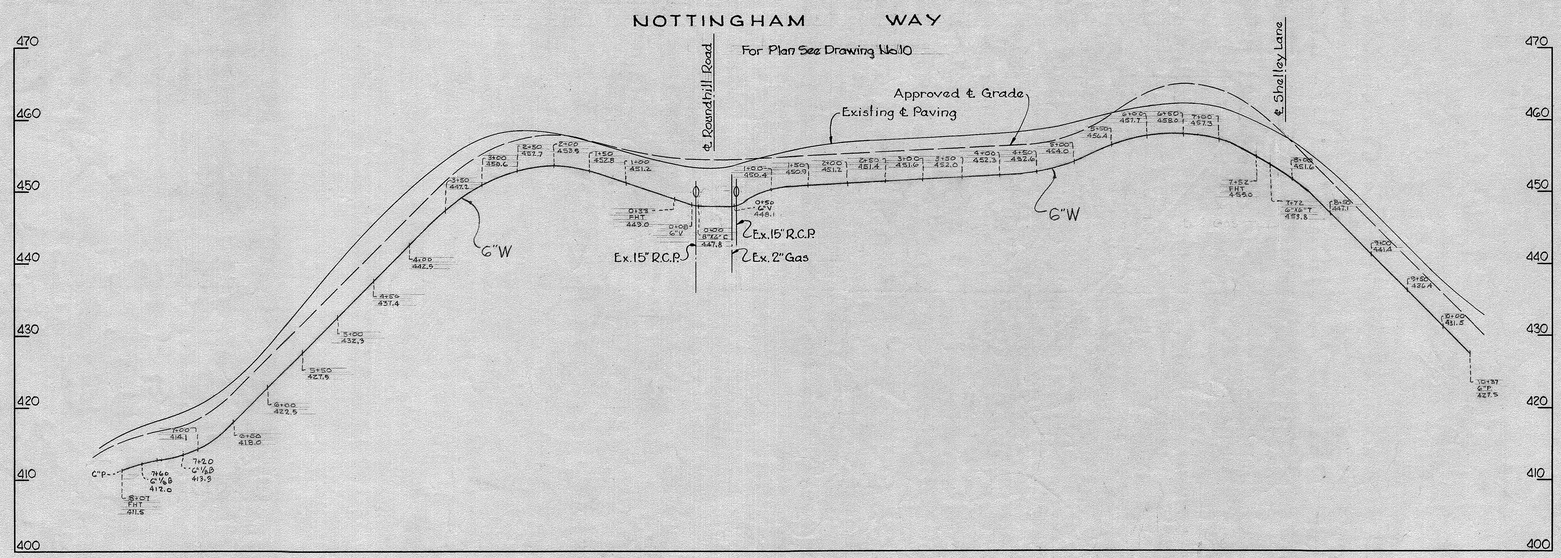


## GAWAIN DRIVE

For Plan See Drawing No. 10

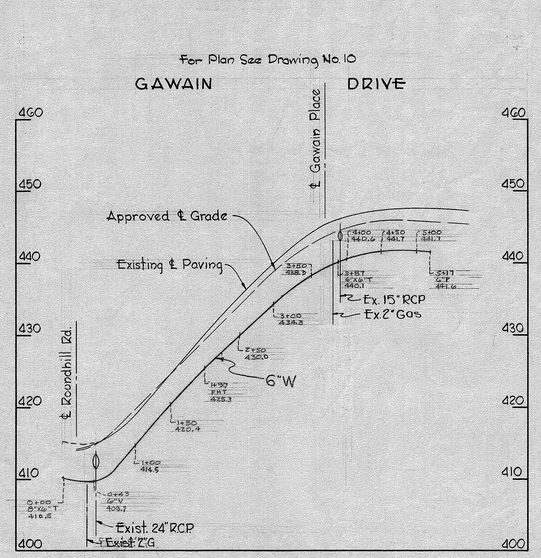


Contract No 64W

| | | | | | | |
|---|---|---|---|---|---|---|
| WHITMAN, REQUARDT & ASSOCIATES ENGINEERS 1304 ST. PAUL ST. BALTIMORE, MARYLAND | HOWARD COUNTY METROPOLITAN COMMISSION July 17, 1964 DATE — W O Gilbert CHIEF ENGINEER | CONTRACT NO. 64 W | PROFILES OF WATER MAIN EXTENSIONS | ELLICOTT CITY SUB-DISTRICT | DRAWING NO. 25 OF 31 | SCALE H-1"=100' V-1"=10' |

W. O. 5318-2

AS BUILT 7 / JAN. 1966

WS 64W/25

E. K. ELLIOTT CO., PITTSBURGH REORDER A-39070

ROLLINGTOP ROAD

for Plan See Drawing No. 7

SHELLEY LANE

for Plan See Drawing No. 11

ROUNDHILL ROAD

for Plan See Drawing No. 9

| | | | | | | |
|---|---|---|---|---|---|---|
| WHITMAN, REQUARDT & ASSOCIATES<br>ENGINEERS<br>1304 ST. PAUL ST.<br>BALTIMORE, MARYLAND | HOWARD COUNTY METROPOLITAN COMMISSION<br>July 17, 1964 DATE<br>W O Gilbert CHIEF ENGINEER | CONTRACT NO. 64 W | PROFILES OF WATER MAIN EXTENSIONS | ELLICOTT CITY SUB-DISTRICT | DRAWING NO. 26 OF 31 | SCALE<br>H-1"=100'<br>V-1"=10' |

Contract Nº 64 W

W. O. 5318-2

AS BUILT 7 JAN. 1966

WS 64W/26

ELLIOTT CO., PITTSBURGH REORDER A-29070

# BONNIE BRANCH ROAD

for Plan See Drawing No. 12

1+00 50'V.C.
P.V.I. 496.30
P.O.C. 496.43

6+00 1+00
P.V.I. 491.30
P.O.C. 491.11

9+00 100'V.C.
P.V.I. 483.80
P.O.C. 483.61

11+00 100'V.C.
P.V.I. 475.80
P.O.C. 475.61

16+50 100'V.C.
P.V.I. 445.55
P.O.C. 445.30

21+25 100'V.C.
P.V.I. 409.93
P.O.C 410.24

24+25 100'V.C.
P.V.I. 394.93
P.O.C. 395.37

℄ Montgomery Road

℄ Bonnie Acres Road

℄ Hurst Road

3.00%

1.00%

2.50%

4.00%

5.50%

7.50%

5.00%

1.50%

Existing Ground over Water, August, 1963

Proposed ℄ Grade by W.R.&A.

8"W

12"W

2-Ex. 4'G

7+81 FHT

16+15 FHT

Ex. 12"RCP

Ex. 24"CMP

23+68

23+83

Concrete Encased

Ex. 12"CMP

Match Line "C-C" See This Sheet

# BONNIE BRANCH ROAD

for Plan See Drawing No. 12

Existing ℄ Paving

Proposed ℄ Grade by W.R.&A.

1.50%

Ex. 12"CMP

Ex. 18"CMP

Match Line "C-C" See This Sheet

# BONNIE ACRES ROAD

for Plan See Drawing No. 13

℄ Bonnie Branch Road

Existing ℄ Paving

Approved ℄ Grade

6"W

12+14 6"W

12+00 FHT

12+09 FHT

℄ Hurst Road

Match Line "C-C" See This Sheet

Contract Nº 64 W

| | | | | | | |
|---|---|---|---|---|---|---|
| WHITMAN, REQUARDT & ASSOCIATES<br>ENGINEERS<br>1304 ST. PAUL ST.<br>BALTIMORE, MARYLAND | HOWARD COUNTY METROPOLITAN COMMISSION<br>July 17, 1964 (DATE)<br>W O Gilbert (CHIEF ENGINEER) | CONTRACT NO. 64 W | PROFILES OF WATER MAIN EXTENSIONS | ELLICOTT CITY SUB-DISTRICT | DRAWING NO. 27 OF 31 | SCALE<br>H-1"=100'<br>V-1"=10' |

W. O. 5318-2

AS BUILT 7 JAN. 1966

WS 64W/27

ELLIOTT CO., PITTSBURGH REORDER A-39070

# ILCHESTER ROAD

for Plan See Drawing No. 14

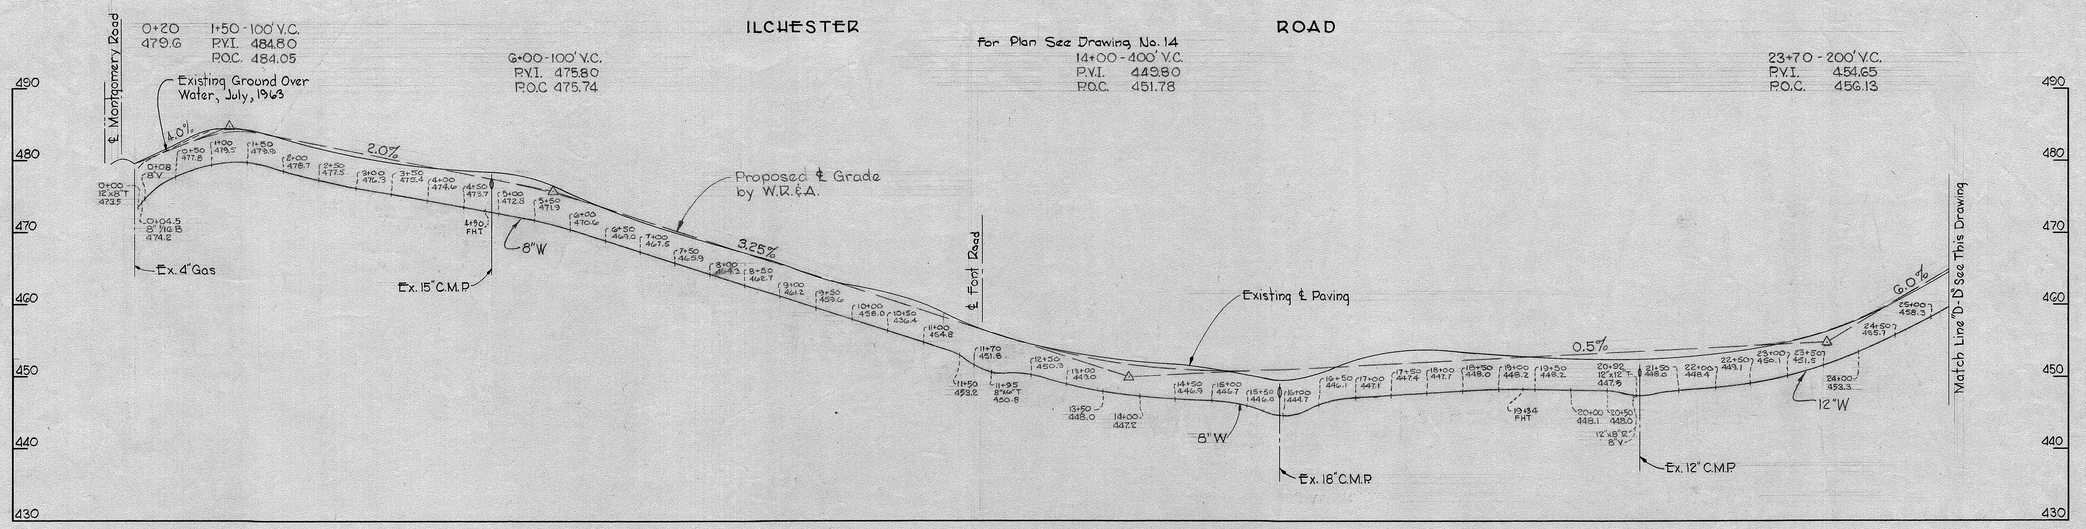


# ILCHESTER ROAD

for Plan See Drawing No. 14

Note: Grade changed see Contract 208-W

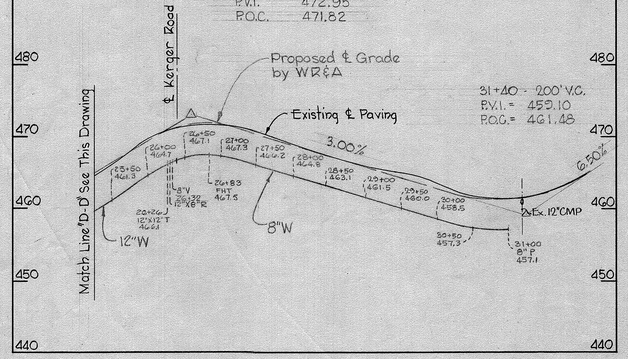


# HURST ROAD

for Plan See Drawing No. 13

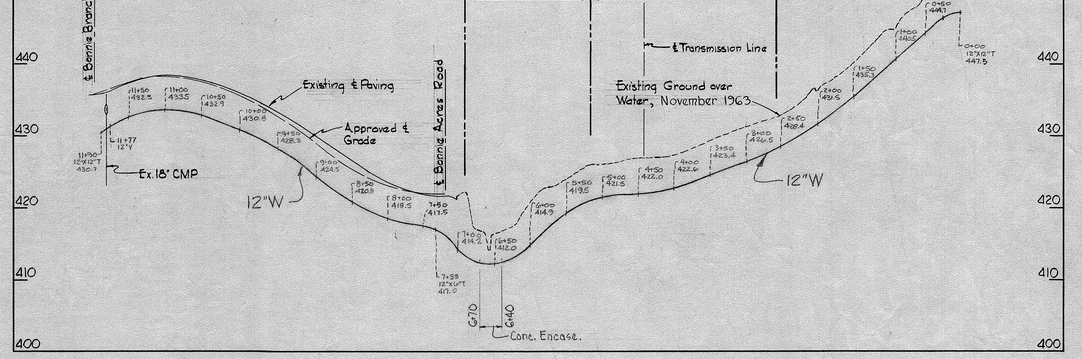


# FONT ROAD

For Plan See Drawing No. 13

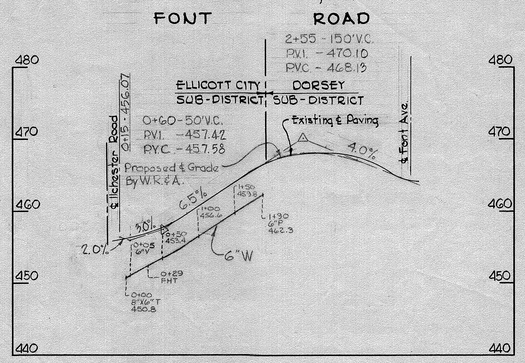


# KERGER ROAD

For Plan See Drawing No. 14

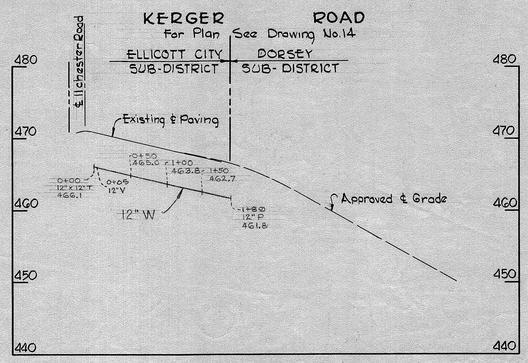


| | | | | | |
|---|---|---|---|---|---|
| WHITMAN, REQUARDT & ASSOCIATES ENGINEERS 1304 ST. PAUL ST. BALTIMORE, MARYLAND | HOWARD COUNTY METROPOLITAN COMMISSION July 17, 1964 (DATE) W O Gilbert (CHIEF ENGINEER) | CONTRACT NO. 64 W | PROFILES OF WATER MAIN EXTENSIONS | ELLICOTT CITY SUB-DISTRICT | DRAWING NO. 28 OF 31 / SCALE H-1"=100' V-1"=10' |

Contract Nº 64 W

W. O. 5318-2

AS BUILT 7 JAN. 66

WS 64W/28

ELLIOTT CO., PITTSBURGH REORDER A-39070

## WATERLOO ROAD STATE ROUTE # 175

for Plan See Drawing No. 15 & 16

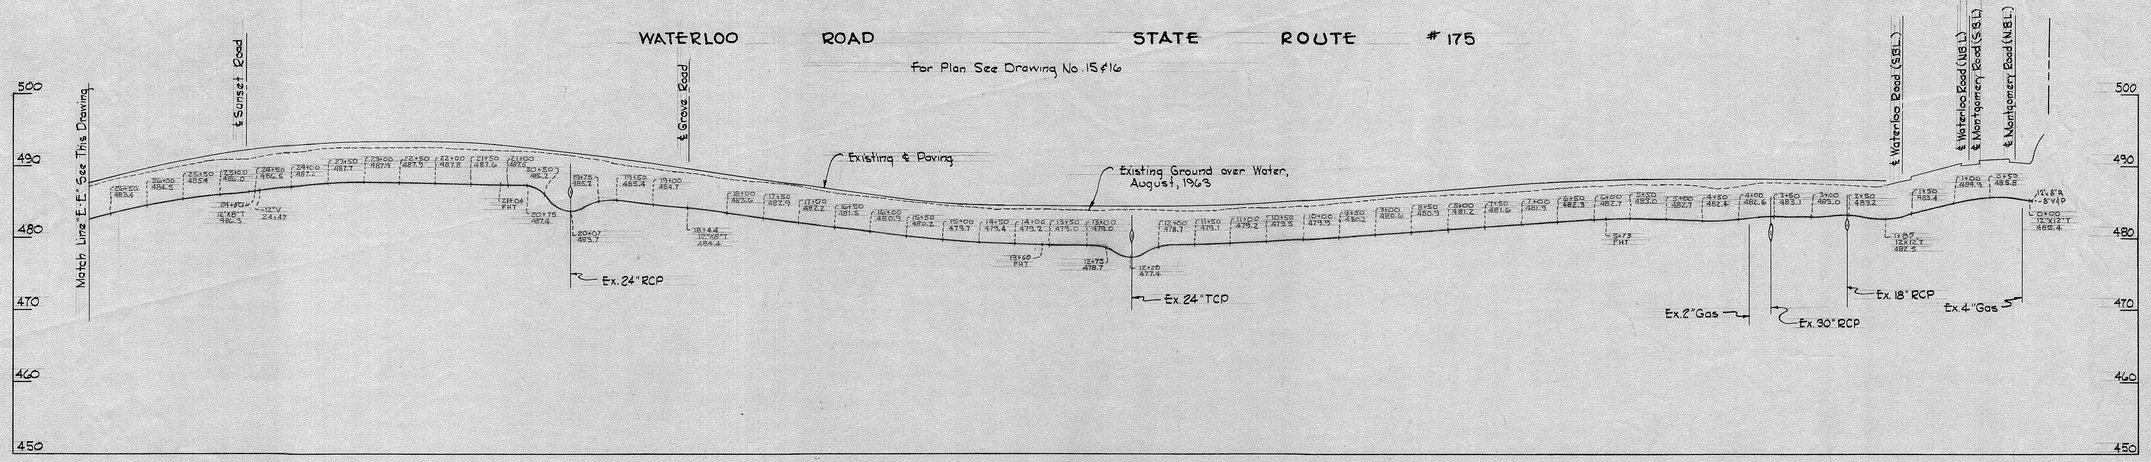


## WATERLOO ROAD STATE ROUTE # 175

for Plan See Drawing No. 15, 16

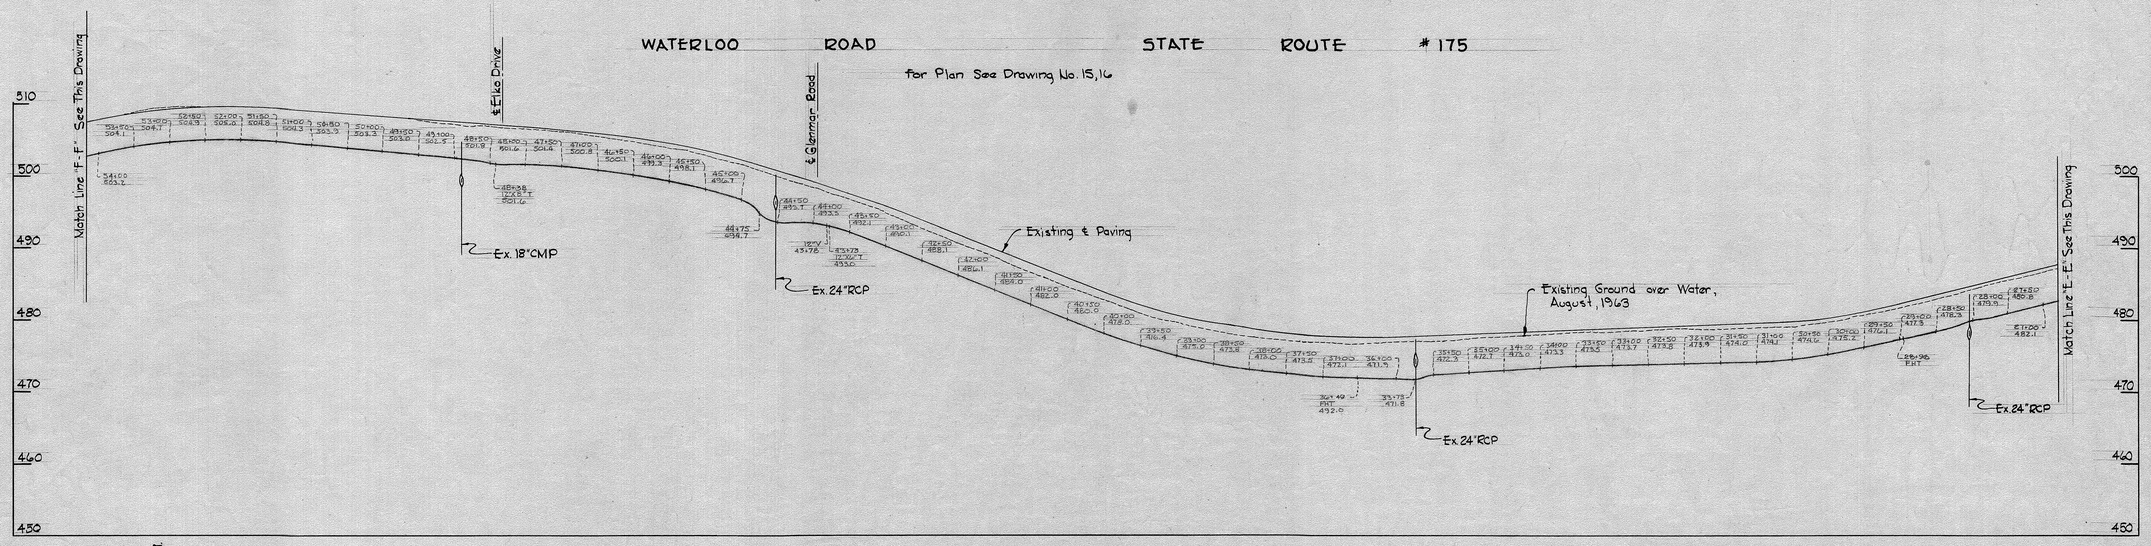


## WATERLOO ROAD STATE ROUTE #175

For Plan See Drawing No. 14

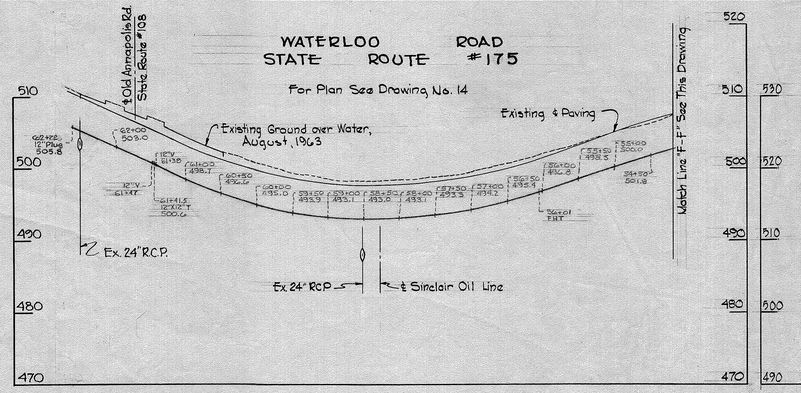


## OLD ANNAPOLIS ROAD STATE ROUTE #108

For Plan See Drawing No. 22

P.V.I. 421.60
P.O.C. 420.72

4+30 200' VC
P.V.I. 425.95
P.O.C. 424.45

1+40 200' V.C.
P.V.I. 510.00
P.O.C. 510.75

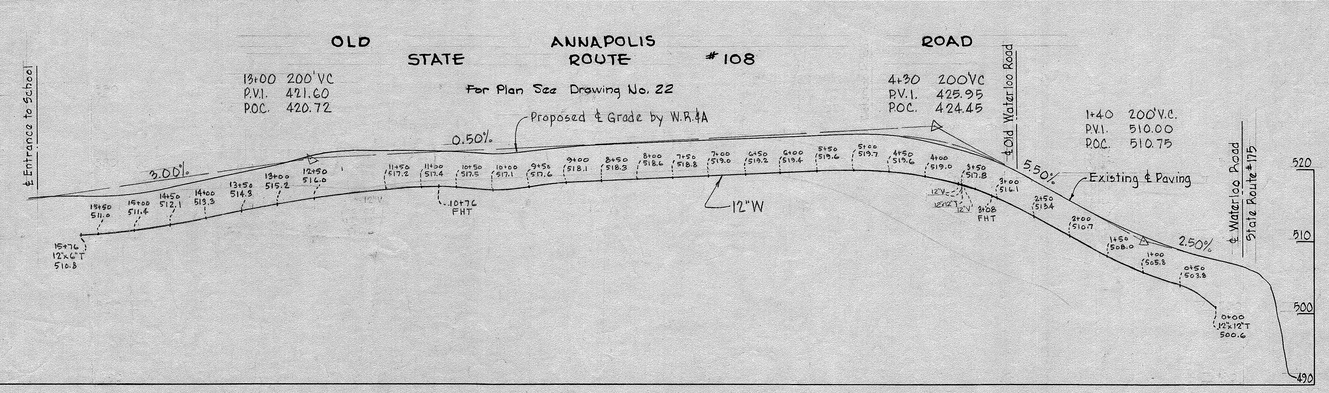


Contract Nº 64 W

| | | | | | | |
|---|---|---|---|---|---|---|
| WHITMAN, REQUARDT & ASSOCIATES<br>ENGINEERS<br>1304 ST. PAUL ST.<br>BALTIMORE, MARYLAND | HOWARD COUNTY METROPOLITAN COMMISSION<br>July 17, 1964 (DATE)<br>W O Filbert (CHIEF ENGINEER) | CONTRACT NO. 64 W | PROFILES OF WATER MAIN EXTENSIONS | ELLICOTT CITY SUB-DISTRICT | DRAWING NO. 29 OF 31 | SCALE<br>H-1"=100'<br>V-1"=10' |

W. O. 5318-2

AS BUILT 7 JAN 1966

WS 64W/29

ELLIOTT CO., PITTSBURGH REORDER A-39070

## WEST GROVE ROAD

For Plan See Drawing 18

5+60 - 50'V.C. P.V.I. 453.82 P.O.C. 453.60

3+35 - 100'V.C. P.V.I. 454.95 P.O.C. 455.64

1+85 - 150'V.C. P.V.I. 463.95 P.O.C. 462.91

7+40 - 100'V.C. P.V.I. 466.62 P.O.C. 465.99

℄ Grove Angle Rd.

Proposed ℄ Grade by W.R.&A.

Existing ℄ Paving

Existing Ground over Water, Aug., 1963

10%

8.0%

6.0%

0.5%

6"W

Ex. 12"CMP

## GROVE ROAD — GROVE ANGLE ROAD

For Plan See Drawing No. 17.

0+25 - 50'V.C. P.V.I. 489.05 P.O.C. 488.80

℄ Waterloo Road

2+00 - 200'V.C. P.V.I. 479.42 P.O.C. 480.72

5+50 - 150'V.C. P.V.I. 478.30 P.O.C. 477.38

8+50 - 130'V.C. P.V.I. 461.51 P.O.C. 462.89

10+50 - 100'V.C. P.V.I. 465.87 P.O.C. 464.93

13+00 - 200'V.C. P.V.I. 452.12 P.O.C. 454.50

15+20 - 100'V.C. P.V.I. 460.92 P.O.C. 459.98

Ex. 6"Gas

8"W

Existing ℄ Paving

℄ Jodpanda Drive

℄ West Grove Road

Proposad ℄ Grade by W.R.&A.

Ex. 18"CMP

Ex. 24"CMP.

8"W

## HORSESHOE ROAD

For Plan See Drawing No. 19

34+20 - 300'V.C. P.V.I. 510.45 P.O.C. 508.70

32+50 - 120'V.C. P.V.I. 491.55 P.O.C. 492.23

30%

45%

Existing ℄ Paving

Proposed ℄ Grade by W.R.&A.

8"W

Existing Ground over Water, Aug. 1963

Match Line "G-G" See This Sheet

## PROPERTY OF DAVID L. & NAOMI M. McCELLAND — PROPERTY OF BOARD OF EDUCATION OF HOWARD COUNTY

For Plan See Drawing No. 18

℄ Avoca Ave.

℄ Horseshoe Road

8"W to be built under Contr. 12-W

8"W

Existing Ground over Water, Dec., 1963

LIMIT OF CONTRACT

## HORSESHOE ROAD

For Plan See Drawing No. 19

26+00 - 200'V.C. P.V.I. 462.30 P.O.C. 461.42

24+00 - 200'V.C. P.V.I. 446.30 P.O.C. 449.10

17+15 - 200'V.C. P.V.I. 468.31 P.O.C. 467.38

45%

8.0%

3.2%

8"W

Existing Ground over Water, August, 1963

Proposed ℄ Grade by W.R.&A.

0.50%

Ex. 12" RCP

FOR UPDATED UTILITIES SEE ACRA PROPERTY CONTRACT # SDP-19-016

Ex. 36"RCP

Ex. 36"RCP

## SUNSET AVENUE

7+70 - 150'V.C. P.V.I. 478.22 P.O.C. 477.73

10+10 - 150'V.C. P.V.I. 464.78 P.O.C. 465.92

1+35 - 50'V.C. P.V.I. 495.27 P.O.C. 493.41

0+15 491.85 ℄ Waterloo Road

3.00%

5.60%

2.85%

2.01%

Existing ℄ Paving

8"W

Ex. 12"CMP

Ex. 12"RCP

Ex. 12"RCP

| | | | | | | |
|---|---|---|---|---|---|---|
| WHITMAN, REQUARDT & ASSOCIATES ENGINEERS 1304 ST. PAUL ST. BALTIMORE, MARYLAND | HOWARD COUNTY METROPOLITAN COMMISSION July 17, 1964 DATE — W.O. Gilbert CHIEF ENGINEER | CONTRACT NO. 64 W | PROFILES OF WATER MAIN EXTENSIONS | ELLICOTT CITY SUB-DISTRICT | DRAWING NO. 30 OF 31 | SCALE H-1"=100' V-1"=10' |

Contract Nº 64 W

W. O. 5318-2

AS BUILT 7 JAN 1966

WS 64W/30

ELLIOTT CO., PITTSBURGH REORDER A-39070

## GLENMAR ROAD

For Plan See Drawing No. 20

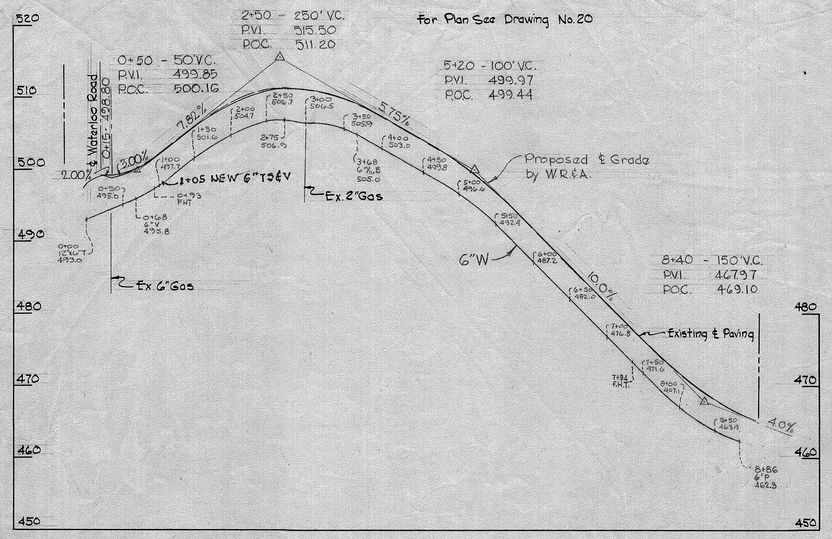


## SUNDERLAND DRIVE

For Plan See Drawing No. 21

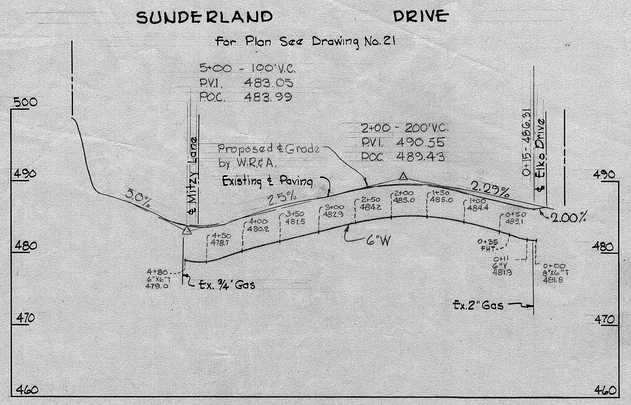


## MITZY LANE

For Plan See Drawing No. 21

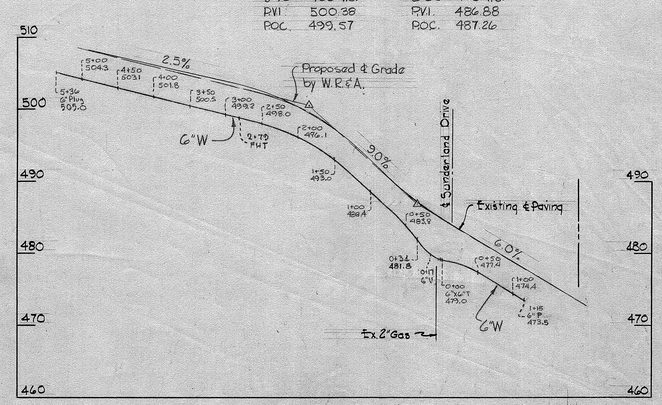


## ELKO DRIVE

For Plan See Drawing No. 20

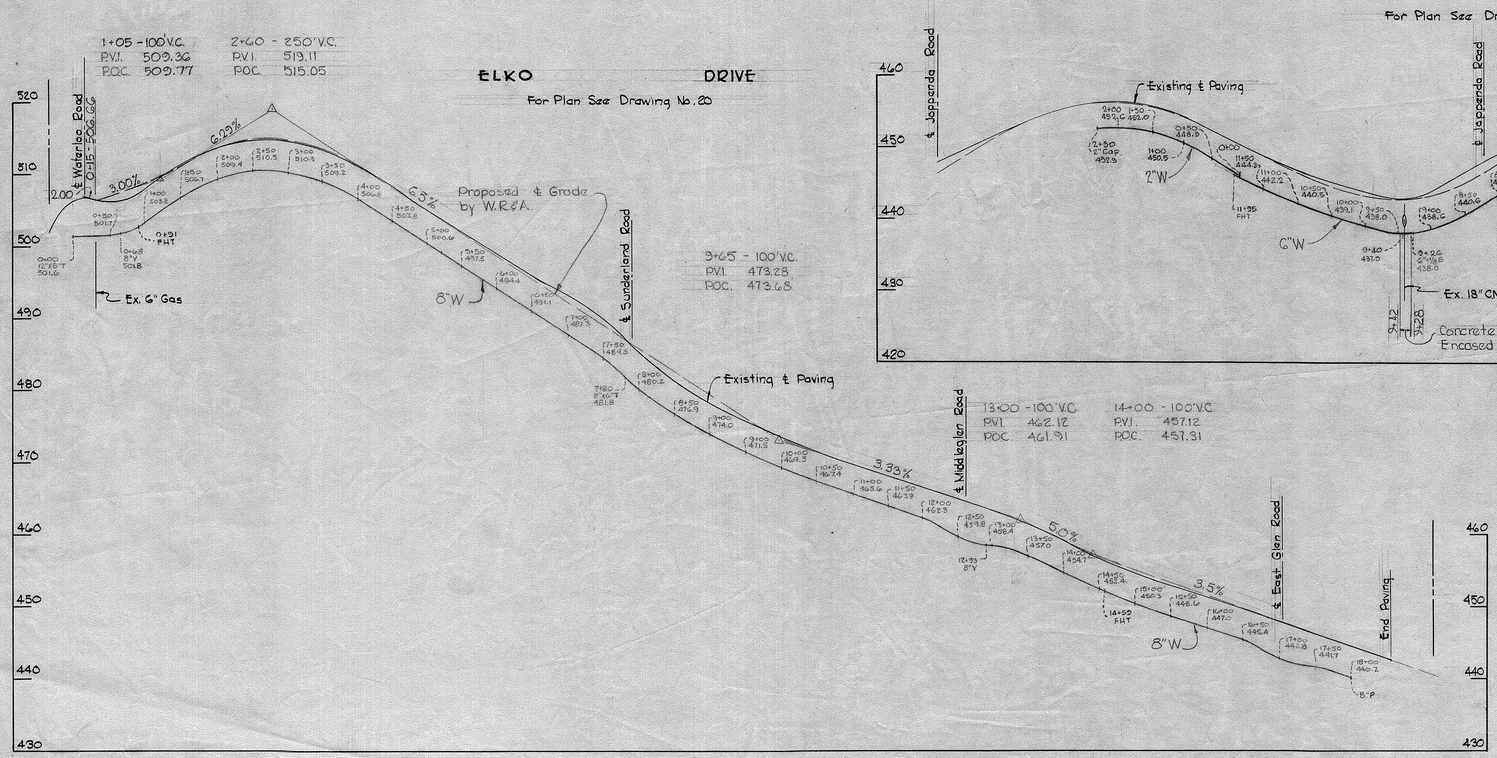


## JOPPENDA ROAD

For Plan See Drawing No. 17

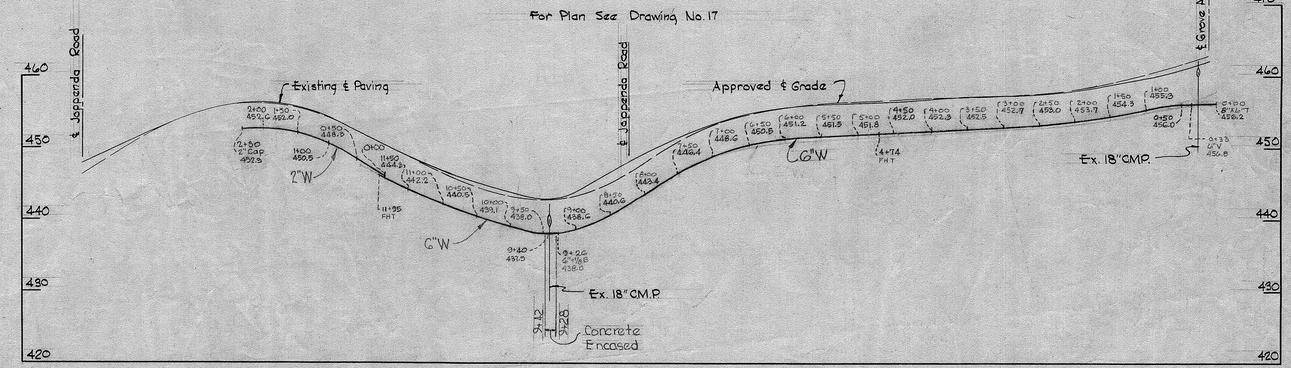


Contract Nº 64 W

| | | | | | | |
|---|---|---|---|---|---|---|
| WHITMAN, REQUARDT & ASSOCIATES<br>ENGINEERS<br>1304 ST. PAUL ST.<br>BALTIMORE, MARYLAND | HOWARD COUNTY METROPOLITAN COMMISSION<br>July 17, 1964 (DATE) W O Filbert (CHIEF ENGINEER) | CONTRACT NO. 64 W | PROFILES OF WATER MAIN EXTENSIONS | ELLICOTT CITY SUB-DISTRICT | DRAWING NO. 31 OF 31 | SCALE H-1"=100 V-1"=10' |

W. O. 5318-2

AS BUILT 4 JAN 2024

AS BUILT 7 JAN. 1966

WS 64W/31

ELLIOTT CO., PITTSBURGH REORDER A-39070