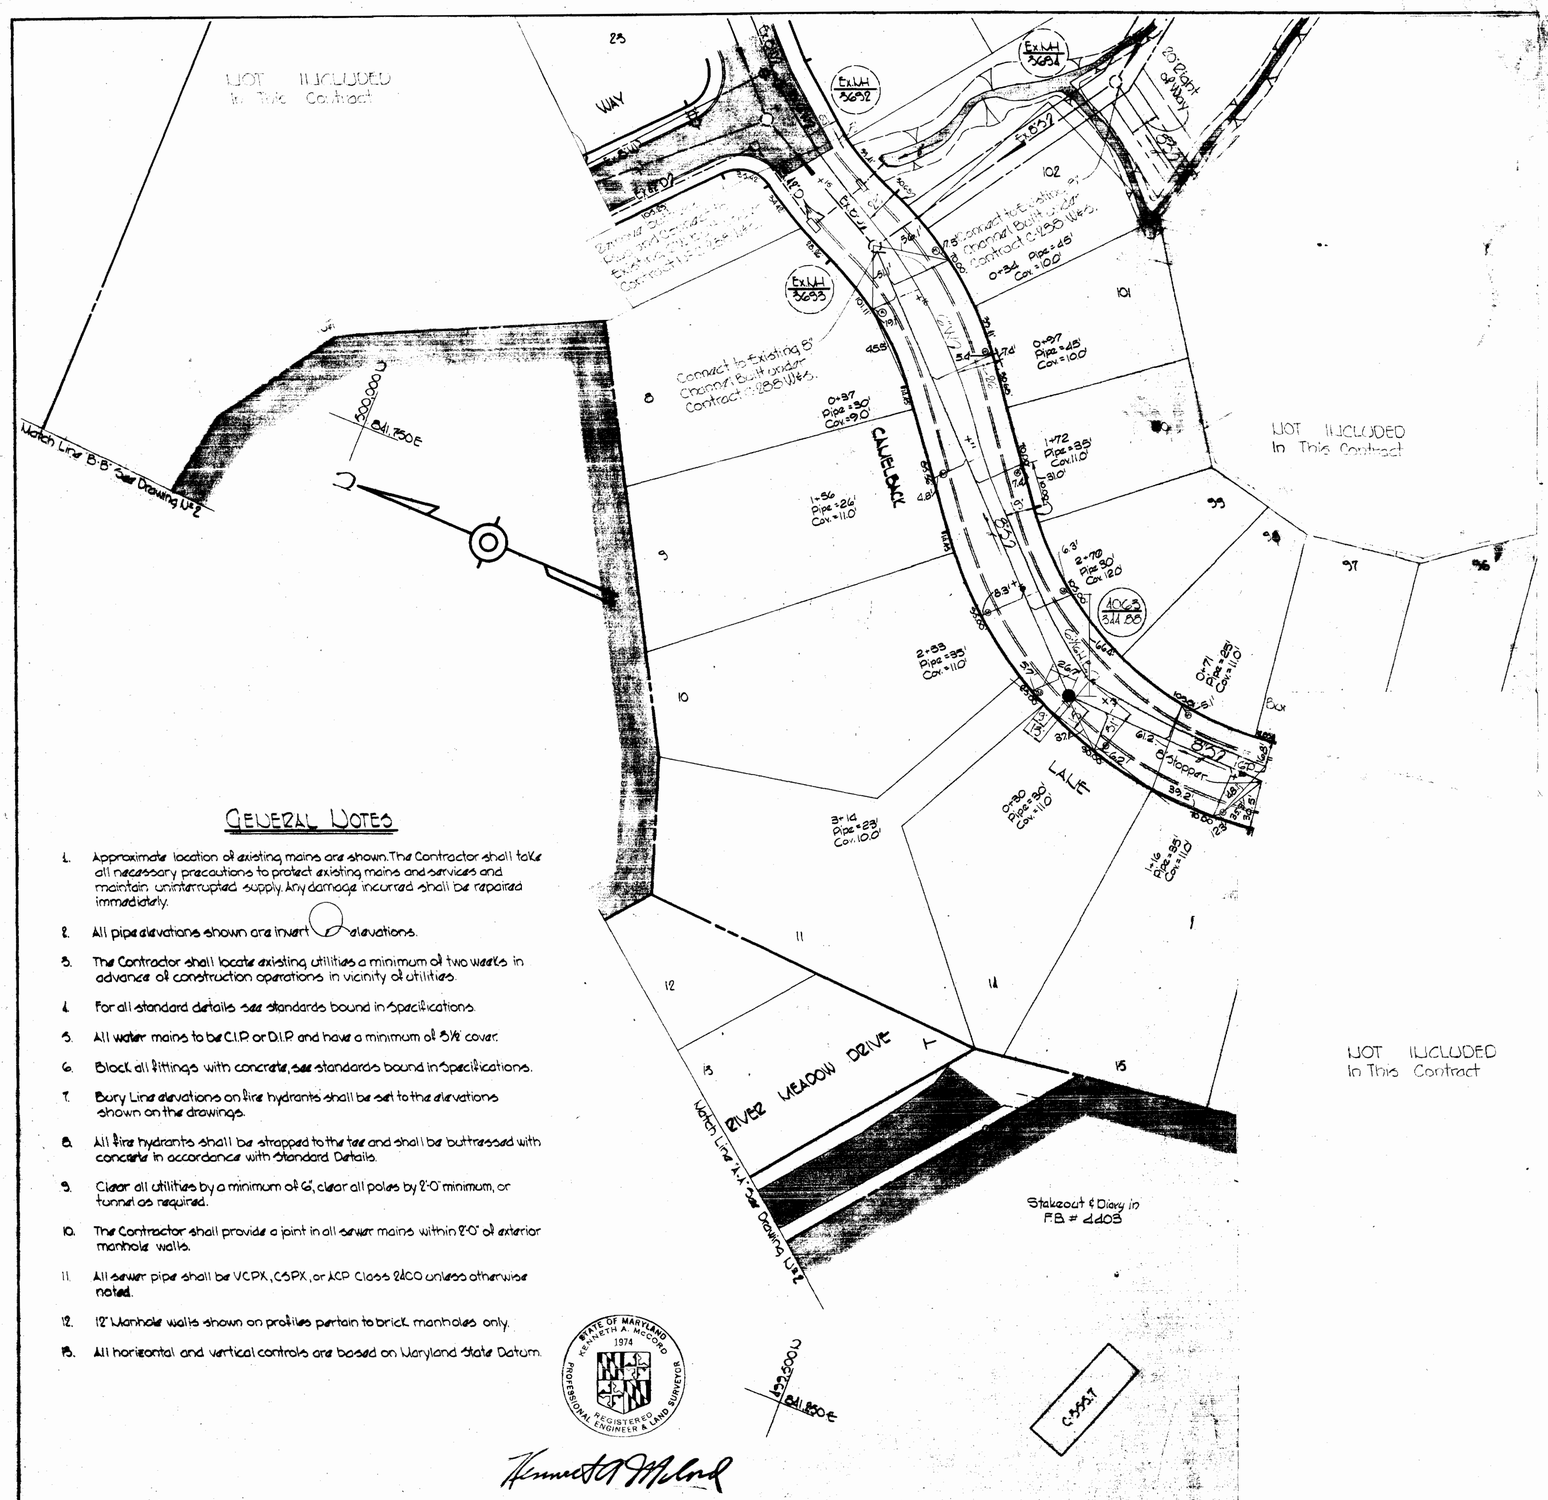

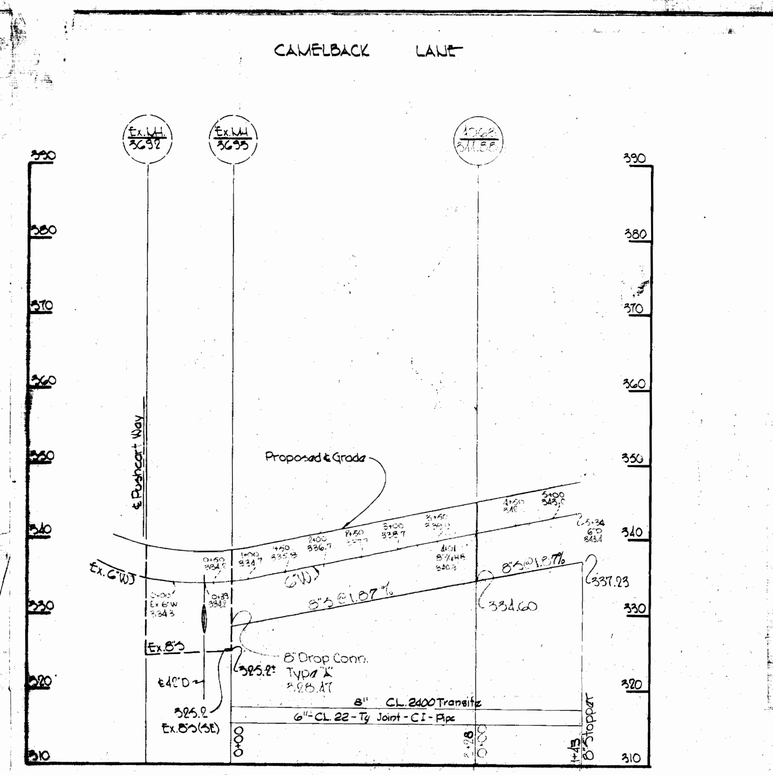

GENERAL NOTES

1. Approximate location of existing mains are shown. The Contractor shall take all necessary precautions to protect existing mains and services and maintain uninterrupted supply. Any damage incurred shall be repaired immediately.
2. All pipe elevations shown are invert elevations.
3. The Contractor shall locate existing utilities a minimum of two weeks in advance of construction operations in vicinity of utilities.
4. For all standard details see standards bound in Specifications.
5. All water mains to be C.I.P. or D.I.P. and have a minimum of 3½' cover.
6. Block all fittings with concrete, see standards bound in Specifications.
7. Bury Line elevations on fire hydrants shall be set to the elevations shown on the drawings.
8. All fire hydrants shall be strapped to the tee and shall be buttressed with concrete in accordance with Standard Details.
9. Clear all utilities by a minimum of 6", clear all poles by 2'-0" minimum, or tunnel as required.
10. The Contractor shall provide a joint in all sewer mains within 2'-0" of exterior manhole walls.
11. All sewer pipe shall be VCPX, CSPX, or ACP Class 2400 unless otherwise noted.
12. 12" Manhole walls shown on profiles pertain to brick manholes only.
13. All horizontal and vertical controls are based on Maryland State Datum.

STATE OF MARYLAND
KENNETH A. McCORD
1974
REGISTERED PROFESSIONAL ENGINEER & LAND SURVEYOR

WHITMAN, REQUARDT & ASSOCIATES ENGINEERS 1304 ST. PAUL ST. BALTIMORE, MARYLAND	HOWARD COUNTY METROPOLITAN COMMISSION 8-25-69 DATE — W.O. Gilbert CHIEF ENGINEER	CONTRACT 0-288-A-W&S	PLAN OF WATER & SEWER MAINS	VILLAGE OF OAKLAND MILLS ELECTION DISTRICT GUILFORD NO. 6	SHEET NO. 1 OF 1

W. O. 6025-2

AS BUILT Nov. 20, 1969

W-5/1A
W-5 887 CM

E. S. ELLIOTT CO., PHIL., PA. REORDER A-14023