DRAINAGE AREA – LITTLE PATUXENT
NO. SHC = 1
NO. WHC = 1
TYPE OF BUILDING = WAREHOUSE & OFFICE
WATER CODE = 802
SEWER CODE = 313000

QUANTITIES

ITEM	EST'D	AS BUILT	SUPPLIER
12" WATER	112 L.F.	112 LF	A&P WATER & SEWER SUPPLIES INC.
8" WATER	1033 LF.	1033 LF.	" ATLANTIC STATES
6" WATER	37 LF.	37 LF	" ATLANTIC STATES
FIRE HYDRANT	3 EA.	3 EA.	" MUELLER
6" F.H. VALVE	3 EA.	3 EA.	" MUELLER
12"X12" TAP SLV. & VAL.	1 EA.	1 EA.	" TYLER PIPE
12"X12" TEE	1 EA.	1 EA.	A&P WATER & SEWER SUPPLIES INC.
8"X8" TEE	2 EA.	2 EA.	" TYLER PIPE
8"X6" TEE	1 EA.	1 EA.	" TYLER PIPE
8"X8" CROSS	1 EA.	1 EA.	" TYLER PIPE
8" VALVE	4 EA.	5 EA.	" MUELLER
12"X8" REDUCER	2 EA.	2 EA.	" TYLER PIPE
8"X6" REDUCER	2 EA.	2 EA.	" TYLER PIPE
6" SEWER	10 L.F.	10 L.F.	" CERTAIN TEED

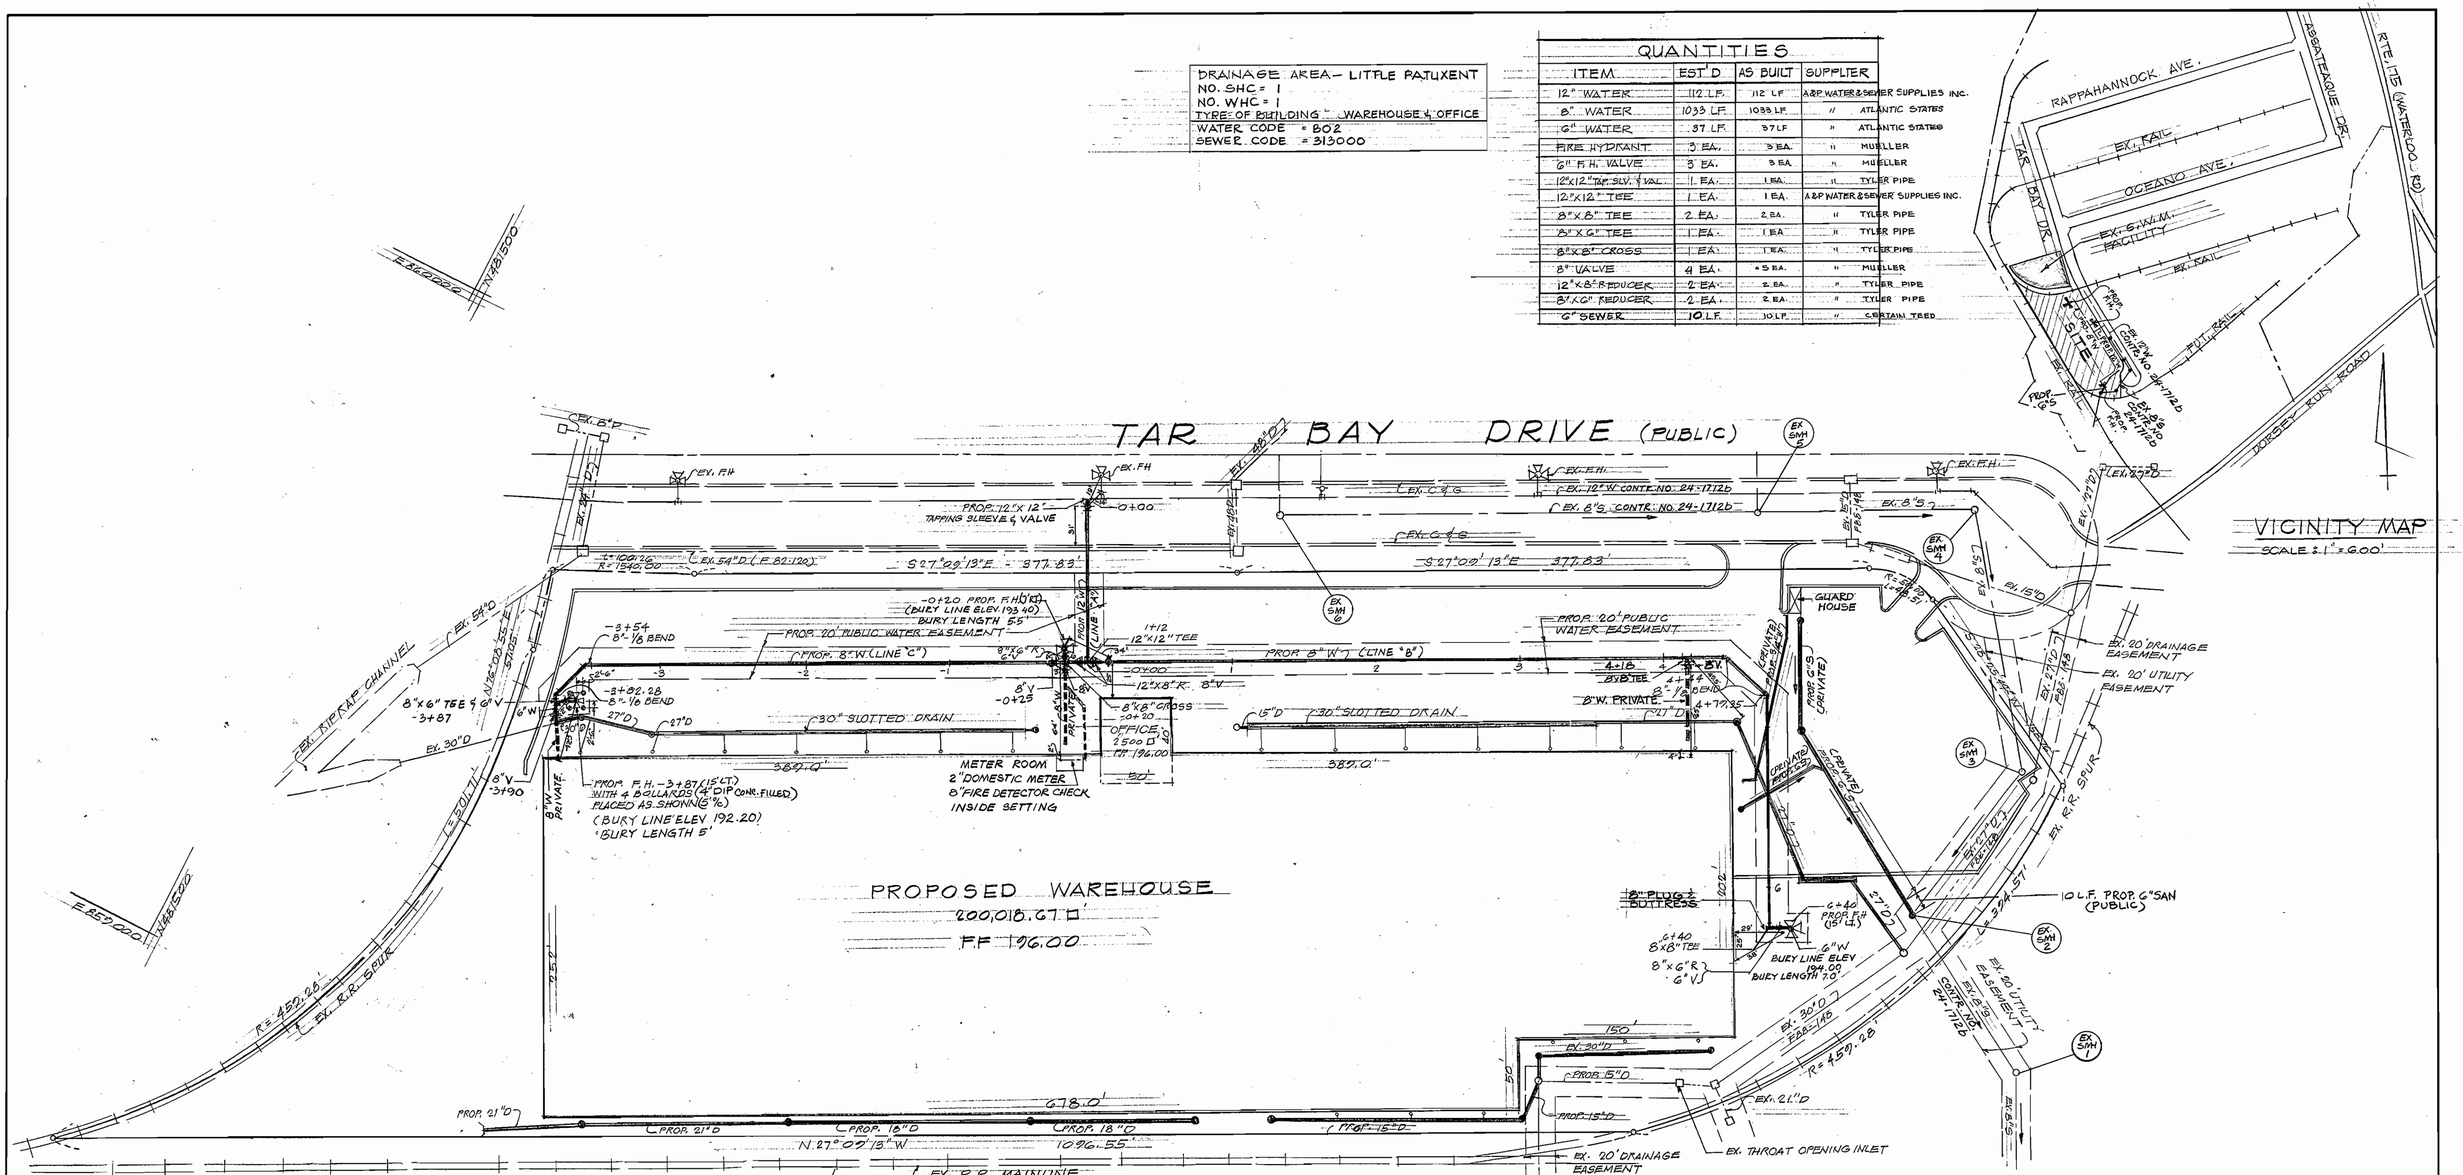
TAR BAY DRIVE (PUBLIC)
PROP. 12"X 12" TAPPING SLEEVE & VALVE
0+00
S 27°09'13" E 377.83'
PROP. 20' PUBLIC WATER EASEMENT
PROP. 8" W. (LINE "C")
PROP. 8" W. (LINE "B")
-3+54 8"-1/8 BEND
-3+92.28 8"-1/8 BEND
8"X6" TEE & 6" V -3+87
8" V -3+90
-0+20 PROP. F.H. (BURY LINE ELEV. 193.40) BURY LENGTH 55'
1+12 12"X12" TEE
12"X8" R. 8" V
8"X8" CROSS 2+20
OFFICE 2500 □' FF 196.00
METER ROOM 2 DOMESTIC METER 8" FIRE DETECTOR CHECK INSIDE SETTING
30" SLOTTED DRAIN
389.0'
PROP. F.H. -3+87 (15' LT.) WITH 4 BOLLARDS (4" DIP CONC. FILLED) PLACED AS SHOWN (6'ø) (BURY LINE ELEV 192.20) BURY LENGTH 5'
PROPOSED WAREHOUSE
200,018.67 □'
FF 196.00
4+18 BYB TEE
8" V 4+35 8" V BEND
8" W PRIVATE
4+79.25
GUARD HOUSE
PROP. C.S. (PRIVATE)
EX. 20' DRAINAGE EASEMENT
EX. 20' UTILITY EASEMENT
EX. R.R. SPUR
8" PLUG & BUTTRESS
6+40 8"X8" TEE
6+40 PROP. F.H. (15' LT.)
6"W BURY LINE ELEV 194.09 BURY LENGTH 7.0
8"X6" R. 6" V
10 L.F. PROP. 6" SAN (PUBLIC)
EX. 30"D
PROP. 15"D
EX. 21"D
EX. THROAT OPENING INLET
EX. 20' DRAINAGE EASEMENT
EX. 36"D
PROP. 21"D
PROP. 18"D
678.0'
N 27°09'13" W 1096.55'
℄ EX. R.R. MAINLINE
R = 450.28'
E 850,000
N 481,000
E 850,000
N 481,500
VICINITY MAP
SCALE 1" = 600'
RAPPAHANNOCK AVE.
ASSATEAGUE DR.
RTE. 175 (WATERLOO RD.)
TAR BAY DR.
OCEANO AVE.
EX. 6" W.M. FACILITY
EX. RAIL
DORSEY RUN ROAD
PROP. 6" SAN CONT. NO. 24-1712D
EX. 8" S CONT. NO. 24-1712D
EX. 12" W CONT. NO. 24-1712D
EX. 8" S CONT. NO. 24-1712D
EX. 8" S CONT. NO. 24-1712D
EX. 8" S

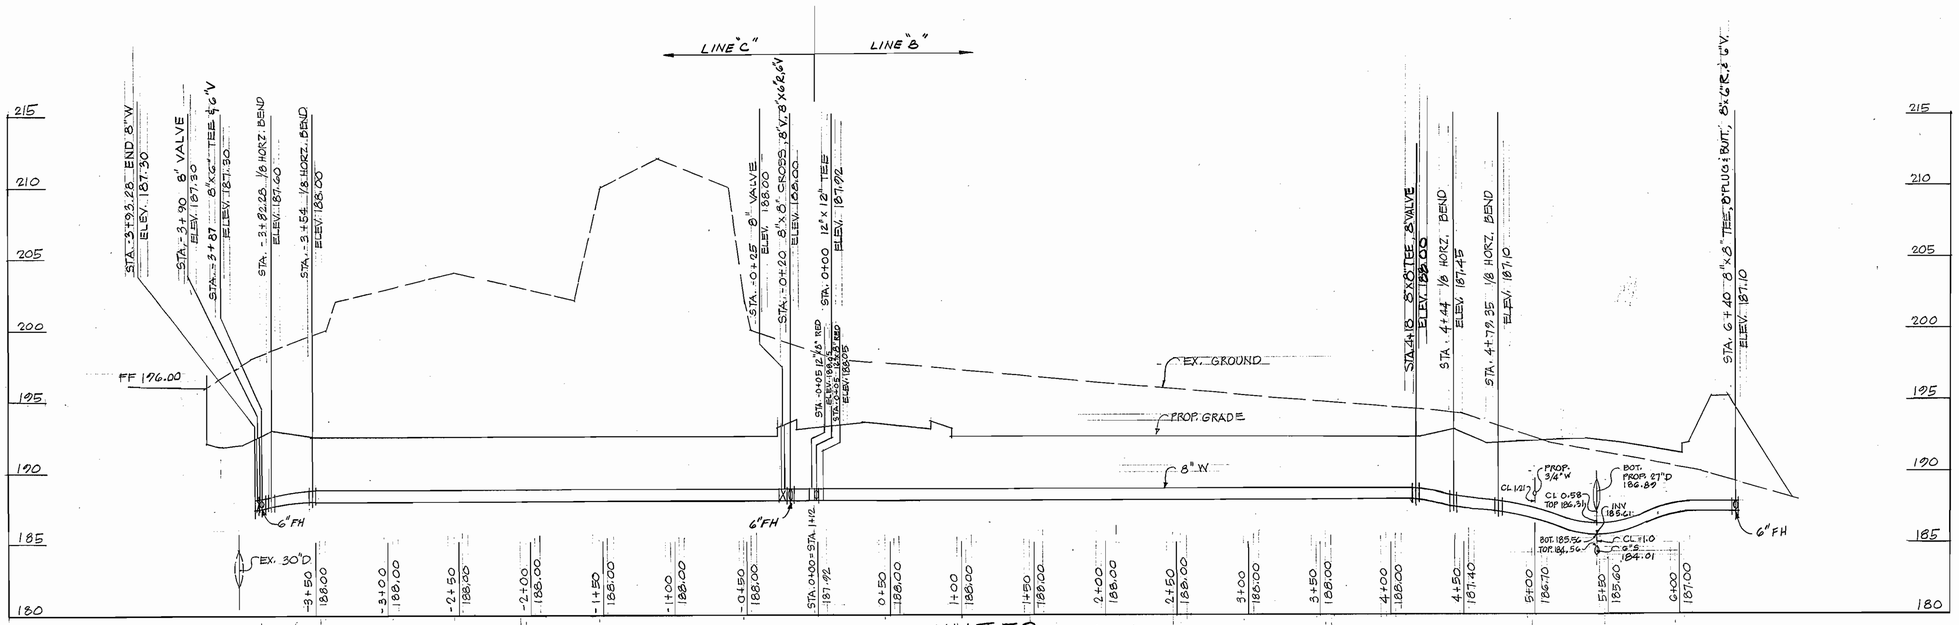

WATER PROFILE

SCALE: 1" = 50' HORZ.
1" = 5' VERT.

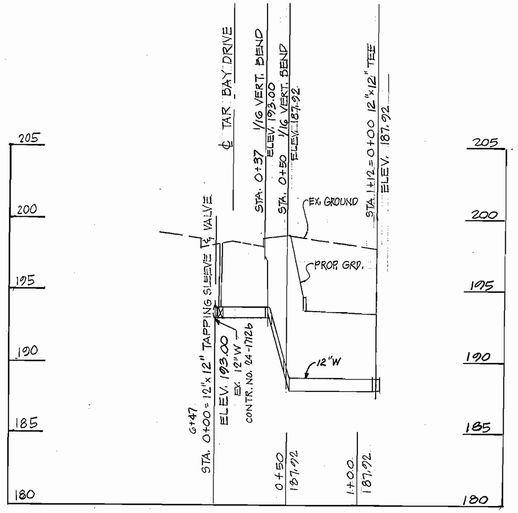

WATER PROFILE

SCALE: 1" = 50' HORZ.
1" = 5' VERT.

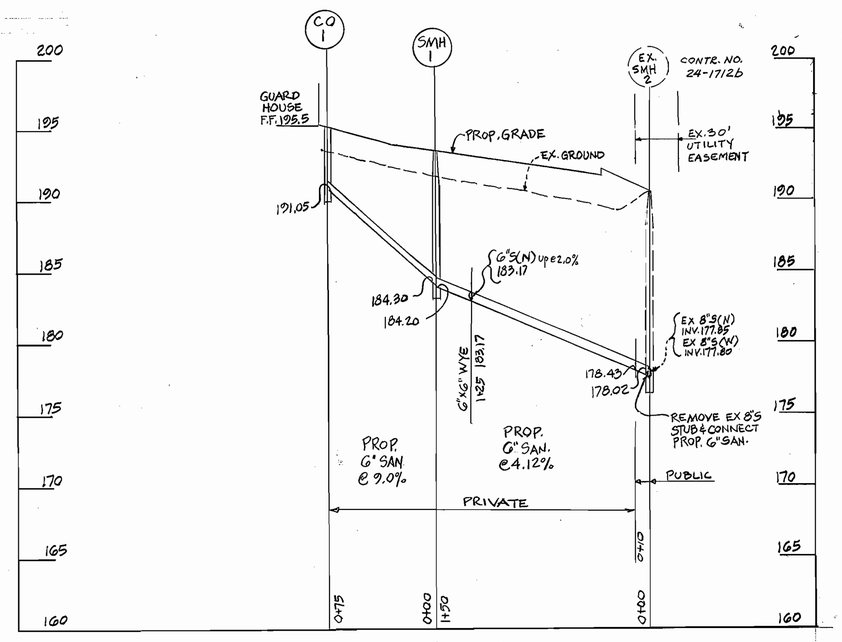

SANITARY SEWER PROFILE

SCALE: 1" = 50' HORZ.
1" = 5' VERT.

DEPARTMENT OF PUBLIC WORKS
HOWARD COUNTY, MARYLAND

DIRECTOR OF PUBLIC WORKS — DATE 5/11/90
CHIEF, BUREAU OF ENGINEERING — DATE 5-11-90
CHIEF, BUREAU OF UTILITIES — DATE 5-7-90
CHIEF, LAND DEVELOPMENT DIV. — DATE 5/11/90

ENGINEER
PAUL LEE ENGINEERING, INC.
304 W. PENNSYLVANIA AVE.
TOWSON, MARYLAND 21204

STATE OF MARYLAND — PAUL LEE — No. 6178 — REGISTERED PROFESSIONAL ENGINEER

DES: G.L.
DRN: R.A.
CHK: P.L.
DATE: 3-19-90

BY	NO.	REVISION	DATE
P.L.E.	1	ADD 8"W. STA 4+18, DELETE 8"W. STA 6+40	

WATER & SEWER PROFILE

600' SCALE MAP NO. 43 BLOCK NO. 20 & 21

MARYLAND WHOLESALE FOOD CENTER
PARCEL "A" TAR BAY DRIVE
SECTION 3 BLOCK B
: ELECTION DISTRICT No. 6
: CONTRACT No. 24-3045-D

SCALE AS SHOWN

SHEET 2 OF 2

AS-BUILT · 10-04-90